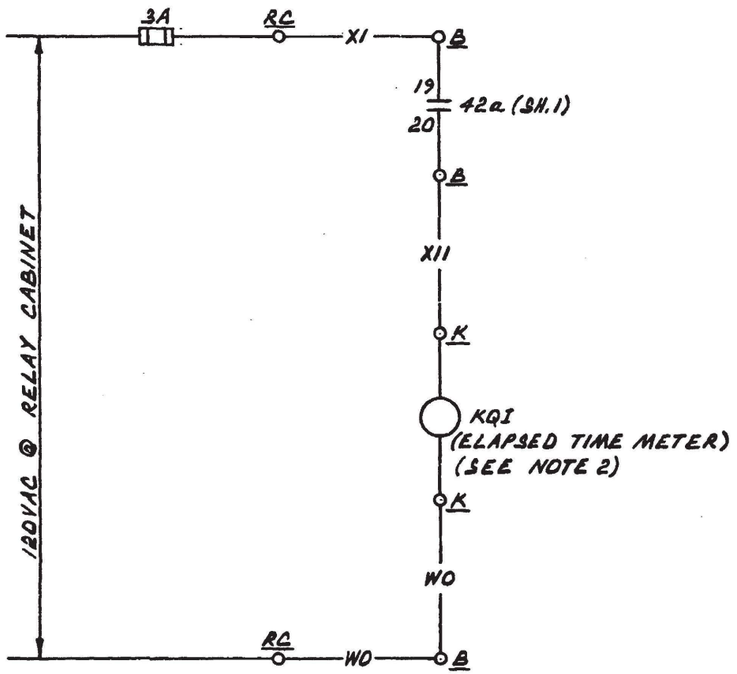

SCHEME NO. SEE TABLE

BLOCK DIAGRAM

NOTES

1. FOR GENERAL NOTES SEE DWG. INDEX E-60B.
2. ELAPSED TIME METER EAGLE SIGNAL BULLETIN 705 CAT #HK61DAG MOUNTED IN A SIZE ONE BOX.

SCHEME NO.	S.U. NO	CHANNEL	EQUIPMENT			DESCRIPTION
			B	RC	K	
ETM01	2B	A	BE1209	RC4601	KQI0211	CTRL RM EMER VENT SYS FAN 1-1 ELAPSED TIME METER
ETM02	2B	B	BF1149	RC4602	KQI0212	CTRL RM EMER VENT SYS FAN 1-2 ELAPSED TIME METER

REV.	DESCRIPTION	DATE	DR	CHK	SUPV	CHIEF	PROJ	OWNER	OWNER
0	"AS BUILT" FOR FCR 77-228	11-7-78	PJC	[illegible]	[illegible]	—	—	—	—

G-231-D

DAVIS-BESSE NUCLEAR POWER STATION

THE TOLEDO EDISON COMPANY
THE CLEVELAND ELECTRIC ILLUMINATING COMPANY

ELEMENTARY WIRING DIAGRAM
STA HTG VENTL & CLNG SYS
CTRL RM EMER VENT SYS E.T. MTR

BECHTEL COMPANY	JOB NO.	DRAWING NO.	REV.
	7749	E-60B SH. 1A	0