LTR	DATE	REVISIONS	BY	CHK	APP'D	MFR SERV SUPV	GEN SUPV
		AC SOURCES NOT IN SERVICE	RLC				
		ECN 20709, ASCO# 70-1149-N-250-S1 A.1	CD	RLC	DMS	JAC	
		ADD TO CH 1749-N-250-S1 A.1		SB	RL	DH	MOK

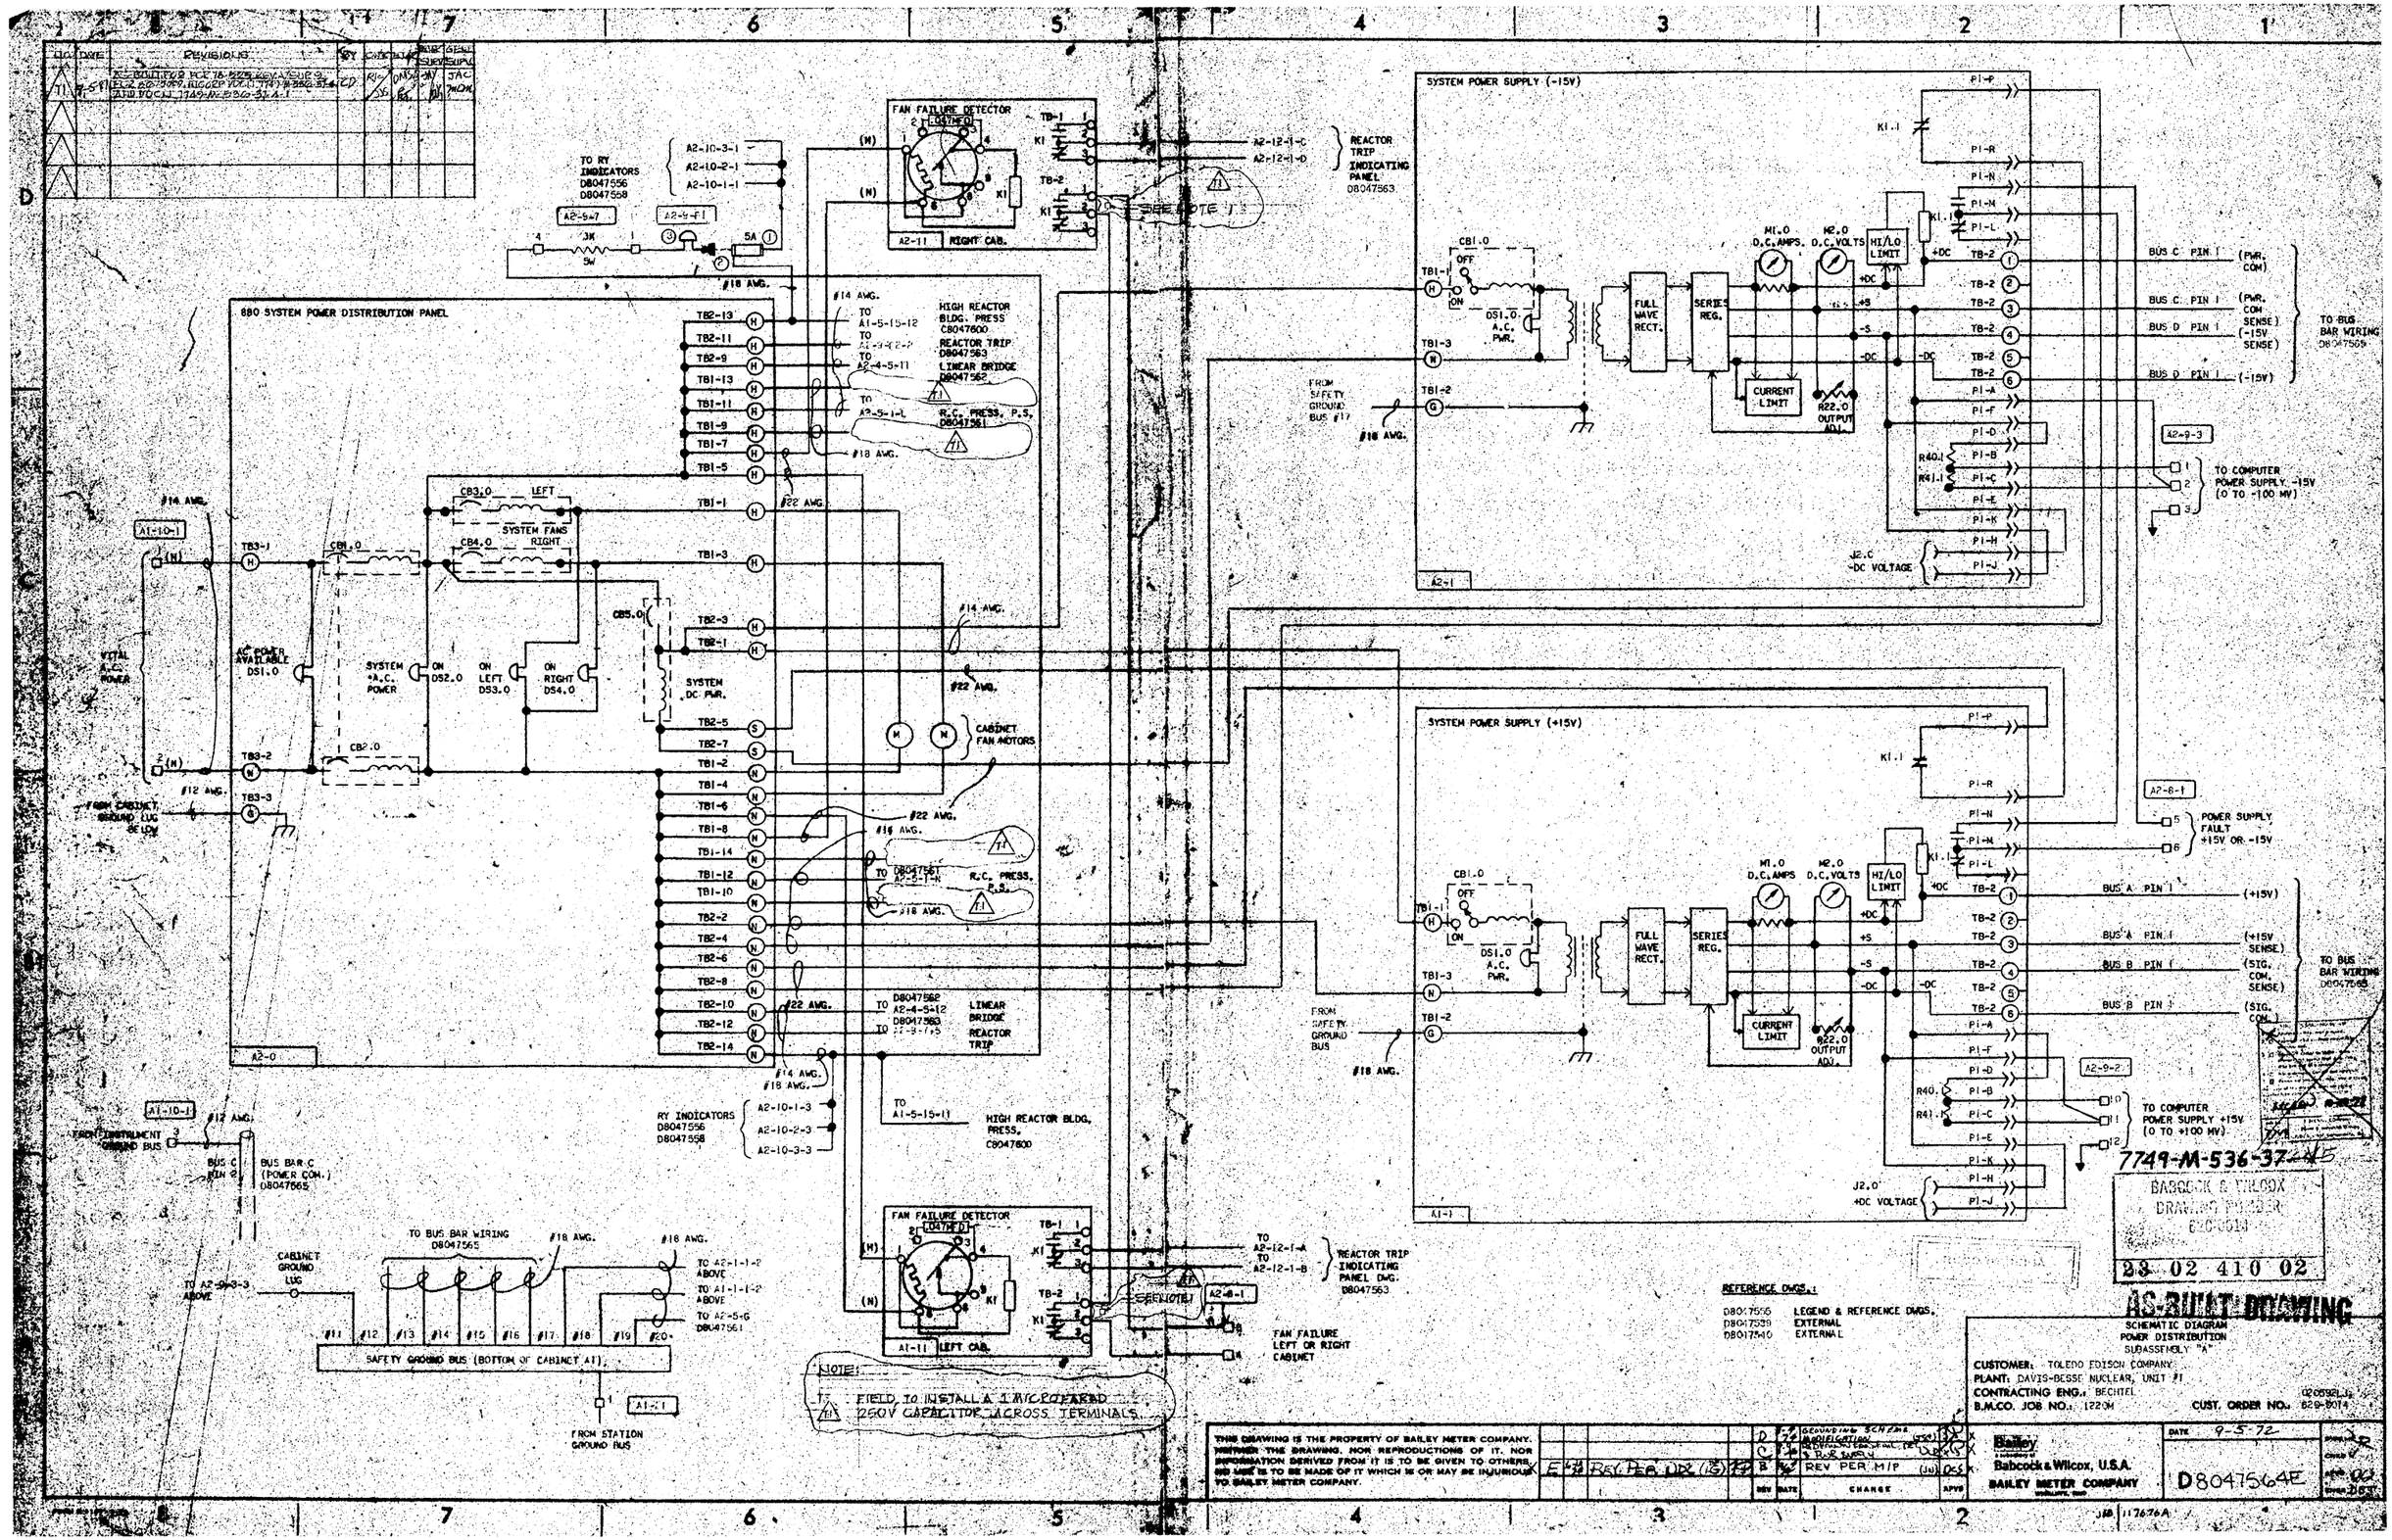

REFERENCE DWGS.:

D8047555	LEGEND & REFERENCE DWGS.
D8047539	EXTERNAL
D8047540	EXTERNAL

7749-M-536-37 45

BABCOCK & WILCOX DRAWING PLOTTER 8-10-71

23 02 410 02

AS-BUILT DRAWING

SCHEMATIC DIAGRAM
POWER DISTRIBUTION
SUBASSEMBLY "A"

CUSTOMER: TOLEDO EDISON COMPANY
PLANT: DAVIS-BESSE NUCLEAR, UNIT #1
CONTRACTING ENG.: BECHTEL
B.M.CO. JOB NO.: 1220M
CUST. ORDER NO.: 829-8014

THIS DRAWING IS THE PROPERTY OF BAILEY METER COMPANY. NEITHER THE DRAWING, NOR REPRODUCTIONS OF IT, NOR INFORMATION DERIVED FROM IT IS TO BE GIVEN TO OTHERS, NOR USED IN TO BE MADE OF IT WHICH IS OR MAY BE INJURIOUS TO BAILEY METER COMPANY.

REV	DATE	CHANGE	APVD
D	7-72	GROUNDING SCHEME MODIFICATION	DCS
C	7-72	ADDED SHIELDING	DCS
B	5-72	REV PER M/P (Jul)	DCS

Bailey
A DIVISION OF
Babcock & Wilcox, U.S.A.
BAILEY METER COMPANY

DATE 9-5-72
D8047564E