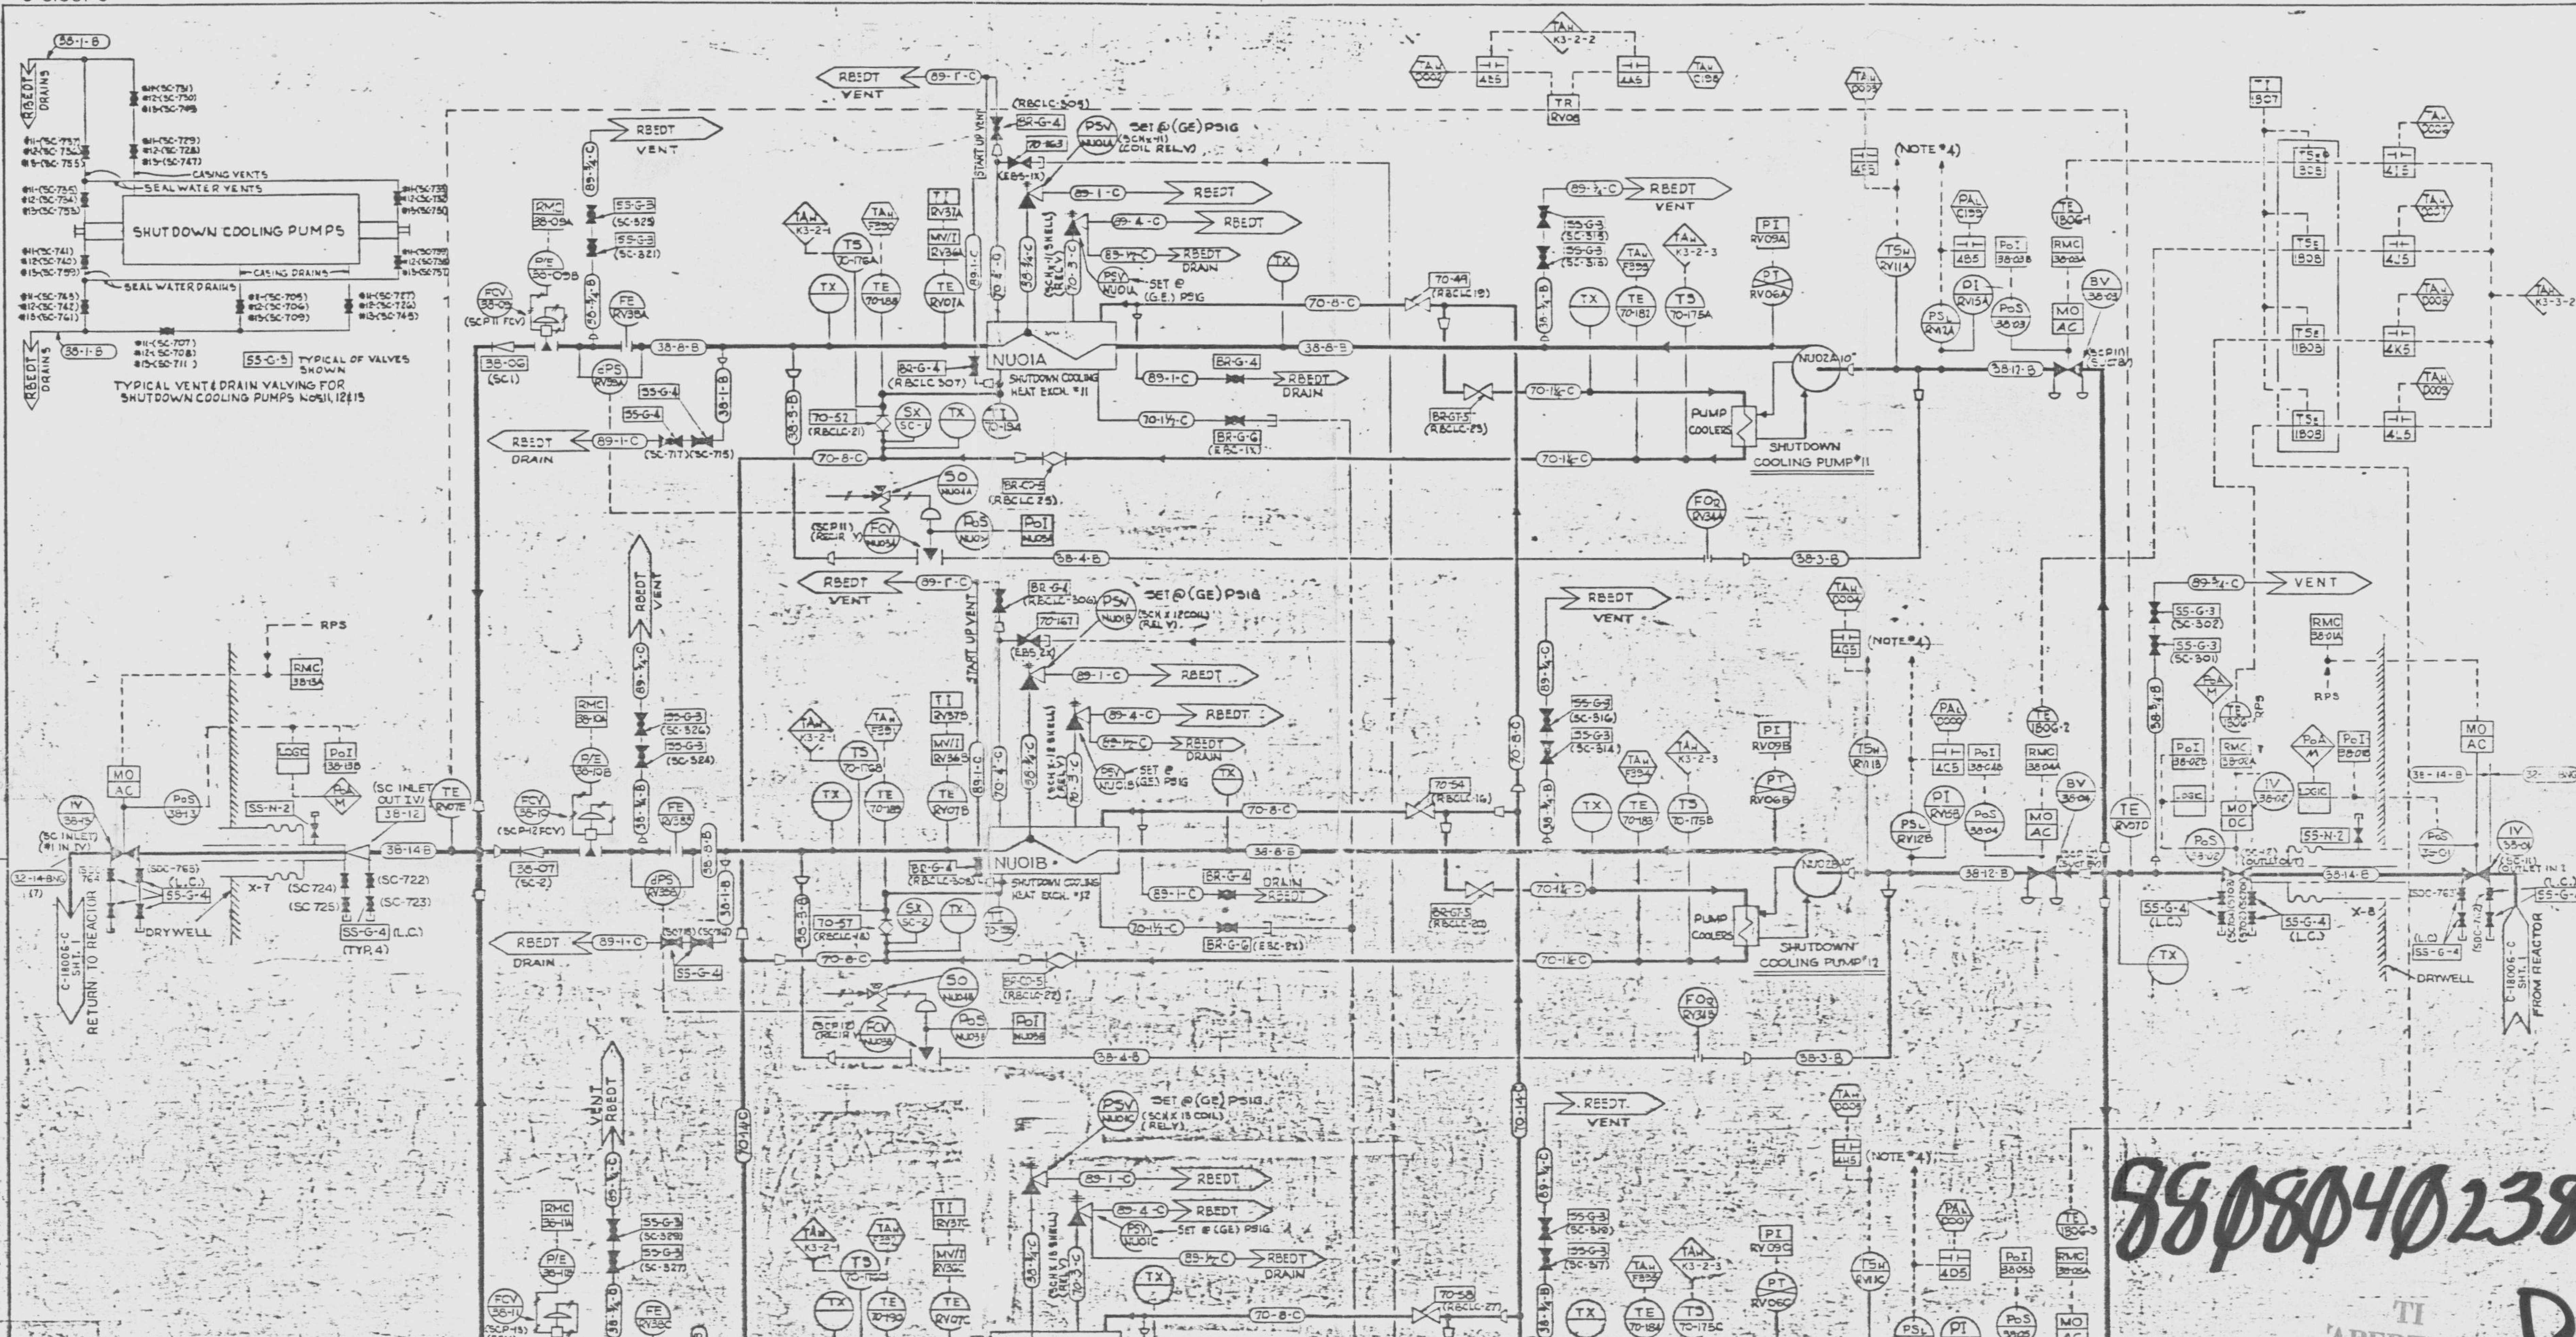

8. FOR Rx VESSEL HYDROTEST HEAT-UP SYSTEM DETAILS, SEE DWG. C-18018-C, SHT. 2.
7. NEW PIPE (BN6) INSTALLED TO FIRST ISOLATION VALVE
6. ALL TEMPERATURE DEVICES (TE TI TS) HAVE THERMOWELLS (TX)
5. ISOLATION VALVES 38-01 & 38-02 ARE INTERLOCKED SO ONLY ONE VALVE CAN BE EXERCISED AT A TIME AT REACTOR PRESSURE ABOVE 120 P.S.I.G. BELOW 120 P.S.I.G. BOTH VALVES MAY BE OPEN AT THE SAME TIME.
4. PUMP PERMISSIVE START- SUCTION PRESS. ABOVE 4 PSIG; TEMP BELOW 350°F; ISOLATION VALVES OPEN
PUMP TRIP- SUCTION PRESS BELOW 4 PSIG; TEMP ABOVE 350°F; ISOLATION VALVES CLOSED
3. REFERENCE DWG. G.E. CO. DWG. 148F719.
2. FOR EQUIP. MARKED NUXX OR RVXX SEE REACTOR SHUTDOWN COOLING SYS PARTS LIST. 194X540 (FURNISHED BY G.E. CO.)
1. ALL VENTS (HIGH POINTS IN SYSTEM) & DRAINS (LOW POINTS IN SYSTEM) TO BE ROUTED TO REACTOR BLDG. EQUIP. DRAIN TANK.

GENERAL NOTES:

10	4/85	H W	REVISED PER FIELD VERIFICATION. DTM 3200-10		
9	6/84	PW	FINAL AS BUILT. M.O. 2999		
8	4/84	S S	DELETED VALVES ADDED IN REV. 6 MO 3171		
7	[illegible]	S S	REVISED PIPE MATERIAL PER FIELD AS BUILT MO 2999		

15	11/28/82	S S	ADDED VALVES FOR EXCESSIVE LEAKAGE MO 3171		
5	12/2/70	C	REVISED PER "AS BUILT"		
4	8/11/69	A M	ADDED ANNUN. NUMBERS		
12	12/22/86	P H W	REMOVED 1 1/2" DRAIN PER AS-BUILT. DCR N1Y85M0521LG062		
11	9/11/86	P H W	ADDED Rx HYDRO HEAT-UP SYSTEM PER FINAL AS-BUILT DCR N1Y85M0521CS106		
NO.	DATE	BY	DESCRIPTION OF REVISION		

NIAGARA MOHAWK

NIAGARA MOHAWK POWER CORPORATION

NINE MILE POINT NUCLEAR STATION

REACTOR SHUTDOWN COOLING
P & I DIAGRAM

DR. JD | CH. AWC | DATE 1/17/66 | SCALE NONE

INDEX 3-N2-S14

NO. C-18018-C

SHEET 1 OF 2

8808040238

D