8770-G-392

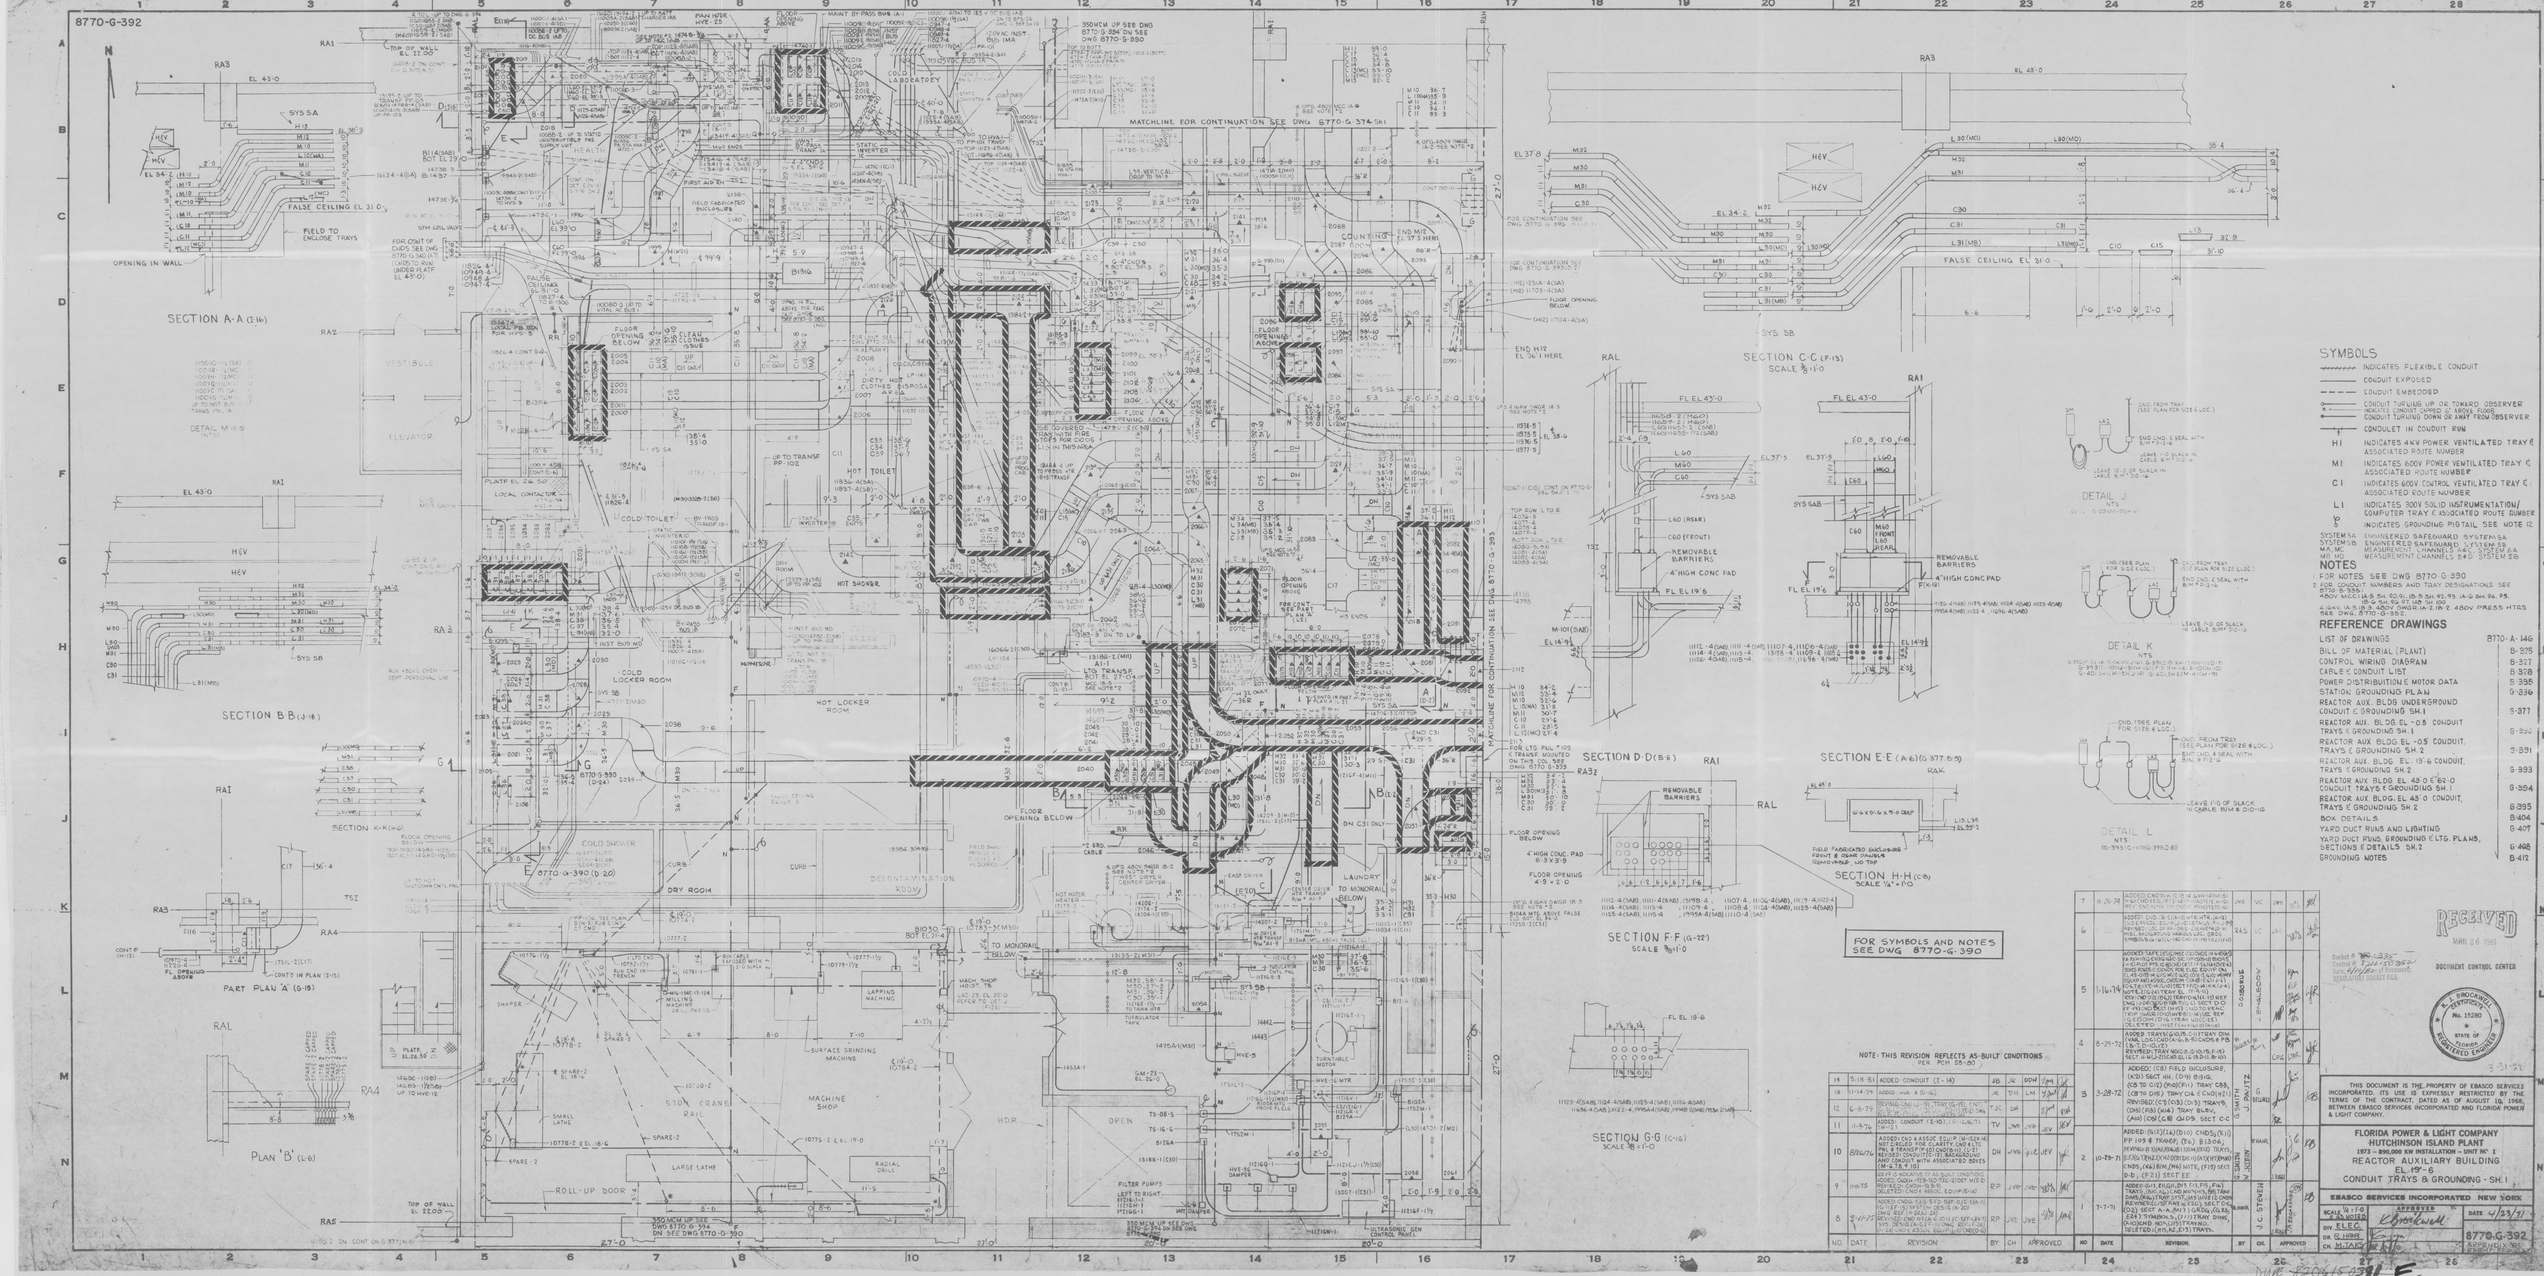
SECTION A-A (J-16)
SECTION B-B (J-16)
SECTION K-K (H-6)
PART PLAN 'A' (G-18)
PLAN 'B' (L-6)
SECTION C-C (F-13)
SECTION D-D (B-6)
SECTION E-E (A-6)(G 8770-B-5)
SECTION F-F (G-22)
SECTION G-G (C-16)
SECTION H-H (C-6)
DETAIL J
DETAIL K
DETAIL L
MATCHLINE FOR CONTINUATION SEE DWG 8770-G-374-SH.1
MATCHLINE FOR CONTINUATION SEE DWG 8770-G-393
FOR SYMBOLS AND NOTES SEE DWG 8770-G-390
NOTE: THIS REVISION REFLECTS AS-BUILT CONDITIONS PER PCN 58-50
RECEIVED
MAR 26 1981
DOCUMENT CONTROL CENTER
THIS DOCUMENT IS THE PROPERTY OF EBASCO SERVICES INCORPORATED. ITS USE IS EXPRESSLY RESTRICTED BY THE TERMS OF THE CONTRACT, DATED AS OF AUGUST 18, 1968, BETWEEN EBASCO SERVICES INCORPORATED AND FLORIDA POWER & LIGHT COMPANY.
FLORIDA POWER & LIGHT COMPANY
HUTCHINSON ISLAND PLANT
1973 - 890,000 KW INSTALLATION - UNIT NO. 3
REACTOR AUXILIARY BUILDING
EL. 19'-6
CONDUIT TRAYS & GROUNDING - SH. 1
EBASCO SERVICES INCORPORATED NEW YORK
8770-G-392