


This drawing and the design it covers are the property of BECHTEL. They are hereby loaned and on the borrower's express agreement that they will not be reproduced, copied, loaned, exhibited, nor used except in the limited way and extent permitted by any written consent given by the lender to the borrower.

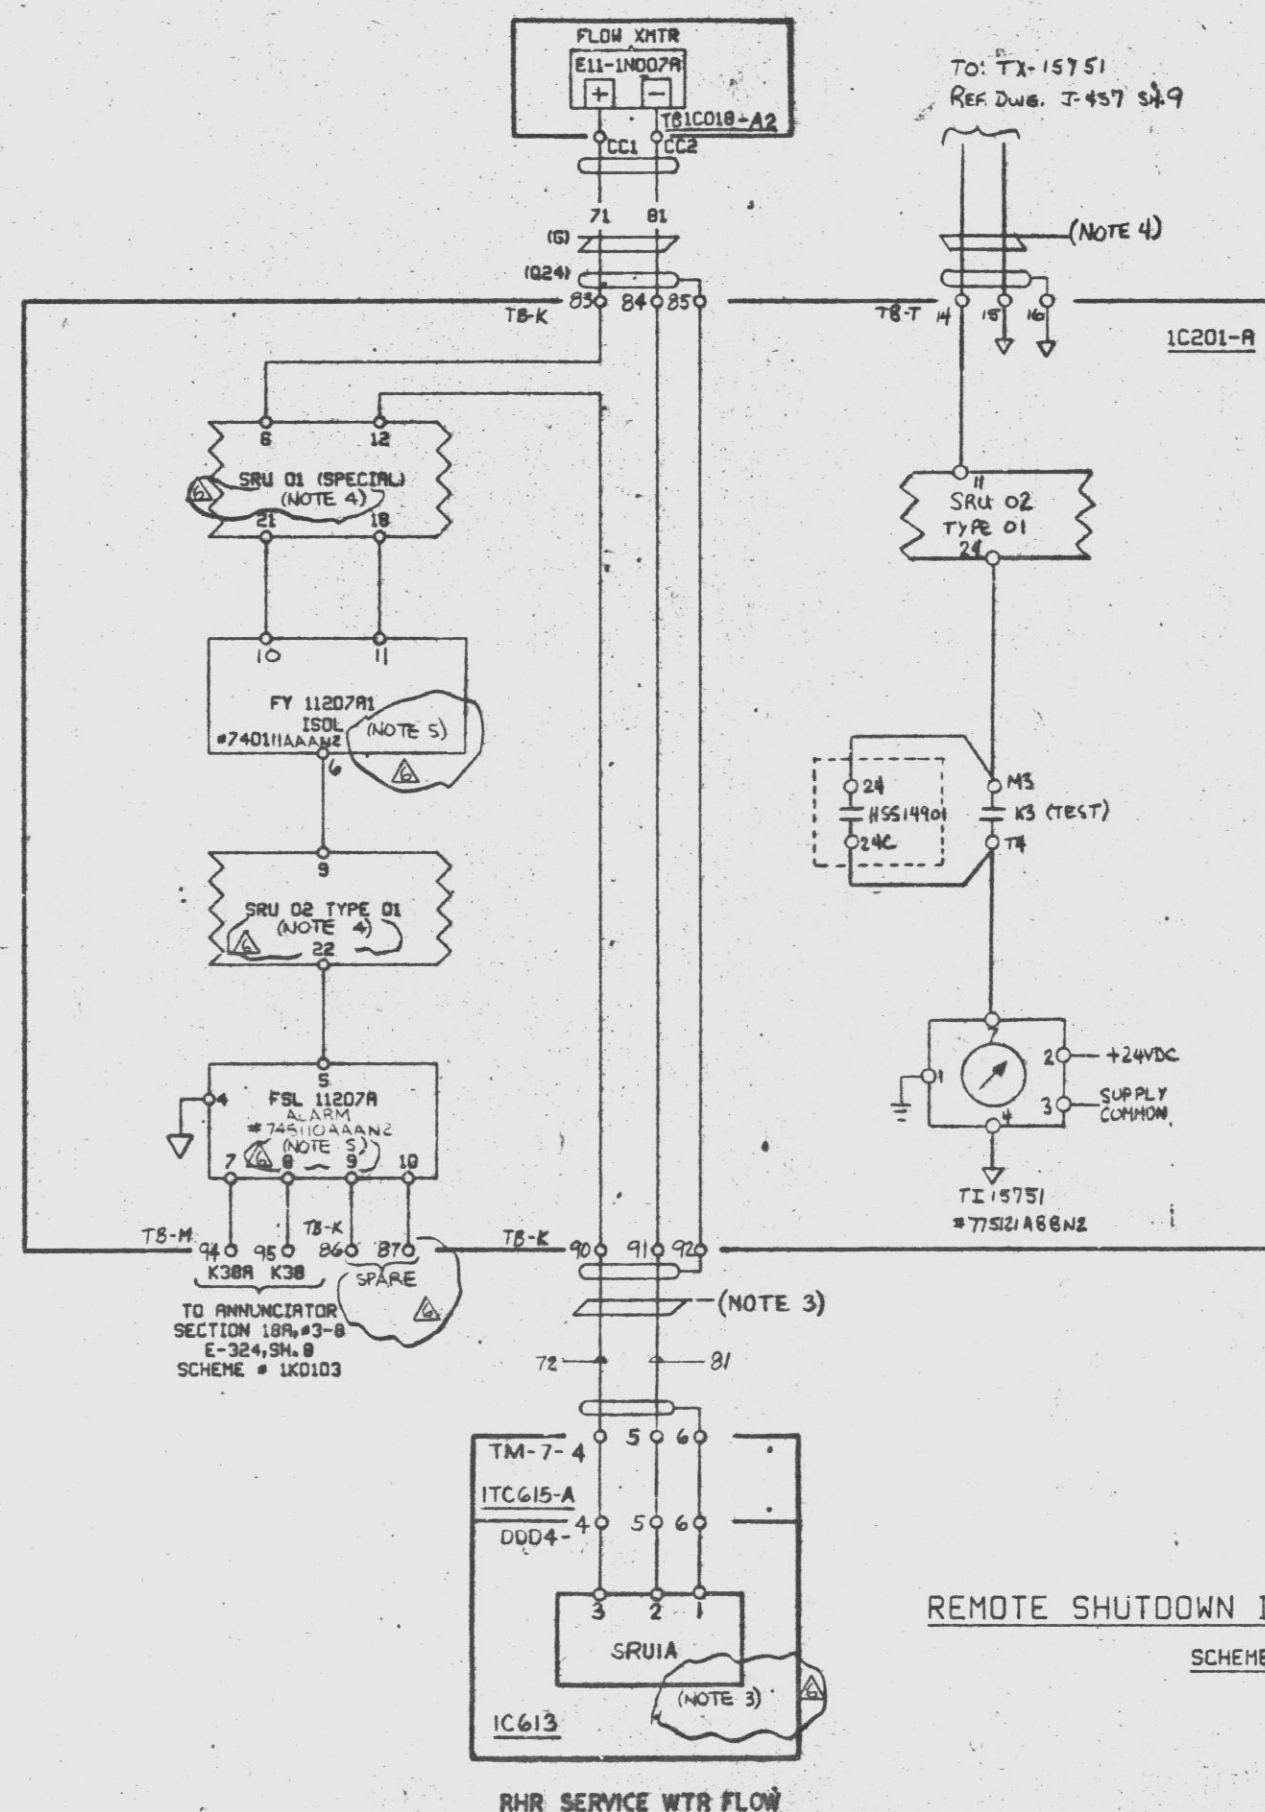

REFERENCE DRAWING		
PANEL NO	BECHTEL NO	PL NO
	E-64 SH 16	D-107213-16
	E-153 SH 35	D-107213-35
	E-324 SH 8	D-107473
	MI-E11-29(10)	FF-124510
TBIC018-A2	E-373-05	A-102522-5
ITC615A	E-360-17	A-107509-17
	E-390	E-107539
IC201A	E-373-18	A-102522-18
IC613	E-395-41 B	A-107544-8

THIS DOCUMENT IS UNDER PPL ADMINISTRATIVE CONTROL. NO CHANGES CAN BE MADE WITHOUT PRIOR PPL APPROVAL.

NOTES

1. ALL CABLES FACILITY CODE EN UNLESS OTHERWISE NOTED.
2. ALL SHIELD CONNECTIONS TO BE AS SHOWN.
3. FOR SCHEME CABLE NO REFER TO E-153, SH 35 (SCHEME N2 (Q3066) AND V.P. 8856-MI-E11-29(10) FOR POWER DISTRIBUTION.
4. REFER TO J-498 SH 2 FOR +24VDC POWER FOR SRU 01 AND SRU 02.
5. +24VDC IS INTERNALLY BUSSED IN BAILEY RACK CONNECTED AT TEE-PY4903.
6. REFER TO J-498 SH 2 FOR POWER DISTRIBUTION.

PRC
APERTURE
CARD

11/2/76	REVISED PER DCR-008, PRC-J-10415				
7/4/77	REVISED PER DCP-474.14	GLT			
7/11/77	REVISED PER PRC-J-50002	GLT			
4/25/77	REVISED PER IDEN # 7, BY # 2974, FOR J-10215, J-10216, ISS AS BUILT				
2/27/77	ISSUED FOR CONSTRUCTION				
DATE	REVISIONS	BY	CHK	DESIGN	APPROV
SCALE	DESIGNED J.B.	DRAWN			
PENNSYLVANIA POWER & LIGHT COMPANY					
ALLENTOWN, PENNSYLVANIA					
SUSQUEHANNA STEAM ELECTRIC STATION - UNIT 1, UNIT 2					
BECHTEL - SAN FRANCISCO					
LOOP DIAGRAM					
REMOTE SHUTDOWN INSTRUMENTATION					
DIV 1 (CONT)					
JOB No.	DRAWING No.	REV.			
8856	J-498 #3	6			
D-103779 #3					

24X

I certify that the microfilm image contained on this microform were made in the normal and regular course of business. This is a true, full, correct and complete reproduction and replacement for and/or in lieu of original documents generated by the Bechtel group of companies.

Sign: RAKins Date: 9-28-82 Camera Type: MRG I

Docket # 58-387
Control # 830-4050245-201
Date 3-29-83 of Document
CHARTER DOCKET FILE

D