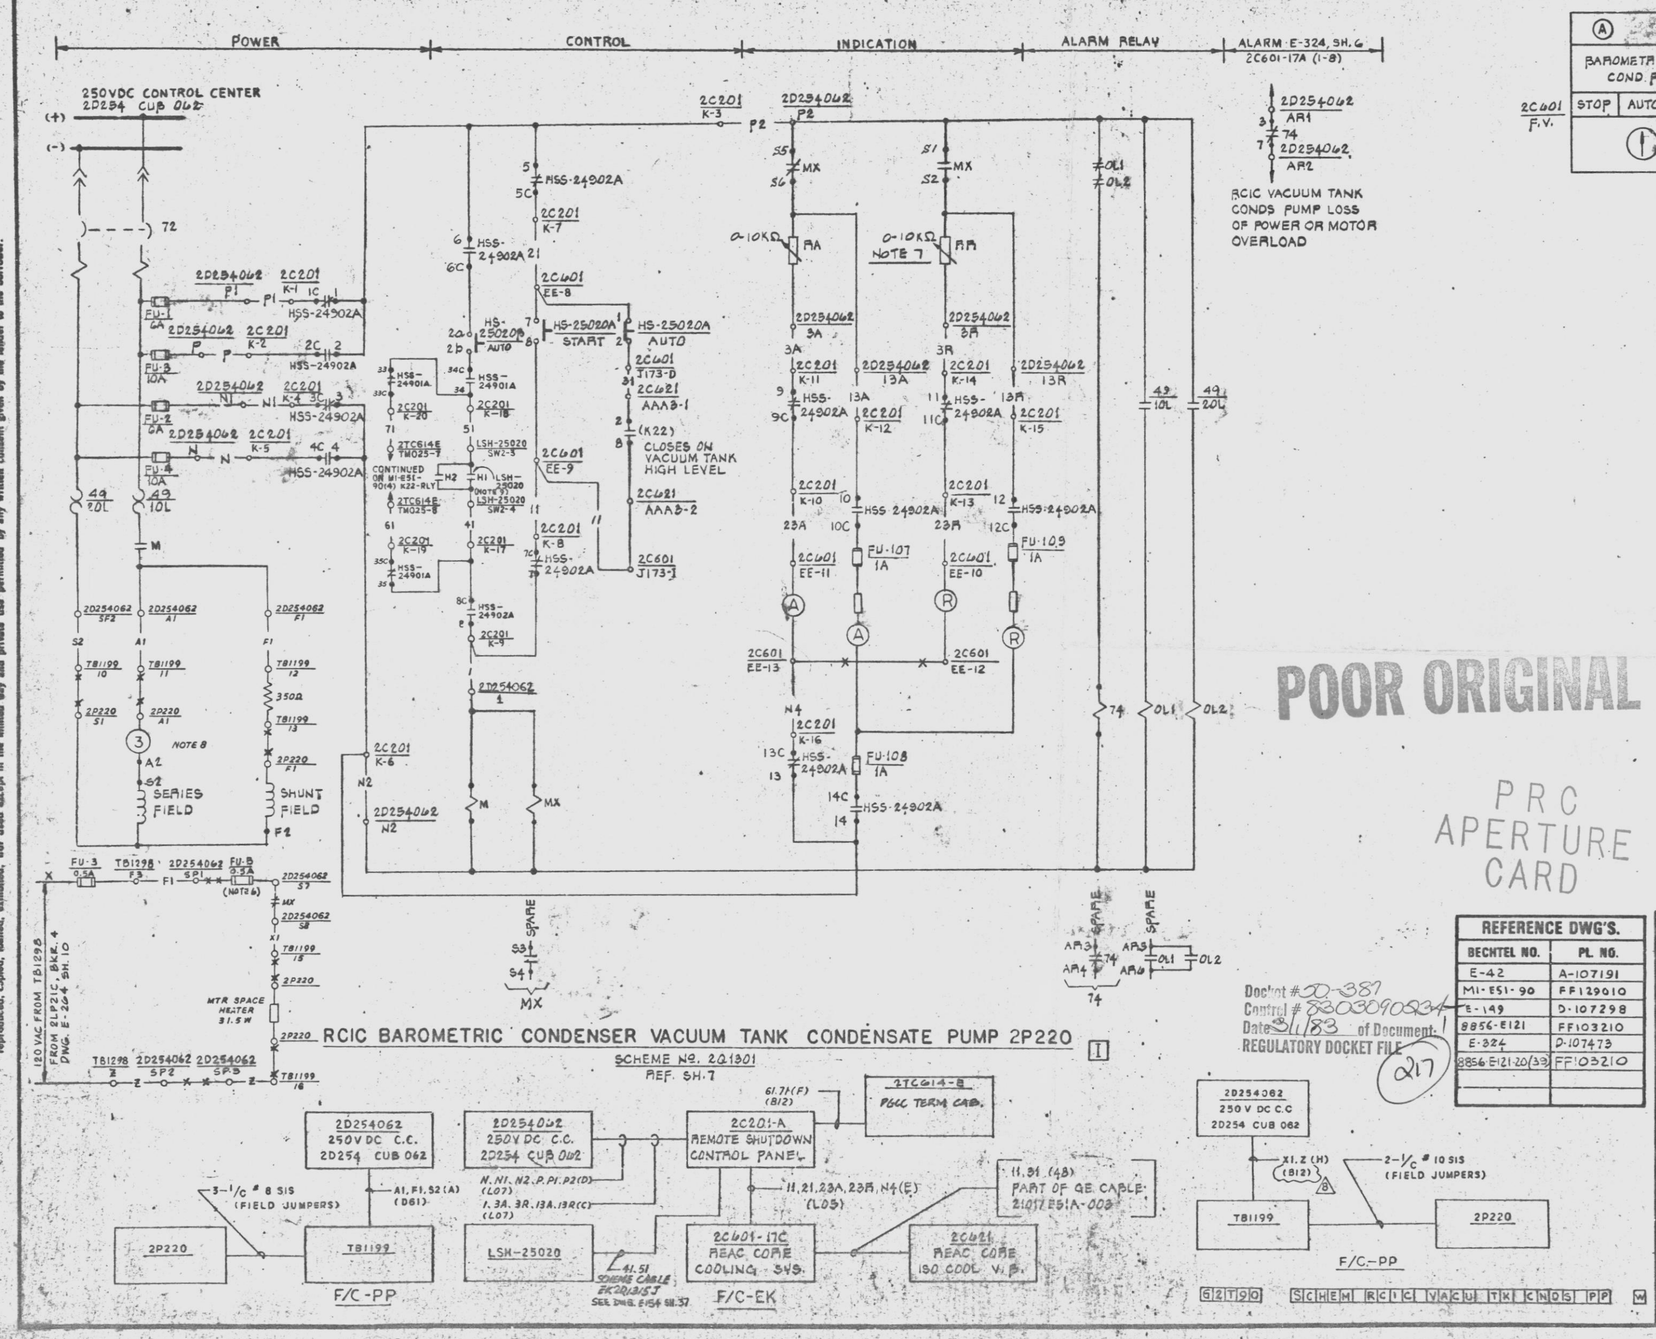

SWITCH DEVELOPMENT

BLOCK No.	CONTACT No.		POSITION STOP	AUTO	START	DRAWING No.
TOP	1 2 3 4	F		X	X	THIS SH.
		B	X			SPARE
BTM	5 6 7 8	F	X	X		SPARE
		B			X	THIS SH.

CONTROL SWITCH : HS-25020A
GENERAL ELECTRIC TYPE CR2940
SPRING RETURN TO AUTO

NOTES:

1. FOR STANDARD SYMBOLS FOR ELECTRICAL DIAGRAMS SEE DWG 8856-E-42
2. ALL DEVICE NOS TO BE SUFFIXED BY STARTER LOCATION NO UNLESS NOTED OTHERWISE
3. NUMBERS IN PARENTHESIS APPEARING ON SCHEM DIAG ARE GE DEVICE NUMBERS .
4. FOR SWITCH DEVELOPMENT OF REMOTE SHUTDOWN PANEL (2C201) SWITCHES SEE DWG E-148, SH. 6 & 8.
5. DESIGN BASED ON GE ELEMENTARY 791E421AE (VP 8856-M1-E51-90(7)-2)
6. FIELD TO INSTALL FUSE B (0.5A) IN COMPARTMENT 2D254062.
7. FIELD TO REPLACE WITH 0-10K Ω VARIABLE RESISTORS AND ADJUST TO 24V ACROSS THE LIGHT CIRCUIT.
8. ALL MOTOR LEADS SHALL BE TERMINATED AT TB1199 PROVIDED BY FIELD.
9. CLOSES, ON BAROMETRIC CONDR. VAC. TANK HIGH LEVEL.

POOR ORIGINAL

PRC APERTURE CARD

UNCONTROLLED DOCUMENT FOR REFERENCE ONLY

Doc'ct # 50-381
Control # 8303090234
Date 3/1/83 of Document:
REGULATORY DOCKET FILE
217

REFERENCE DWG'S.	
BECHTEL NO.	PL. NO.
E-42	A-107191
M1-E51-90	FF129010
E-149	D-107298
8856-E121	FF103210
E-324	D-107473
8856-E121-20(33)	FF103210

No.	DATE	REVISIONS	BY	CHK'D	DESIGN SUPV	ENG'G	PROJ ENGR	APP'D
8	1/19/83	REV. CABLE CODE PER AS BUILT (DCR 72)	JC	VAK	JS			
7	8/12/82	REV TO INCORP DCR E-7677	JC	VAK	JS			
6	6/14/82	REV F/C FROM EP TO PP (DCR 762)	JC	JAC	JS			
5	3/23/82	INCORPORATED DCR E-6364	JC	VAK	JS			
4	9/24/77	ISSUED FOR CONSTRUCTION	JS		JS			

SCALE — DESIGNED A. SANCHEZ — DRAWN MPSANTOS — CHIEF ENGR.

PENNSYLVANIA POWER & LIGHT COMPANY
ALLENTOWN, PENNSYLVANIA
SUSQUEHANNA STEAM ELECTRIC STATION - UNIT 1, UNIT 2

BECHTEL - SAN FRANCISCO

SCHEMATIC DIAGRAM RCIC BAROMETRIC CONDENSER VACUUM TANK CONDENSATE PUMP UNIT 2

JOB No.	DRAWING No.	REV.
8856	E-154 SH 21	8

D-107303 SH21

This drawing and the design it covers are the property of BECHTEL. They are merely loaned and on the borrower's express agreement that they will not be reproduced, copied, loaned, exhibited, nor used except in the limited way and private use permitted by any written consent given by the lender to the borrower.

24 X
JACINTO Operator Date 1/21/83 Camera Type MRG I