

DEPARTMENT OF ENERGY
ALBUQUERQUE OPERATIONS OFFICE
CONTRACT NO. DE-AC04-83AL18796

Vicinity Property Completion Report

Remedial Actions
Contractor
for the
Uranium Mill Tailings
Remedial Actions
Project



MK-FERGUSON COMPANY
A MORRISON KNUDSEN COMPANY

Vicinity Property No. RF-480

9709190137 970911
PDR WASTE
WM-62 PDR

VICINITY PROPERTY COMPLETION REPORT

AT

RF-480

RAILROAD RIGHT-OF-WAY
SOUTH OF THE OLD RIFLE SITE
RIFLE, CO

MAY 28, 1997

FOR

URANIUM MILL TAILINGS REMEDIAL ACTION PROJECT OFFICE
ALBUQUERQUE OPERATIONS OFFICE
U.S. DEPARTMENT OF ENERGY
ALBUQUERQUE, NM

BY

MK-FERGUSON COMPANY

AND

RUST FEDERAL SERVICES, INC.

MK-Ferguson Company has been granted authorization to perform remedial action under the Uranium Mill Tailings Radiation Control Act of 1978, Public Law 95-604. Remedial action was done in accordance to the EPA Standards for Cleanup of Lands and Buildings Contaminated with Residual Radioactive Material from Inactive Uranium Processing Sites, 40 CFR 192.12, 192.20-2.

TABLE OF CONTENTS

Section

- 1.0 SUMMARY
- 2.0 OPERATION SUMMARY
 - 2.1 Remedial Action Plan
 - 2.2 Previously Unidentified Contamination
 - 2.3 Unanticipated Items During Remedial Action
 - 2.4 Application of Supplemental Standards
- 3.0 VERIFICATION SUMMARY
 - 3.1 Radiological Survey Data
 - 3.1.1 Pre-Remedial Action Survey
 - 3.1.2 Pre-Restoration Survey
 - 3.2 Recommendation for Certification
 - 3.2.1 Exterior
 - 3.2.2 Interior
- 4.0 REFERENCES

- APPENDIX A - Radiological Survey Data
- APPENDIX B - Supplemental Standards Recommendation
- APPENDIX C - Legal Description

LIST OF FIGURES

Figures

- Property Photos
- Excavation Sequence and Tailings Excavation Plan: (RFL-PS-10-0708)
- Certification Radiological Plan: (RF-480-015 through -017)
- Excavation and Restoration Plan: (RF-480-020 through -022)
- Supplemental Standards Survey Data: (RF-480-030 and -031)

LIST OF TABLES

Table

- 3.1 Verification Soil Sample Survey
- 3.2 Supplemental Standards Dose Rate Survey
- 3.3 Supplemental Standards Outdoor Gamma and Borehole Survey
- 3.4 Supplemental Standards Soil Sample Survey

Vicinity Property No. RF-480

| | |
|-----------------------------|---------------------------------------------------------------------------|
| PROPERTY NUMBER: | RF-480 |
| PROPERTY ADDRESS: | RAILROAD RIGHT-OF-WAY SOUTH OF HIGHWAY 6 WEST RIFLE, COLORADO 81650 |
| PROPERTY OWNER: | D&RGW RAILROAD CO. P.O. BOX 5482 DENVER, CO. |
| PROPERTY CATEGORY: | COMMERCIAL |
| REMEDIAL ACTION CONTRACTOR: | MK-FERGUSON COMPANY |
| CONSTRUCTION SUBCONTRACTOR: | GREEN INTERNATIONAL INC. |
| RADIOLOGICAL CONTRACTOR: | RUST FEDERAL SERVICES, INC. |
| REA APPROVED: | N/A |
| REMEDIAL ACTION STARTED: | MAY, 1994 |
| REMEDIAL ACTION COMPLETED: | SEPTEMBER, 1994 |
| VOLUME OF MATERIAL REMOVED: | OUTDOOR: 16,678 cy INDOOR: N/A |

1.0 SUMMARY

Remedial action was completed on Vicinity Property RF-480. A total of 16,678 cubic yards of soil was removed from the property. Radiological surveys conducted following removal of contaminated material, but before property restoration, demonstrate that the property has been cleaned up to the EPA standards, with the application of supplemental standards. This completion report recommends that DOE review the radiological data provided for the property and award final certification.

2.0 OPERATION SUMMARY

2.1 Remedial Action Plan

The basic remedial action on this property was performed according to the Remedial Action Plan for Rifle, Colorado. A total of 16,678 cubic yards of soil was removed from the property. An estimate of the amount of material to be removed from this property was not made since the remedial action was performed in conjunction with the Old Rifle Site Remedial Action Plan.

2.2 Previously Unidentified Contamination

No new areas of contamination were identified during remedial action on property RF-480.

An area of contamination was discovered south of the railroad tracks at the west end of the property during remediation of adjacent property RF-510. The area was excavated and verified during remedial action of RF-510. Verification data for the area falling within the railroad right-of-way are presented in this report.

2.3 Unanticipated Items During Remedial Action

No unanticipated items occurred during remedial action on this property.

2.4 Application of Supplemental Standards

Per agreement, supplemental standards have been applied to residual radioactive material left in place along the railroad tracks. No remediation was performed within 15 feet of the centerline of the main tracks and railroad track and ties were not replaced. These conditions, including the application of supplemental standards, were pre-approved by the State, the DOE, and the NRC via their concurrence with the Remedial Action Plan for the Rifle Site. After completion of the RSA, but prior to remedial action, an MCI fiber optic telecommunications line was buried within the railroad right-of-way north of the tracks. Supplemental standards have also been applied to critical areas around the fiber optic cable and around the bases of eleven utility poles which support railroad operations. Appendix B, Supplemental Standards Recommendation, serves as documentation of the application of supplemental standards to the remaining areas of contamination and their current radiological conditions.

3.0 VERIFICATION SUMMARY

3.1 Radiological Survey Data

All survey data were acquired according to approved procedures.

3.1.1 Pre-Remedial Action Survey

The results of the survey defining the contaminated area requiring remedial action are presented on Drawing RFL-PS-10-0708.

3.1.2 Pre-Restoration Survey

Exterior:

After removal of contamination, and prior to backfilling, a soil sample survey was conducted in the excavated areas. Soil samples were aliquoted from 160 verification grids and analyzed by gamma spectroscopy with the Opposed Crystal System in accordance with Health Physics Procedure OP-003-1 and IN-001-2. The radium concentration in these soil samples range from 0.5 to 13.3 pCi/g, as summarized in Table 3.1.

Drawings RF-480-020 through 022 show the actual areas of excavation.

These results confirm that exterior contamination, with the application of supplemental standards, has been reduced to levels below the EPA standards for radium in soil. Background for the Rifle, Colorado, locale is 1.2 pCi/g Ra-226. The data presented include background.

Interior: There are no structures on this property.

3.2 Recommendation for Certification

3.2.1 Exterior:

Areas of contamination contiguous to the Old Rifle Site were identified and removed. Soil samples after excavation and prior to backfilling indicate that the limits of 15 pCi/g above background in the surface 15 cm and 15 pCi/g above background in any 15 cm layer below the surface are not exceeded. Based on this information, we recommend the exterior of this vicinity property be certified to be in compliance with EPA standards, with the application of supplemental standards, for the UMTRA Project.

3.2.2 Interior:

There are no structures on this property.

4.0 REFERENCES

- 4.1 Remedial Action Plan and Site Design for Stabilization of the Inactive Uranium Mill Tailings Sites At Rifle, Colorado; U.S. Department of Energy, UMTRAP, February, 1992.
- 4.2 The Vicinity Property Remedial Action Agreement for Property RF-480; MK-Ferguson Company; Albuquerque, New Mexico; April, 1994.
- 4.3 Health Physics Procedures; Rust Federal Services, Inc., for MK-Ferguson Company, Remedial Action Contractor; Albuquerque, New Mexico; October, 1993.
- 4.4 Vicinity Properties Management and Implementation Manual; UMTRAP, U.S. Department of Energy; Albuquerque, New Mexico; August, 1986.
- 4.5 Title 40, Code of Federal Regulations, Part 192.12-23; U.S. Environmental Protection Agency; Washington, D.C.; July, 1983.

TABLE 3.1
VERIFICATION SOIL SAMPLE SURVEY
PROPERTY RF-480

| LOCATION/SAMPLE ID | SAMPLE DEPTH (cm) | RA-226 CONC. (pCi/g) |
|--------------------|----------------------|-------------------------|
| ORF-SV-D-40-25 | > 15 | 2.6 |
| ORF-SV-D-41-20 | > 15 | 1.4 |
| ORF-SV-D-41-21 | > 15 | 1.8 |
| ORF-SV-D-41-22 | > 15 | 1.4 |
| ORF-SV-D-41-23 | > 15 | 1.7 |
| ORF-SV-D-41-24 | > 15 | 3.7 |
| ORF-SV-D-41-25 | > 15 | 3.0 |
| ORF-SV-D-42-15 | > 15 | 1.4 |
| ORF-SV-D-42-16 | > 15 | 3.1 |
| ORF-SV-D-42-17 | > 15 | 3.7 |
| ORF-SV-D-42-18 | > 15 | 2.7 |
| ORF-SV-D-42-19 | > 15 | 2.9 |
| ORF-SV-D-42-20 | > 15 | 2.7 |
| ORF-SV-D-42-21 | > 15 | 2.8 |
| ORF-SV-D-42-22 | > 15 | 3.4 |
| ORF-SV-D-42-23 | > 15 | 7.8 |
| ORF-SV-D-42-24 | > 15 | 5.4 |
| ORF-SV-E-28-25 | > 15 | 6.5 |
| ORF-SV-E-31-23 | > 15 | 6.6 |
| ORF-SV-E-31-24 | > 15 | 2.8 |
| ORF-SV-E-31-25 | > 15 | 1.8 |
| ORF-SV-E-32-17 | > 15 | 1.5 |
| ORF-SV-E-32-18 | > 15 | 1.6 |
| ORF-SV-E-32-19 | > 15 | 2.2 |

TABLE 3.1
VERIFICATION SOIL SAMPLE SURVEY
PROPERTY RF-480

| <u>LOCATION/SAMPLE ID</u> | <u>SAMPLE DEPTH (cm)</u> | <u>RA-226 CONC. (pCi/g)</u> |
|---------------------------|------------------------------|---------------------------------|
| ORF-SV-E-32-20 | > 15 | 2.0 |
| ORF-SV-E-32-21 | > 15 | 2.2 |
| ORF-SV-E-32-22 | > 15 | 2.8 |
| ORF-SV-E-32-23 | > 15 | 1.3 |
| ORF-SV-E-32-24 | > 15 | 1.2 |
| ORF-SV-E-32-25 | > 15 | 1.4 |
| ORF-SV-E-33-12 | > 15 | 0.7 |
| ORF-SV-E-33-13 | > 15 | 1.3 |
| ORF-SV-E-33-14 | > 15 | 1.6 |
| ORF-SV-E-33-15 | > 15 | 1.7 |
| ORF-SV-E-33-16 | > 15 | 9.5 |
| ORF-SV-E-33-17 | > 15 | 3.3 |
| ORF-SV-E-33-18 | > 15 | 1.1 |
| ORF-SV-E-34-06 | > 15 | 1.9 |
| ORF-SV-E-34-07 | > 15 | 2.3 |
| ORF-SV-E-34-08 | > 15 | 1.2 |
| ORF-SV-E-34-09 | > 15 | 1.7 |
| ORF-SV-E-34-10 | > 15 | 1.5 |
| ORF-SV-E-34-11 | > 15 | 1.6 |
| ORF-SV-E-34-12 | > 15 | 3.1 |
| ORF-SV-E-34-13 | > 15 | 1.3 |
| ORF-SV-E-34-14 | > 15 | 0.5 |
| ORF-SV-E-35-01 | > 15 | 1.4 |
| ORF-SV-E-35-02 | > 15 | 0.8 |

TABLE 3.1
VERIFICATION SOIL SAMPLE SURVEY
PROPERTY RF-480

| LOCATION/SAMPLE ID | SAMPLE DEPTH (cm) | RA-226 CONC. (pCi/g) |
|--------------------|----------------------|-------------------------|
| ORF-SV-E-35-03 | > 15 | 1.6 |
| ORF-SV-E-35-04 | > 15 | 1.7 |
| ORF-SV-E-35-05 | > 15 | 1.0 |
| ORF-SV-E-35-06 | > 15 | 0.9 |
| ORF-SV-E-35-07 | > 15 | 1.4 |
| ORF-SV-E-35-08 | > 15 | 5.0 |
| ORF-SV-E-36-09 | > 15 | 1.3 |
| ORF-SV-E-36-10 | > 15 | 6.1 |
| ORF-SV-E-36-11 | > 15 | 2.7 |
| ORF-SV-E-36-12 | > 15 | 2.9 |
| ORF-SV-E-36-13 | > 15 | 1.4 |
| ORF-SV-E-36-14 | > 15 | 1.2 |
| ORF-SV-E-36-15 | > 15 | 13.3 |
| ORF-SV-E-36-16 | > 15 | 3.2 |
| ORF-SV-E-37-04 | > 15 | 9.9 |
| ORF-SV-E-37-05 | > 15 | 7.9 |
| ORF-SV-E-37-06 | > 15 | 2.8 |
| ORF-SV-E-37-07 | > 15 | 8.7 |
| ORF-SV-E-37-08 | > 15 | 3.3 |
| ORF-SV-E-37-09 | > 15 | 6.6 |
| ORF-SV-E-37-10 | > 15 | 12.3 |
| ORF-SV-E-37-11 | > 15 | 4.9 |
| ORF-SV-E-37-12 | > 15 | 6.9 |
| ORF-SV-E-38-01 | > 15 | 6.0 |

TABLE 3.1
VERIFICATION SOIL SAMPLE SURVEY
PROPERTY RF-480

| LOCATION/SAMPLE ID | SAMPLE DEPTH (cm) | RA-226 CONC. (pCi/g) |
|--------------------|----------------------|-------------------------|
| ORF-SV-E-38-02 | > 15 | 5.5 |
| ORF-SV-E-38-03 | > 15 | 2.9 |
| ORF-SV-E-38-04 | > 15 | 3.0 |
| ORF-SV-E-38-05 | > 15 | 2.6 |
| ORF-SV-E-38-06 | > 15 | 5.2 |
| ORF-SV-E-38-07 | > 15 | 1.7 |
| ORF-SV-E-39-01 | > 15 | 2.2 |
| ORF-SV-E-39-02 | > 15 | 1.6 |
| ORF-SV-F-22-19 | > 15 | 1.0 |
| ORF-SV-F-22-20 | > 15 | 1.6 |
| ORF-SV-F-22-21 | > 15 | 2.6 |
| ORF-SV-F-22-22 | > 15 | 1.6 |
| ORF-SV-F-22-23 | > 15 | 1.5 |
| ORF-SV-F-22-24 | > 15 | 1.0 |
| ORF-SV-F-22-25 | > 15 | 1.5 |
| ORF-SV-F-23-14 | > 15 | 0.6 |
| ORF-SV-F-23-15 | > 15 | 2.5 |
| ORF-SV-F-23-16 | > 15 | 1.4 |
| ORF-SV-F-23-17 | > 15 | 1.4 |
| ORF-SV-F-23-18 | > 15 | 1.6 |
| ORF-SV-F-23-19 | > 15 | 1.5 |
| ORF-SV-F-23-20 | > 15 | 1.9 |
| ORF-SV-F-23-21 | > 15 | 1.3 |
| ORF-SV-F-23-22 | > 15 | 1.8 |

TABLE 3.1
VERIFICATION SOIL SAMPLE SURVEY
PROPERTY RF-480

| LOCATION/SAMPLE ID | SAMPLE DEPTH (cm) | RA-226 CONC. (pCi/g) |
|--------------------|----------------------|-------------------------|
| ORF-SV-F-23-23 | > 15 | 0.6 |
| ORF-SV-F-24-08 | > 15 | 1.2 |
| ORF-SV-F-24-09 | > 15 | 8.0 |
| ORF-SV-F-24-10 | > 15 | 4.8 |
| ORF-SV-F-24-11 | > 15 | 1.9 |
| ORF-SV-F-24-12 | > 15 | 1.5 |
| ORF-SV-F-24-13 | > 15 | 1.8 |
| ORF-SV-F-24-14 | > 15 | 4.5 |
| ORF-SV-F-24-16 | > 15 | 4.9 |
| ORF-SV-F-24-17 | > 15 | 1.5 |
| ORF-SV-F-24-18 | > 15 | 4.4 |
| ORF-SV-F-29-01 | > 15 | 3.8 |
| ORF-SV-F-29-02 | > 15 | 3.4 |
| ORF-SV-F-29-03 | > 15 | 4.5 |
| ORF-SV-F-29-04 | > 15 | 3.8 |
| ORF-SV-G-03-02 | > 15 | 1.0 |
| ORF-SV-G-03-03 | > 15 | 1.6 |
| ORF-SV-G-03-04 | > 15 | 2.6 |
| ORF-SV-G-03-05 | > 15 | 1.6 |
| ORF-SV-G-03-10 | > 15 | 0.9 |
| ORF-SV-G-04-01 | > 15 | 6.2 |
| ORF-SV-G-04-02 | > 15 | 2.6 |
| ORF-SV-G-04-03 | > 15 | 2.2 |
| ORF-SV-G-04-04 | > 15 | 1.3 |

TABLE 3.1
 VERIFICATION SOIL SAMPLE SURVEY
 PROPERTY RF-480

| LOCATION/SAMPLE ID | SAMPLE DEPTH (cm) | RA-226 CONC. (pCi/g) |
|---------------------|-------------------|----------------------|
| ORF-SV-G-04-05 | > 15 | 1.4 |
| ORF-SV-G-04-06 | > 15 | 2.3 |
| ORF-SV-G-04-07 | > 15 | 1.5 |
| ORF-SV-G-04-08 | > 15 | 1.4 |
| ORF-SV-G-04-09 | > 15 | 1.1 |
| ORF-SV-G-04-10 | > 15 | 2.2 |
| ORF-SV-G-05-01 | > 15 | 0.9 |
| ORF-SV-G-05-02 | > 15 | 2.2 |
| ORF-SV-G-05-03 | > 15 | 2.4 |
| ORF-SV-G-05-04 | > 15 | 1.5 |
| ORF-SV-G-05-05 | > 15 | 1.0 |
| ORF-SV-G-05-06 | > 15 | 2.0 |
| ORF-SV-G-05-07 | > 15 | 2.5 |
| ORF-SV-G-05-08 | > 15 | 1.6 |
| ORF-SV-G-05-09 | > 15 | 2.3 |
| ORF-SV-G-06-01 | > 15 | 1.7 |
| ORF-SV-G-06-02 | > 15 | 1.5 |
| ORF-SV-G-06-03 | > 15 | 1.9 |
| ORF-SV-G-06-04 | > 15 | 2.5 |
| ORF-SV-G-06-05 | > 15 | 1.7 |
| GRID #1 RFL-SV-5902 | > 15 | 3.1 |
| GRID #2 RFL-SV-5920 | > 15 | 3.3 |
| GRID #3 RFL-SV-5916 | > 15 | 4.1 |
| GRID #4 RFL-SV-5895 | > 15 | 5.1 |

TABLE 3.1
 VERIFICATION SOIL SAMPLING SURVEY
 PROPERTY RF-480

| LOCATION/SAMPLE ID | SAMPLE DEPTH (cm) | RA-226 CONC. (pCi/g) |
|----------------------|----------------------|-------------------------|
| GRID #5 RFL-SV-5926 | > 15 | 4.1 |
| GRID #6 RFL-SV-5906 | > 15 | 9.3 |
| GRID #7 RFL-SV-5899 | > 15 | 7.2 |
| GRID #8 RFL-SV-5934 | > 15 | 5.9 |
| GRID #9 RFL-SV-5910 | > 15 | 9.4 |
| GRID #10 RFL-SV-5928 | > 15 | 8.5 |
| GRID #11 RFL-SV-5950 | > 15 | 3.7 |
| GRID #12 RFL-SV-5930 | > 15 | 3.8 |
| GRID #13 RFL-SV-5953 | > 15 | 2.7 |
| GRID #14 RFL-SV-5948 | > 15 | 3.9 |
| GRID #16 RFL-SV-5894 | > 15 | 2.0 |
| GRID #17 RFL-SV-5924 | > 15 | 6.1 |
| GRID #18 RFL-SV-5918 | > 15 | 4.2 |
| GRID #19 RFL-SV-5893 | > 15 | 3.4 |
| GRID #20 RFL-SV-5944 | > 15 | 2.2 |
| GRID #21 RFL-SV-5954 | > 15 | 2.8 |

Note that the area of excavation south of the railroad tracks, represented by Grids 1 through 21, was excavated with vicinity property RF-510 and has a separate verification grid system.

TABLE 3.2
SUPPLEMENTAL STANDARDS
DOSE RATE SURVEY
PROPERTY RF-480

| BOREHOLE ID # | LOCATION | UREM/HR |
|---------------|---------------|---------|
| 45 | N25554 E58307 | 10 |
| 43 | N25501 E58371 | 10 |
| 44 | N25529 E58371 | 10 |
| 42 | N25475 E58440 | 10 |
| 47 | N25504 E58440 | 10 |
| 41 | N25448 E58512 | 10 |
| 48 | N25478 E58512 | 10 |
| 40 | N25427 E58583 | 10 |
| 50 | N25464 E58583 | 10 |
| 39 | N25408 E58647 | 10 |
| 52 | N25433 E58647 | 10 |
| 38 | N25390 E58729 | 10 |
| 53 | N25417 E58729 | 10 |
| 37 | N25378 E58803 | 10 |
| 54 | N25412 E58803 | 15 |
| 36 | N25365 E58875 | 10 |
| 57 | N25401 E58875 | 10 |
| 35 | N25352 E58948 | 15 |
| 59 | N25385 E58948 | 10 |
| 34 | N25350 E58993 | 15 |
| 33 | N25350 E59062 | 15 |
| 32 | N25348 E59150 | 20 |
| 31 | N25358 E59236 | 20 |
| 30 | N25371 E59319 | 10 |

TABLE 3.2
SUPPLEMENTAL STANDARDS
DOSE RATE SURVEY
PROPERTY RF-480

| BOREHOLE ID # | LOCATION | UREM/HR |
|---------------|---------------|---------|
| 29 | N25382 F59387 | 10 |
| 28 | N25396 E59460 | 10 |
| 27 | N25418 E59541 | 10 |
| 26 | N25434 E59615 | 10 |
| 25 | N25449 E59688 | 20 |
| 81 | N25463 E59770 | 25 |
| 82 | N25479 E59846 | 20 |
| 22 | N25502 E59923 | 20 |
| 21 | N25517 E59991 | 40 |
| 20 | N25535 E60075 | 60 |
| 19 | N25549 E60153 | 45 |
| 18 | N25570 E60224 | 45 |
| 17 | N25586 E60290 | 85 |
| 16 | N25599 E60363 | 30 |
| 15 | N25620 E60446 | 40 |
| 14 | N25642 E60532 | 30 |
| 13 | N25656 E60599 | 53 |
| 12 | N25676 E60675 | 90 |
| 11 | N25690 E60746 | 85 |
| 10 | N25705 E60814 | 110 |
| 9 | N25733 E60929 | 121 |
| 8 | N25746 E61003 | 200 |
| 7 | N25764 E61077 | 132 |
| 6 | N25776 E61136 | 50 |

TABLE 3.2
SUPPLEMENTAL STANDARDS
DOSE RATE SURVEY
PROPERTY RF-480

| BOREHOLE ID # | LOCATION | UREM/HR |
|---------------|---------------|---------|
| 95 | N25794 E61224 | 35 |
| 1 | N25816 E61362 | 35 |
| 61 | N25865 E61362 | 20 |
| 99 | N25836 E61436 | 30 |
| 62 | N25876 E61436 | 20 |
| 101 | N25867 E61512 | 25 |
| 63 | N25889 E61512 | 10 |
| 103 | N25874 E61583 | 20 |
| 64 | N25901 E61583 | 10 |
| 104 | N25888 E61657 | 25 |
| 65 | N25924 E61657 | 20 |
| 105 | N25916 E61729 | 20 |
| 66 | N25943 E61729 | 15 |
| 107 | N25919 E61801 | 15 |
| 67 | N25964 E61801 | 10 |
| 108 | N25974 E61873 | 10 |
| 68 | N25988 E61873 | 10 |
| 109 | N25995 E61945 | 15 |
| 69 | N26020 E61945 | 10 |
| 110 | N26026 E62018 | 15 |
| 70 | N26046 E62018 | 10 |
| N/A | N25348 E59204 | 11 |
| N/A | N25348 E59198 | 11 |

TABLE 3.2
SUPPLEMENTAL STANDARDS
DOSE RATE SURVEY
PROPERTY RF-480

| <u>BOREHOLE ID #</u> | <u>LOCATION</u> | <u>UREM/HR</u> |
|----------------------|-----------------|----------------|
| N/A | N25348 E59188 | 9 |
| N/A | N25344 E59188 | 9 |

TABLE 3.3
 SUPPLEMENTAL STANDARDS
 OUTDOOR GAMMA AND BOREHOLE SURVEY
 PROPERTY RF-480

| BOREHOLE ID# | LOCATION | CONTAM. DEPTH | MICRO R/HK |
|--------------|---------------|---------------|------------|
| 1 | N25816 E61362 | 0-18" | 48 |
| 2 | N25826 E61362 | SURFACE | 24 |
| 3 | N25816 E61297 | 0-30" | 77 |
| 4 | N25804 E61297 | 0-48" | 45 |
| 5 | N25799 E61224 | 0-30" | 42 |
| 6 | N25776 E61136 | 0-24" | 123 |
| 7 | N25764 E61077 | 0-42" | 255 |
| 8 | N25746 E61003 | 0-48" + | 326 |
| 9 | N25733 E60929 | 0-48" | 333 |
| 10 | N25705 E60814 | 0-48" | 56 |
| 11 | N25690 E60746 | 0-24" | 162 |
| 12 | N25676 E60675 | 0-30" | 207 |
| 13 | N25656 E60599 | 0-30" | 123 |
| 14 | N25642 E60532 | 0-18" | 81 |
| 15 | N25620 E60446 | 0-30" | 97 |
| 16 | N25599 E60363 | 0-48" | 53 |
| 17 | N25586 E60290 | 0-30" | 103 |
| 18 | N25570 E60224 | 0-18" | 76 |
| 19 | N25549 E60153 | 0-18" | 105 |
| 20 | N25535 E60075 | 0-12" | 68 |
| 21 | N25517 E59991 | 0-18" | 44 |
| 22 | N25502 E59923 | 0-12" | 45 |

TABLE 3.3
 SUPPLEMENTAL STANDARDS
 OUTDOOR GAMMA AND BOREHOLE SURVEY
 PROPERTY RF-480

| BOREHOLE ID# | LOCATION | CONTAM. DEPTH | MICRO R/HR |
|--------------|---------------|---------------|------------|
| 23 | N25484 E59846 | 0-18" | 33 |
| 24 | N25468 E59770 | 0-12" | 38 |
| 25 | N25449 E59688 | NONE | 17 |
| 26 | N25434 E59615 | NONE | 17 |
| 27 | N25418 E59541 | 12-18" | 18 |
| 28 | N25396 E59460 | NONE | 13 |
| 29 | N25382 E59387 | NONE | 15 |
| 30 | N25371 E59319 | NONE | 14 |
| 31 | N25358 E59236 | SURFACE | 20 |
| 32 | N25348 E59150 | SURFACE | 24 |
| 33 | N25350 E59062 | SURFACE | 24 |
| 34 | N25350 E58995 | SURFACE | 28 |
| 35 | N25352 E58948 | SURFACE | 21 |
| 36 | N25365 E58875 | NONE | 16 |
| 37 | N25378 E58803 | NONE | 16 |
| 38 | N25390 E58729 | NONE | 16 |
| 39 | N25408 E58647 | NONE | 16 |
| 40 | N25427 E58583 | NONE | 16 |
| 41 | N25448 E58512 | 0-30" | 21 |
| 42 | N25475 E58440 | 0-30" | 21 |
| 43 | N25501 E58371 | NONE | 16 |
| 44 | N25529 E58371 | NONE | 17 |
| 45 | N25554 E58307 | NONE | 17 |

TABLE 3.3
 SUPPLEMENTAL STANDARDS
 OUTDOOR GAMMA AND BOREHOLE SURVEY
 PROPERTY RF-480

| BOREHOLE ID# | LOCATION | CONTAM. DEPTH | MICRO R/HR |
|--------------|---------------|---------------|------------|
| 46 | N25542 E58371 | NONE | 17 |
| 47 | N25504 E58440 | NONE | 17 |
| 48 | N25478 E58512 | NONE | 15 |
| 49 | N25456 E58583 | NONE | 17 |
| 50 | N25464 E58583 | 24-36" | 18 |
| 51 | N25479 E58583 | NONE | 15 |
| 52 | N25433 E58647 | NONE | 17 |
| 53 | N25417 E58729 | NONE | 16 |
| 54 | N25412 E58803 | NONE | 17 |
| 55 | N25417 E58803 | NONE | 15 |
| 56 | N25391 E58875 | NONE | 16 |
| 57 | N25401 E58875 | 12-18" | 17 |
| 58 | N25415 E58875 | 12-18" | 16 |
| 59 | N25385 E58948 | 24-30" | 18 |
| 60 | N25855 E61362 | 0-36" | 32 |
| 61 | N25865 E61362 | 0-30" | 32 |
| 62 | N25876 E61436 | SURFACE | 19 |
| 63 | N25889 E61512 | 0-30" | 20 |
| 64 | N25901 E61583 | 18-48" | 19 |
| 65 | N25924 E61657 | 0-36" | 25 |
| 66 | N25943 E61729 | NONE | 17 |
| 67 | N25964 E61801 | NONE | 18 |
| 68 | N25988 E61873 | NONE | 16 |

TABLE 3.3
 SUPPLEMENTAL STANDARDS
 OUTDOOR GAMMA AND BOREHOLE SURVEY
 PROPERTY RF-480

| BOREHOLE ID# | LOCATION | CONTAM. DEPTH | MICRO R/HR |
|--------------|---------------|---------------|------------|
| 69 | N26020 E61945 | NONE | 17 |
| 70 | N26046 E62018 | NONE | 15 |
| 71 | N25464 E58573 | NONE | 18 |
| 72 | N25464 E58593 | NONE | 18 |
| 73 | N25425 E58875 | NONE | 15 |
| 74 | N25415 E58885 | NONE | 16 |
| 75 | N25415 E58870 | NONE | 16 |
| 76 | N25401 E58885 | NONE | 16 |
| 77 | N25385 E58935 | NONE | 16 |
| 78 | N25358 E59245 | NONE | 17 |
| 79 | N25429 E59615 | NONE | 14 |
| 80 | N25444 E59688 | SURFACE | 21 |
| 81 | N25463 E59770 | 0-24" | 50 |
| 82 | N25479 E59846 | 0-18" | 38 |
| 83 | N25497 E59923 | SURFACE | 25 |
| 84 | N25512 E59991 | 0-24" | 51 |
| Pp | N25530 E60075 | 0-24" | 34 |
| 85 | N25544 E60153 | 0-36" | 41 |
| 86 | N25565 E60224 | 0-24" | 63 |
| Mm | N25581 E60290 | 0-36" | 80 |
| 87 | N25594 E60363 | 0-48" | 42 |
| 88 | N25615 E60446 | 0-36" | 78 |
| 89 | N25635 E60599 | 0-36" | 79 |

TABLE 3.3
 SUPPLEMENTAL STANDARDS
 OUTDOOR GAMMA AND BOREHOLE SURVEY
 PROPERTY RF-480

| BOREHOLE ID# | LOCATION | CONTAM. DEPTH | MICRO R/HR |
|--------------|---------------|---------------|------------|
| 90 | N25671 E60675 | 0-36" | 120 |
| 91 | N25685 E60746 | 0-36" | 118 |
| 92 | N25728 E60814 | 0-54" | 171 |
| 93 | N25725 E60929 | 0-30" | 85 |
| 94 | N25758 E61077 | 0-42" | 151 |
| 95 | N25794 E61224 | 0-18" | 45 |
| 96 | N25799 E61297 | 0-66" | 31 |
| 97 | N25812 E61362 | SURFACE | 29 |
| 98 | N25846 E61436 | 0-18" | 44 |
| 99 | N25836 E61436 | 0-36" | 46 |
| 100 | N25826 E61436 | 0-36" | 38 |
| 101 | N25867 E61512 | SURFACE | 27 |
| 102 | N25857 E61512 | 0-42" | 25 |
| 103 | N25874 E61583 | SURFACE | 25 |
| 104 | N25888 E61657 | 0-18" | 43 |
| 105 | N25916 E61729 | 0-18" | 43 |
| 106 | N25937 E61801 | NONE | 18 |
| 107 | N25919 E61801 | SURFACE | 25 |
| 108 | N25974 E61873 | 12-36" | 19 |
| 109 | N25995 E61945 | 0-18" | 25 |
| 110 | N26026 E62018 | NONE | 19 |
| 111 | N25395 E58948 | NONE | 16 |
| 112 | N25401 E58870 | NONE | 18 |

TABLE 3.3
 SUPPLEMENTAL STANDARDS
 OUTDOOR GAMMA AND BOREHOLE SURVEY
 PROPERTY RF-480

| BOREHOLE ID# | LOCATION | CONTAM. DEPTH | MICRO R/HR |
|--------------|---------------|---------------|------------|
| 113 | N25775 E61300 | NONE | 15 |
| 114 | N25785 E61362 | NONE | 17 |
| 115 | N25817 E61436 | 0-36" | 45 |
| 116 | N25844 E61512 | 0-30" | 34 |
| 117 | N25860 E61583 | 0-36" | 27 |
| 118 | N25853 E61657 | NONE | 15 |
| 119 | N25905 E61729 | 6-30" | 19 |
| 120 | N25934 E61873 | NONE | 17 |
| 121 | N25942 E61950 | NONE | 15 |
| 122 | N25959 E62017 | NONE | 13 |
| * 1A | N25348 E59198 | 30-66" | N/A |

* Note that at Borehole #1a, 30 inches of excavation had occurred before drilling began. Clean backfill was placed over the area. No surface gamma rate is available.

Exposure rates were calculated by the computer using the following formula:

$$\text{Micro R/hr} = \text{CPTM} * .006 + 6.11$$

TABLE 3.4
 SUPPLEMENTAL STANDARDS
 SOIL SAMPLE SURVEY
 PROPERTY RF-480

| SAMPLE ID # | LOCATION | DEPTH (FT.) | FINAL RA-226 CONC. (pCi/g) |
|-------------|---------------------|-------------|-------------------------------|
| RFL-SS-8271 | BH #3/N25816 E61297 | 0-2 | 14.6 |
| RFL-SS-8272 | BH #3/N25816 E61297 | 2-4 | 16.9 |
| RFL-SS-8273 | BH #2/N25826 E61362 | 0-2 | 10.5 |
| RFL-SS-8317 | BH #5/N25799 E61224 | 0-2 | 140.4 |
| RFL-SS-8318 | BH #5/N25799 E61224 | 2-4 | 178.5 |
| RFL-SS-8319 | BH #6/N25776 E61136 | 0-2 | 52.7 |
| RFL-SS-8320 | BH #6/N25776 E61136 | 2-4 | 58.3 |
| RFL-SS-8321 | BH #6/N25776 E61136 | 4-6 | 96.1 |
| RFL-SS-8322 | BH #6/N25776 E61136 | 6-8 | 1.8 |
| ORF-SS-4219 | N25813 E61128 | 0-1 | 17.3 |
| ORF-SS-4220 | N25813 E61128 | 1-2 | 72.8 |
| ORF-SS-4221 | N25813 E61128 | 2-3 | 72.5 |
| RFL-SS-8323 | BH #7/N25764 E61077 | 0-2 | 340.1 |
| RFL-SS-8324 | BH #7/N25764 E61077 | 2-4 | 227.3 |
| RFL-SS-8325 | BH #7/N25764 E61077 | 4-6 | 1.6 |
| RFL-SS-8326 | BH #7/N25764 E61077 | 6-8 | 1.3 |
| ORF-SS-4197 | N25780 E61055 | 0-1 | 203.9 |
| ORF-SS-4198 | N25780 E61055 | 1-2 | 26.3 |
| ORF-SS-4199 | N25780 E61055 | 2-3 | 30.1 |
| ORF-SS-4200 | N25780 E61055 | 3-4 | 58.8 |
| RFL-SS-8327 | BH #8/N25746 E61003 | 0-2 | 2.0 |
| RFL-SS-8328 | BH #8/N25746 E61003 | 2-4 | 386.9 |
| RFL-SS-8329 | BH #8/N25746 E61003 | 4-6 | 110.9 |

TABLE 3.4
 SUPPLEMENTAL STANDARDS
 SOIL SAMPLE SURVEY
 PROPERTY RF-480

| SAMPLE ID # | LOCATION | DEPTH (FT.) | FINAL RA-226 CONC. (pCi/g) |
|-------------|----------------------|-------------|-------------------------------|
| RFL-SS-8330 | BH #8/N25746 E61003 | 6-8 | 182.8 |
| ORF-SS-4201 | N25783 E60985 | 0-1 | 44.8 |
| ORF-SS-4202 | N25783 E60985 | 1-2 | 63.0 |
| ORF-SS-4203 | N25783 E60985 | 2-3 | 90.1 |
| ORF-SS-4204 | N25783 E60985 | 3-4 | 56.3 |
| ORF-SS-4205 | N25783 E60985 | 4-5 | 41.8 |
| ORF-SS-4206 | N25783 E60985 | 5-6 | 52.9 |
| ORF-SS-4213 | N25783 E60985 | 6-7 | 221.5 |
| RFL-SS-8331 | BH #9/N25733 E60929 | 0-2 | 23.0 |
| RFL-SS-8332 | BH #9/N25733 E60929 | 2-4 | 2.2 |
| ORF-SS-4214 | N25762 E60898 | 0-1 | 20.5 |
| ORF-SS-4215 | N25762 E60898 | 1-2 | 112.3 |
| ORF-SS-4216 | N25762 E60898 | 2-3 | 29.7 |
| ORF-SS-4217 | N25762 E60898 | 3-4 | 20.1 |
| ORF-SS-4218 | N25762 E60898 | 4-5 | 204.3 |
| RFL-SS-8333 | BH #10/N25705 E60814 | 0-2 | 93.6 |
| RFL-SS-8334 | BH #10/N25705 E60814 | 2-4 | 276.7 |
| RFL-SS-8335 | BH #10/N25705 E60814 | 4-6 | 16.1 |
| RFL-SS-8336 | BH #10/N25705 E60814 | 6-8 | 1.1 |
| RFL-SS-8337 | BH #10/N25705 E60814 | 8-10 | 0.7 |
| RFL-SS-8338 | BH #10/N25705 E60814 | 10-12 | 1.7 |
| ORF-SS-4207 | N25742 E60804 | 0-1 | 14.6 |
| ORF-SS-4208 | N25742 E60804 | 1-2 | 98.7 |

TABLE 3.4
 SUPPLEMENTAL STANDARDS
 SOIL SAMPLE SURVEY
 PROPERTY RF-480

| SAMPLE ID # | LOCATION | DEPTH (FT.) | FINAL RA-226 CONC. (pCi/g) |
|-------------|----------------------|-------------|-------------------------------|
| ORF-SS-4209 | N25742 E60804 | 2-3 | 233.8 |
| ORF-SS-4210 | N25742 E60804 | 3-4 | 76.5 |
| ORF-SS-4211 | N25742 E60804 | 4-5 | 116.0 |
| ORF-SS-4212 | N25742 E60804 | 5-6 | 43.0 |
| RFL-SS-8215 | BH #11/N25690 E60746 | 0-2 | 181.9 |
| RFL-SS-8216 | BH #11/N25690 E60746 | 2-4 | 119.3 |
| RFL-SS-8217 | BH #11/N25690 E60746 | 4-6 | 106.6 |
| RFL-SS-8218 | BH #11/N25690 E60746 | 6-8 | 32.8 |
| RFL-SS-8219 | BH #11/N25690 E60746 | 8-10 | 1.8 |
| ORF-SS-4095 | N25729 E60736 | 0-1 | 1.4 |
| ORF-SS-4191 | N25729 E60736 | 1-2 | 7.7 |
| ORF-SS-4192 | N25729 E60736 | 2-3 | 116.6 |
| ORF-SS-4096 | N25729 E60736 | 3-4 | 166.9 |
| ORF-SS-4097 | N25729 E60736 | 4-5 | 130.1 |
| ORF-SS-4193 | N25729 E60736 | 5-6 | 121.3 |
| ORF-SS-4098 | N25729 E60736 | 6-7 | 170.9 |
| ORF-SS-4099 | N25729 E60736 | 7-8 | 446.4 |
| RFL-SS-8220 | BH #12/N25676 E60675 | 0-2 | 20.9 |
| RFL-SS-8221 | BH #12/N25676 E60675 | 2-4 | 162.1 |
| RFL-SS-8222 | BH #12/N25676 E60675 | 4-6 | 45.7 |
| ORF-SS-4100 | N25707 E60668 | 0-1 | 24.6 |
| ORF-SS-4194 | N25707 E60668 | 1-2 | 17.8 |
| ORF-SS-4195 | N25707 E60668 | 2-3 | 9.6 |

TABLE 3.4
 SUPPLEMENTAL STANDARDS
 SOIL SAMPLE SURVEY
 PROPERTY RF-480

| SAMPLE ID # | LOCATION | DEPTH (FT.) | FINAL RA-226 CONC. (pCi/g) |
|--------------|----------------------|-------------|-------------------------------|
| ORF-SS-4196 | N25707 E60668 | 3-4 | 35.4 |
| ORF-SS-4101 | N25707 E60668 | 4-5 | 12.4 |
| ORF-SS-4102 | N25707 E60668 | 5-6 | 115.6 |
| RFL-SS-8223 | BH #13/N25656 E60599 | 0-2 | 39.0 |
| RFL-SS-8224 | BH #13/N25656 E60599 | 2-4 | 57.5 |
| RFL-SS-8225 | BH #13/N25656 E60599 | 4-6 | 58.8 |
| ORF-SS-4111 | N25673 E60589 | 0-1 | 37.3 |
| ORF-SS-4104 | N25673 E60589 | 1-2 | 24.1 |
| ORF-SS-4112 | N25673 E60589 | 2-3 | 47.5 |
| ORF-SS-4087 | N25673 E60589 | 3-4 | 47.8 |
| ORF-SS-4088 | N25673 E60589 | 4-5 | 34.9 |
| ORF-SS-4089 | N25673 E60589 | 5-6 | 43.9 |
| RFL-SS-8226 | BH #14/N25642 E60532 | 0-2 | 72.9 |
| RFL-SS-8227 | BH #14/N25642 E60532 | 2-4 | 65.2 |
| RFL-SS-8228 | BH #14/N25642 E60532 | 4-6 | 54.2 |
| ORF-SS-4103 | N25675 E60523 | 0-1 | 2.4 |
| ORF-SS-4177 | N25675 E60523 | 1-2 | 21.1 |
| ORF-SS-4178 | N25675 E60523 | 2-3 | 47.6 |
| ORF-SS-4179 | N25675 E60523 | 3-4 | 32.4 |
| ORF-SS-4180 | N25675 E60523 | 4-5 | 11.0 |
| RFL-SS-8229 | BH #15/N25620 E60446 | 0-2 | 50.8 |
| RFL-SS-8230 | BH #15/N25620 E60446 | 2-4 | 40.5 |
| *ORF-SS-4173 | N25657 E60436 | 0-1 | 5.7 |

TABLE 3.4
 SUPPLEMENTAL STANDARDS
 SOIL SAMPLE SURVEY
 PROPERTY RF-480

| SAMPLE ID # | LOCATION | DEPTH (FT.) | FINAL RA-226 CONC. (pCi/g) |
|-------------|----------------------|-------------|-------------------------------|
| ORF-SS-4094 | N25657 E60436 | 1-2 | 14.0 |
| ORF-SS-4174 | N25657 E60436 | 2-3 | 15.1 |
| ORF-SS-4175 | N25657 E60436 | 3-4 | 40.8 |
| ORF-SS-4176 | N25657 E60436 | 4-5 | 228.5 |
| RFL-SS-8231 | BH #16/N25599 E60363 | 0-2 | 29.9 |
| RFL-SS-8232 | BH #16/N25599 E60363 | 2-4 | 12.5 |
| RFL-SS-8233 | BH #16/N25599 E60363 | 4-6 | 21.4 |
| RFL-SS-8234 | BH #16/N25599 E60363 | 6-8 | 21.3 |
| RFL-SS-8235 | BH #16/N25599 E60363 | 8-10 | 1.8 |
| ORF-SS-4160 | N25637 E60348 | 0-1 | 2.0 |
| ORF-SS-4161 | N25637 E60348 | 1-2 | 3.0 |
| ORF-SS-4162 | N25637 E60348 | 2-3 | 10.1 |
| ORF-SS-4121 | N25637 E60348 | 3-4 | 10.6 |
| ORF-SS-4091 | N25637 E60348 | 4-5 | 48.2 |
| ORF-SS-4163 | N25637 E60348 | 5-6 | 6.4 |
| ORF-SS-4169 | N25637 E60348 | 6-7 | 317.2 |
| RFL-SS-8236 | BH #17/N25586 E60290 | 0-2 | 473.9 |
| RFL-SS-8237 | BH #17/N25586 E60290 | 2-4 | 121.8 |
| ORF-SS-4170 | N25619 E60282 | 0-1 | 12.5 |
| ORF-SS-4171 | N25619 E60282 | 1-2 | 8.6 |
| ORF-SS-4172 | N25619 E60282 | 2-3 | 4.4 |
| ORF-SS-4093 | N25619 E60282 | 3-4 | 18.2 |
| RFL-SS-8238 | BH #18/N25570 E60224 | 0-2 | 65.6 |

TABLE 3.4
 SUPPLEMENTAL STANDARDS
 SOIL SAMPLE SURVEY
 PROPERTY RF-480

| SAMPLE ID # | LOCATION | DEPTH (FT.) | FINAL RA-226 CONC. (pCi/g) |
|--------------|----------------------|-------------|-------------------------------|
| RFL-SS-8239 | BH #18/N25570 E60224 | 2-4 | 286.7 |
| RFL-SS-8240 | BH #18/N25570 E60224 | 4-6 | 174.5 |
| ORF-SS-4090 | N25602 E60216 | 0-1 | 1.5 |
| *ORF-SS-4125 | N25602 E60216 | 1-2 | 1.4 |
| ORF-SS-4126 | N25602 E60216 | 2-3 | 0.9 |
| ORF-SS-4158 | N25602 E60216 | 3-4 | 2.5 |
| ORF-SS-4159 | N25602 E60216 | 4-5 | 21.1 |
| ORF-SS-4092 | N25602 E60216 | 5-6 | 2.8 |
| RFL-SS-8241 | BH #19/N25549 E60153 | 0-2 | 59.0 |
| RFL-SS-8242 | BH #19/N25549 E60153 | 2-4 | 55.6 |
| ORF-SS-4118 | N25585 E60143 | 0-1 | 5.8 |
| ORF-SS-4119 | N25585 E60143 | 1-2 | 1.7 |
| ORF-SS-4120 | N25585 E60143 | 2-3 | 1.9 |
| ORF-SS-4117 | N25585 E60143 | 3-4 | 6.9 |
| ORF-SS-4122 | N25585 E60143 | 4-5 | 2.5 |
| RFL-SS-8196 | BH #20/N25535 E60075 | 0-2 | 106.1 |
| RFL-SS-8197 | BH #20/N25535 E60075 | 2-4 | 287.4 |
| ORF-SS-4105 | N25571 E60064 | 0-1 | 140.9 |
| ORF-SS-4106 | N25571 E60064 | 1-2 | 199.8 |
| ORF-SS-4107 | N25571 E60064 | 2-3 | 7.0 |
| ORF-SS-4108 | N25571 E60064 | 3-4 | 44.5 |
| ORF-SS-4109 | N25571 E60064 | 4-5 | 5.2 |
| ORF-SS-4110 | N25571 E60064 | 5-6 | 7.0 |

TABLE 3.4
 SUPPLEMENTAL STANDARDS
 SOIL SAMPLE SURVEY
 PROPERTY RF-480

| SAMPLE ID # | LOCATION | DEPTH (FT.) | FINAL RA-226 CONC. (pCi/g) |
|-------------|----------------------|-------------|-------------------------------|
| RFL-SS-8198 | BH #21/N25517 E59991 | 0-2 | 119.2 |
| RFL-SS-8199 | BH #21/N25517 E59991 | 2-4 | 288.7 |
| ORF-SS-4028 | N25550 E59984 | 0-1 | 4.1 |
| ORF-SS-4029 | N25550 E59984 | 1-2 | 5.8 |
| ORF-SS-4030 | N25550 E59984 | 2-3 | 4.6 |
| ORF-SS-4032 | N25550 E59984 | 3-4 | 2.5 |
| ORF-SS-4031 | N25550 E59984 | 4-5 | 1.3 |
| ORF-SS-4033 | N25550 E59984 | 5-6 | 4.3 |
| ORF-SS-4034 | N25550 E59984 | 6-7 | 15.9 |
| RFL-SS-8200 | BH #22/N25502 E59923 | 0-2 | 26.5 |
| RFL-SS-8201 | BH #22/N25502 E59923 | 2-4 | 25.6 |
| RFL-SS-8202 | BH #22/N25502 E59923 | 4-6 | 17.7 |
| ORF-SS-4051 | N25535 E59912 | 0-1 | 13.2 |
| ORF-SS-4052 | N25535 E59912 | 1-2 | 1.7 |
| ORF-SS-4053 | N25535 E59912 | 2-3 | 49.6 |
| ORF-SS-4054 | N25535 E59912 | 3-4 | 3.9 |
| ORF-SS-4055 | N25535 E59912 | 4-5 | 1.8 |
| ORF-SS-4056 | N25535 E59912 | 5-6 | 4.4 |
| ORF-SS-4060 | N25535 E59912 | 6-7 | 11.9 |
| RFL-SS-8203 | BH #23/N25484 E59846 | 0-2 | 29.2 |
| RFL-SS-8204 | BH #23/N25484 E59846 | 2-4 | 53.8 |
| RFL-SS-8205 | BH #23/N25484 E59846 | 4-6 | 9.8 |
| RFL-SS-8206 | BH #23/N25484 E59846 | 6-8 | 9.4 |

TABLE 3.4
 SUPPLEMENTAL STANDARDS
 SOIL SAMPLE SURVEY
 PROPERTY RF-480

| SAMPLE ID # | LOCATION | DEPTH (FT.) | FINAL RA-226 CONC. (pCi/g) |
|-------------|----------------------|-------------|-------------------------------|
| ORF-SS-4020 | N25518 E59836 | 0-1 | 1.6 |
| ORF-SS-4022 | N25518 E59836 | 1-2 | 2.2 |
| ORF-SS-4023 | N25518 E59836 | 2-3 | 2.3 |
| ORF-SS-4024 | N25518 E59836 | 3-4 | 4.0 |
| ORF-SS-4025 | N25518 E59836 | 4-5 | 2.7 |
| ORF-SS-4027 | N25518 E59836 | 5-6 | 2.7 |
| ORF-SS-4026 | N25518 E59836 | 6-7 | 16.8 |
| RFL-SS-8207 | BH #81/N25463 E59770 | 0-2 | 9.9 |
| RFL-SS-8208 | BH #81/N25463 E59770 | 2-4 | 8.9 |
| ORF-SS-4082 | N25499 E59762 | 0-1 | 1.4 |
| ORF-SS-4083 | N25499 E59762 | 1-2 | 2.3 |
| ORF-SS-4084 | N25499 E59762 | 2-3 | 4.8 |
| ORF-SS-4085 | N25499 E59762 | 3-4 | 5.0 |
| ORF-SS-4086 | N25499 E59762 | 4-5 | 15.3 |
| RFL-SS-8209 | BH #25/N25449 E59688 | 0-2 | 9.0 |
| RFL-SS-8210 | BH #25/N25449 E59688 | 2-4 | 20.9 |
| ORF-SS-4072 | N25479 E59674 | 0-1 | 3.9 |
| ORF-SS-4073 | N25479 E59674 | 1-2 | 5.0 |
| ORF-SS-4074 | N25479 E59674 | 2-3 | 6.7 |
| ORF-SS-4075 | N25479 E59674 | 3-4 | 358.3 |
| ORF-SS-4076 | N25479 E59674 | 4-5 | 31.1 |
| ORF-SS-4077 | N25464 E59608 | 0-1 | 2.5 |
| ORF-SS-4078 | N25464 E59608 | 1-2 | 1.7 |

TABLE 3.4
 SUPPLEMENTAL STANDARDS
 SOIL SAMPLE SURVEY
 PROPERTY RF-480

| SAMPLE ID # | LOCATION | DEPTH (FT.) | FINAL RA-226 CONC. (pCi/g) |
|-------------|----------------------|-------------|-------------------------------|
| ORF-SS-4079 | N25464 E59608 | 2-3 | 2.9 |
| ORF-SS-4080 | N25464 E59608 | 3-4 | 1.6 |
| ORF-SS-4081 | N25464 E59608 | 4-5 | 2.0 |
| RFL-SS-8211 | BH #27/N25418 E59541 | 0-2 | 3.1 |
| RFL-SS-8212 | BH #27/N25418 E59541 | 2-4 | 6.9 |
| RFL-SS-8213 | BH #27/N25418 E59541 | 4-6 | 7.4 |
| RFL-SS-8214 | BH #27/N25418 E59541 | 6-8 | 1.8 |
| ORF-SS-4067 | N25447 E59537 | 0-1 | 1.4 |
| ORF-SS-4068 | N25447 E59537 | 1-2 | 4.1 |
| ORF-SS-4069 | N25447 E59537 | 2-3 | 10.8 |
| ORF-SS-4070 | N25447 E59537 | 3-4 | 3.9 |
| ORF-SS-4071 | N25447 E59537 | 4-5 | 55.6 |
| ORF-SS-4035 | N25428 E59456 | 0-1 | 1.5 |
| ORF-SS-4036 | N25428 E59456 | 1-2 | 7.2 |
| ORF-SS-4042 | N25428 E59456 | 2-3 | 0.9 |
| ORF-SS-4043 | N25428 E59456 | 3-4 | 1.9 |
| ORF-SS-4044 | N25428 E59456 | 4-5 | 40.0 |
| ORF-SS-4045 | N25411 E59382 | 0-1 | 3.5 |
| ORF-SS-4048 | N25411 E59382 | 1-2 | 4.1 |
| ORF-SS-4049 | N25411 E59382 | 2-3 | 2.1 |
| ORF-SS-4050 | N25411 E59382 | 3-4 | 16.4 |
| ORF-SS-4000 | N25401 E59307 | 0-1 | 26.0 |
| ORF-SS-4001 | N25401 E59307 | 1-2 | 17.5 |

TABLE 3.4
 SUPPLEMENTAL STANDARDS
 SOIL SAMPLE SURVEY
 PROPERTY RF-480


| SAMPLE ID # | LOCATION | DEPTH (FT.) | FINAL RA-226 CONC. (pCi/g) |
|-------------|---------------|-------------|-------------------------------|
| ORF-SS-4002 | N25401 E59307 | 2-3 | 75.2 |
| ORF-SS-4003 | N25401 E59307 | 3-4 | 13.5 |
| ORF-SS-4004 | N25401 E59307 | 4-5 | 14.2 |
| ORF-SS-3969 | N25394 E59235 | 0-1 | 786.9 |
| ORF-SS-3996 | N25394 E59235 | 1-2 | 64.5 |
| ORF-SS-3997 | N25394 E59235 | 2-3 | 4.2 |
| ORF-SS-3998 | N25394 E59235 | 3-4 | 4.3 |
| ORF-SS-3999 | N25394 E59235 | 4-5 | 14.1 |
| ORF-SS-3989 | N25392 E59156 | 0-1 | 8.4 |
| ORF-SS-3990 | N25392 E59156 | 1-2 | 16.5 |
| ORF-SS-3991 | N25392 E59156 | 2-3 | 35.1 |
| ORF-SS-3992 | N25392 E59156 | 3-4 | 77.9 |
| ORF-SS-3993 | N25392 E59156 | 4-5 | 71.8 |
| ORF-SS-3994 | N25392 E59156 | 5-6 | 384.3 |
| ORF-SS-3995 | N25392 E59156 | 6-7 | 29.6 |
| ORF-SS-3971 | N25392 E59156 | 7-8 | 6.9 |
| ORF-SS-3966 | N25391 E58997 | 0-1 | 4.5 |
| ORF-SS-3978 | N25391 E58997 | 1-2 | 5.2 |
| ORF-SS-3970 | N25391 E58997 | 2-3 | 3.6 |
| ORF-SS-3965 | N25391 E58997 | 3-4 | 1.9 |
| ORF-SS-3979 | N25391 E58997 | 4-5 | 6.4 |
| ORF-SS-3980 | N25391 E58997 | 5-6 | 7.3 |
| ORF-SS-3981 | N25391 E58997 | 6-7 | 4.0 |

TABLE 3.4
 SUPPLEMENTAL STANDARDS
 SOIL SAMPLE SURVEY
 PROPERTY RF-480

| SAMPLE ID # | LOCATION | DEPTH (FT.) | FINAL RA-226 CONC. (pCi/g) |
|--------------|----------------------|-------------|-------------------------------|
| ORF-SS-3977 | N25391 E59058 | 0-1 | 5.5 |
| ORF-SS-3983 | N25391 E59058 | 1-2 | 5.9 |
| ORF-SS-3984 | N25391 E59058 | 2-3 | 7.3 |
| ORF-SS-3985 | N25391 E59058 | 3-4 | 10.0 |
| ORF-SS-3986 | N25391 E59058 | 4-5 | 3.2 |
| ORF-SS-3987 | N25391 E59058 | 5-6 | 2.4 |
| ORF-SS-3968 | N25395 E58951 | 0-1 | 2.2 |
| ORF-SS-3973 | N25395 E58951 | 1-2 | 1.9 |
| ORF-SS-3964 | N25395 E58951 | 2-3 | 1.7 |
| ORF-SS-3967 | N25395 E58951 | 3-4 | 2.3 |
| ORF-SS-3974 | N25395 E58951 | 4-5 | 1.6 |
| ORF-SS-3975 | N25395 E58951 | 5-6 | 1.1 |
| ORF-SS-3963 | N25395 E58951 | 6-7 | 1.1 |
| ORF-SS-3982 | N25395 E58951 | 7-8 | 6.5 |
| ORF-SS-3976 | N25395 E58951 | 8-9 | 3.1 |
| *RFL-SS-7513 | BH #1A/N25348 E59198 | 4-5 | 9056.0 |

* NOTES: Soil samples ORF-SS-4173 and ORF-SS-4125 are not depicted on drawings RF-480-03G and -031.

The final Ra-226 concentration is estimated for soil sample RFL-SS-7513.

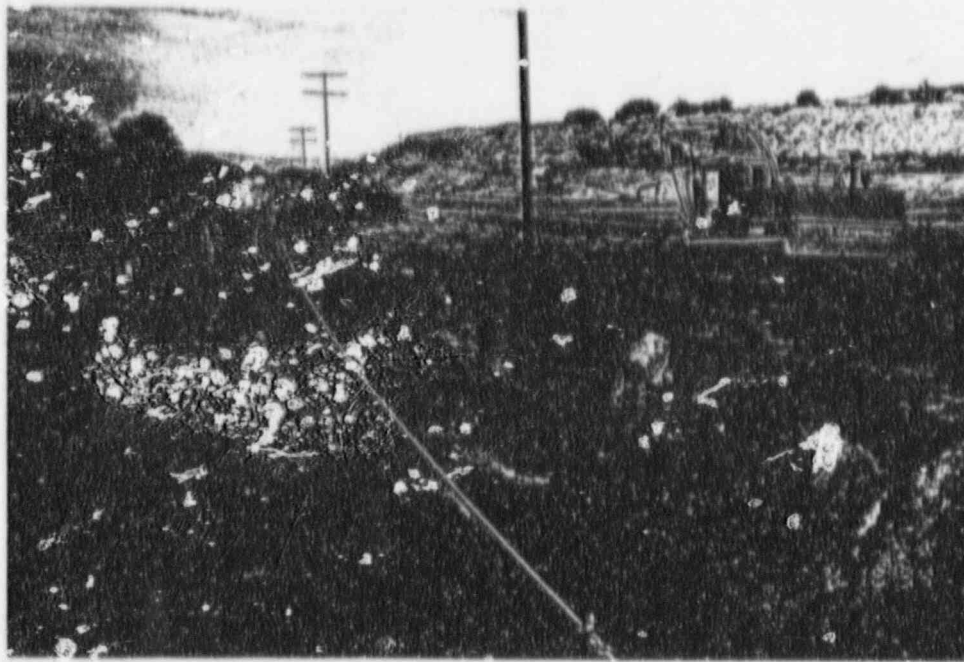


Looking West along railroad track during excavation.



Looking West during excavation.




Looking East during excavation.

 


Looking Southwest during excavation.



Looking East at remaining contaminates around poles.

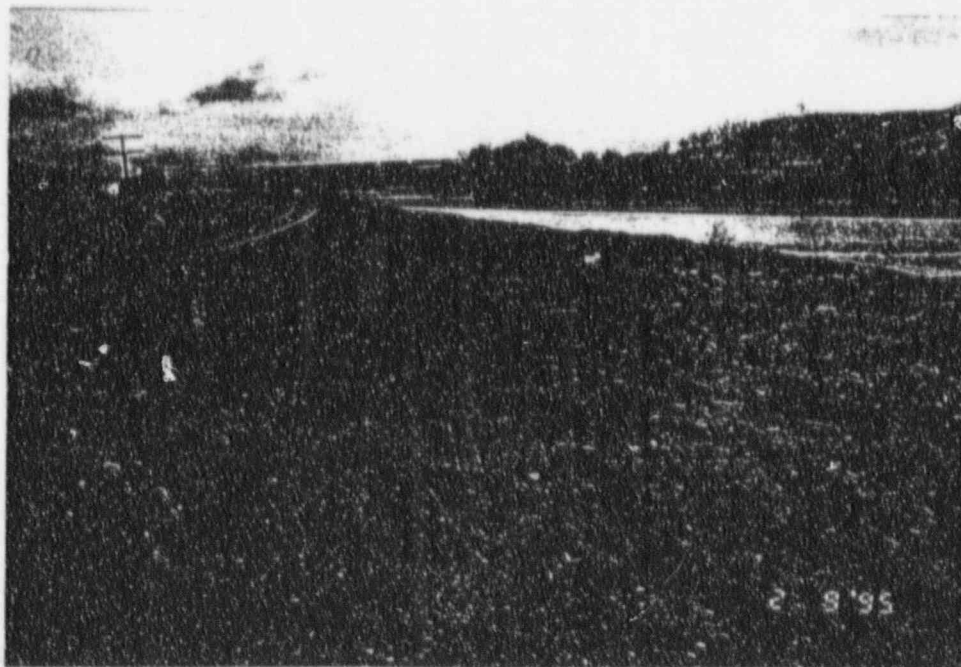

Looking East on South side of railroad track during excavation of (RF-480/RF-510).

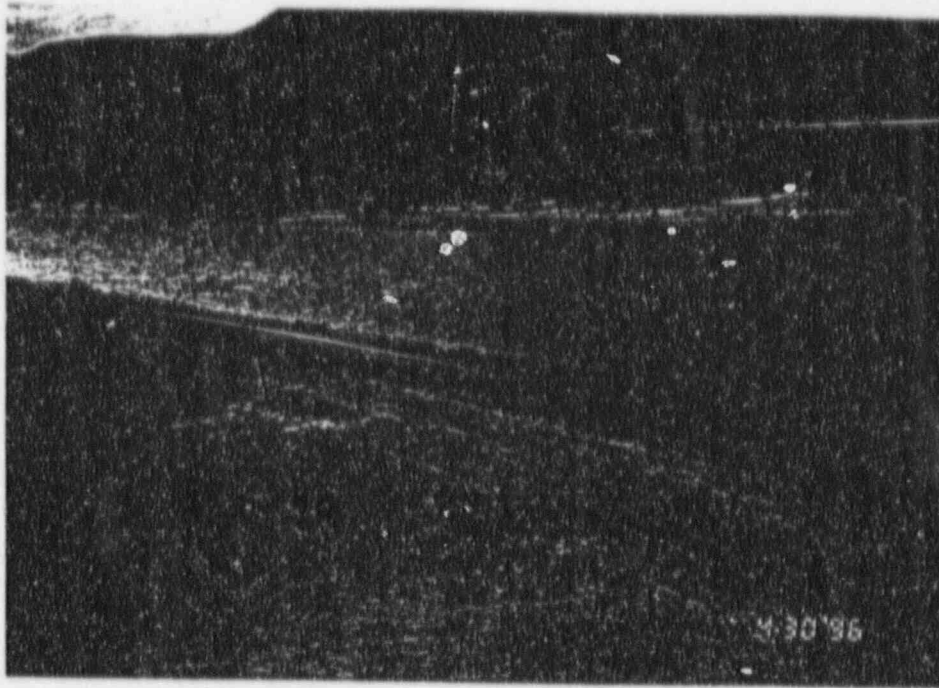

Looking Southeast after Remedial Action.



Looking East after Remedial Action.

E60,500

E60,000



REFERENCE DRAWINGS:

- RFL-PS-10-0727 ACCESS FROM WEST SIDE (SHEET 1 OF 3)
- RFL-PS-10-0728 ACCESS FROM WEST SIDE (SHEET 2 OF 3)
- RFL-PS-10-0729 ACCESS FROM WEST SIDE (SHEET 3 OF 3)

ANSTEC APERTURE CARD

Also Available on Aperture Card

LEGEND:



APPROXIMATE LIMIT AND DEPTH IN FEET OF CONTAMINATED MATERIAL TO BE EXCAVATED.

N27,000
E 59,000


CONSTRUCTION GRID COORDINATES




APPROXIMATE EXCAVATION CONTOUR



SUPPLEMENTAL STANDARDS TO BE APPLIED

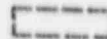

VICINITY PROPERTIES INCLUDED IN THE CONTRACT

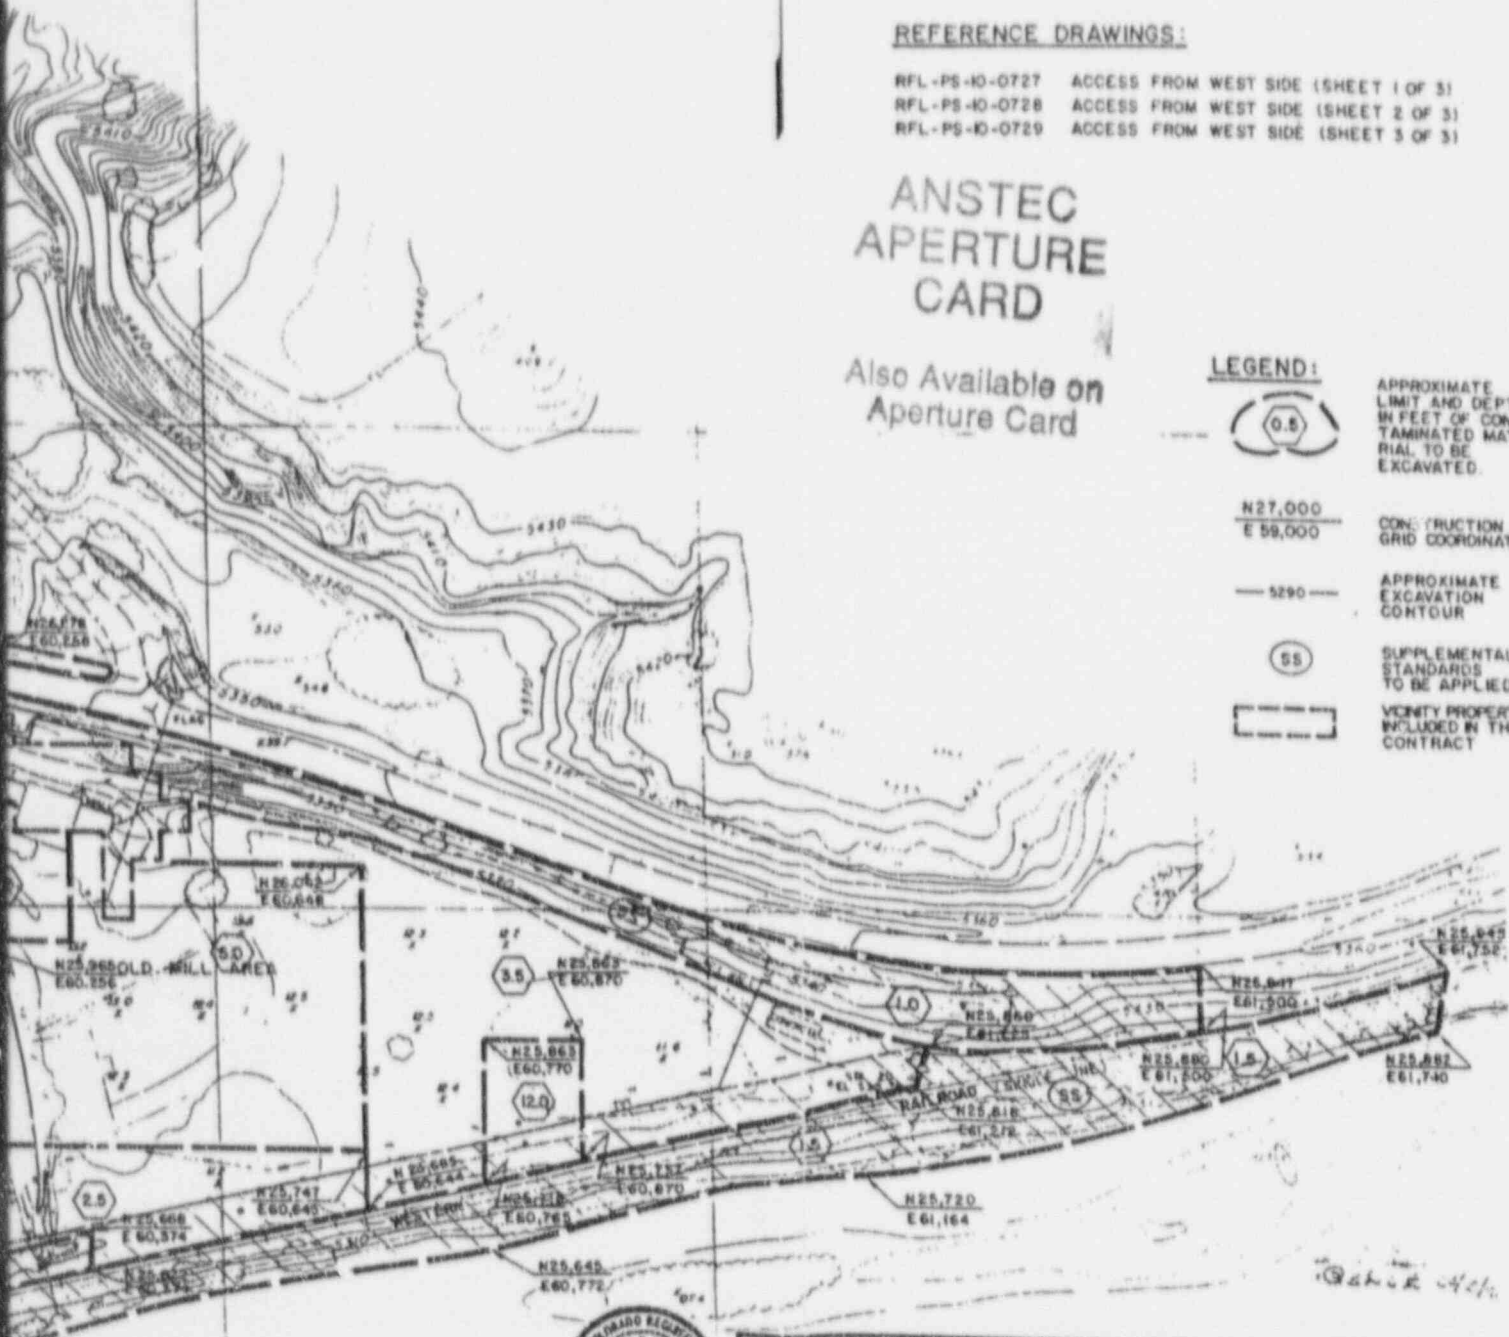

U. S. DEPARTMENT OF ENERGY
ALBUQUERQUE, NEW MEXICO

OLD RIFLE PROCESSING SITE
RIFLE, COLORADO
PHASE II CONSTRUCTION

EXCAVATION SEQUENCE AND TAILINGS EXCAVATION PLAN

| | |
|-------------|-----------|
| DESIGNED | DRANK RBC |
| CHECKED | |
| INSPECTED | SG |
| RECOMMENDED | SS |
| APPROVED | |




MORRISON-KNUDSEN ENGINEERS, INC.

ULTRA PROJECT
401 HAYWARD ST. SAN FRANCISCO, CA 94102

| | |
|-------------|-------------------|
| PROJECT NO. | DE-AC04-83AL18796 |
| DRAWING NO. | RFL-PS-10-0708 |
| REV. | 1 |


| | | | | | | |
|---------------------------------------|----|----|-----|------|----|-----|
| ADDED NOTE 12 & 13 AND CHANGED NOTE 5 | | | | | | |
| PLUED FOR CONSTRUCTION | | | | | | |
| REVISIONS | BY | CR | E&S | CHEF | DS | DOE |
| | | | | | | |

9709190137-01

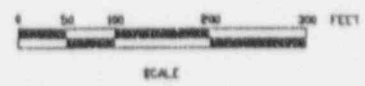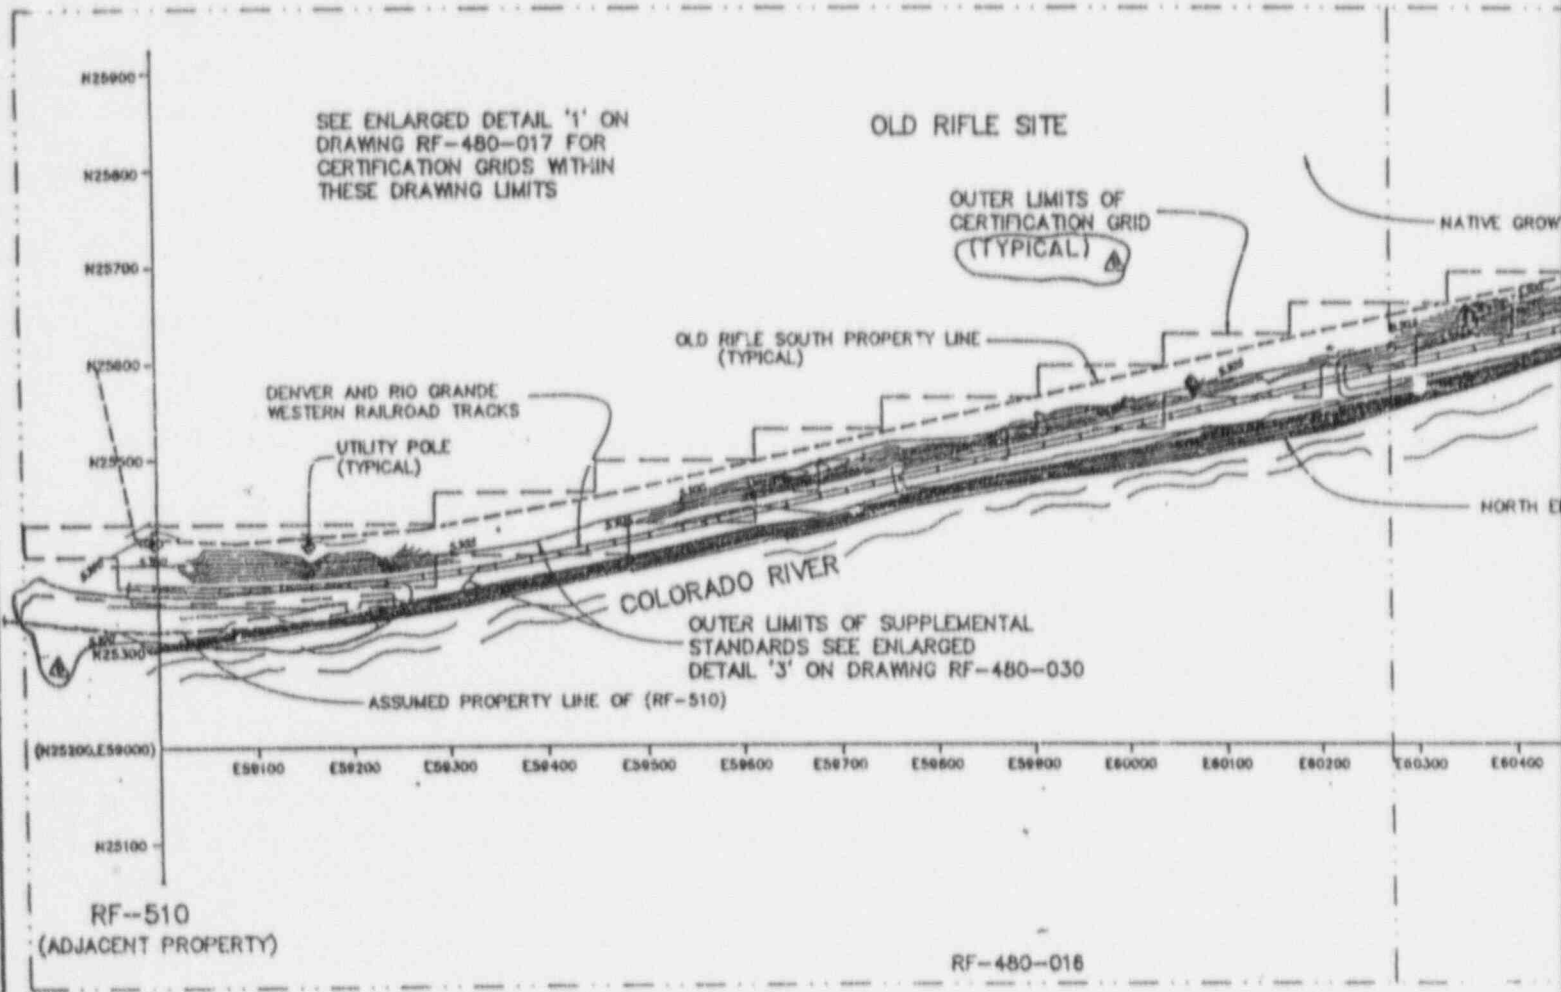


| | |
|-----|----|
| | |
| B | TH |
| A | SO |
| NO. | D |

REFERENCE DRAWING LIMITS

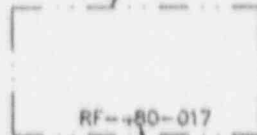

RF-480-017

REFERENCE DRAWING NO.

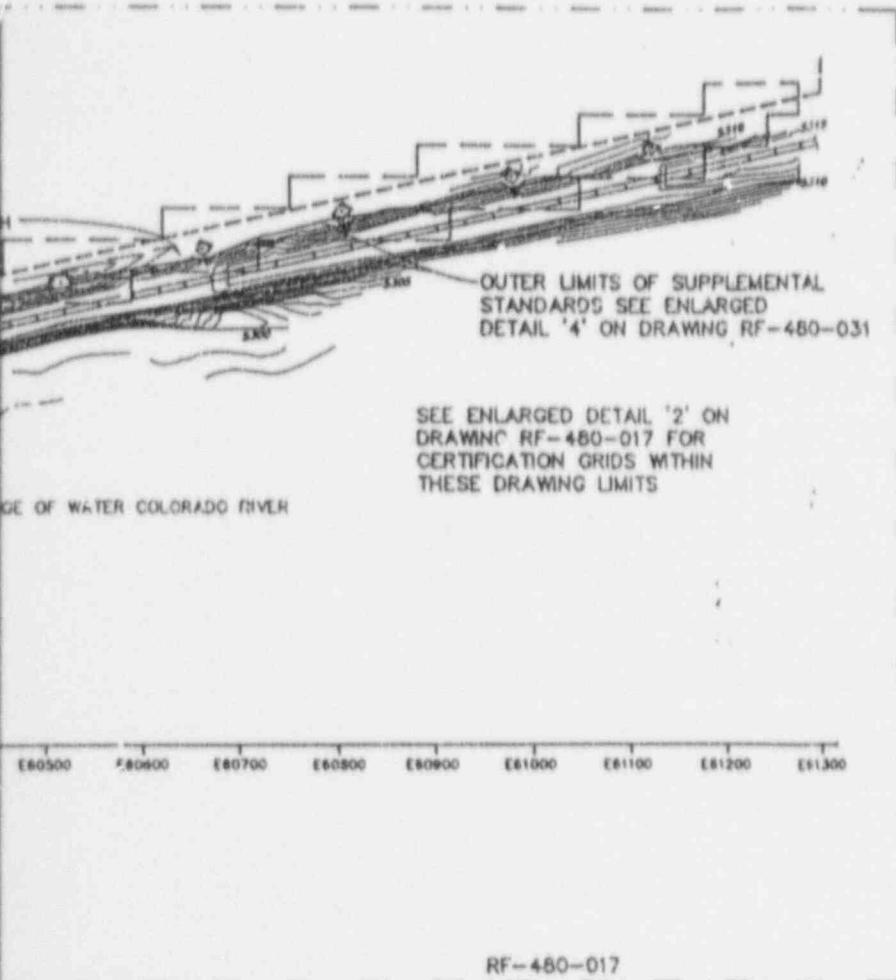

**ANSTEC
APERTURE
CARD**

Also Available on
Aperture Card

RF-480-017

**U. S. DEPARTMENT OF ENERGY
ALBUQUERQUE, NEW MEXICO**

DESIGNED BY JWH
CHECKED
REVIEWED
RECOMMENDED

**CERTIFICATION RADIOLOGICAL PLAN
RF-480**

RFLE, COLORADO
URANIUM MILL TAILINGS REMEDIAL ACTION PROJECT

APPROVED DATE PROJECT NUMBER DATE PROJECT ENGINEER DATE

NR

NR

NR



MORRISON KNUDSEN

PROJECT NO. DF-AC04-83AL18796
DRAWING NO. RF-480-015

REV. B

| NO. | REVISIONS | DATE | BY | CHECKED BY | APPROVAL LOC | APPROVAL DATE | PROJ. ENG. | APPROVAL DATE |
|-----|------------------------------------------------------|------|-----|------------|--------------|---------------|------------|---------------|
| 1 | REMOVED NOTES ADDED CERTIFICATION SOUTH OF TRACKS | | PGC | | | | | |
| 2 | ISSUE FOR CERTIFICATION SURVEY | | JWH | | | | | |

4709190137-02



N25900

N25800

N25700

N25600

N25500

N25300

N25100

OLD RIFLE SITE

OUTER LIMITS OF CERTIFICATION GRID AREA

UTILITY POLE (TYPICAL)

OLD RIFLE SOUTH PROPERTY LINE (TYPICAL)

DENVER AND RIO GRANDE WESTERN RAILROAD TRACKS

NATIVE GROWTH

COLORADO RIVER

SEE DETAIL '2' FOR VERIFICATION GRIDS THIS GRID AREA

ASSUMED PROPERTY LINE OF (RF-510)

(N25200, E59000)

E58900

E59100

E59200

E59300

E59400


E59500

E59600



E59700

RF-510
(ADJACENT PROPERTY)

ENLARGED DETAIL '1'

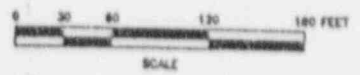


| | |
|-----|------|
| | |
| | |
| B | |
| A | |
| NO. | DATE |

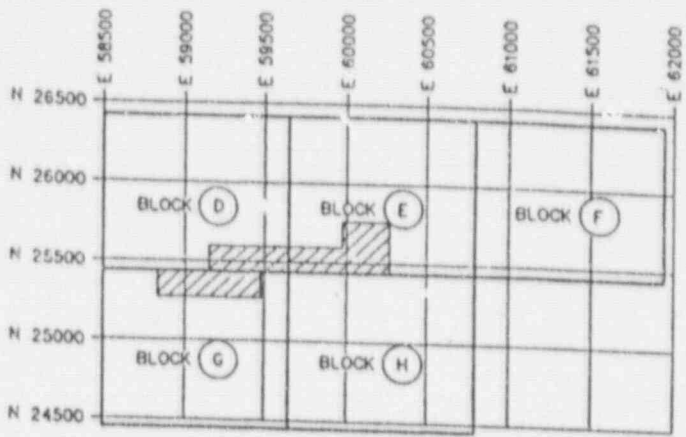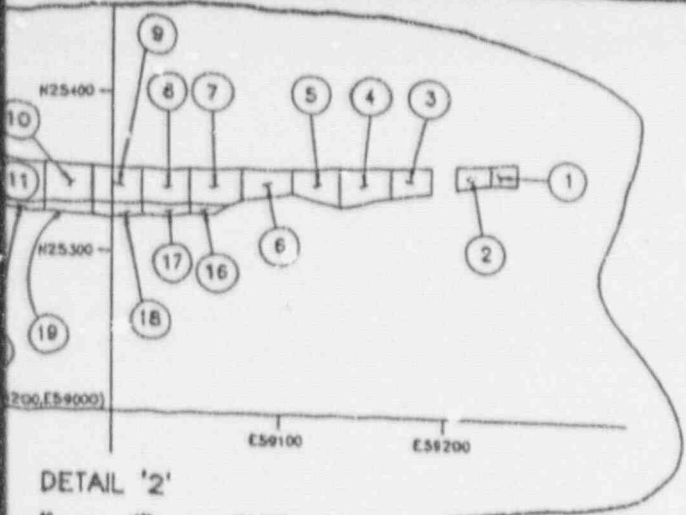

KEY MAP

- NOTES:
- SEE DRAWING RF-480-015 FOR OVERALL CERTIFICATION GRID LOCATION AND GENERAL NOTES.

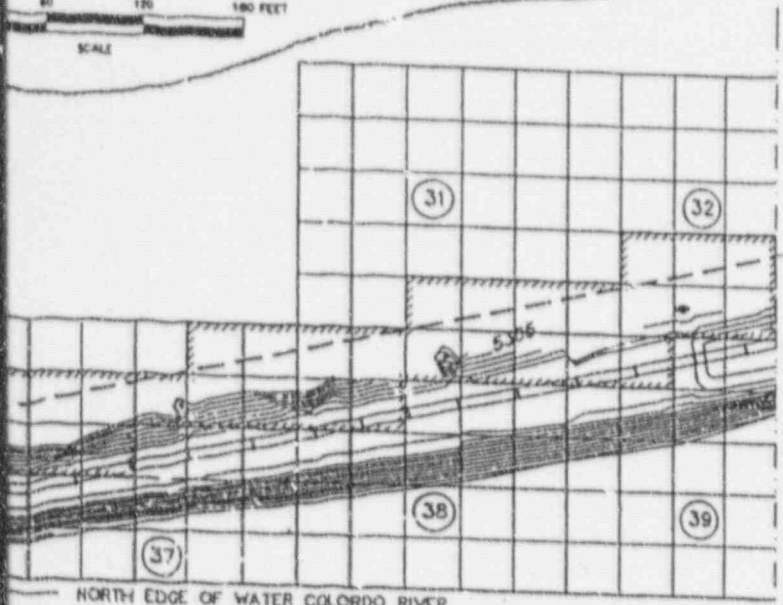

LEGEND



| | | 50M | | | | |
|-----|-----|-----|-----|-----|-----|-----|
| | | 10M | 10M | 10M | 10M | 10M |
| 50M | 10M | 1 | 2 | 3 | 4 | 5 |
| | 10M | 6 | 7 | 8 | 9 | 10 |
| | 10M | 11 | 12 | 13 | 14 | 15 |
| | 10M | 16 | 17 | 18 | 19 | 20 |
| | 10M | 21 | 22 | 23 | 24 | 25 |

SAMPLE GRID NO.
E-37-8
E - BLOCK NO. (SEE KEY MAP ABOVE)
37 - 50M X 50M GRID
8 - 10M X 10M SUBGRID

50M X 50M GRID

ANSTEC APERTURE CARD

Also Available on Aperture Card

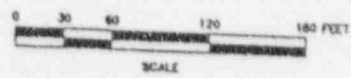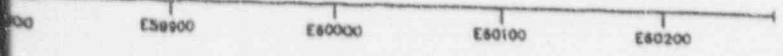

U. S. DEPARTMENT OF ENERGY
ALBUQUERQUE, NEW MEXICO

CERTIFICATION RADIOLOGICAL PLAN
RF-480

RIFLE, COLORADO
URANIUM MILL TAILINGS REMEDIAL ACTION PROJECT

DESIGNED BY JWH
CHECKED
REVIEWED
RECOMMENDED
APPROVED NR


DATE DOE PROJECT MANAGER NR DATE DOE PROJECT ENGINEER NR

PROJECT NO. DE-AC04-83AL18796
DRAWING NO. RF-480-016


MORRISON KNUDSEN

| REVISIONS | DATE | BY | CHKD | APPVLD | PROJ. ENG. | APPVLD. |
|----------------------------------------------------------------|------|----|------|--------|------------|---------|
| ADDED CERTIFICATION GRID AREA SOUTH OF TRACKS ADDED DETAIL '2' | | | | | | |
| ISSUE FOR CERTIFICATION SURVEY | | | | | | |

9709190137-03

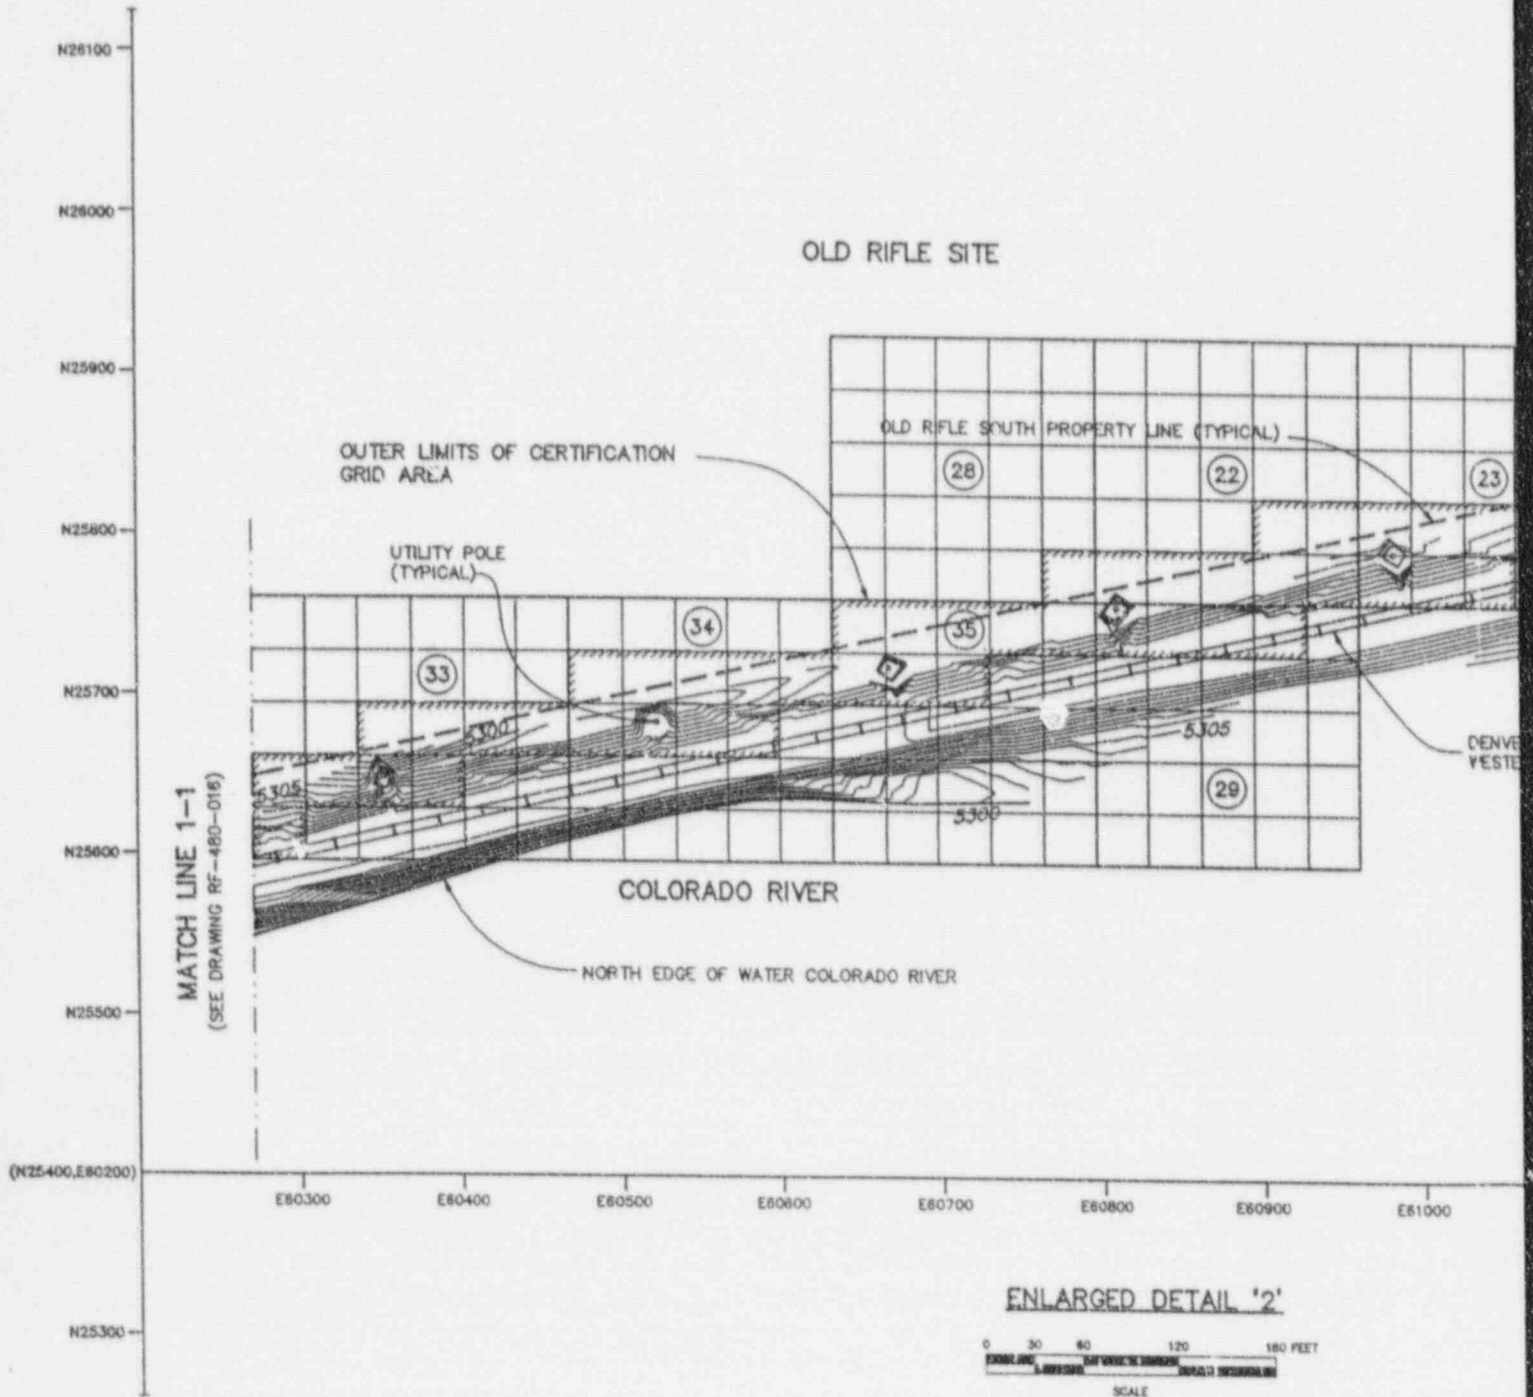



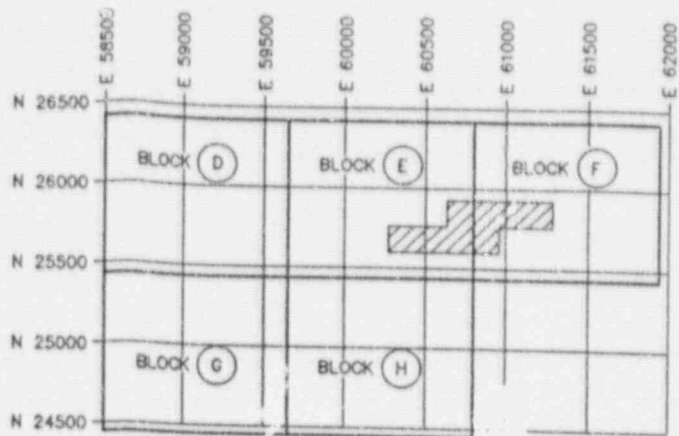

KEY MAP

NOTES:

- SEE DRAWING RF-480-015 FOR OVERALL CERTIFICATION GRID LOCATION AND GENERAL NOTES.

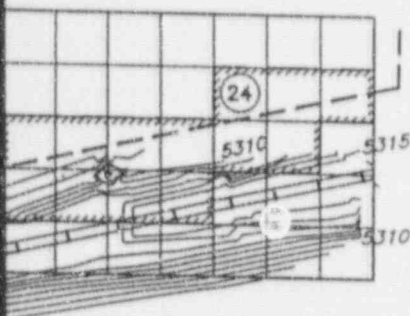


R AND RIO GRANDE
RN RAILROAD TRACKS

ANSTEC
APERTURE
CARD

Also Available on
Aperture Card

LEGEND

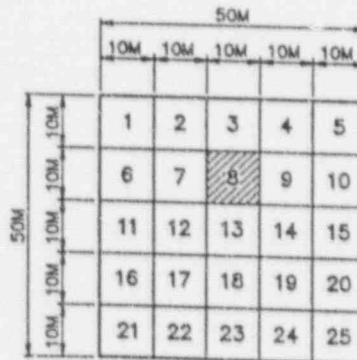

50M X 50M GRID


SAMPLE GRID NO.

E-34-8

E - BLOCK NO. (SEE
KEY MAP ABOVE)

34 - 50M X 50M GRID

8 - 10M X 10M SUBGRID

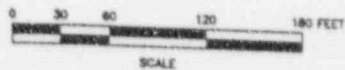

E81100 E81200 E81300 E81400

| | | | | | |
|------------------------------------------------------------------|-------------------------------------------|---------------------------|---------------------------|----------------------------|------|
| U. S. DEPARTMENT OF ENERGY ALBUQUERQUE, NEW MEXICO | | | | | |
| DESIGNED BY JWH | CERTIFICATION RADIOLOGICAL PLAN RF-480 | | | | |
| CHECKED | | | | | |
| REVIEWED | | | | | |
| RECOMMENDED | | | | | |
| APPROVED NR | DATE | DOE PROJECT MANAGER NR | DATE | DOE PROJECT ENG REPR NR | DATE |
| RIFLE, COLORADO URANIUM MILL TAILINGS REMEDIAL ACTION PROJECT | | | | | |
| PROJECT NO. DE-AC04-83A18796 | | | DRAWING NO. RF-480-017 | | |
| MORRISON KNUDSEN | | | REV. A | | |

| | | | | | | | | | |
|--------------------------------|----------|------------|--------------|-------------|-----------|--------------|--|--|--|
| ISSUE FOR CERTIFICATION SURVEY | JWH | | | | | | | | |
| REVISIONS | DRAWN BY | CHECKED BY | APPROVAL LOK | APPROVAL OH | PROJ. ENG | APPROVAL DOE | | | |

9709190137-04



N25900

N25800

N25700

N25600

N25500

N25400

N25300

N25200

(N25200, E59000)

N25100

RF-510
(ADJACENT PROPERTY)

E59100

E59200

E59300

E59400

E59500

E59600

E59700

OLD RIFLE SITE

AREA OF EXCAVATION

AREA OF EX

N25333.5
E58853.0

UTILITY POLE
(TYPICAL)

DENVER AND RIO GRANDE
WESTERN RAILROAD TRACKS

NATIVE
GROWTH

OLD RIFLE SOUTH PROPERTY LINE (TYPICAL)

COLORADO RIVER

SEE DETAIL '1' FOR COORDINATES THIS AREA OF EXCAVATION

ASSUMED PROPERTY LINE OF (RF-510)

N25419.0
E58976.0

N25421.0
E58980.0

N25386.0
E58951.0

N25390.0
E58951.0

N25390.0
E58995.0

N25392.0
E59158.0

N25413.2
E59078.0

N25427.0
E59271.5

N25392.5
E59042.0

N25393.0
E59118.4

N25397.0
E59206.0

N25403.0
E59317.0

N25412.0
E59381.0


N25434.0
E59454.0

N25462.0
E59463.0


N25468.5
E59606.0

N25494.0
E59670.0

N25518.5
E59731.0

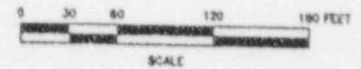

| | |
|-----|------|
| 1 | 1/4" |
| 0 | 0" |
| NO. | 0A |

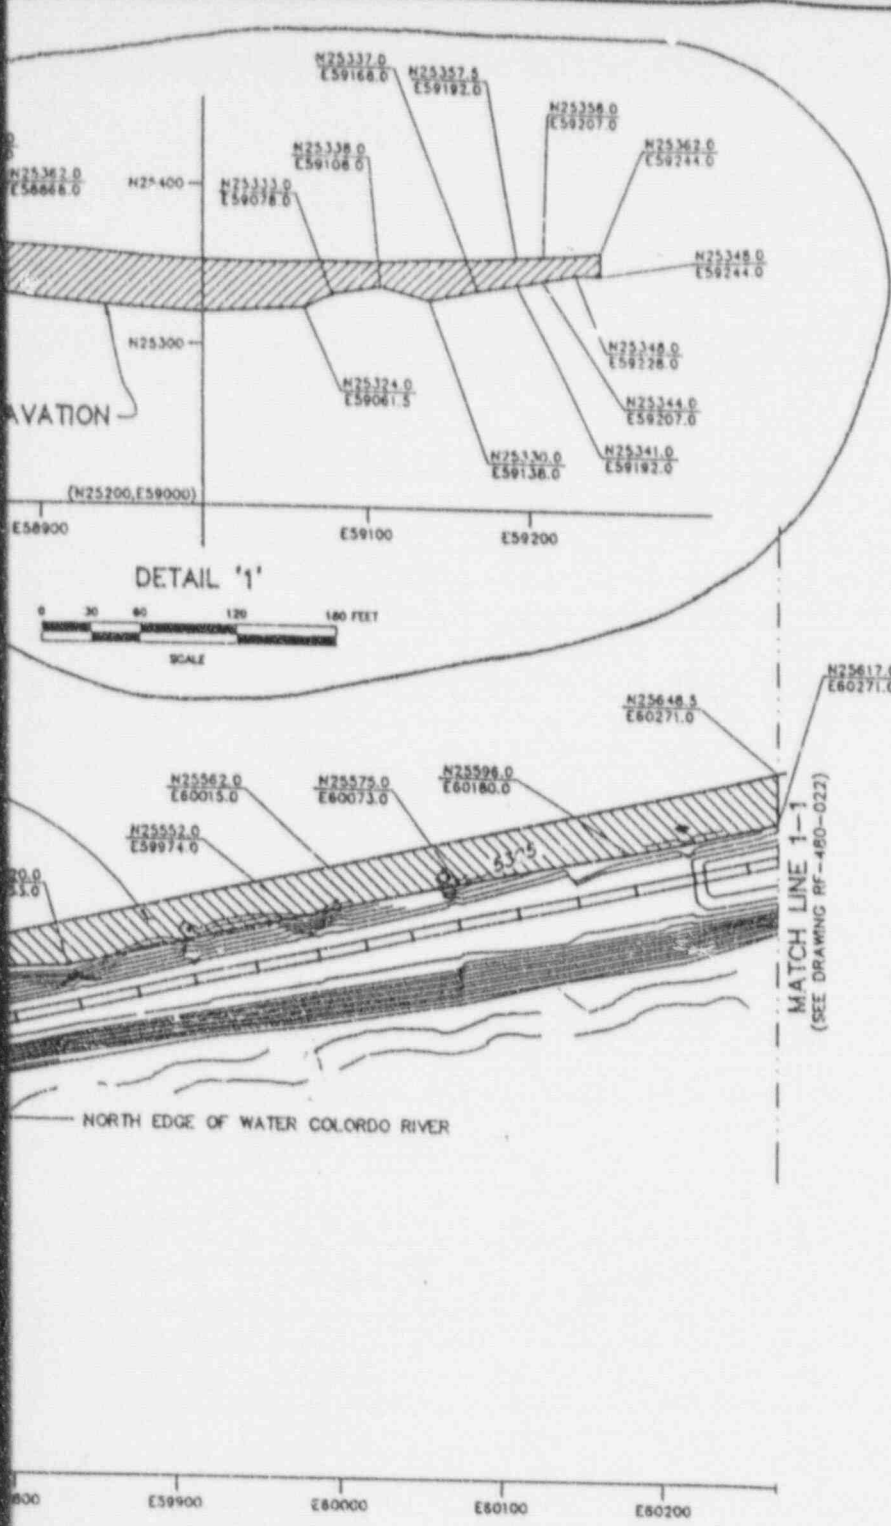

LEGEND

- W — WATER LINE
 - G — GAS LINE
 - GM — GAS MAIN
 - S — SEWER LINE
 - SM — SEWER MAIN
 - STM — STORM SEWER
 - E — ELECTRICAL LINE
 - T — TELEPHONE LINE
 - TV — CABLE TV
 - — — — — PROPERTY LINE
 - X-X-X-X- FENCE LINE
 - ⊗ METER
 - ⊙ VALVE
 - PROPERTY PIN
 - POWER POLE
- OVERHEAD SERVICE DENOTED BY SOLID LINE
UNDERGROUND SERVICE DENOTED BY DASHED LINE

NOTES:

1. SEE DRAWING RF-480-020 FOR GENERAL NOTES AND OVERALL SITE ORIENTATION.

**ANSTEC
APERTURE
CARD**

Also Available on
Aperture Card

MATCH LINE 1-1
(SEE DRAWING RF-480-022)

AS-BUILT DRAWING

| | | | |
|------------------------------------------------------------------|------|----------------------|-------------------|
| U. S. DEPARTMENT OF ENERGY ALBUQUERQUE, NEW MEXICO | | | |
| EXCAVATION AND RESTORATION PLAN RF-480 | | | |
| RIFLE, COLORADO URANIUM MILL TAILINGS REMEDIAL ACTION PROJECT | | | |
| DESIGNED BY JHC | DATE | NOI PROJECT MANAGER | DATE |
| CHECKED BY [Signature] | | NOI PROJECT ENGINEER | DATE |
| APPROVED BY [Signature] | | | |
| NR | | NR | NR |
| MORRISON KNUDSEN | | PROJECT NO. | DE-AC04-83AL18796 |
| | | DRAWING NO. | RF-480-021 |

| | | | | | | |
|--------------------------------------------------------------|-----|-------------|------|------|------|------|
| ADDED AREA OF EXCAVATION SOUTH OF TRACKS ADDED DETAIL '1' | PGC | PAC | JHC | SSS | SSS | --- |
| AS-BUILT DRAWING | JAH | [Signature] | SSS | SSS | SSS | --- |
| REVISIONS | BY | CHKD | APPR | APPR | PROJ | APPR |
| | BT | BT | LOI | SH | ENG | DIR |

9709190137-05


LEGEND

- W ——— WATER LINE
- G ——— GAS LINE
- GM ——— GAS MAIN
- S ——— SEWER LINE
- SM ——— SEWER MAIN
- STM ——— STORM SEWER
- E ——— ELECTRICAL LINE
- T ——— TELEPHONE LINE
- TV ——— CABLE TV
- ——— PROPERTY LINE
- - - - - FENCE LINE
- ⊕ METER
- ⊙ VALVE
- PROPERTY PIN
- POWER POLE

OVERHEAD SERVICE DENOTED BY SOLID LINE
UNDERGROUND SERVICE DENOTED BY DASHED LINE

NOTES:

1. THE LATEST REVISION OF THE FOLLOWING TECHNICAL SPECIFICATIONS APPLY TO THE REMEDIAL ACTION WORK REQUIRED FOR PROPERTY NO. RF-480:
 - SECTION 02110
CLEARING AND GRUBBING
 - SECTION 02130
CONTAMINATED MATERIAL REMOVAL
 - SECTION 02200
EXCAVATION AND BACKFILL
 - SECTION 02480
LANDSCAPING
2. UTILITY LOCATIONS ARE FOR REFERENCE ONLY. SUBCONTRACTOR SHALL BE SOLELY RESPONSIBLE FOR THE ACTUAL LOCATIONS OF UTILITIES PRIOR TO START OF CONSTRUCTION.
3. THE EXCAVATION LIMITS AND DEPTHS ARE BASED ON A LIMITED NUMBER OF BORINGS TAKEN DURING THE RADIOLOGICAL SURVEYS OF THIS PROPERTY. ADDITIONAL RADIOLOGICAL SURVEYS PERFORMED DURING REMEDIAL ACTION MAY REQUIRE MORE OR LESS EXCAVATION TO BE TAKEN FROM THE DESIGNATED AREAS. ALL CHANGES TO THE LIMITS AND DEPTHS OF EXCAVATION SHOWN ON THE DESIGN DRAWINGS SHALL BE AS DIRECTED BY THE CONTRACTOR'S REPRESENTATIVE.
4. EXCAVATE AREA TO THE LIMITS INDICATED ON DRAWING RF-480-021 AND RF-480-022 TO AN AVERAGE DEPTH OF 47 INCHES. CONTRACTOR'S REPRESENTATIVE TO RESURVEY AREA BEFORE BACKFILLING. IF FURTHER CONTAMINATION IS FOUND, EXCAVATE IN 6 INCH INCREMENTS AS DIRECTED BY CONTRACTOR'S REPRESENTATIVE.
5. BACKFILL BERM AREAS WITH MATERIAL SIMILAR TO THAT REMOVED AS DEMONSTRATED TO THE CONTRACTOR'S REPRESENTATIVE BY COMPARATIVE SIEVE ANALYSIS. ALL OTHER AREAS SHALL BE BACKFILLED WITH COMPACTED COMMON FILL AND TOPPED WITH NATIVE SEED, MULCH, AND FERTILISER. GRADE TO MATCH EXISTING CONTOURS AND ELEVATIONS.
6. THE AREA OF CONTAMINATION LOCATED SOUTH OF RAILROAD TRACK WAS EXCAVATED DURING REMEDIATION OF VICINITY PROPERTY RF-510.

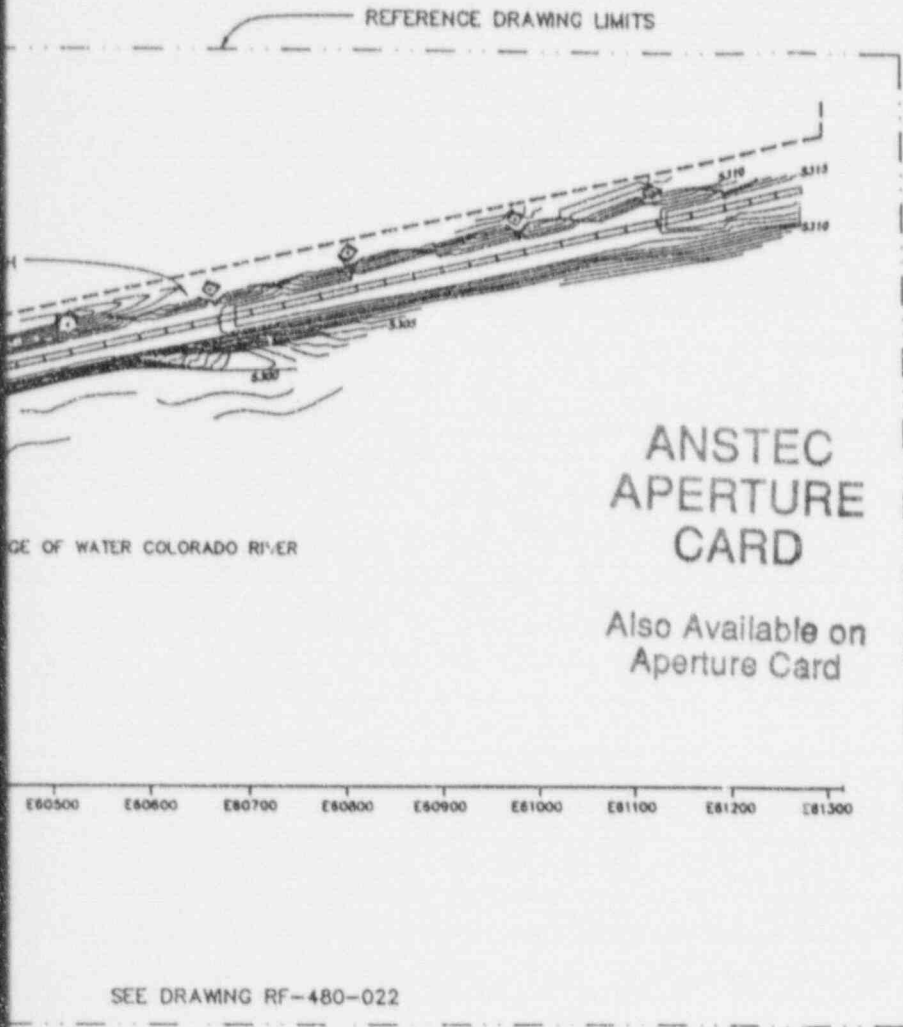

SEE DRAWING RF-480-022

AS-BUILT DRAWING

| | | | | | | | | | |
|-------------------------------------------------------|--|--|--|--|-----------------------------------------------|--|--------------------------|--|----------|
| U. S. DEPARTMENT OF ENERGY ALBUQUERQUE, NEW MEXICO | | | | | | | | | |
| DESIGNED BY: JWH | | | | | EXCAVATION AND RESTORATION KEY PLAN RF-480 | | | | |
| CHECKED BY: JWH | | | | | URANUM MILL TAILINGS REMEDIAL ACTION PROJECT | | | | |
| APPROVED BY: JWH | | | | | DATE: NR | | DOE PROJECT MANAGER: NR | | DATE: NR |
| RECOMMENDED BY: JWH | | | | | PROJECT NO.: | | DOE PROJECT ENGINEER: NR | | DATE: NR |

9709190137-06


LEGEND

- W — WATER LINE
- G — GAS LINE
- GM — GAS MAIN
- S — SEWER LINE
- SM — SEWER MAIN
- STM — STORM SEWER
- E — ELECTRICAL LINE
- T — TELEPHONE LINE
- TV — CABLE TV
- - - PROPERTY LINE
- X - X - X - X - FENCE LINE
- ⊕ METER
- ⊗ VALVE
- PROPERTY PIN
- POWER POLE

OVERHEAD SERVICE DENOTED BY SOLID LINE
UNDERGROUND SERVICE DENOTED BY DASHED LINE

NOTES:

- SEE DRAWING RF-480-020 FOR GENERAL NOTES AND OVERALL SITE ORIENTATION.

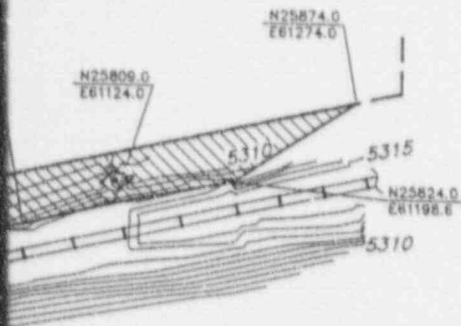

R AND RIO GRANDE
RN RAILROAD TRACKS

ANSTEC
APERTURE
CARD

Also Available on
Aperture Card

9709190137-07

E81100 E81200 E81300 E81400

AS-BUILT DRAWING


| | | | | | | | | | |
|-------------------------------------------------------------------------------------|--|-----------------------------------------------------------------------------------------|---------------------|-------------------------------------------|----------------------|-----------------------------------|------|---------------|--|
| <p align="center">U. S. DEPARTMENT OF ENERGY ALBUQUERQUE, NEW MEXICO</p> | | | | | | | | | |
| <p>DESIGNED/DRAWN JWH</p> | | <p align="center">EXCAVATION RESTORATION PLAN RF-480</p> | | | | | | | |
| <p>CHECKED <i>[Signature]</i></p> | | <p align="center">RIFLE, COLORADO URANIUM MILL TAILINGS REMEDIAL ACTION PROJECT</p> | | | | | | | |
| <p>APPROVED <i>[Signature]</i></p> | | DATE | DOE PROJECT MANAGER | DATE | DOE PROJECT ENGINEER | DATE | | | |
| NR | | | NR | | NR | | | | |
| AS-BUILT DRAWING | | JWH | <i>[Signature]</i> | <i>[Signature]</i> | <i>[Signature]</i> | <i>[Signature]</i> | | | |
| REVISIONS | | DRW | CHECK | APPR | APPR | PROJ | APPR | | |
| | | ST | UT | LOE | OH | ENG | ODE | | |
| | | | | <p>PROJECT NO. DE-ACC-4-83AL18796</p> | | <p>DRAWING NO. RF-480-022</p> | | <p>REV. 0</p> | |

LEGEND

- 22 BOREHOLE DESIGNATION
- ⊙ 19/SS-8241 BOREHOLE AND SOIL SAMPLE DESIGNATION
- SS-4118 SOIL SAMPLE DESIGNATION


ESTIMATED DEPTH OF CONTAMINATION:

- 0 TO 102 INCHES IN TRACK BED
- 0 TO 78 INCHES IN UTILITY POLE BASES

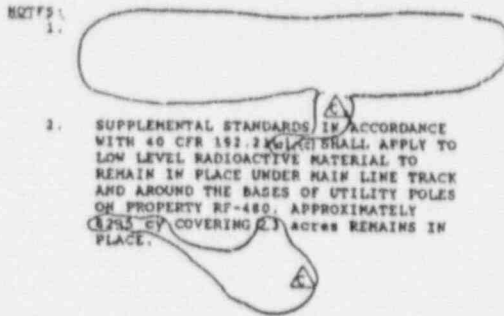

2. SUPPLEMENTAL STANDARDS IN ACCORDANCE WITH 40 CFR 192.201 SHALL APPLY TO LOW LEVEL RADIOACTIVE MATERIAL TO REMAIN IN PLACE UNDER MAIN LINE TRACK AND AROUND THE BASES OF UTILITY POLES OR PROPERTY RF-480, APPROXIMATELY COVERING 2.3 ACRES REMAINS IN PLACE.


OLD RIFLE SITE

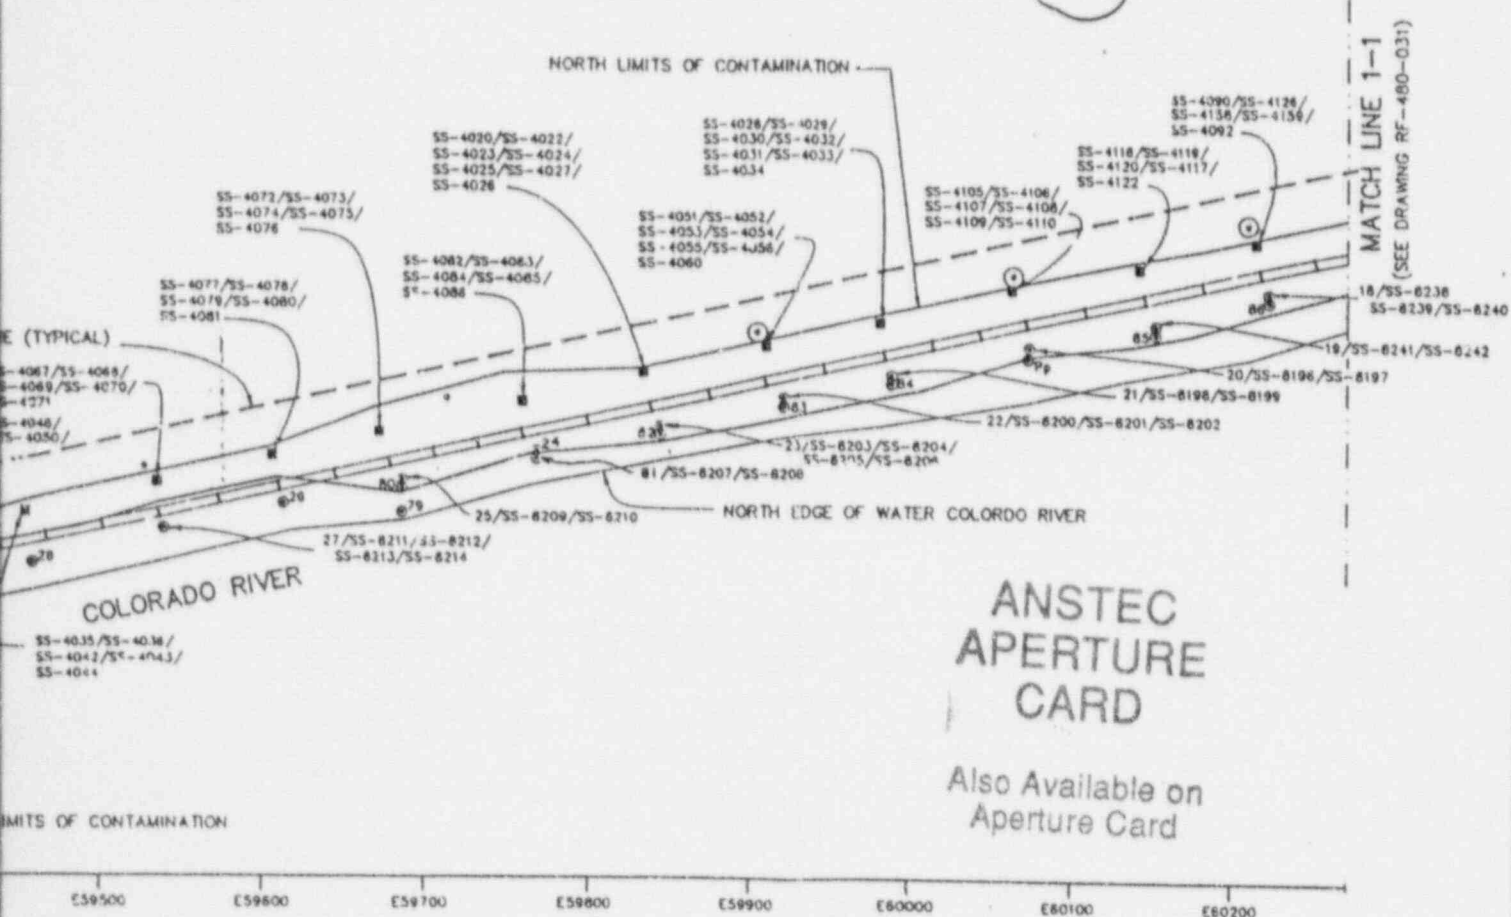

ANSTEC APERTURE CARD

Also Available on Aperture Card

ENLARGED DETAIL '3'

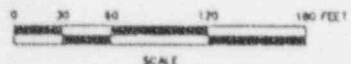

| | | | | | | | | |
|----------------------------|------|-----|---|-------------------------|-------------------|----------------------|------|----|
| U. S. DEPARTMENT OF ENERGY | | | | ALBUQUERQUE, NEW MEXICO | | | | |
| DESIGNED | BY | JWH | SUPPLEMENTAL STANDARDS SURVEY DATA RF-480 RIFLE, COLORADO URANIUM MILL TAILINGS REMEDIAL ACTION PROJECT | | | | | |
| CHECKED | BY | | | | | | | |
| REVIEWED | BY | | | | | | | |
| RECOMMENDED | BY | | | | | | | |
| APPROVED | DATE | NR | DOE PROJECT MANAGER | DATE | NR | DOE PROJECT ENGINEER | DATE | NR |
| MORRISON KNUDSEN | | | PROJECT NO. | | DE-AC04-83AL18796 | | | |
| | | | DRAWING NO. | | RF-480-030 | | | |
| REV. C | | | | | | | | |

970919D137-08



N26100

N26000

N25900

N25800

N25700

N25600

N25500

(N25400.E80200)

N25300

E80300

E80400

E80500

E80600

E80700

E80800

E80900

E81000

E81100

OLD RIFLE SITE

OLD RIFLE SOUTH PROPERTY LINE

LIMIT CONTAMINATION AROUND POLE

NORTH LIMITS OF CONTAMINATION

SS-4201/SS-4202/SS-4203/SS-4204/SS-4205/SS-4206

SS-4207/SS-4208/SS-4209/SS-4210/SS-4211/SS-4212

SS-4213/SS-4214/SS-4215/SS-4216/SS-4217/SS-4218

SS-4219/SS-4220/SS-4221/SS-4222/SS-4223/SS-4224/SS-4225





















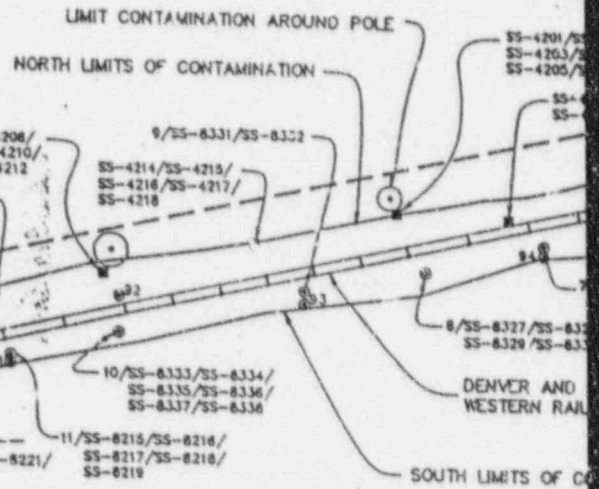


MATCH LINE 1-1
(SEE DRAWING PF-480-030)

COLORADO RIVER


NORTH EDGE OF WATER COLORADO RIVER

ENLARGED DETAIL '4'

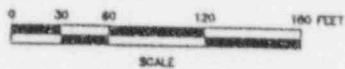

| | |
|-----|---------|
| | |
| C | (NAME) |
| B | (DATE) |
| A | (SHEET) |
| NO. | DATE |

PORTION OF THE DENVER AND RIO GRANDE
RAILROAD THAT IS IDENTIFIED AS VICINITY
PROPERTY RF-480

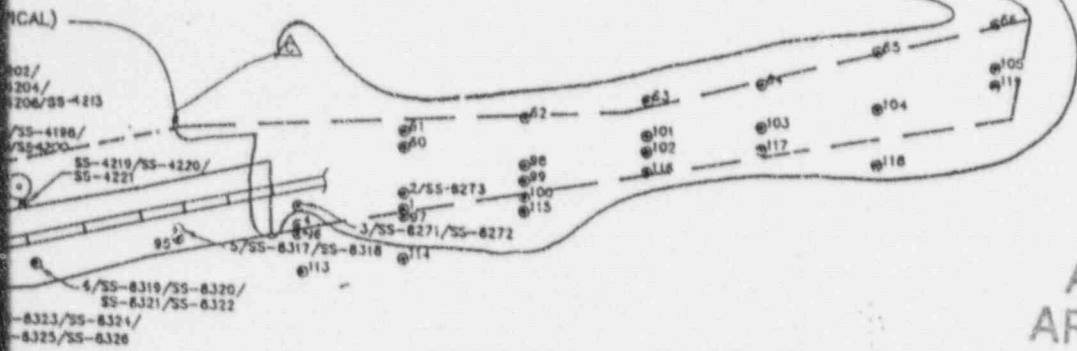


ANSTEC APERTURE CARD

Also Available on
Aperture Card

NOTES:

1. SEE DRAWING RF-480-030 FOR BOREHOLE DESIGNATION, SOIL SAMPLE DESIGNATION, AND BOREHOLE/SOIL SAMPLE DESIGNATION.
2. SEE DRAWING RF-480-030 FOR GENERAL NOTES.

9709190137-09

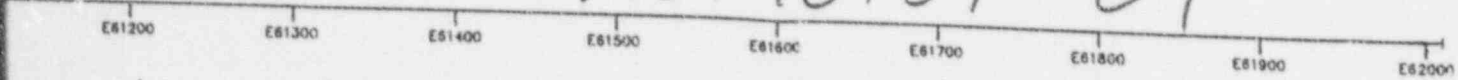

| | |
|----------------------|-------------------|
| DESIGNED BY | JWH |
| CHECKED | |
| REVIEWED | |
| RECOMMENDED | |
| APPROVED | NR |
| DATE | |
| BOE PROJECT MANAGER | NR |
| DATE | |
| BOE PROJECT ENGINEER | NR |
| DATE | |
| PROJECT NO. | DE-AC04-83AL18796 |
| DRAWING NO. | RF-480-031 |
| REV. | C |

U. S. DEPARTMENT OF ENERGY
ALBUQUERQUE, NEW MEXICO

SUPPLEMENTAL STANDARDS
SURVEY DATA
RF-480
RIFLE, COLORADO
URANIUM MILL TAILINGS REMEDIAL ACTION PROJECT

PROJECT NO. DE-AC04-83AL18796
DRAWING NO. RF-480-031

| REVISIONS | BY | CHECKED BY | APPROVAL DATE | PROJ. ENG. | APPROVAL DATE |
|-------------------------------------------|-----|------------|---------------|------------|---------------|
| CHANGED PROPERTY BOUNDARY | PGC | | | | |
| 100 Mm. SS-8273, SS-4213, SS-4200, AND 89 | PHC | | | | |
| ISSUE FOR SUPPLEMENTAL STANDARDS | JWH | | | | |

Vicinity Property No. RF-480

APPENDIX A
RADIOLOGICAL SURVEY DATA

OCS SAMPLE LOG FOR INFORMATION ONLY

RIFLES CO

SITE NAME

| COUNT DATE INITIAL 20 DAY | SAMPLE ID & LOCATION | DATE SAMPLED | DATE SEALED | OCS # INITIAL 20 DAY | BI-214 pCi INITIAL 20 DAY | TI-208 pCi INITIAL 20 DAY | MASS (grams) WET DRY | Pa-228 pCi/g INITIAL/CORR 20 DAY | Th-232 pCi/g INITIAL 20 DAY | DEPTH <15cm >15cm | TECH INITIAL 20 DAY | COMMENTS |
|---------------------------|----------------------|--------------|-------------|----------------------|---------------------------|---------------------------|----------------------|----------------------------------|-----------------------------|-------------------|---------------------|-------------------------------------------------------|
| | D-40-21 | | | | | N | A | | | | | |
| 9-12-94 | ORF-SV ✓ | 9-9-94 | 9-13-94 | 458 | 1369 | 775.0 | 595 | 2.3 | 1.3 | | AW | |
| 10-13-94 | D-40-22 | 9-9-94 | | 462 | 2184 | 602.9 | 566 | 3.9 | 1.1 | ✓ | AW | |
| 10-10-94 | ORF-SV ✓ | 10-7-94 | 10-12-94 | 428 | 860.3 | 585.5 | 561 | 1.5 | 1.0 | | AW | |
| 11-2-94 | D-40-23 | 10-7-94 | 10-12-94 | 586 | 723.0 | 871.1 | 489 | 1.5 | 1.8 | ✓ | AW | |
| 10-10-94 | ORF-SV ✓ | 10-7-94 | 10-12-94 | 530 | 808.9 | 765.8 | 550 | 1.5 | 1.4 | ✓ | AW | |
| 11-3-94 | D-40-24 | 10-7-94 | 10-12-94 | 578 | 1012 | 804.1 | 476 | 2.1 | 1.7 | ✓ | AW | |
| 10-10-94 | ORF-SV ✓ | 10-7-94 | 10-12-94 | 430 | 693.5 | 917.5 | 495 | 1.4 | 1.9 | | AW | QC Sample Ra-226 = 2.1 ± 0.4 Th-230 = 1.8 ± 0.4 |
| 11-3-94 | D-40-25 | 10-7-94 | 10-12-94 | 476 | 1134 | 655.4 | 431 | 2.0 | 1.5 | ✓ | AW | |
| | | | | | | N | A | | | | | |

Site Correction Factor = 1.8

Count Rate Correction Factor (if applicable) = 1.8

Count Time = 500 SEC, unless otherwise noted

REVIEWED BY: *Robert R. Fernald*
Site HPI Manager

FOR INFORMATION ONLY

OCS SAMPLE LOG

ITE NAME RIFLE Co.

| COUNT DATE INITIAL 20 DAY | SAMPLE ID & LOCATION | DATE SAMPLED | DATE SEALED | OCS # INITIAL 20 DAY | BI-214 pCi INITIAL 20 DAY | TI-208 pCi INITIAL 20 DAY | MASS (grams) WET DRY | Re-226 pCi/g INITIAL/CORR. 20 DAY | Th-232 pCi/g INITIAL 20 DAY | DEPTH <15cm >15cm | TECH INITIAL 20 DAY | COMMENTS |
|---------------------------|----------------------|--------------|-------------|----------------------|---------------------------|---------------------------|----------------------|-----------------------------------|-----------------------------|-------------------|---------------------|----------|
| 9-15-94 | ORF-SV | | | 576 | 700.0 | 1063 | 621 | 1.1 | 1.7 | | SS | |
| 10-14-94 | D-41-11 | 9-14-94 | 9-16-94 | 560 | 819.6 | 1034 | 582 | 1.4 | 1.8 | - | WNU | |
| 9-15-94 | ORF-SV | | | 578 | 2257 | 1034 | 617 | 3.7 | 1.7 | | SS | |
| 10-14-94 | D-41-12 | 9-14-94 | 9-16-94 | 462 | 3455 | 961.2 | 584 | 10-14-94 42.59 | 1.6 | - | WNU | |
| 9-15-94 | ORF-SV | | | 580 | 1023 | 966.8 | 587 | 1.7 | 1.6 | | SS | |
| 10-17-94 | D-41-13 | 9-14-94 | 9-16-94 | 472 | 1366 | 1119 | 548 | 2.5 | 2.0 | - | WNU | |
| 9-15-94 | ORF-SV | | | 582 | 1040 | 689.2 | 565 | 1.8 | 1.2 | | SS | |
| 10-17-94 | D-41-14 | 9-14-94 | 9-16-94 | 574 | 1424 | 871.1 | 527 | 2.7 | 1.7 | - | WNU | |
| 9-16-94 | ORF-SV | | | 510 | 1219 | 1138 | 590 | 2.1 | 1.9 | | PU | |
| 10-17-94 | D-41-15 | 9-14-94 | 9-17-94 | 560 | 1149 | 928.5 | 540 | 2.1 | 1.7 | ✓ | WNU | |
| 9-16-94 | ORF-SV | | | 512 | 311.5 | 918.9 | 609 | 0.51 | 1.5 | | PU | |
| 10-17-94 | D-41-16 | 9-14-94 | 9-17-94 | 460 | 703.0 | 952.5 | 565 | 1.2 | 1.7 | ✓ | WNU | |
| 9-16-94 | ORF-SV | | | 514 | 230.7 | 1101 | 563 | 0.41 | 2.0 | | PU | |
| 10-17-94 | D-41-17 | 9-14-94 | 9-17-94 | 562 | 822.8 | 650.9 | 523 | 1.6 | 1.2 | ✓ | WNU | |
| 9-16-94 | ORF-SV | | | 516 | 692.2 | 1283 | 547 | 0.79 | 2.3 | | ES | |
| 10-17-94 | D-41-18 | 9-14-94 | 9-17-94 | 458 | 1065 | 812.7 | 496 | 2.1 | 1.6 | ✓ | WNU | |
| 9-16-94 | ORF-SV | | | 518 | 785.8 | 1063 | 574 | 1.4 | 1.9 | | ES | |
| 10-17-94 | D-41-19 | 9-14-94 | 9-17-94 | 474 | 1745 | 1022 | 525 | 3.3 | 1.9 | ✓ | WNU | |
| 9-16-94 | ORF-SV | | | 520 | 672.2 | 861.5 | 560 | 1.2 | 1.5 | | ES | |
| 10-17-94 | D-41-20 | 9-14-94 | 9-17-94 | 462 | 698.2 | 1040 | 512 | 1.4 | 2.0 | ✓ | WNU | 480 |

Correction Factor = 1.8
 Correction Factor (if applicable) = 1.8
 Count Time = 500 Sec., unless otherwise noted

REVIEWED BY: [Signature]
 Site HP Manager

FOR INFORMATION ONLY

OCS SAMPLE LOG

Rifle-Cor

SITE NAME

| COUNT DATE INITIAL 20 DAY | SAMPLE ID & LOCATION | DATE SAMPLED | DATE SEALED | OCS # INITIAL 20 DAY | BI-214 pCi INITIAL 20 DAY | TI-208 pCi INITIAL 20 DAY | MASS (grams) WET DRY | Ra-226 pCi/g INITIAL/CORR. 20 DAY | Th-232 pCi/g INITIAL 20 DAY | DEPTH <15cm >15cm | TECH INITIAL 20 DAY | COMMENTS |
|---------------------------|----------------------|--------------|-------------|----------------------|---------------------------|---------------------------|----------------------|-----------------------------------|-----------------------------|-------------------|---------------------|----------|
| | | | | | | | | | | | | |
| 9-19-94 | ORF-SV | 9-17-94 | 9-20-94 | 578 | 655.3 | 928.5 | 558 | 1.2 | 1.7 | | WV | |
| 10-21-94 | D-42-11 | 9-17-94 | 9-20-94 | 430 | 1598 | 873.8 | 498 | 3.2 | 1.8 | | WV | |
| 9-19-94 | ORF-SV | 9-17-94 | 9-20-94 | 580 | 1139 | 1005 | 725 | 1.6 | 1.4 | | WV | |
| 10-18-94 | D-42-12 | 9-17-94 | 9-20-94 | 582 | 1910 | 851.9 | 659 | 2.9 | 1.3 | | WV | |
| 9-19-94 | ORF-SV | 9-17-94 | 9-20-94 | 582 | 363.6 | 842.4 | 555 | 0.66 | 1.5 | | WV | |
| 10-21-94 | D-42-13 | 9-17-94 | 9-20-94 | 532 | 970.5 | 938.1 | 495 | 2.0 | 1.9 | | WV | |
| 9-19-94 | ORF-SV | 9-17-94 | 9-20-94 | 584 | 245 | 966.8 | 672 | 3.2 | 1.4 | | WV | |
| 10-18-94 | D-42-14 | 9-17-94 | 9-20-94 | 498 | 2595 | 1005 | 611 | 4.2 | 1.0 | | WV | |
| 9-19-94 | ORF-SV | 9-17-94 | 9-20-94 | 586 | 859.1 | 660.5 | 688 | 1.2 | 0.96 | | WV | 480 |
| 10-18-94 | D-42-15 | 9-17-94 | 9-20-94 | 584 | 912.8 | 823.2 | 659 | 1.4 | 1.3 | | WV | 480 |
| 9-19-94 | ORF-SV | 9-17-94 | 9-20-94 | 588 | 973.6 | 1091 | 478 | 2.0 | 2.3 | | WV | 480 |
| 10-18-94 | D-42-16 | 9-17-94 | 9-20-94 | 4000 | 1428 | 1031 | 467 | 3.1 | 2.2 | | WV | 480 |
| 9-19-94 | ORF-SV | 9-17-94 | 9-20-94 | 590 | 1270 | 918.9 | 508 | 2.5 | 1.8 | | WV | 480 |
| 10-18-94 | D-42-17 | 9-17-94 | 9-20-94 | 580 | 1846 | 775.4 | 497 | 3.7 | 1.6 | | WV | 480 |
| 9-19-94 | ORF-SV | 9-17-94 | 9-20-94 | 592 | 1142 | 1149 | 530 | 2.2 | 2.2 | | WV | 480 |
| 10-21-94 | D-42-18 | 9-17-94 | 9-20-94 | 432 | 1351 | 1232 | 508 | 2.7 | 2.4 | | WV | 480 |
| | ORF-SV | | | | | | | | | | | |
| | D-42-19 | | | | | | | | | | | |
| | ORF-SV | | | | | | | | | | | |
| | D-42-20 | | | | | | | | | | | |

Correction Factor = 1.8

Correction Factor (if applicable) = 1.8

Count Time = 500 Sec, unless otherwise noted

REVIEWED BY:

Robert A. Fennell
Site HTP Manager

OCS SAMPLE LOG **QA ORIGINAL**

SITE NAME RIFE Co

| COUNT DATE INITIAL 20 DAY | SAMPLE ID & LOCATION | DATE SAMPLED | DATE SEALED | OCS # INITIAL 20 DAY | BI-214 pCi INITIAL 20 DAY | TI-208 pCi INITIAL 20 DAY | MASS (grams) WET DRY | Re-226 pCi/g INITIAL/CORR. 20 DAY | Th-232 pCi/g INITIAL 20 DAY | DEPTH <15cm >15cm | TECH INITIAL 20 DAY | COMMENTS |
|---------------------------|----------------------|--------------|-------------|----------------------|---------------------------|---------------------------|----------------------|-----------------------------------|-----------------------------|-------------------|---------------------|-------------|
| 9/19/94 | ORF-SV ✓ ① | 9/17/94 | 9-20-94 | 594 | 1829 | 1053 | 756 | 2.4 | 1.4 | ✓ | W/W | 1st partial |
| 10-21-94 | D-42-19 | | | 534 | 2056 | 1120 | 707 | 2.9 | 1.6 | ✓ | W/W | |
| 9/19/94 | ORF-SV ✓ ① | 9/17/94 | 9-20-94 | 596 | 1303 | 880.7 | 690 | 1.9 | 1.3 | ✓ | W/W | 1st partial |
| 10/21/94 | D-42-20 | | | 538 | 1634 | 698.8 | 614 | 2.7 | 1.1 | ✓ | W/W | 1st partial |
| 9/19/94 | ORF-SV ✓ ① | 9/17/94 | 9-20-94 | 598 | 981.9 | 679.6 | 531 | 1.8 | 1.3 | ✓ | W/W | 1st partial |
| 10/21/94 | D-42-21 | | | 438 | 1460 | 1031 | 521 | 2.8 | 2.0 | ✓ | W/W | 1st partial |
| 10-10-94 | ORF-SV ✓ ① | 9/17/94 | 9-20-94 | 538 | 1454 | 899.8 | 711 | 2.0 | 1.3 | ✓ | W/W | partial |
| 11-3-94 | D-42-22 | 10-7-94 | 10-12-94 | 584 | 2287 | 842.4 | 677 | 3.4 | 1.2 | ✓ | W/W | partial |
| 10-10-94 | ORF-SV ✓ ① | 10/7/94 | 10-12-94 | 438 | 3206 | 803.9 | 604 | 5.3 | 1.3 | ✓ | W/W | partial |
| 11-3-94 | D-42-23 | 10/7/94 | 10-12-94 | 586 | 4483 | 871.1 | 575 | 7.8 | 1.5 | ✓ | W/W | partial |
| 10-10-94 | ORF-SV ✓ ① | 10/7/94 | 10-12-94 | 440 | 2242 | 760.2 | 612 | 3 | 1.2 | ✓ | W/W | partial |
| 11-3-94 | D-42-24 | 10/7/94 | 10-12-94 | 486 | 3091 | 655.4 | 577 | 5.4 | 1.1 | ✓ | W/W | partial |
| 10-10-94 | ORF-SV ✓ | 10/7/94 | 10-12-94 | 546 | 2173 | 1063 | 640 | 3.4 | 1.7 | ✓ | W/W | partial |
| 11-3-94 | D-42-25 | 10/7/94 | 10-12-94 | 588 | 3105 | 890.2 | 615 | 5.0 | 1.4 | ✓ | W/W | partial |
| | | | | | | | | | | | | |
| | | | | | | | | | | | | |
Site Correction Factor = 1.8
 'P' Correction Factor (if applicable) = 1.8
 Count Time = 500 SEC., unless otherwise noted

REVIEWED BY: [Signature]
 Site HP Manager

OCS SAMPLE LOG

FOR INFORMATION ONLY

SITE NAME RIFLE, Co

| COUNT DATE INITIAL 20 DAY | SAMPLE ID & LOCATION | DATE SAMPLED | DATE SEALED | OCS # | | TI-208 pCi INITIAL 20 DAY | MASS (grams) WET DRY | Ra-226 pCi/g INITIAL/CORR. 20 DAY | | Th-232 pCi/g INITIAL 20 DAY | DEPTH <15cm >15cm | TECH INITIAL 20 DAY | COMMENTS |
|---------------------------------|-------------------------|-----------------|----------------|-------------------|------------------------------------|------------------------------------|-------------------------------|--------------------------------------------|-------|--------------------------------------|-------------------------|---------------------------|------------------------------|
| | | | | INITIAL 20 DAY | BI-214 pCi INITIAL 20 DAY | | | INITIAL | CORR. | | | | |
| 11-1-94 | ORF-SV | | | 566 | 572.2 | 861.5 | 728 | 0.79 | 1.2 | | | WV | |
| 11-23-94 | E-28-21 ✓ | 10-31-94 | 11-2-94 | 504 | 744.4 | 871.1 | 707 | 1.1 | 1.2 | | ✓ | PU | |
| 10/18/94 | ORF-SV ✓ | | | 406 | 718.9 | 917.5 | 676 | 1.1 | 1.4 | | | WV | |
| 11-10-94 | E-28-22 | 10/14/94 | 10-17-94 | 502 | 807.7 | 641.3 | 655 | 1.2 | 0.98 | | ✓ | PU | |
| 10-11-94 | ORF-SV ✓ | | | 464 | 1186 | 672.9 | 630 | 1.9 | 1.1 | | | WV | |
| 11-2-94 | E-28-23 | 10-11-94 | 10-12-94 | 576 | 1324 | 880.7 | 616 | 2.1 | 1.4 | | ✓ | PU | |
| 10-11-94 | ORF-SV ✓ | | | 466 | 4068 | 847.6 | 750 | 5.4 | 1.1 | | | WV | |
| 11-2-94 | E-28-24 | 10-11-94 | 10-12-94 | 482 | 5958 | 1084 | 654 | 9.1 | 1.7 | | ✓ | WV | |
| 10-11-94 | ORF-SV ✓ | | | 568 | 2429 | 938.1 | 633 | 3.8 | 1.5 | | | WV | QC 480 Ra-226 = 8.1 ± 0.7 |
| 11-2-94 | E-28-25 | 10-11-94 | 10-12-94 | 478 | 4070 | 803.9 | 630 | 6.5 | 1.3 | | ✓ | PU | Th-230 = 1.0 ± 0.3 |
| N A | | | | | | | | | | | | | |

Site Correction Factor = 1.8

VP Correction Factor (if applicable) = 1.8

Count Time = 500 SEC., unless otherwise noted

REVIEWED BY: [Signature] Site HP Manager

OCS SAMPLE LOG FOR INFORMATION ONLY

RIFLE Co.

SITE NAME

| COUNT DATE INITIAL 20 DAY | SAMPLE ID & LOCATION | DATE SAMPLED | DATE SEALED | OCS # INITIAL 20 DAY | BI-214 pCi INITIAL 20 DAY | TI-208 pCi INITIAL 20 DAY | MASS (grams) WET DRY | Ra-226 pCi/g INITIAL 20 DAY | Th-232 pCi/g INITIAL 20 DAY | DEPTH <15cm >15cm | TECH INITIAL 20 DAY | COMMENTS |
|---------------------------|----------------------|--------------|-------------|----------------------|---------------------------|---------------------------|----------------------|-----------------------------|-----------------------------|-------------------|---------------------|----------------------------------------|
| | | | | | | | | | | | | |
| 9-20-94 | ORF-SV | 9-20-94 | 9-21-94 | 556 | 704.1 | 909.4 | 556 | 1.3 | 1.6 | ✓ | 9U | |
| 10-20-94 | E-31-21 | 9-20-94 | 9-21-94 | 556 | 586.4 | 966.8 | 518 | 1.1 | 1.9 | ✓ | 9U | |
| 9-20-94 | ORF-SV | 9-20-94 | 9-21-94 | 558 | 846.5 | 794.5 | 546 | 1.6 | 1.5 | | 9U | |
| 10-20-94 | E-31-22 | 9-20-94 | 9-21-94 | 458 | 792.8 | 751.5 | 503 | 1.6 | 1.5 | ✓ | 9U | |
| 9/29/94 | ORF-SV J | 9/29/94 | 10/5/94 | 440 | 2813 | 812.7 | 571 | 4.9 | 1.4 | ✓ | WW | 480 |
| 10/24/94 | E-31-23 | 9/29/94 | 10/5/94 | 516 | 3612 | 775.4 | 545 | 6.6 | 1.4 | ✓ | 9U | 480 |
| 10/13/94 | ORF-SV J | 10/13/94 | 10-17-94 | 418 | 1299 | 725.3 | 604 | 2.1 | 1.2 | | 9U | 480 |
| 11-10-94 | E-31-24 | 10/13/94 | 10-17-94 | 400 | 1652 | 769.0 | 593 | 2.8 | 1.3 | ✓ | 9U | 480 |
| 10/14/94 | ORF-SV J | 10/13/94 | 10-17-94 | 520 | 374.2 | 679.6 | 525 | 0.71 | 1.3 | | WW | QC Ra-226=1.0±0.3 Th-230=1.3±0.4 |
| 11-10-94 | E-31-25 | 10/13/94 | 10-17-94 | 500 | 922.9 | 545.6 | 511 | 1.8 | 1.1 | ✓ | 9U | |
| | | | | | | | | | | | | |
| | | | | | | | | | | | | |
Site Correction Factor = 1.8
 VP Correction Factor (if applicable) = 1.8
 Count Time = 500 Sec, unless otherwise noted

REVIEWED BY: 
 Site iP Manager

FOR INFORMATION ONLY

OCS SAMPLE LOG

RIFLE, Co

SITE NAME

| COUNT DATE INITIAL 20 DAY | SAMPLE ID & LOCATION | DATE SAMPLED | DATE SEALED | OCS # INITIAL 20 DAY | BI-214 pCi INITIAL 20 DAY | TI-206 pCi INITIAL 20 DAY | MASS (grams) WET DRY | Re-226 pCi/g INITIAL 20 DAY | Th-232 pCi/g INITIAL 20 DAY | DEPTH <15cm >15cm | TECH INITIAL 20 DAY | COMMENTS |
|---------------------------|----------------------|--------------|-------------|----------------------|---------------------------|---------------------------|----------------------|-----------------------------|-----------------------------|-------------------|---------------------|----------------------|
| 10-31-94 | ORF-SV- | | | 424 | 946.9 | 978.7 | 618 | 1.5 | 1.6 | | W/W | Leak Tested - Passed |
| 11-22-94 | E-32-11 | 10-28-94 | 11-1-94 | 446 | 1126 | 847.6 | 563 | 2.0 | 1.5 | ✓ | W/W | |
| 10-31-94 | ORF-SV- | | | 528 | 859.1 | 660.5 | 589 | 1.5 | 1.1 | | W/W | |
| 11-22-94 | E-32-12 | 10-28-94 | 11-1-94 | 546 | 923.4 | 660.5 | 555 | 1.7 | 1.2 | ✓ | W/W | |
| 10-31-94 | ORF-SV- | | | 426 | 552.9 | 908.8 | 549 | 1.0 | 1.7 | | W/W | |
| 11-22-94 | E-32-13 | 10-28-94 | 11-1-94 | 558 | 276.6 | 871.1 | 516 | 0.53 | 1.7 | ✓ | W/W | |
| 10-31-94 | ORF-SV- | | | 530 | 789.1 | 469.0 | 569 | 1.4 | 0.82 | | W/W | |
| 11-22-94 | E-32-14 | 10-28-94 | 11-1-94 | 456 | 735.4 | 891.3 | 522 | 1.4 | 1.7 | ✓ | W/W | |
| 10-31-94 | ORF-SV- | | | 428 | 975.5 | 803.9 | 567 | 1.7 | 1.4 | | W/W | |
| 11-22-94 | E-32-15 | 10-28-94 | 11-1-94 | 560 | 815.1 | 966.8 | 516 | 1.6 | 1.9 | ✓ | W/W | |
| 10-31-94 | ORF-SV | | | 430 | 838.0 | 830.1 | 575 | 1.5 | 1.4 | | W/W | |
| 11-22-94 | E-32-16 | 10-28-94 | 11-1-94 | 458 | 1659 | 908.8 | 536 | 3.1 | 1.7 | ✓ | W/W | |
| 10-31-94 | ORF-SV | | | 532 | 930.4 | 765.8 | 593 | 1.6 | 1.3 | | W/W | 480 |
| 11-22-94 | E-32-17 | 10-28-94 | 11-1-94 | 562 | 828.8 | 957.2 | 554 | 1.5 | 1.7 | ✓ | W/W | |
| 10-31-94 | ORF-SV | | | 432 | 519.5 | 891.3 | 578 | 0.90 | 1.5 | | W/W | |
| 11-22-94 | E-32-18 | 10-28-94 | 11-1-94 | 460 | 877.0 | 908.8 | 541 | 1.6 | 1.7 | ✓ | W/W | 480 |
| 10-31-94 | ORF-SV | | | 534 | 714.5 | 851.9 | 535 | 1.3 | 1.6 | | W/W | |
| 11-22-94 | E-32-19 | 10-28-94 | 11-1-94 | 564 | 1088 | 765.8 | 494 | 2.2 | 1.6 | ✓ | W/W | 480 |
| 10-31-94 | ORF-SV | | | 438 | 378.9 | 1162 | 546 | 0.69 | 2.1 | | W/W | |
| 11-22-94 | E-32-20 | 10-28-94 | 11-1-94 | 462 | 981.0 | 1075 | 502 | 2.0 | 2.1 | ✓ | W/W | 480 |

Site Correction Factor = 1.8

VP Correction Factor (if applicable) = 1.8

Count Time = 500 SEC, unless otherwise noted

REVIEWED BY:



Site HP Manager

OC'S SAMPLE LOG

FOR INFORMATION ONLY

SITE NAME RIFLE, CO

| COUNT DATE INITIAL 20 DAY | SAMPLE ID & LOCATION | DATE SAMPLED | DATE SEALED | OCS # | | TI-208 pCi INITIAL 20 DAY | MASS (grams) WET DRY | Ra-226 pCi/g | | Th-232 pCi/g INITIAL 20 DAY | DEPTH <15cm >15cm | TECH INITIAL 20 DAY | COMMENTS |
|---|----------------------|--------------|-------------|-------------------|---------------------------------|---------------------------------|----------------------------|-------------------------|--------|-----------------------------------|-------------------------|---------------------------|----------|
| | | | | INITIAL 20 DAY | BI-214 pCi INITIAL 20 DAY | | | INITIAL/CORR. 20 DAY | 20 DAY | | | | |
| 10-31-94 | ORF-SV-J | | | 436 | 512.4 | 952.5 | 582 | 0.88 | 1.6 | | | PU | Partial |
| 11-22-94 | E-32-24 | 10-28-94 | 11-1-94 | 516 | 631.3 | 890.2 | 531 | 1.2 | 1.7 | ✓ | | PU | 480 |
| 10-31-94 | ORF-SV-J | | | 538 | 845.5 | 564.8 | 527 | 1.6 | 1.1 | | | PU | Partial |
| 11-22-94 | E-32-25 | 10-28-94 | 11-1-94 | 418 | 676.8 | 873.8 | 479 | 1.4 | 1.8 | ✓ | | PU | 480 |
| 10-31-94 | ORF-SV-J | | | 440 | 620.3 | 952.5 | 568 | 1.1 | 1.7 | | | MMW | Partial |
| 11-22-94 | E-32-23 | 10-28-94 | 11-1-94 | 416 | 661.7 | 1337 | 524 | 1.3 | 2.6 | ✓ | | PU | 480 |
| <div style="position: absolute; top: 50%; left: 50%; transform: translate(-50%, -50%); font-size: 4em; opacity: 0.5;"> N A </div> | | | | | | | | | | | | | |

Site Correction Factor = 1.8

VP Correction Factor (if applicable) = 1.8

Count Time = 500 SEC. unless otherwise noted

REVIEWED BY: [Signature]

Site HP Manager

OCS SAMPLE LOG

REINFORCEMENT ONLY

SITE NAME RIFLECO

| COUNT DATE INITIAL 20 DAY | SAMPLE ID & LOCATION | DATE SAMPLED | DATE SEALED | OCS # INITIAL 20 DAY | BI-214 PCI INITIAL 20 DAY | TI-208 PCI INITIAL 20 DAY | MASS (grams) WET DRY | Re-226 pCi/g INITIAL CORRECTED 20 DAY | Th-232 pCi/g INITIAL 20 DAY | DEPTH: <15cm >15cm | TECH INITIAL 20 DAY | COMMENTS |
|---------------------------|----------------------|--------------|-------------|----------------------|---------------------------|---------------------------|----------------------|---------------------------------------|-----------------------------|--------------------|---------------------|----------------------------------------------------|
| 11-1-94 | ORF-SV-1 | | | 468 | 788.0 | 908.8 | 627 | 1.3 | 1.4 | | UMW | |
| 11-23-94 | E-33-11 | 10-31-94 | 11-2-94 | 410 | 749.9 | 908.8 | 574 | 1.3 | 1.6 | ✓ | PU | |
| 11-1-94 | ORF-SV-1 | | | 572 | 625.1 | 689.2 | 565 | 1.1 | 1.2 | | UMW | 480 |
| 11-23-94 | E-33-12 | 10-31-94 | 11-2-94 | 510 | 369.6 | 717.9 | 529 | 0.70 | 1.4 | ✓ | PU | 480 |
| 11-18-94 | ORF-SV-1 | | | 586 | 526.4 | 1139 | 705 | 0.75 | 1.6 | | UMW | |
| 12-13-94 | E-33-13 | 11-18-94 | 11-19-94 | 422 | 844.4 | 970.0 | 662 | 1.3 | 1.5 | ✓ | PU | 480 |
| 11-2-94 | ORF-SV-1 | | | 546 | 472.9 | 765.8 | 530 | 0.89 | 1.4 | | PU | 480 |
| 11-28-94 | E-33-14 | 11-1-94 | 11-3-94 | 440 | 814.2 | 777.7 | 501 | 1.6 | 1.6 | ✓ | UMW | |
| 11-2-94 | ORF-SV-1 | | | 446 | 668.8 | 1066 | 556 | 1.2 | 1.9 | | PU | QC 480 RA-226 = 1.5 ± 0.3 Th-230 = 1.2 ± 0.3 |
| 11-28-94 | E-33-15 | 11-1-94 | 11-3-94 | 556 | 859.6 | 775.4 | 513 | 1.7 | 1.5 | ✓ | UMW | |
| | | | | | | | | | | | | |
| | | | | | | | | | | | | |
Site Correction Factor = 1.8
 VP Correction Factor (if applicable) = 1.8
 Count Time = 500 SEC unless otherwise noted

REVIEWED BY: [Signature] Site HP Manager


OCS SAMPLE LOG

SITE NAME: RIFLE CO

FOR INFORMATION ONLY

| COUNT DATE INITIAL 20 DAY | SAMPLE ID & LOCATION | DATE SAMPLED | DATE SEALED | OCS # | BI-214 pCi INITIAL 20 DAY | TI-208 pCi INITIAL 20 DAY | MASS (grams) WET DRY | Rb-226 pCi/g INITIAL 20 DAY | Th-232 pCi/g INITIAL 20 DAY | DEPTH <15cm >15cm | TECH INITIAL 20 DAY | COMMENTS |
|---------------------------|----------------------|--------------|-------------|-------|---------------------------|---------------------------|----------------------|-----------------------------|-----------------------------|-------------------|---------------------|----------------------------------------------------|
| 11-7-94 | ORF-SV- | | | 418 | 1053 | 8214 | 778 | 1.4 | 1.1 | | RU | |
| 11-28-94 | E-34-01 | 11-4-94 | 11-8-94 | 564 | 1632 | 1101 | 723 | 2.3 | 1.5 | ✓ | WAW | |
| 11-7-94 | ORF-SV- | | | 534 | 1500 | 1158 | 707 | 2.1 | 1.6 | | RU | |
| 11-28-94 | E-34-02 | 11-4-94 | 11-8-94 | 566 | 2707 | 833.6 | 653 | 4.1 | 1.2 | ✓ | WAW | |
| 11-2-94 | ORF-SV- | | | 550 | 500.5 | 1072 | 587 | 0.85 | 1.8 | | RU | |
| 11-28-94 | E-34-03 | 11-1-94 | 11-3-94 | 512 | 932.2 | 899.8 | 566 | 1.6 | 1.6 | ✓ | WAW | |
| 11-2-94 | ORF-SV | | | 452 | 922.2 | 1127 | 545 | 1.7 | 2.1 | | WAW | |
| 11-28-94 | E-34-04 | 11-1-94 | 11-3-94 | 526 | 418.2 | 979.4 | 509 | 0.92 | 1.8 | ✓ | WAW | |
| 11-1-94 | ORF-SV | | | 472 | 795.9 | 1136 | 610 | 1.3 | 1.9 | | WAW | |
| 11-23-94 | E-34-05 | 10-31-94 | 11-2-94 | 412 | 991.3 | 699.1 | 574 | 1.7 | 1.2 | ✓ | RU | |
| 11-2-94 | ORF-SV | | | 552 | 715.8 | 871.1 | 575 | 1.2 | 1.5 | | WAW | 480 |
| 11-28-94 | E-34-06 | 11-1-94 | 11-3-94 | 424 | 1029 | 900.0 | 554 | 1.9 | 1.6 | ✓ | WAW | |
| 11-2-94 | ORF-SV | | | 554 | 664.5 | 851.9 | 604 | 1.1 | 1.4 | | WAW | |
| 11-28-94 | E-34-07 | 11-1-94 | 11-3-94 | 514 | 1330 | 1072 | 585 | 2.3 | 1.8 | ✓ | WAW | 480 |
| 11-2-94 | ORF-SV | | | 454 | 689.5 | 1084 | 531 | 1.3 | 2.0 | | WAW | |
| 11-28-94 | E-34-08 | 11-1-94 | 11-3-94 | 400 | 824.5 | 1082 | 511 | 1.2 | 2.1 | ✓ | WAW | QC 480 Rb-226 = 1.4 ± 0.4 Th-230 = 7.0 ± 0.7 |
| 11-2-94 | ORF-SV | | | 556 | 553.3 | 899.8 | 506 | 1.1 | 1.8 | | WAW | 480 |
| 11-28-94 | E-34-09 | 11-1-94 | 11-3-94 | 400 | 824.5 | 961.2 | 480 | 1.7 | 2.0 | ✓ | WAW | |
| | | | | | | N | A | | | | | |

Site Correction Factor = 1.8
 VP Correction Factor (if applicable) = 1.8
 Count Time = 500 SEC, unless otherwise noted

REVIEWED BY:  Site HP Manager

OCS SAMPLE LOG

FOR INFORMATION ONLY

SITE NAME RIFIE, Co

| COUNT DATE INITIAL 20 DAY | SAMPLE ID & LOCATION | DATE SAMPLED | DATE SEALED | OCS # | | Tl-208 pCi INITIAL 20 DAY | MASS (grams) WET DRY | Ra-226 pCi/g INITIAL/CORR 20 DAY | | Tn-232 pCi/g INITIAL 20 DAY | DEPTH <15cm >15cm | TECH INITIAL 20 DAY | COMMENTS |
|---------------------------------|----------------------|--------------|-------------|-----------------------|---------------------------|---------------------------|-----------------------|----------------------------------|-----------------------|-----------------------------|-------------------|---------------------|----------|
| | | | | INITIAL 20 DAY | BI-214 pCi INITIAL 20 DAY | | | INITIAL | 20 DAY | | | | |
| 11-1-94 | ORF-SV | | | 570 | 795.5 | 1101 | 588 | 1.4 | 1.9 | | WW | Partial | |
| 11-23-94 | E-34-10 ✓ | 10-31-94 | 11-2-94 | 416 | 807.1 | 1258 | 551 | 1.5 | 2.3 | ✓ | PU | 480 | |
| 11-2-94 | ORF-SV | | | 456 | 963.5 | 1092 | 556 | 1.7 | 2.0 | | WW | Partial | |
| 11-28-94 | E-34-11 ✓ | 11-1-94 | 11-3-94 | 428 | 860.3 | 865.1 | 537 | 1.6 | 1.6 | ✓ | WW | 480 | |
| 11-2-94 | ORF-SV | | | 558 | 1106 | 717.9 | 526 | 2.1 | 1.4 | | WW | Partial | |
| 11-28-94 | E-34-12 ✓ | 11-1-94 | 11-3-94 | 502 | 1551 | 1168 | 500 | 3.1 | 2.3 | ✓ | WW | 480 | |
| 11-2-94 | ORF-SV | | | 458 | 659.3 | 1031 | 567 | 1.2 | 1.8 | | WW | Partial | |
| 11-28-94 | E-34-13 ✓ | 11-1-94 | 11-3-94 | 504 | 691.1 | 928.5 | 551 | 1.3 | 1.7 | ✓ | WW | 480 | |
| 11-2-94 | ORF-SV- | | | 460 | 409.1 | 795.2 | 539 | 0.76 | 1.5 | | PU | Partial | |
| 11-28-94 | E-34-14 ✓ | 11-1-94 | 11-3-94 | 540 | 276.5 | 923.2 | 529 | 0.52 | 1.6 | ✓ | WW | 480 | |
| 11-16-94 | ORF-SV- | | | 502 | 624.9 | 1331 | 556 | 1.1 | 2.4 | | PU | Partial | |
| 12-14-94 | E-34-15 | 11-15-94 | 11-17-94 | 518 504 | 900.0 691.1 | 1168 928.5 | 510 550 | 1.6 1.6 | 2.3 2.3 | ✓ | RUC | 480 | |

Site Correction Factor = 1.8

VP Correction Factor (if applicable) = 1.8

Count Time = 500 SEC., unless otherwise noted

REVIEWED BY: [Signature] Site HP Manager

OCS SAMPLE LOG

QA ORIGINAL

RIFLE CO

SITE NAME

| COUNT DATE INITIAL 20 DAY | SAMPLE ID & LOCATION | DATE SAMPLED | DATE SEALED | OCS # INITIAL 20 DAY | BI-214 pCi INITIAL 20 DAY | TI-208 pCi INITIAL 20 DAY | MASS (grams) WET DRY | Ra-226 pCi/g INITIAL 20 DAY | Th-232 pCi/g INITIAL 20 DAY | DEPTH <15cm >15cm | TECH INITIAL 20 DAY | COMMENTS |
|---------------------------|----------------------|--------------|-------------|----------------------|---------------------------|---------------------------|----------------------|-----------------------------|-----------------------------|-------------------|---------------------|------------------------------------------------|
| 11/1/94 | ORF-SV ✓ | 10/31/94 | 11-2-94 | 474 | 706.2 | 847.6 | 542 | 1.3 | 1.6 | ✓ | MMW | QC Ra-226 = 0.8 ± 0.3 Th-232 = 2.0 ± 0.4 |
| 11-23-94 | E-35-01 ✓ | 10/14/94 | 10-11-94 | 513 | 710.3 | 574.3 | 502 | 1.4 | 1.1 | ✓ | PU | |
| 10/13/94 | ORF-SV ✓ | 10/14/94 | 10-11-94 | 5002 | 594.8 | 986.0 | 625 | 0.95 | 1.6 | ✓ | MMW | |
| 11-10-94 | E-35-02 | 10-11-94 | 10-12-94 | 444 | 451.2 | 838.9 | 586 | 0.77 | 1.4 | ✓ | MMW | |
| 10-11-94 | ORF-SV ✓ | 10-11-94 | 10-12-94 | 468 | 508.4 | 978.7 | 555 | 0.92 | 1.8 | ✓ | MMW | |
| 11-2-94 | E-35-03 | 10-11-94 | 10-12-94 | 578 | 793.8 | 861.5 | 508 | 1.6 | 1.7 | ✓ | PU | |
| A | | | | | | | | | | | | |
| N | | | | | | | | | | | | |

Site Correction Factor = 1.8
 VP Correction Factor (if applicable) = 1.3
 Count Time = 500 sec., unless otherwise noted

REVIEWED BY: [Signature] Site HP Manager

2

OCS SAMPLE LOG

SITE NAME: RIFLE, CO

| COUNT DATE INITIAL 20 DAY | SAMPLE ID & LOCATION | DATE SAMPLED | DATE SEALED | OCS # INITIAL 20 DAY | BI-214 pCi INITIAL 20 DAY | TI-208 pCi INITIAL 20 DAY | MASS (grams) WET DRY | Re-226 pCi/g INITIAL 20 DAY | Th-232 pCi/g INITIAL 20 DAY | DEPTH <15cm >15cm | TECH INITIAL 20 DAY | COMMENTS |
|---------------------------|----------------------|--------------|-------------|----------------------|---------------------------|---------------------------|----------------------|-----------------------------|-----------------------------|-------------------|---------------------|----------|
| 10/11/94 | ORF-SVJ | 10/11/94 | | 570 | 665.7 | 976.4 | 530 | 1.3 | 1.8 | | MLW | Partial |
| 11-2-94 | E-35-04 | | 10-12-94 | 470 | 839.6 | 987.4 | 496 | 1.7 | 2.0 | ✓ | YU | 480 |
| 10/11/94 | ORF-SVJ | 10/11/94 | | 570 | 1529 | 1022 | 545 | 2.8 | 1.9 | | MLW | Partial |
| 11-2-94 | E-35-08 | | 10-12-94 | 570 | 2598 | 794.5 | 518 | 5.0 | 1.5 | ✓ | YU | 480 |
| A | | | | | | | | | | | | |
| N | | | | | | | | | | | | |
| / | | | | | | | | | | | | |

Site Correction Factor = 1.8
 VP Correction Factor (if applicable) = 1.8
 Count Time = 500 SEC., unless otherwise noted

REVIEWED BY:  Site HF Manager

OCS SAMPLE LOG

SITE NAME RIFLE, Co

| COUNT DATE INITIAL 20 DAY | SAMPLE ID & LOCATION | DATE SAMPLED | DATE SEALED | OCS # | BI-214 pCi INITIAL 20 DAY | TI-208 pCi INITIAL 20 DAY | MASS (grams) WET DRY | RA-226 pCi/g INITIAL 20 DAY | TH-232 pCi/g INITIAL 20 DAY | DEPTH <15cm >15cm | TECH INITIAL 20 DAY | COMMENTS |
|---------------------------|----------------------|--------------|-------------|-------|---------------------------|---------------------------|----------------------|-----------------------------|-----------------------------|-------------------|---------------------|-------------|
| 10-4-94 | ORF-SV | 10-4-94 | 10-7-94 | 450 | 252.6 | 961.2 | 0.21 | 0.41 | 1.5 | ✓ | W/W | Partial 480 |
| 10-28-94 | E-35-05 | 10-4-94 | 10-7-94 | 402 | 554.5 | 856.4 | 539 | 1.0 | 1.6 | ✓ | W/W | Partial 480 |
| 11-1-94 | ORF-SV | 10-31-94 | 11-2-94 | 578 | 856.0 | 1043 | 557 | 1.5 | 1.9 | ✓ | W/W | Partial 480 |
| 11-23-94 | E-35-06 | 10-31-94 | 11-2-94 | 516 | 456.9 | 1063 | 523 | 0.87 | 2.0 | ✓ | W/W | Partial 480 |
| 11-1-94 | ORF-SV | 10-31-94 | 11-2-94 | 476 | 601.3 | 742.8 | 542 | 1.1 | 1.4 | ✓ | W/W | Partial 480 |
| 11-23-94 | E-35-07 | 10-31-94 | 11-2-94 | 418 | 635.5 | 908.8 | 449 | 1.4 | 2.0 | ✓ | W/W | Partial 480 |
| | | | | | | | | | | | | |
| | | | | | | | | | | | | |
Site Correction Factor = 1.8
 VP Correction Factor (if applicable) = 1.8
 Count Time = 500 SEC., unless otherwise noted

REVIEWED BY: [Signature] Site HP Manager

FOR INFORMATION ONLY

OCS SAMPLE LOG

SITE NAME RIFLE, CO

| COUNT DATE INITIAL 20 DAY | SAMPLE ID & LOCATION | DATE SAMPLED | DATE SEALED | OCS # INITIAL 20 DAY | BI-214 pCi INITIAL 20 DAY | TH-208 pCi INITIAL 20 DAY | MASS (grams) WET DRY | Re-226 pCi/g INITIAL/CORR. 20 DAY | Th-232 pCi/g INITIAL 20 DAY | DEPTH <15cm >15cm | TECH INITIAL 20 DAY | COMMENTS |
|---------------------------|----------------------|--------------|-------------|----------------------|---------------------------|---------------------------|----------------------|-----------------------------------|-----------------------------|-------------------|---------------------|----------|
| 9-19-94 | ORF-SV - ✓ | | | 500 | 1849 | 823.2 | 606 | 8.1 | 1.4 | | PU | |
| 10/18/94 | E-36-1 ✓ | 9-17-94 | 9/20/94 | 4004 | 2488 | 943.7 | 557 | 6.2 | 1.7 | ✓ | B | |
| 9-19-94 | ORF-SV - ✓ | | | 502 | 717.0 | 995.5 | 598 | 1.2 | 1.7 | | PU | |
| 10-18-94 | E-36-2 ✓ | 9-17-94 | 9-20-94 | 492 | 472.6 | 1005 | 568 | 0.83 | 1.8 | ✓ | WWD | |
| 7-19-94 | ORF-SV - ✓ | | | 504 | 655.9 | 938.1 | 527 | 1.2 | 1.8 | | PU | |
| 10/18/94 | E-36-3 ✓ | 9-17-94 | 9/20/94 | 590 | 820.6 | 727.5 | 511 | 1.6 | 1.4 | ✓ | B | |
| 9-19-94 | ORF-SV - ✓ | | | 506 | 752.2 | 880.7 | 633 | 1.2 | 1.4 | | WWD | |
| 10-21-94 | E-36-4 ✓ | 9-17-94 | 9-20-94 | 522 | 467.3 | 1110 | 616 | 0.76 | 1.8 | ✓ | WWD | |
| 7-19-94 | ORF-SV - ✓ | | | 514 | 753.6 | 794.5 | 601 | 1.3 | 1.3 | | PU | |
| 10-21-94 | E-36-5 ✓ | 9-17-94 | 9-20-94 | 422 | 661.7 | 1127 | 594 | 1.1 | 1.9 | ✓ | WWD | |
| 7-19-94 | ORF-SV - ✓ | | | 516 | 747.9 | 708.4 | 575 | 1.3 | 1.2 | | PU | |
| 10-21-94 | E-36-6 ✓ | 9-17-94 | 9-20-94 | 524 | 519.5 | 928.5 | 539 | 0.96 | 1.7 | ✓ | W | |
| 9-19-94 | ORF-SV - ✓ | | | 518 | 886.1 | 851.9 | 590 | 1.5 | 1.4 | | PU | |
| 10-18-94 | E-36-7 ✓ | 9-17-94 | 9-20-94 | 578 | 846.5 | 794.5 | 545 | 1.6 | 1.5 | ✓ | WWD | |
| 1-19-94 | ORF-SV - ✓ | | | 520 | 1125 | 899.8 | 556 | 2.0 | 1.6 | | PU | |
| 10-18-94 | E-36-8 ✓ | 9-17-94 | 9-20-94 | 494 | 1269 | 1022 | 508 | 2.5 | 2.0 | ✓ | WWD | |
| 7-19-94 | ORF-SV - ✓ | | | 534 | 579.2 | 966.8 | 526 | 1.1 | 1.8 | | PU | 480 |
| 0/18/94 | E-36-9 ✓ | 9-17-94 | 9/20/94 | 4002 | 623.6 | 1057 | 498 | 1.3 | 2.1 | ✓ | B | |
| 9-19-94 | ORF-SV ✓ | | | 536 | 1865 | 1053 | 511 | 3.1 | 2.1 | | B | |
| 10-21-94 | E-36-10 ✓ | 9-17-94 | 9-20-94 | 424 | 3072 | 1075 | 504 | 6.1 | 2.1 | ✓ | PU | 480 |

Reviewed BY: [Signature]

Site HP Manager

14

te Correction Factor = 1.8
 p Correction Factor (if applicable) = 1.8
 Count Time = 500 Sec., unless otherwise noted

OCS SAMPLE LOG FOR INFORMATION ONLY

SITE NAME

RIFLE CO.

| COUNT DATE INITIAL 20 DAY | SAMPLE ID & LOCATION | DATE SAMPLED | DATE SEALED | OCS # INITIAL 20 DAY | B-214 pCi INITIAL 20 DAY | Tl-208 pCi INITIAL 20 DAY | MASS (grams) WET DRY | Re-226 pCi/g INITIAL/CORR. 20 DAY | Th-232 pCi/g INITIAL 20 DAY | DEPTH <15cm >15cm | TECH INITIAL 20 DAY | COMMENTS |
|---------------------------|----------------------|--------------|-------------|----------------------|--------------------------|---------------------------|----------------------|-----------------------------------|-----------------------------|-------------------|---------------------|----------------------------------------------------|
| | | | | | | | | | | | | |
| 9-19-94 | ORF-SV- | | | 538 | 804.8 | 918.9 | 621 | 1.3 | 1.5 | | SE | |
| 10-21-94 | E-36-11 | 9-17-94 | 9-20-94 | 426 | 1555 | 821.4 | 574 | 2.7 | 1.4 | ✓ | MMW | 480 |
| 9-19-94 | ORF-SV | | | 546 | 744.4 | 871.1 | 495 | 1.5 | 1.8 | | SE | |
| 10/18/94 | E-36-12 | 9-17-94 | 9/20/94 | 592 | 1348 | 698.8 | 462 | 2.9 | 1.5 | ✓ | SE | 480 |
| 9-19-94 | ORF-SV- | | | 548 | 218.6 | 918.9 | 564 | 0.39 | 1.6 | | RU | |
| 10/18/94 | E-36-13 | 9-17-94 | 9/20/94 | 588 | 754.2 | 804.1 | 525 | 1.4 | 1.5 | ✓ | SE | QC RQ-226 = 1.3 ± 0.4 480 TA-230 = 1.5 ± 0.4 |
| | ORF-SV- | | | | | | A | | | | | |
| | E-36-14 | | | | | | | | | | | |
| | ORF-SV | | | | | | | | | | | |
| | E-36-15 | | | | | | | | | | | |
| 11-16-94 | ORF-SV | | | 568 | 2333 | 890.2 | 585 | 4.0 | 1.5 | | MMW | 2-partials Combine |
| 12-14-94 | E-36-16 | 11-16-94 | 11-17-94 | 510 | 1824 | 976.4 | 578 | 3.2 | 1.7 | ✓ | RnC | 480 |
| | | | | | | | | | | | | |
| | | | | | | | | | | | | |
| | | | | | | | | | | | | |
| | | | | | | | | | | | | |

ite Correction Factor = 1.8

P Correction Factor (if applicable) = 1.8

ount Time = 500 SEC, unless otherwise noted

REVIEWED BY:  Site HP Manager

OCS SAMPLE LOG

SITE NAME RIFLE CO

| COUNT DATE INITIAL 20 DAY | SAMPLE ID & LOCATION | DATE SAMPLED | DATE SEALED | OCS # INITIAL 20 DAY | BI-214 pCi INITIAL 20 DAY | TI-208 pCi INITIAL 20 DAY | MASS (grams) WET DRY | IR-228 pCi/g INITIAL/CORR. 20 DAY | TR-232 pCi/g INITIAL 20 DAY | DEPTH <15cm >15cm | TECH INITIAL 20 DAY | COMMENTS |
|---------------------------|----------------------|--------------|-------------|----------------------|---------------------------|---------------------------|----------------------|-----------------------------------|-----------------------------|-------------------|---------------------|----------|
| 9-19-94 | ORF-SV- ✓ | 9-17-94 | 9-20-94 | 550 | 639.9 | 804.1 | 509 | 1.3 | 1.6 | ✓ | PU | Partial |
| 10/18/94 | E-36-14 ① | 9-17-94 | 9-20-94 | 4008 | 593.4 | 795.2 | 481 | 1.3 | 1.2 | ✓ | BB | Partial |
| 9-19-94 | ORF-SV ✓ | 9-17-94 | 9-20-94 | 552 | 4084 | 1206 | 516 | 7.9 | 2.3 | ✓ | SS | Partial |
| 10-21-94 | E-36-15 ① | 9-17-94 | 9-20-94 | 434 | 6456 | 1040 | 486 | 13.3 | 2.1 | ✓ | WW | Partial |
| 9-19-94 | ORF-SV | 9-17-94 | 9-20-94 | 556 | 13817 | 1043 | 584 | 23.7 | 1.8 | ✓ | SS | Partial |
| 10-20-94 | E-36-16 ① | 9-17-94 | 9-20-94 | 536 | 18205 | 1445 | 563 | 32.3 | 2.6 | ✓ | WW | Partial |
| 10-10-94 | ORF-SV | 9-17-94 | 9-20-94 | 446 | 2022 | 1127 | 632 | 3.2 | 1.8 | ✓ | WW | Partial |
| 11-3-94 | E-36-18 ① | 10-7-94 | 10-12-94 | 404 | 2445 | 1206 | 537 | 4.9 | 2.2 | ✓ | PU | Partial |
| 10-10-94 | ORF-SV | 10-7-94 | 10-12-94 | 548 | 1897 | 1005 | 616 | 3.1 | 1.4 | ✓ | WW | Partial |
| 11-3-94 | E-36-17 | 10-7-94 | 10-12-94 | 488 | 2514 | 891.3 | 529 | 4.8 | 1.7 | ✓ | WW | Partial |
| 10-10-94 | ORF-SV | 10-7-94 | 10-12-94 | 448 | 1769 | 1075 | 604 | 2.9 | 1.8 | ✓ | WW | Partial |
| 11-3-94 | E-36-18 | 10-7-94 | 10-12-94 | 590 | 2497 | 986.0 | 517 | 4.8 | 1.9 | ✓ | WW | Partial |
| 10-10-94 | ORF-SV | 10-7-94 | 10-12-94 | 550 | 1068 | 1120 | 595 | 1.8 | 1.9 | ✓ | WW | Partial |
| 11-3-94 | E-36-19 | 10-7-94 | 10-12-94 | 490 | 2096 | 891.3 | 527 | 4.0 | 1.7 | ✓ | WW | Partial |
| 10-10-94 | ORF-SV | 10-7-94 | 10-12-94 | 450 | 1830 | 1049 | 635 | 2.9 | 1.7 | ✓ | WW | Partial |
| 11-4-94 | E-36-20 | 10-7-94 | 10-12-94 | 500 | 2908 | 1043 | 549 | 5.3 | 1.9 | ✓ | PU | Partial |
| 10-10-94 | ORF-SV | 10-7-94 | 10-12-94 | 552 | 1699 | 813.6 | 616 | 2.8 | 1.3 | ✓ | WW | Partial |
| 11-3-94 | E-36-21 | 10-7-94 | 10-12-94 | 504 | 2445 | 957.2 | 523 | 4.7 | 1.8 | ✓ | PU | Partial |
| | | | | | | | | | | | | |

Site Correction Factor = 1.8
 VP Correction Factor (if applicable) = 1.8
 Count Time = 500 SEC., unless otherwise noted

REVIEWED BY: [Signature] Site HP Manager

FOR INFORMATION ONLY

OCS SAMPLE LOG

SITE NAME

RIFLE Co.

| COUNT DATE INITIAL 20 DAY | SAMPLE ID & LOCATION | DATE SAMPLED | DATE SEALED | OCS # INITIAL 20 DAY | BI-214 pCi INITIAL 20 DAY | TI-208 pCi INITIAL 20 DAY | MASS (grams) WET DRY | Ra-226 pCi/g INITIAL 20 DAY | Th-232 pCi/g INITIAL 20 DAY | DEPTH <15cm >15cm | TECH INITIAL 20 DAY | COMMENTS |
|---------------------------|----------------------|--------------|-------------|----------------------|---------------------------|---------------------------|----------------------|-----------------------------|-----------------------------|-------------------|---------------------|------------------------------------------------|
| | | | | | | | | | | | | |
| 9-19-94 | ORF-SV | | | 558 | 2634 | 1015 | 629 | 4.2 | 1.6 | | RB | |
| 10/18/94 | E-37-1 | 9-17-94 | 9/20/94 | 594 | 4007 | 1130 | 619 | 6.5 | 1.8 | | RB | |
| 9-20-94 | ORF-SV | | | 560 | 1907 | 832.8 | 596 | 3.2 | 1.4 | | RB | |
| 10-20-94 | E-37-2 | 9-20-94 | 9-21-94 | 558 | 2159 | 957.2 | 574 | 3.8 | 1.7 | | RB | |
| 9-20-94 | ORF-SV | | | 562 | 1439 | 775.4 | 520 | 2.8 | 1.5 | | RB | 480 |
| 10-20-94 | E-37-3 | 9-20-94 | 9-21-94 | 548 | 1330 | 1177 | 476 | 2.8 | 2.5 | | WMD | 480 |
| 9-20-94 | ORF-SV | | | 566 | 3809 | 938.1 | 503 | 7.6 | 1.9 | | RB | 480 |
| 10-20-94 | E-37-4 | 9-20-94 | 9-21-94 | 448 | 4735 | 1057 | 477 | 9.9 | 2.2 | | WMD | 480 |
| 9-20-94 | ORF-SV | | | 568 | 2664 | 832.2 | 569 | 4.7 | 1.5 | | RB | 480 |
| 10-20-94 | E-37-5 | 9-20-94 | 9-21-94 | 524 | 4348 | 765.8 | 550 | 7.9 | 1.4 | | RB | 480 |
| 9-19-94 | ORF-SV | | | 564 | 1161 | 1005 | 627 | 1.9 | 1.6 | | RB | QC Ra-226 = 2.9 ± 0.5 Th-230 = 2.3 ± 0.4 |
| 10/18/94 | E-37-6 | 9-17-94 | 9/20/94 | 4007 | 1712 | 935.0 | 620 | 28.5 | 1.5 | | RB | |
| | | | | | | | | | | | | |
| | | | | | | | | | | | | |
| | | | | | | | | | | | | |
| | | | | | | | | | | | | |
| | | | | | | | | | | | | |

Reviewed By: *[Signature]*

Site HP Manager

12

Site Correction Factor = 1.8
 P Correction Factor (if applicable) = 1.8
 Count Time = 500 Sec, unless otherwise noted

OCS SAMPLE LOG

SITE NAME RIFLE Co

| COUNT DATE INITIAL 20 DAY | SAMPLE ID & LOCATION | DATE SAMPLED | DATE SEALED | OCS # INITIAL 20 DAY | B-214 pCi INITIAL 20 DAY | Ti-208 pCi INITIAL 20 DAY | MASS (grams) WET DRY | Re-226 pCi/g INITIAL 20 DAY | Th-232 pCi/g INITIAL 20 DAY | DEPTH <15cm >15cm | TECH INITIAL 20 DAY | COMMENTS |
|---------------------------|----------------------|--------------|-------------|----------------------|--------------------------|---------------------------|----------------------|-----------------------------|-----------------------------|-------------------|---------------------|-------------|
| 9/20/94 | ORF-SV ① | 9/20/94 | 9/21/94 | 570 | 3783 | 1082 | 645 | 5.9 | 1.7 | ✓ | WUW | Partial 480 |
| 10/20/94 | E-37-7 | | | 550 | 5517 | 1359 | 636 | 8.7 | 2.1 | ✓ | WUW | 480 |
| 9/20/94 | ORF-SV ① | 9/20/94 | 9/21/94 | 572 | 1922 | 832.8 | 619 | 3.1 | 1.3 | ✓ | WUW | Partial 480 |
| 10/20/94 | E-37-8 | | | 452 | 2042 | 1136 | 611 | 3.3 | 1.9 | ✓ | WUW | 480 |
| 9/20/94 | ORF-SV ① | 9/20/94 | 9-21-94 | 574 | 2471 | 1034 | 493 | 5.0 | 2.1 | ✓ | WUW | Partial 480 |
| 10-20-94 | E-37-9 | | | 554 | 3134 | 1110 | 476 | 6.6 | 2.3 | ✓ | WUW | Partial 480 |
| 9/20/94 | ORF-SV ① | 9/20/94 | 9-21-94 | 594 | 4181 | 727.5 | 476 | 8.8 | 1.5 | ✓ | WUW | Partial 480 |
| 10-20-94 | E-37-10 | | | 454 | 5604 | 1110 | 454 | 12.3 | 2.4 | ✓ | WUW | 480 |
| 10/10/94 | ORF-SV | 10/7/94 | 10-12-94 | 452 | 1830 | 1119 | 627 | 2.9 | 1.8 | ✓ | WUW | Partial 480 |
| 11-3-94 | E-37-11 | | | 406 | 2653 | 1154 | 536 | 4.9 | 2.2 | ✓ | WUW | 480 |
| 10/10/94 | ORF-SV | 10/7/94 | 10-12-94 | 554 | 2121 | 1139 | 578 | 3.7 | 2.0 | ✓ | WUW | 480 |
| 11-4-94 | E-37-12 | | | 400 | 3441 | 872.8 | 497 | 6.9 | 1.8 | ✓ | WUW | 480 |
| 10/10/94 | ORF-SV | 10/7/94 | 10-12-94 | 454 | 1664 | 1180 | 583 | 2.9 | 2.0 | ✓ | WUW | Partial 480 |
| 11-4-94 | E-37-13 | | | 502 | 2538 | 966.8 | 500 | 5.1 | 1.9 | ✓ | WUW | 480 |
| 10/10/94 | ORF-SV | 10/7/94 | 10-12-94 | 556 | 1809 | 1187 | 699 | 2.6 | 1.7 | ✓ | WUW | Partial 480 |
| 11-4-94 | E-37-14 | | | 504 | 2568 | 1206 | 602 | 4.3 | 2.0 | ✓ | WUW | 480 |
| 10/10/94 | ORF-SV | 10/7/94 | 10-12-94 | 456 | 1802 | 943.7 | 635 | 2.8 | 1.5 | ✓ | WUW | Partial 480 |
| 11-3-94 | E-37-15 | | | 506 | 1811 | 1216 | 539 | 3.4 | 2.3 | ✓ | WUW | 480 |
| | | | | | | N | | | | | | |

Site Correction Factor = 1.8

VP Correction Factor (if applicable) = 1.8

Count Time = 500 SEC., unless otherwise noted

REVIEWED BY: 

Site HP Manager



OCS SAMPLE LOG

FOR INFORMATION ONLY

SITE NAME RIFIE Co

| COUNT DATE INITIAL 20 DAY | SAMPLE ID & LOCATION | DATE SAMPLED | DATE SEALED | OCS # | | B-214 pCi INITIAL 20 DAY | I-208 pCi INITIAL 20 DAY | MASS (grams) WET DRY | Ra-226 pCi/g | | Th-232 pCi/g INITIAL 20 DAY | DEPTH <15cm >15cm | TECH INITIAL 20 DAY | COMMENTS |
|---------------------------------|----------------------|--------------|-------------|-------------------|-------------------|--------------------------------|--------------------------------|----------------------------|-------------------------|-------------------|-----------------------------------|-------------------------|------------------------------------------|----------|
| | | | | INITIAL 20 DAY | INITIAL 20 DAY | | | | INITIAL/CORR. 20 DAY | INITIAL 20 DAY | | | | |
| 9/20/94 | ORF-SV ✓ | | | 576 | 2080 | 957.2 | 575 | | 3.6 | 1.7 | | WRW | QC 480 | |
| 10/20/94 | E-38-01 | 9/20/94 | 9/21/94 | 450 | 3356 | 8476 | 555 | | 6.0 | 1.5 | ✓ | WRW | Ra-226 = 6.3 ± 0.7 Th-230 = 6.0 ± 0.7 | |
| 9/20/94 | ORF-SV | | | | | | | | | | | | | |
| | E-38-02 | | | | | | | | | | | | | |
| | | | | | | | | | | | | | | |
| | | | | | | | | | | | | | | |
NA

Site Correction Factor = 1.8
 VP Correction Factor (if applicable) = 1.8
 Count Time = 500 SEC. unless otherwise noted

REVIEWED BY: [Signature]
 Site HP Manager

FCI THE CORPORATION ONLY

OCS SAMPLE LOG

SITE NAME RIFLE Co.

| COUNT DATE INITIAL 20 DAY | SAMPLE ID & LOCATION | DATE SAMPLED | DATE SEALED | OCS # INITIAL 20 DAY | BI-214 pCi INITIAL 20 DAY | TI-208 pCi INITIAL 20 DAY | MASS (grams) WET DRY | Re-226 pCi/g INITIAL/CORR. 20 DAY | Th-232 pCi/g INITIAL 20 DAY | DEPTH <15cm >15cm | TECH INITIAL 20 DAY | COMMENTS |
|---------------------------|----------------------|--------------|-------------|----------------------|---------------------------|---------------------------|----------------------|-----------------------------------|-----------------------------|-------------------|---------------------|--------------|
| 9/20/94 | ORF-SV-E | 9/20/94 | 9-21-94 | 578 | 1125 | 1005 | 505 | 2.2 | 2.0 | ✓ | WUW | Partial 480 |
| 10-20-94 | 38-02-1 | | | 426 | 2654 | 882.6 | 480 | 5.5 | 1.8 | | WUW | |
| 9/20/94 | ORF-SV-E-1 | 9/20/94 | 9/21/94 | 580 | 972.7 | 756.2 | 530 | 1.8 | 1.4 | ✓ | WUW | Partial 480 |
| 10/20/94 | E-38-03 | | | 460 | 1461 | 900.1 | 506 | 2.9 | 1.8 | | WUW | |
| 9/20/94 | ORF-SV-E-1 | 9/20/94 | 9/21/94 | 582 | 988.1 | 880.7 | 565 | 1.7 | 1.6 | ✓ | WUW | Partial- 480 |
| 10/20/94 | E-38-04 | | | 560 | 1642 | 1043 | 544 | 3.0 | 1.9 | | WUW | |
| 9/20/94 | ORF-SV-E-1 | 9/20/94 | 9/21/94 | 584 | 1552 | 765.8 | 564 | 2.8 | 1.4 | ✓ | WUW | Partial 480 |
| 10/20/94 | E-38-05 | | | 552 | 1401 | 957.2 | 546 | 2.6 | 1.8 | | WUW | |
| 9/20/94 | ORF-SV-E-1 | 9/20/94 | 9/21/94 | 586 | 1248 | 918.7 | 487 | 2.6 | 1.9 | ✓ | WUW | Partial 480 |
| 10-20-94 | E-38-06 | | | 526 | 2476 | 899.8 | 475 | 5.2 | 1.9 | | WUW | |
| 9/20/94 | ORF-SV-E-1 | 9/20/94 | 9/21/94 | 588 | 434.1 | 612.6 | 510 | 0.85 | 1.2 | ✓ | WUW | Partial- 480 |
| 10-20-94 | E-38-07 | | | 562 | 851.3 | 650.9 | 499 | 1.7 | 1.3 | | WUW | |
| 10/10/94 | ORF-SV | 10/7/94 | 10-12-94 | 458 | 2045 | 1040 | 619 | 3.3 | 1.7 | ✓ | WUW | Partial- 480 |
| 10/10/94 | E-38-08 | | | 402 | 2787 | 672.9 | 585 | 4.8 | 1.2 | | WUW | |
| 10/10/94 | ORF-SV | 10/7/94 | 10-12-94 | 558 | 2627 | 909.4 | 608 | 4.3 | 1.5 | ✓ | WUW | Partial- 480 |
| 11-4-94 | E-38-09 | | | 506 | 3623 | 1043 | 572 | 6.3 | 1.8 | | WUW | |
| 10/10/94 | ORF-SV | 10/7/94 | 10-11-94 | 460 | 3052 | 856.4 | 585 | 5.2 | 1.5 | ✓ | WUW | partial 480 |
| 11-1-94 | E-38-10 | | | 536 | 4233 | 1082 | 554 | 7.6 | 2.0 | | WUW | |
| | | | | | | N | | | | | | |

Site Correction Factor = 1.8
 VP Correction Factor (if applicable) = 1.8
 Count Time = 500 SEC., unless otherwise noted

REVIEWED BY: 

Site HP Manager



OCS SAMPLE LOG

FOR INFORMATION ONLY

SITE NAME RIFIE Co

| COUNT DATE INITIAL 20 DAY | SAMPLE ID & LOCATION | DATE SAMPLED | DATE SEALED | OCS # INITIAL 20 DAY | Bi-214 | Tl-208 | MASS (grams) WET DRY | Ra-226 | Th-232 | DEPTH < 15cm > 15cm | TECH INITIAL 20 DAY | COMMENTS |
|---------------------------------|----------------------|--------------|-------------|----------------------------|--------------------------|--------------------------|-------------------------------|----------------------------------|----------------------------|---------------------------|---------------------------|----------|
| | | | | | pCi INITIAL 20 DAY | pCi INITIAL 20 DAY | | pCi/g INITIAL/CORR. 20 DAY | pCi/g INITIAL 20 DAY | | | |
| 9/20/94 | ORF-SUV ① | 9/20/94 | | 590 | 821.7 | 957.2 | 545 | 1.5 | 1.8 | | WUW | Partial |
| 10-20-94 | E-39-01 | 9/20/94 | 9-21-94 | 462 | 1176 | 1057 | 533 | 2.2 | 2.0 | ✓ | WUW | 480 |
| 9/20/94 | ORF-SV ✓ | 9/20/94 | 9/21/94 | 592 | 829.1 | 746.6 | 462 | 1.8 | 1.6 | | WUW | Partial |
| 10/20/94 | E-39-02 ① | 9/20/94 | 9/21/94 | 472 | 700.6 | 856.4 | 446 | 1.6 | 1.9 | ✓ | WUW | 480 |
| | | | | | | | | | | | | |

Site Correction Factor = 1.8

VP Correction Factor (if applicable) = 1.8

Count Time = 500 SEC. unless otherwise noted

REVIEWED BY: [Signature] Site HP Manager

2

OCS SAMPLE LOG FOR THE CONSTRUCTION ONLY

SITE NAME RIFLE CO

| COUNT DATE INITIAL 20 DAY | SAMPLE ID & LOCATION | DATE SAMPLED | DATE SEALED | OCS # INITIAL 20 DAY | BI-214 pCi INITIAL 20 DAY | TI-208 pCi INITIAL 20 DAY | MASS (grams) WET DRY | Rn-226 pCi/g INITIAL 20 DAY | Tl-232 pCi/g INITIAL 20 DAY | DEPTH <15cm >15cm | TECH INITIAL 20 DAY | COMMENTS |
|---------------------------|----------------------|--------------|-------------|----------------------|---------------------------|---------------------------|----------------------|-----------------------------|-----------------------------|-------------------|---------------------|----------|
| 10-3-94 | ORF-SV-F | 9-30-94 | 10/4/94 | 424 | 280.8 | 620.4 | 680 | 0.91 | 0.91 | ✓ | SB | |
| 10/25/94 | 22-11 | 9-30-94 | 10/4/94 | 514 | 4843 | 1015 | 643 | 7.5 | 1.6 | ✓ | UNW | |
| 10-3-94 | ORF-SV-F | 9-30-94 | 10/11/94 | 524 | 964.6 | 957.2 | 685 | 1.4 | 1.4 | ✓ | SB | |
| 10/25/94 | 22-12 | 9-30-94 | 10/11/94 | 414 | 2128 | 760.2 | 628 | 3.4 | 1.2 | ✓ | UNW | |
| 9/21/94 | ORF-SV | 9/21/94 | 9/23/94 | 432 | 761.8 | 760.2 | 700 | 1.1 | 1.1 | ✓ | UNW | |
| 10/11/94 | F-22-13 | 9/21/94 | 9/23/94 | 412 | 959.6 | 769.0 | 643 | 1.5 | 1.2 | ✓ | UNW | |
| 9/21/94 | ORF-SV | 9/21/94 | 9/23/94 | 556 | 1096 | 1321 | 627 | 1.7 | 2.1 | ✓ | UNW | |
| 10/12/94 | F-22-14 | 9/21/94 | 9/23/94 | 586 | 1484 | 1350 | 568 | 2.6 | 2.4 | ✓ | UNW | |
| 9/21/94 | ORF-SV | 9/21/94 | 9/23/94 | 434 | 831.7 | 830.1 | 533 | 1.6 | 1.6 | ✓ | UNW | |
| 10/12/94 | F-22-15 | 9/21/94 | 9/23/94 | 480 | 914.1 | 1022 | 487 | 1.9 | 2.1 | ✓ | UNW | |
| 10-3-94 | ORF-SV-F | 9-30-94 | 10/4/94 | 488 | 1638 | 821.4 | 709 | 2.3 | 1.2 | ✓ | SB | |
| 10/25/94 | 22-16 | 9-30-94 | 10/4/94 | 516 | 2299 | 1024 | 676 | 3.4 | 1.5 | ✓ | UNW | |
| 10-3-94 | ORF-SV-F | 9-30-94 | 10/4/94 | 530 | 429 | 947.7 | 693 | 2.1 | 1.4 | ✓ | SB | |
| 10/25/94 | 22-17 | 9-30-94 | 10/4/94 | 416 | 1968 | 891.3 | 652 | 3.0 | 1.4 | ✓ | UNW | |
| 9/21/94 | ORF-SV | 9/21/94 | 9/23/94 | 558 | 560.3 | 1005 | 646 | 0.87 | 1.6 | ✓ | UNW | |
| 10/12/94 | F-22-18 | 9/21/94 | 9/23/94 | 588 | 577.8 | 1053 | 603 | 0.96 | 1.7 | ✓ | UNW | |
| 9/21/94 | ORF-SV | 9/21/94 | 9-23-94 | 436 | 981.8 | 943.7 | 659 | 1.5 | 1.4 | ✓ | UNW | 480 |
| 10-12-94 | F-22-19 | 9/21/94 | 9-23-94 | 510 | 600.4 | 1177 | 630 | 0.95 | 1.9 | ✓ | UNW | 480 |
| 9/21/94 | ORF-SV | 9/21/94 | 9/23/94 | 560 | 665.4 | 650.9 | 605 | 1.1 | 1.1 | ✓ | UNW | |
| 10/11/94 | F-22-20 | 9/21/94 | 9/23/94 | 512 | 932.8 | 909.4 | 591 | 1.6 | 1.5 | ✓ | UNW | 480 |

Site Correction Factor = 1.8

VP Correction Factor (if applicable) = 1.8

Count Time = 500 SEC., unless otherwise noted

REVIEWED BY:

Site HP Manager

OCS SAMPLE LOG

SITE NAME RIFIE Co

| COUNT DATE INITIAL 20 DAY | SAMPLE ID & LOCATION | DATE SAMPLED | DATE SEALED | OCS # INITIAL 20 DAY | BH-214 pCi INITIAL 20 DAY | TI-208 pCi INITIAL 20 DAY | MASS (grams) WET DRY | Re-226 pCi/g INITIAL/CORR. 20 DAY | Th-232 pCi/g INITIAL 20 DAY | DEPTH <15cm >15cm | TECH INITIAL 20 DAY | COMMENTS |
|---------------------------|----------------------|--------------|-------------|----------------------|---------------------------|---------------------------|----------------------|-----------------------------------|-----------------------------|-------------------|---------------------|-------------|
| 9/21/94 | ORF-SV ① | 9/21/94 | 9-23-94 | 438 | 693.5 | 917.5 | 612 | 1.1 | 1.5 | ✓ | WUW | partial 480 |
| 10-13-94 | F-22-23 | | | 406 | 864.2 | 699.1 | 596 | 1.5 | 1.2 | ✓ | PU | |
| 9/21/94 | ORF-SV ① | 9/21/94 | 9-23-94 | 562 | 363.3 | 105.3 | 566 | 0.64 | 1.9 | ✓ | WUW | partial 480 |
| 10-11-94 | F-22-24 | | | 514 | 570.9 | 842.4 | 551 | 1.0 | 1.5 | ✓ | PU | |
| 9/21/94 | ORF-SV ① | 9/21/94 | 9-23-94 | 440 | 381.3 | 838.9 | 543 | 0.70 | 1.5 | ✓ | WUW | partial 480 |
| 10-13-94 | F-22-25 | | | 506 | 805.6 | 823.2 | 525 | 1.5 | 1.6 | ✓ | PU | |
| 10-3-94 | ORF SV-F | 9-30-94 | 10/4/94 | 430 | 1160 | 943.7 | 602 | 1.9 | 1.6 | | SS | |
| 10/25/94 | 23-21 | | | 425 | 1346 | 961.2 | 527 | 2.6 | 1.8 | | WUW | Part. 480 |
| AN | | | | | | | | | | | | |

Site Correction Factor = 1.8
 VP Correction Factor (if applicable) = 1.8
 Count Time = 500 SEC., unless otherwise noted

REVIEWED BY: [Signature]

Site HP Manager

OCS SAMPLE LOG FOR RIFLE Co.

SITE NAME RIFLE Co.

| COUNT DATE INITIAL 20 DAY | SAMPLE ID & LOCATION | DATE SAMPLED | DATE SEALED | OCS # | BI-214 pCi INITIAL 20 DAY | TH-208 pCi INITIAL 20 DAY | MASS (grams) WET DRY | Ra-226 pCi/g INITIAL/CORR. 20 DAY | Th-232 pCi/g INITIAL 20 DAY | DEPTH <15cm >15cm | TECH INITIAL 20 DAY | COMMENTS |
|---------------------------|----------------------|--------------|-------------|-------|---------------------------|---------------------------|----------------------|-----------------------------------|-----------------------------|-------------------|---------------------|------------------------------------------|
| | | | | | | | | | | | | |
| | | | | | | | A | | | | | |
| 10-3-94 | ORF-SV-F ✓ | 9-30-94 | 10/4/94 | 532 | 826.8 | 1063 | 653 | 1.3 | 1.6 | | SS | QC 480 |
| 10/25/94 | 22-22 | | | 518 | 964.0 | 947.7 | 600 | 1.0 | 1.0 | ✓ | UNW | Ka-226 = 1.1 ± 0.3 Th-230 = 1.9 ± 0.4 |
| | | | | | | | | | | | | |
| | | | | | | | | | | | | |
Site Correction Factor = 1.8
 VP Correction Factor (if applicable) = 1.8
 Count Time = 500 Sec., unless otherwise noted


REVIEWED BY: [Signature] Site HP Manager

OCS SAMPLE LOG

RIFLE, CO

| COUNT DATE INITIAL 20 DAY | SAMPLE ID & LOCATION | DATE SAMPLED | DATE SEALED | OCS # INITIAL 20 DAY | BI-214 pCi INITIAL 20 DAY | TI-208 pCi INITIAL 20 DAY | MASS (grams) WET DRY | Re-226 pCi/g INITIAL 20 DAY | Th-232 pCi/g INITIAL 20 DAY | DEPTH <15cm >15cm | TECH INITIAL 20 DAY | COMMENTS |
|---------------------------|----------------------|--------------|-------------|----------------------|---------------------------|---------------------------|----------------------|-----------------------------|-----------------------------|-------------------|---------------------|----------------------------------------------------|
| 9/21/94 | ORF-SV ↓ | 9/21/94 | 9-23-94 | 448 | 639.5 | 742.8 | 549 | 1.2 | 1.4 | ✓ | WRW | |
| 10-12-94 | F-23-11 | 9/21/94 | 9-23-94 | 518 | 856.8 | 947.7 | 507 | 1.7 | 1.9 | ✓ | YU | |
| 9/21/94 | ORF-SV ↓ | 9/21/94 | 9/23/94 | 572 | 380.3 | 986.0 | 513 | 0.74 | 1.9 | ✓ | WRW | |
| 10/12/94 | F-23-12 | 9/21/94 | 9-23-94 | 484 | 811.8 | 821.4 | 458 | 1.8 | 1.8 | ✓ | WRW | |
| 9/21/94 | ORF-SV ↓ | 9/21/94 | 9-23-94 | 450 | 527.4 | 629.2 | 483 | 1.1 | 1.3 | ✓ | WRW | 480 |
| 10-13-94 | F-23-13 | 9/21/94 | 9-23-94 | 400 | 493.3 | 672.9 | 450 | 1.1 | 1.5 | ✓ | YU | |
| 9/21/94 | ORF-SV ↓ | 9/21/94 | 9-23-94 | 574 | 557.6 | 536.1 | 453 | 1.2 | 1.2 | ✓ | WRW | |
| 10-12-94 | F-23-14 | 9/21/94 | 9-23-94 | 420 | 253.4 | 970.0 | 420 | 0.60 | 2.3 | ✓ | YU | 480 |
| 9/21/94 | ORF-SV ↓ | 9/21/94 | 9-23-94 | 452 | 904.0 | 716.5 | 483 | 1.9 | 1.5 | ✓ | WRW | |
| 10-12-94 | F-23-15 | 9/21/94 | 9-23-94 | 520 | 1155 | 804.1 | 460 | 2.5 | 1.7 | ✓ | YU | 480 |
| 9/21/94 | ORF-SV ↓ | 9/21/94 | 9-23-94 | 576 | 774.3 | 890.2 | 705 | 1.1 | 1.3 | ✓ | WRW | |
| 10-13-94 | F-23-16 | 9/21/94 | 9-23-94 | 500 | 954.0 | 1120 | 689 | 1.4 | 1.6 | ✓ | YU | 480 |
| 9/21/94 | ORF-SV ↓ | 9/21/94 | 9-23-94 | 454 | 722.1 | 812.7 | 514 | 1.4 | 1.6 | ✓ | WRW | QC 480 RA-226 = 1.6 ± 0.4 Th-230 = 2.3 ± 0.4 |
| 10-13-94 | F-23-17 | 9/21/94 | 9-23-94 | 402 | 703.0 | 812.7 | 497 | 1.4 | 1.6 | ✓ | YU | |
| 9/21/94 | ORF-SV ↓ | 9/21/94 | 9-23-94 | 578 | 494.3 | 765.8 | 507 | 0.97 | 1.5 | ✓ | WRW | |
| 10-12-94 | F-23-18 | 9/21/94 | 10-12-94 | 522 | 778.9 | 851.9 | 492 | 1.6 | 1.7 | ✓ | YU | 480 |
| | | | | | | | A | | | | | |
| | | | | | | N | | | | | | |

Site Correction Factor = 1.8
 VP Correction Factor (if applicable) = 1.8
 Count Time = 500 SEC, unless otherwise noted

REVIEWED BY:  Site HP Manager

12



SITE NAME RIFLE, Co

OCS SAMPLE LOG

QA ORIGINAL

| COUNT DATE INITIAL 20 DAY | SAMPLE ID & LOCATION | DATE SAMPLED | DATE SEALED | OCS # | | TI-208 pCi INITIAL 20 DAY | MASS (grams) WET DRY | Ra-226 pCi/g INITIAL/CORR. 20 DAY | | Th-232 pCi/g INITIAL 20 DAY | DEPTH <15cm >15cm | TECH INITIAL 20 DAY | COMMENTS |
|---------------------------------|-------------------------|-----------------|----------------|-------------------|--------------------------|------------------------------------|-------------------------------|--------------------------------------------|-------------------|--------------------------------------|-------------------------|---------------------------|------------------------------------------------|
| | | | | INITIAL 20 DAY | pCi INITIAL 20 DAY | | | INITIAL/CORR. 20 DAY | INITIAL 20 DAY | | | | |
| 9/21/94 | ORF-SV ✓ | 9/21/94 | | 466 | 620.4 | 882.6 | 523 | 1.2 | 1.7 | | | W/W | |
| 10-12-94 | F-24-11 | 9/21/94 | 9-23-94 | 528 | 967.3 | 890.2 | 503 | 1.9 | 1.8 | ✓ | | W/W | |
| 9/21/94 | ORF-SV ✓ | 9/21/94 | | 590 | 512.5 | 823.2 | 539 | 0.95 | 1.5 | | | W/W | |
| 10-13-94 | F-24-12 | 9/21/94 | 9-23-94 | 502 | 782.8 | 804.1 | 525 | 1.5 | 1.5 | ✓ | | W/W | QC Ra-226 = 1.4 ± 0.4 Th-230 = 1.1 ± 0.3 |
| N A | | | | | | | | | | | | | |

Site Correction Factor = 1.8

VP Correction Factor (if applicable) = 1.8

Count Time = 500 SEC, unless otherwise noted

REVIEWED BY: [Signature]

Site HP Manager

OCS SAMPLE LOG

SITE NAME Rifle, Co

| COUNT DATE INITIAL 20 DAY | SAMPLE ID & LOCATION | DATE SAMPLED | DATE SEALED | OCS # INITIAL 20 DAY | BI-214 pCi INITIAL 20 DAY | TI-208 pCi INITIAL 20 DAY | MASS (grams) WET DIRY | Ra-226 pCi/g INITIAL 20 DAY | Th-232 pCi/g INITIAL 20 DAY | DEPTH <15cm >15cm | TECH INITIAL 20 DAY | COMMENTS | | | | | | | |
|---------------------------|----------------------|--------------|-------------|----------------------|---------------------------|---------------------------|-----------------------|-----------------------------|-----------------------------|-------------------|---------------------|----------|-----|-----|-----|-----|-----|-----|-----|
| | | | | | | | | | | | | | 584 | 412 | 462 | 524 | 586 | 430 | 464 |
| 9/21/94 | ORF-SV | 9/21/94 | 9/23/94 | 584 | 2609 | 746.6 | 567 | 4.6 | 1.3 | | WU | Partial | | | | | | | |
| 10/13/94 | F-24-6 | 9/21/94 | 9/23/94 | 412 | 3610 | 908.8 | 555 | 6.5 | 1.6 | ✓ | WU | Partial | | | | | | | |
| 9/21/94 | ORF-SV | 9/21/94 | 9/23/94 | 462 | 628.3 | 1250 | 492 | 1.3 | 2.5 | | WU | Partial | | | | | | | |
| 10-11-94 | F-24-7 | 9/21/94 | 9/23/94 | 524 | 1059 | 871.1 | 471 | 2.2 | 1.8 | ✓ | WU | Partial | | | | | | | |
| 9/21/94 | ORF-SV | 9/21/94 | 9/23/94 | 586 | 1046 | 890.2 | 535 | 2.0 | 1.7 | | WU | Partial | | | | | | | |
| 10-11-94 | F-24-8 | 9/21/94 | 9/23/94 | 430 | 599.7 | 1285 | 521 | 1.2 | 2.5 | ✓ | WU | 480 | | | | | | | |
| 9/21/94 | ORF-SV | 9/21/94 | 9/23/94 | 464 | 2890 | 891.3 | 560 | 5.2 | 1.6 | | WU | Partial | | | | | | | |
| 10-11-94 | F-24-9 | 9/21/94 | 9/23/94 | 426 | 4428 | 1101 | 553 | 8.0 | 2.0 | ✓ | WU | 480 | | | | | | | |
| 9/21/94 | ORF-SV | 9/21/94 | 9/23/94 | 588 | 1617 | 976.4 | 568 | 2.8 | 1.7 | | WU | Partial | | | | | | | |
| 10/3/94 | F-24-10 | 9/21/94 | 9/23/94 | 512 | 2655 | 1110 | 558 | 4.8 | 2.0 | ✓ | WU | 480 | | | | | | | |
| 9/21/94 | ORF-SV | 9/21/94 | 9/23/94 | 468 | 715.7 | 812.7 | 559 | 1.3 | 1.5 | | WU | Partial | | | | | | | |
| 10-11-94 | F-24-13 | 9/21/94 | 9/23/94 | 526 | 991.4 | 823.2 | 546 | 1.8 | 1.5 | ✓ | WU | 480 | | | | | | | |
| 9/21/94 | ORF-SV | 9/21/94 | 9/23/94 | 592 | 1876 | 689.2 | 499 | 3.8 | 1.4 | | WU | Partial | | | | | | | |
| 10-11-94 | F-24-14 | 9/21/94 | 9/23/94 | 532 | 2167 | 871.1 | 486 | 4.5 | 1.8 | ✓ | WU | 480 | | | | | | | |
| 9/21/94 | ORF-SV | 9/21/94 | 9/23/94 | 470 | 916.7 | 856.4 | 514 | 1.8 | 1.7 | | WU | Partial | | | | | | | |
| 10-11-94 | F-24-15 | 9/21/94 | 9/23/94 | 432 | 1285 | 917.5 | 501 | 2.6 | 1.8 | ✓ | WU | 480 | | | | | | | |
| 9/21/94 | ORF-SV | 9/21/94 | 9/23/94 | 594 | 1322 | 737.1 | 468 | 2.8 | 1.6 | | WU | Partial | | | | | | | |
| 10/12/94 | F-24-16 | 9/21/94 | 9/23/94 | 414 | 2219 | 777.1 | 450 | 4.9 | 1.7 | ✓ | WU | 480 | | | | | | | |
| 9/21/94 | ORF-SV | 9/21/94 | 9/23/94 | 472 | 566.4 | 847.6 | 514 | 1.1 | 1.6 | | WU | Partial | | | | | | | |
| 10-14-94 | F-24-17 | 9/21/94 | 9/23-14 | 428 | 737.9 | 917.5 | 504 | 1.5 | 1.8 | ✓ | WU | 480 | | | | | | | |

Site Correction Factor = 1.8
 VP Correction Factor (if applicable) = 1.8
 Count Time = 500 SEC, unless otherwise noted

REVIEWED BY: [Signature]
 Site HP Manager

9 11

| COUNT DATE INITIAL 20 DAY | SAMPLE ID & LOCATION | DATE SAMPLED | DATE SEALED | OCS # | BI-214 pCi INITIAL 20 DAY | TI-208 pCi INITIAL 20 DAY | MASS (grams) WET DRY | Re-226 pCi/g INITIAL 20 DAY | Th-232 pCi/g INITIAL 20 DAY | DEPTH <15cm >15cm | TECH INITIAL 20 DAY | COMMENTS |
|---------------------------|----------------------|--------------|-------------|-------|---------------------------|---------------------------|----------------------|-----------------------------|-----------------------------|-------------------|---------------------|------------------------|
| 9/21/94 | ORF-SV ① | 9/21/94 | | 564 | 834.8 | 832.8 | 495 | 1.7 | 1.7 | | WUW | Partial |
| 10-11-94 | F-23-3 | | 9-23-94 | 414 | 634.7 | 1110 | 457 | 1.4 | 2.4 | ✓ | PU | |
| 9/21/94 | ORF-SV ① | 9/21/94 | | 442 | 467.9 | 952.5 | 496 | 0.94 | 1.9 | | WUW | Partial |
| 10-13-94 | F-23-4 | | 9-23-94 | 408 | 684.7 | 751.5 | 464 | 1.5 | 1.6 | ✓ | WUW | Low Test Pass |
| 9/21/94 | ORF-SV ① | 9/21/94 | | 570 | 465.5 | 976.4 | 508 | 0.92 | 1.9 | | WUW | Partial |
| 10-11-94 | F-23-10 | | 9-23-94 | 416 | 472.6 | 1145 | 488 | 0.97 | 2.3 | ✓ | PU | |
| 9/21/94 | ORF-SV ① | 9/21/94 | | 448 | 639.5 | 742.8 | 549 | 1.2 | 1.4 | | WUW | Partial - w/sg 9/21/94 |
| 9/21/94 | F-23-11 | | 9/21/94 | | | | | | | ✓ | | |
| 9/21/94 | ORF-SV ① | 9/21/94 | | 456 | 492.5 | 803.9 | 491 | 1.0 | 1.6 | | WUW | Partial - 480 |
| 10-14-94 | F-23-19 | | 9-23-94 | 516 | 725.0 | 794.5 | 478 | 1.5 | 1.7 | ✓ | PU | |
| 9/21/94 | ORF-SV ① | 9/21/94 | | 580 | 453.1 | 918.9 | 478 | 1.0 | 1.9 | | WUW | Partial - 480 |
| 10-13-94 | F-23-20 | | 9-23-94 | 508 | 858.2 | 866.5 | 458 | 1.9 | 1.9 | ✓ | PU | |
| 9/21/94 | ORF-SV ① | 9/21/94 | | 458 | 317.7 | 1049 | 573 | 0.55 | 1.8 | | WUW | Partial - 480 |
| 10-13-94 | F-23-21 | | 9-23-94 | 410 | 732.4 | 856.4 | 563 | 1.3 | 1.5 | ✓ | PU | |
| 9/21/94 | ORF-SV ① | 9/21/94 | | 582 | 452.7 | 784.9 | 448 | 1.0 | 1.8 | | WUW | Partial - 480 |
| 10-13-94 | F-23-22 | | 9-23-94 | 510 | 757.7 | 641.3 | 410 | 1.8 | 1.6 | ✓ | PU | |
| 9/21/94 | ORF-SV ① | 9/21/94 | | 460 | 620.4 | 812.7 | 559 | 1.1 | 1.5 | | WUW | Partial - 480 |
| 10-14-94 | F-23-23 | | 9-23-94 | 424 | 309.8 | 966.2 | 522 | 0.59 | 1.8 | ✓ | PU | |
| 10-3-94 | ORF-SV-F | | 9-30-94 | 534 | 822.5 | 756.2 | 645 | 1.3 | 1.2 | | SB | |
| 10/25/94 | 23-2 | | 10/4/94 | 526 | 782.3 | 1225 | 544 | 1.4 | 2.3 | | WUW | Partial |

Site Correction Factor = 1.8

VP Correction Factor (if applicable) = 1.8

Count Time = 500 SEC., unless otherwise noted

REVIEWED BY: [Signature]

Site HP Manager

F5-INT-001-1, Rev. 1



MK-F
A MORRIS
JOHNSON COMPANY



CWNi Federal Environmental Services, Inc.

FOR THE GOVERNMENT ONLY

OCS SAMPLE LOG

SITE NAME RIFLE CO

| COUNT DATE INITIAL 20 DAY | SAMPLE ID & LOCATION | DATE SAMPLED | DATE SEALED | OCS # INITIAL 20 DAY | B-214 pCi/g INITIAL 20 DAY | TI-208 pCi/g INITIAL 20 DAY | MASS (gram) WET WRY | Ra-226 pCi/g INITIAL 20 DAY | Th-232 pCi/g INITIAL 20 DAY | DEPTH <15cm >15cm | TECH INITIAL 20 DAY | COMMENTS |
|---------------------------|----------------------|--------------|-------------|----------------------|----------------------------|-----------------------------|---------------------|-----------------------------|-----------------------------|-------------------|---------------------|-------------|
| 10-10-94 | ORF-SV- | | | 464 | 941.5 | 1092 | 576 | 1.6 | 1.9 | | PU | Partial 480 |
| 11-1-94 | F-29-1 | 10-7-94 | 10-11-94 | 440 | 1957 | 900.1 | 511 | 3.8 | 1.8 | ✓ | WW | |
| 10-10-94 | ORF-SV- | | | 562 | 1139 | 1110 | 618 | 1.8 | 1.8 | | PU | Partial 480 |
| 11-1-94 | F-29-2 | 10-7-94 | 10-11-94 | 538 | 1858 | 947.7 | 549 | 3.4 | 1.7 | ✓ | PU | Partial 480 |
| 10-10-94 | ORF-SV | | | 468 | 1319 | 1084 | 613 | 2.2 | 1.8 | | WW | Partial 480 |
| 11-1-94 | F-29-03 | 10-7-94 | 10-11-94 | 540 | 2432 | 976.4 | 539 | 4.5 | 1.8 | ✓ | WW | Partial 480 |
| 10-10-94 | ORF-SV | | | 566 | 1298 | 804.1 | 583 | 2.2 | 1.4 | | WW | Partial 480 |
| 11-1-94 | F-29-04 | 10-7-94 | 10-11-94 | 542 | 1970 | 1024 | 513 | 3.8 | 2.0 | ✓ | WW | Partial 480 |
| | | | | | | | | | | | | |
| | | | | | | | | | | | | |
A
N

Site Correction Factor = 1.8
 VP Correction Factor (if applicable) = 1.8
 Count Time = 500 SEC. unless otherwise noted

REVIEWED BY: [Signature]
 Site HP Manager

OCS SAMPLE LOG

SITE NAME GRAND JCT. CO

| COUNT DATE INITIAL 20 DAY | SAMPLE ID & LOCATION | DATE SAMPLED | DATE SEALED | OCS # INITIAL 20 DAY | Bi-214 | Tl-208 | MASS | Re-226 | Tl-232 | DEPTH ≤15cm >15cm | TECH | COMMENTS |
|---------------------------------|-------------------------------------------|--------------|-------------|----------------------------|--------------------------|--------------------------|-----------------------|----------------------------------|----------------------------|-------------------------|-------------------|-----------|
| | | | | | pCi INITIAL 20 DAY | pCi INITIAL 20 DAY | (grams) WET DRY | pCi/g INITIAL/CORR. 20 DAY | pCi/g INITIAL 20 DAY | | INITIAL 20 DAY | |
| 2-27-97 | ORF-SV-G- 3-2 | 2-26-97 | 2-27-97 | 8 | 882.14 | | 747.33 | 1.18 | | 715 | ROG | >6" @ 24" |
| 3-25-97 | | | | | 616.73 | 642.6 | 0.95 | | ROG | | | |
| 2-27-97 | ORF-SV-G- 3-4 | 2-26-97 | 2-27-97 | 8 | 1439.2 | | 666.31 | 2.16 | | 715 | ROG | >6" @ 24" |
| 3-25-97 | | | | | 1538.7 | 596.09 | 2.58 | | ROG | | | |
| 2-27-97 | ORF-SV-G- 3-63 03-03 10c 2-27-97 | 2-26-97 | 2-27-97 | 8 | 729.08 | | 699.05 | 1.04 | | 715 | ROG | >6" @ 24" |
| 3-25-97 | | | | | 992.93 | 641.9 | 1.55 | | ROG | | | |
| N/A | | | | | | | | | | | | |

Site Correction Factor = 2

VP Correction Factor (if applicable) = N/A

Count Time = 500 sec., unless otherwise noted

REVIEWED BY: [Signature]
Site HP Manager

FOR INFORMATION ONLY

OCS SAMPLE LOG

FIRM NAME RIFLE, CO

| COUNT DATE INITIAL 20 DAY | SAMPLE ID & LOCATION | DATE SAMPLED | DATE SEALED | OCS # | | BI-214 pCi INITIAL 20 DAY | | TI-208 pCi INITIAL 20 DAY | | MASS (grams) WET DRY | | Re-226 pCi/g INITIAL/CORR. 20 DAY | | Th-232 pCi/g INITIAL 20 DAY | | DEPTH <15cm >15cm | TECH INITIAL 20 DAY | COMMENTS |
|---------------------------|----------------------|--------------|-------------|----------------|----------------|---------------------------|----------------|---------------------------|----------------|----------------------|----------------|-----------------------------------|-----|-----------------------------|---------|-------------------|---------------------|----------|
| | | | | INITIAL 20 DAY | INITIAL 20 DAY | INITIAL 20 DAY | INITIAL 20 DAY | INITIAL 20 DAY | INITIAL 20 DAY | INITIAL 20 DAY | INITIAL 20 DAY | | | | | | | |
| 7-12-94 | ORF-SV-# | | | | 558 | 2202 | 1072 | 563 | | | | 3.9 | 1.9 | 90 | Partial | | | |
| 7/13/94 | G-4-1 ① | 9-9-94 | 9/13/94 | | 562 | 3365 | 1034 | 543 | | | | 6.2 | 1.9 | 600 | 480 | | | |
| 1-10-94 | ORF-SV-✓ | | | | 500 | 5980 | 1034 | 575 | | | | 1.0 | 1.8 | 90 | Partial | | | |
| 1-4-94 | G-4-05 | 10-7-94 | 10-12-94 | | 508 | 685.7 | 1063 | 501 | | | | 1.4 | 2.1 | 90 | 480 | | | |
| 1-10-94 | ORF-SV-✓ | | | | 402 | 598.1 | 777.7 | 570 | | | | 1.0 | 1.4 | 90 | Partial | | | |
| 1-3-94 | G-4-07 | 10-7-94 | 10-12-94 | | 505 | 762.7 | 823.2 | 501 | | | | 1.5 | 1.6 | 90 | 480 | | | |
| 2-10-94 | ORF-SV-✓ | | | | 502 | 472.8 | 871.1 | 585 | | | | 0.81 | 1.5 | 90 | Partial | | | |
| 1-3-94 | G-4-08 | 10-7-94 | 10-12-94 | | 410 | 707.0 | 666 | 507 | | | | 1.4 | 2.1 | 90 | 480 | | | |
| 2-10-94 | ORF-SV-✓ | | | | 404 | 656.9 | 935.0 | 609 | | | | 1.1 | 1.5 | 90 | Partial | | | |
| 1-4-94 | G-4-09 | 10-7-94 | 10-12-94 | | 510 | 590.2 | 1024 | 535 | | | | 1.1 | 1.9 | 90 | 480 | | | |
| 2-10-94 | ORF-SV-✓ | | | | 510 | 758.2 | 756.2 | 558 | | | | 1.4 | 1.4 | 90 | Partial | | | |
| 1-4-94 | G-4-06 | 10-7-94 | 10-12-94 | | 406 | 1051 | 725.3 | 469 | | | | 2.2 | 1.5 | 90 | 480 | | | |
| 1-10-94 | ORF-SV ✓ | | | | 412 | 721.3 | 734.0 | 555 | | | | 1.3 | 1.3 | 600 | Partial | | | |
| 1-3-94 | G-4-10 ① | 10-7-94 | 10-12-94 | | 510 | 1018 | 784.9 | 471 | | | | 2.2 | 1.7 | 90 | 480 | | | |
| 7-10-94 | ORF-SV-# | | | | | | | | | | | | | | | | | |
| | G-4-11 | | | | | | | | | | | | | | | | | |

Correction Factor = 1.8
 Correction Factor (if applicable) = 1.8
 Count Time = 500 SEC., unless otherwise noted

REVIEWED BY:  Site HIP Manager

10

OCS SAMPLE LOG

FOR INFORMATION ONLY

TE NAME RIFLE, CO

| COUNT DATE INITIAL 20 DAY | SAMPLE ID & LOCATION | DATE SAMPLED | DATE SEALF | OCS # INITIAL 20 DAY | BI-214 pCi INITIAL 20 DAY | Ti-208 pCi INITIAL 20 DAY | MASS (grams) WET DRY | Re-226 pCi/g INITIAL 20 DAY | Th-232 pCi/g INITIAL 20 DAY | DEPTH Δ 15cm > 15cm | TECH INITIAL 20 DAY | COMMENTS |
|---------------------------|----------------------|----------------|-----------------|----------------------|---------------------------|---------------------------|----------------------|-----------------------------|-----------------------------|-------------------------------------|---------------------|-----------------------------------------------------------|
| | <u>ORF-SV</u> | | | | | <u>A</u> | | | | | | |
| | <u>G-4-D1</u> | | | | | <u>N</u> | | | | | | |
| <u>7-12-94</u> | <u>ORF-SV-1</u> | <u>9-9-94</u> | <u>9-13-94</u> | <u>460</u> | <u>1080</u> | <u>1010</u> | <u>537</u> | <u>2.0</u> | <u>1.9</u> | <input checked="" type="checkbox"/> | <u>PU</u> | <u>486</u> |
| <u>10-13-94</u> | <u>G-4-02</u> | | | <u>564</u> | <u>1391</u> | <u>1024</u> | <u>529</u> | <u>2.6</u> | <u>1.9</u> | <input checked="" type="checkbox"/> | <u>WAW</u> | |
| <u>2-10-94</u> | <u>ORF-SV-1</u> | | | <u>410</u> | <u>815.8</u> | <u>725.3</u> | <u>620</u> | <u>1.3</u> | <u>1.2</u> | <input checked="" type="checkbox"/> | <u>PU</u> | <u>480</u> |
| <u>1-3-94</u> | <u>G-4-03</u> | <u>10-7-94</u> | <u>10-12-94</u> | <u>582</u> | <u>1227</u> | <u>708.4</u> | <u>547</u> | <u>2.2</u> | <u>1.3</u> | <input checked="" type="checkbox"/> | <u>WAW</u> | |
| <u>10-10-94</u> | <u>ORF-SV-1</u> | | | <u>400</u> | <u>634.7</u> | <u>760.2</u> | <u>606</u> | <u>1.0</u> | <u>1.3</u> | <input checked="" type="checkbox"/> | <u>PU</u> | <u>QC</u> |
| <u>11-3-94</u> | <u>G-4-04</u> | <u>10-7-94</u> | <u>10-12-94</u> | <u>182</u> | <u>671.2</u> | <u>882.6</u> | <u>530</u> | <u>1.3</u> | <u>1.7</u> | <input checked="" type="checkbox"/> | <u>WAW</u> | <u>Ra-226 = 1.9 ± 0.4/80</u> <u>Th-230 = 1.6 ± 0.4</u> |
| | | | | | | | | | | | | |
| | | | | | | | | | | | | |
REVIEWED BY: [Signature]

Site HEP Manager

Correction Factor = 1.8
 Correction Factor (if applicable) = 1.8
 Count Time = 500 SEC., unless otherwise noted

OCS SAMPLE LOG

SITE NAME RIFLE, Co

| COUNT DATE INITIAL 20 DAY | SAMPLE ID & LOCATION | DATE SAMPLED | DATE SEALED | OCS # INITIAL 20 DAY | BI-214 pCi INITIAL 20 DAY | TI-208 pCi INITIAL 20 DAY | MASS (grams) WET DRY | Ra-226 pCi/g INITIAL/CORR 20 DAY | Th-232 pCi/g INITIAL 20 DAY | DEPTH <15cm >15cm | TECH INITIAL 20 DAY | COMMENTS |
|---------------------------|----------------------|--------------|-------------|----------------------|---------------------------|---------------------------|----------------------|----------------------------------|-----------------------------|-------------------|---------------------|------------------------------------------------|
| 10/14/94 | ORF-SV | 10/14/94 | | 538 | 458.6 | 765.8 | 584 | 0.79 | 1.3 | | WVW | 480 |
| 11-10-94 | G-5-01 ✓ | 10-17-94 | | 402 | 548.1 | 716.5 | 581 | 0.94 | 1.2 | ✓ | WV | 480 |
| 10-10-94 | ORF-SV j | 10-7-94 | | 516 | 416.6 | 1101 | 570 | 0.73 | 1.9 | ✓ | WVW | 480 |
| 11-2-94 | G-5-02 | 10-12-94 | | 590 | 1063 | 717.9 | 489 | 2.2 | 1.5 | ✓ | WVW | 480 |
| 10-10-94 | ORF-SV j | 10-7-94 | | 416 | 644.2 | 725.3 | 625 | 1.0 | 1.2 | | WVW | 480 |
| 11-3-94 | G-5-03 | 10-12-94 | | 484 | 434.6 | 620.4 | 559 | 2.4 | 1.1 | ✓ | WVW | QC Rc-226 = 1.6 ± 0.4 Th-230 = 2.9 ± 0.5 |
| 10-10-94 | ORF-SV j | 10-7-94 | | 518 | 306.2 | 1053 | 579 | 0.53 | 1.8 | ✓ | WVW | 480 |
| 11-4-94 | G-5-04 | 10-12-94 | | 512 | 743.1 | 851.9 | 508 | 1.5 | 1.7 | ✓ | WV | 480 |
| A | | | | | | | | | | | | |
| N | | | | | | | | | | | | |

Site Correction Factor = 1.8
 VP Correction Factor (if applicable) = 1.8
 Count Time = 500 SEC., unless otherwise noted

REVIEWED BY: [Signature] Site HP Manager

OCS SAMPLE LOG

FOR INFORMATION ONLY

 SITE NAME RIFLE, CO

| COUNT DATE INITIAL 20 DAY | SAMPLE ID & LOCATION | DATE SAMPLED | DATE SEALED | OCS # INITIAL 20 DAY | Bi-214 | Tl-208 | MASS | Po-226 | Th-232 | DEPTH ≤15cm >15cm | TECH INITIAL 20 DAY | COMMENTS |
|---------------------------------|-------------------------|--------------------|---------------------|----------------------------|--------------------------|--------------------------|-----------------------|----------------------------------|----------------------------|-------------------------|---------------------------|----------|
| | | | | | pCi INITIAL 20 DAY | pCi INITIAL 20 DAY | (grams) WET DRY | pCi/g INITIAL/CORR. 20 DAY | pCi/g INITIAL 20 DAY | | | |
| 10-10-94 | ORF-SV- | | | 504 | 556.5 | 947.7 | 587 | 10.95 | 1.6 | | PU | Partial |
| 11-4-94 | G-5-01 | 10-7-94 | 10-12-94 | 408 | 711.7 | 838.9 | 512 | 1.4 ^A | 1.6 | ✓ | PU | 480 |
| 10-10-94 | ORF-SV ① | | | 512 | 719.1 | 813.6 | 584 | 1.2 | 1.4 | | WUW | partial |
| 11-3-94 | G-5-05 | 10-7-94 | 10-12-94 | 412 | 532.2 | 1171 | 511 | 1.0 | 2.3 | ✓ | PU | 480 |
| 10-10-94 | ORF-SV ① | | | 418 | 496.5 | 777.7 | 554 | 0.90 | 1.4 | | WUW | partial |
| 11-3-94 | G-5-06 | 10-7-94 | 10-12-94 | 512 | 961.6 | 804.1 | 475 | 2.0 | 1.7 | ✓ | PU | 480 |
| 10-10-94 | ORF-SV ① | | | 520 | 779.8 | 650.9 | 568 | 1.4 | 1.1 | | WUW | partial |
| 11-3-94 | G-5-07 | 10-7-94 | 10-12-94 | 400 | 1191 | 865.1 | 485 | 2.5 | 1.8 | ✓ | PU | 480 |
| 10-10-94 | ORF-SV ① | | | 420 | 792.8 | 961.2 | 597 | 1.3 | 1.6 | | WUW | partial |
| 11-4-94 | G-5-08 | 10-7-94 | 10-12-94 | 514 | 822.9 | 976.4 | 512 | 1.6 | 1.9 | ✓ | WUW | 480 |
| 10-10-94 | ORF-SV ① | | | 522 | 898.0 | 708.4 | 588 | 1.5 | 1.2 | | WUW | partial |
| 11-4-94 | G-5-09 | 10-7-94 | 10-12-94 | 410 | 1172 | 585.5 | 504 | 2.3 | 1.2 | ✓ | WUW | 480 |
| N A | | | | | | | | | | | | |

 Site Correction Factor = 1.8

 VP Correction Factor (if applicable) = 1.8

 Count Time = 500 SEC unless otherwise noted

REVIEWED BY:

Site HP Manager

OCS SAMPLE LOG

FOR INFORMATION ONLY

SITE NAME RIFLE Co

| COUNT DATE INITIAL 20 DAY | SAMPLE ID & LOCATION | DATE SAMPLED | DATE SEALED | OCS # | Bi-214 | Tl-208 | MASS (grams) WET DRY | Ra-226 | Th-232 | DEPTH <15cm >15cm | TECH INITIAL 20 DAY | COMMENTS |
|---------------------------------|----------------------|--------------|-------------|-------|-------------------|--------------------------|----------------------------|--------------------------|----------------------------------|-------------------------|---------------------------|----------|
| | | | | | INITIAL 20 DAY | pCi INITIAL 20 DAY | | pCi INITIAL 20 DAY | pCi/g INITIAL/CORR. 20 DAY | | | |
| 10-10-94 | ORF-SV | | | 422 | 957.2 | 672.9 | 599 | 1.6 | 1.1 | | WU | partial |
| 11-3-94 | G-6-01 | 10-7-94 | 10-12-94 | 500 | 873.5 | 1091 | 516 | 1.7 | 2.1 | ✓ | WU | 480 |
| 10-10-94 | ORF-SV | | | 524 | 526.1 | 813.6 | 591 | 0.89 | 1.4 | | WU | partial |
| 11-4-94 | G-6-02 | 10-7-94 | 10-12-94 | 516 | 749.5 | 947.7 | 503 | 1.5 | 1.9 | ✓ | WU | 480 |
| 10-10-94 | ORF-SV | | | 424 | 785.6 | 812.7 | 542 | 1.4 | 1.5 | | WU | partial |
| 11-3-94 | G-6-03 | 10-7-94 | 10-12-94 | 402 | 900.0 | 1092 | 466 | 1.9 | 2.3 | ✓ | WU | 480 |
| 10-10-94 | ORF-SV | | | 526 | 650.2 | 851.9 | 521 | 1.2 | 1.6 | | WU | partial |
| 11-4-94 | G-6-04 | 10-7-94 | 10-12-94 | 412 | 1130 | 751.5 | 448 | 2.5 | 1.7 | ✓ | WU | 480 |
| 10-10-94 | ORF-SV | | | 426 | 506.0 | 952.5 | 543 | 0.93 | 1.8 | | WU | partial |
| 11-3-94 | G-6-05 | 10-7-94 | 10-12-94 | 502 | 788.3 | 1101 | 457 | 1.7 | 2.4 | ✓ | WU | 480 |
| N/A | | | | | | | | | | | | |

Site Correction Factor = 1.8
 P Correction Factor (if applicable) = 1.8
 Count Time = 500 SEC., unless otherwise noted

REVIEWED BY: [Signature]
 Site HP Manager

RF-510 / RF-480.
SOIL VERIFICATION DATA

| GRID I.D. | COORDINATES | SAMPLE NO. (RFL-SV-) | APPROX. Depth | Ra-226 (pCi/g) | | COMMENTS | Date sampled |
|-----------|-------------------------------------------------------------------------------------------------|----------------------|---------------|----------------|-------|------------------------|--------------|
| | | | | INITIAL | FINAL | | |
| ✓ 1 | N25348, E59228; N25360, E59228; N25362, E59224; E59224, N25348; | 5902 | 0.50 | 2.00 | 3.10 | RF-480 | 2/8/95 |
| ✓ 2 | N25344, E59207; N25358.5, E59207; N25360, E59228; N25348, E59228 | 5920 | 0.50 | 2.00 | 3.30 | RF-480 | 2/8/95 |
| ✓ 3 | N25337, E59168; N25357, E59168; N25357.5, E59192; N25341, E59192; | 5918 | 0.50 | 3.80 | 4.10 | RF-480 | 2/8/95 |
| ✓ 4 | N25330, E59138; N25355, E59138; N25358, E59168; N25337, E59168; | 5895 | 0.50 | 4.30 | 5.10 | RF-480 | 2/8/95 |
| ✓ 5 | N25330, E59138; N25355, E59138; N25355, E59138; N25330, E59138; | 5926 | 0.50 | 3.00 | 4.10 | RF-480 | 2/8/95 |
| ✓ 6 | N25333, E59078; N25353, E59078; N25353, E59108; N25338, E59108; | 5906 | 0.50 | 6.50 | 9.30 | RF-480 | 2/8/95 |
| ✓ 7 | N25220, E59048; N25352, E59048; N25353, E59078; N25330, E59078; | 5899 | 0.50 | 4.70 | 7.20 | RF-480 | 2/8/95 |
| ✓ 8 | N25330, E59018; N25352, E59018; N25352, E59048; N25330, E59048; | 5934 | 0.50 | 5.40 | 5.90 | RF-480 | 2/8/95 |
| ✓ 9 | N25330, E58988; N25352, E58988; N25352, E59018; N25330, E59018; | 5910 | 0.50 | 7.30 | 9.40 | RF-480 | 2/8/95 |
| ✓ 10 | N25330, E58958; N25355, E58958; N25353, E58988; N25330, E58988; | 5928 | 0.50 | 1.87 | 8.50 | RF-480 | 2/8/95 |
| ✓ 11 | N25330, E58928; N25358, E58928; N25355, E58958; N25330, E58958; | 5950 | 0.50 | 2.30 | 3.70 | RF-480 | 2/8/95 |
| ✓ 12 | N25330, E58898; N25358, E58898; N25358, E58928; N25330, E58928; | 5930 | 0.50 | 1.90 | 3.80 | RF-480 | 2/8/95 |
| ✓ 13 | N25330, E58868; N25362, E58868; N25360, E58898; N25330, E58868; | 5923 | 0.50 | 2.70 | 2.70 | RF-480 | 2/8/95 |
| ✓ 14 | N25330, E58855; N25347, E58855; N25333, E58859; N25353, E58863; N25362, E58868; N25330, E58868; | 5948 | 0.50 | 3.30 | 3.90 | RF-480 / RF-510 | 2/8/95 |
| ✓ 15 | N25317, E59048; N25330, E59048; N25330, E59078; N25333, E59078; | 5938 | 0.50 | 3.00 | 5.00 | RF-480 / RF-510 | 2/8/95 |
| ✓ 16 | N25309, E59018; N25330, E59018; N25330, E59048; N25317, E59048; | 5894 | 0.50 | 1.30 | 2.00 | RF-480 / RF-510 | 2/8/95 |
| ✓ 17 | N25307, E58988; N25330, E58988; N25330, E59018; N25309, E59018; | 5924 | 0.50 | 3.60 | 6.10 | RF-480 / RF-510 | 2/8/95 |
| ✓ 18 | N25300, E58958; N25330, E58958; N25300, E58988; N25307, E58988; | 5918 | 0.50 | 3.70 | 4.20 | RF-480 / RF-510 | 2/8/95 |
| ✓ 19 | N25300, E58928; | 5893 | 0.80 | 2.70 | 3.40 | RF-480 / RF-510 | 2/8/95 |
| ✓ 20 | N25300, E58898; | 5944 | 0.80 | 1.30 | 2.20 | RF-480 / RF-510 | 2/8/95 |
| ✓ 21 | N25300, E58868; | 5954 | 0.50 | 1.70 | 2.80 | RF-480 / RF-510 | 2/8/95 |
| ✓ 22 | N25300, E58838; | 5901 | 0.50 | 1.90 | 2.20 | RF-510 | 2/8/95 |
| ✓ 23 | N25300, E588008; N25321.5, E58800; N25314, E58838; N25300, E58838; | 5958 | 0.00 | 2.00 | 3.10 | NOT Excavated; | |
| ✓ 24 | N25300, E58778; N25330, E58778; N25321.5, E58838; N25300, E58838; | 5959 | 0.25 0.00 | 0.84 | 1.00 | Verified Clean; RF-510 | |



MK-FERGUSON COMPANY
A MORRISON KNUDSEN COMPANY

John
Dave

INTER-OFFICE CORRESPONDENCE

| | | | |
|-----------|--------------------------|-----------|----------------------|
| TO: | J.V. Innis <i>JV</i> | DATE: | July 17, 1996 |
| LOCATION: | Albuquerque | FROM: | D.L. Lewis <i>DL</i> |
| SUBJECT: | RF-480 Completion Report | LOCATION: | Rifle, CO |

Attached are the remaining portions of the completion report for RF-480. The Supplemental Standard and Photograph sections were sent to you on May 28, 1996.

Two data items in the May 28, 1996, IOC are incorrect. The average width of contamination was 42 feet, excluding utility poles, and the total area is about 2.3 acres.

Please contact R. Fencil or me, if you have any questions.

DL/pk

File: RF-480 w/attachments
4.4 w/out attachments

TL

MK-FERGUSON CO.
ALBUQUERQUE

JUL 19 1996

RECEIVED



MK-FERGUSON COMPANY
A MORRISON KNUDSEN COMPANY

INTER-OFFICE CORRESPONDENCE

DATE: May 28, 1996
TO: J.V. Innis FROM: D.L. Lewis *DL*
LOCATION: Albuquerque, NM LOCATION: Rifle, CO
SUBJECT: Supplemental Standard Package for RF-480

Vicinity property RF-480 consists of an estimated 8300 cubic yards of contaminated material beneath the D&RG Railroad bed and around the bases of several utility pole between the Colorado River and the Old Rifle processing site. The limits of the vicinity property are shown on the attached drawing sheets 1 through 8 of 8. Coordinates are shown on the drawings.

The length of contamination is approximately 2400 feet long and the average width is approximately 225 feet excluding the utility pole bases. Total area is approximately 13 acres.

Depth of contamination varies from 0 to 8.5 feet in the railroad bed and from 0 to 6.5 feet at the utility pole bases. See attached cross sections A through EE.

Test holes were drilled with a 4-inch diameter auger at 75-foot intervals along the railroad. Bore hole locations are shown on the drawings and cross sections. Results of each boring log are attached to the specific cross section. OCS sample logs are also attached.

Photos of the area are attached.

The cost of complete remedial action on this property would be unreasonably high relative to the long term benefits and the R.R.M. do not pose a clear present or future hazard. It is very unlikely buildings will be erected or that people will spend long periods of time on the property.

A material quantity takeoff is also attached. If a detailed cost estimate is desired, please have the Cleveland office provide one.

Please contact Bob Fencil or me if you have any questions.

DH/DL/sh

File: RF-408 w/attachment
4.4 w/o attachment

DL

DOSE RATE LOG

SITE: ORF-PROCESS - SUPPLEMENTAL STANDARDS REF 480 DATE: 5-19-95
 INST. MODEL: BICRON SERIAL NO.: 13845M
 BACKGROUND 3 FT. 14 μ rem/h SURVEYOR: K. COSAROVE

| LOCATION (ATTACH MAP OF AREA IF NECESSARY) | 3 Ft. Dose Rate (μ rem/h) | 3 Ft. Net Dose Rate (μ rem/h) | AREA AVERAGE (μ rem/h) | 1 Ft. Dose Rate (μ rem/h) |
|--------------------------------------------------|--------------------------------------|------------------------------------------|-----------------------------------|--------------------------------------|
| BOREHOLE I.D. # | | | | |
| #45 NN2 | 10 | -4 | | 15 |
| #43 mm | 10 | -4 | | 10 |
| #44 mm2 | 10 | -4 | | 15 |
| #42 LL | 10 | -4 | | 15 |
| #47 LL2 | 10 | -4 | -4 | 10 |
| #41 KK | 10 | -4 | | 10 |
| #48 KK2 | 10 | -4 | | 10 |
| #40 JJ | 10 | -4 | | 15 |
| #50 JJ3 | 10 | -4 | | 10 |
| #39 II | 10 | -4 | | 10 |
| #52 II2 | 10 | -4 | -4 | 15 |
| #38 HH | 10 | -4 | | 10 |
| #53 HH2 | 10 | -4 | | 10 |
| #37 GG | 10 | -4 | | 10 |
| #54 GG2 | 15 | 1 | | 10 |
| #36 FF | 10 | -4 | | 15 |
| #57 FF3 | 10 | -4 | -3 | 10 |
| N A | | | | |

Reviewed By: James Stadelman

Date: 5-19-95

DOSE RATE LOG

SITE: ORF-PROCESS - SUPPLEMENTAL STANDARDS R-480 DATE: 5-19-95
 INST. MODEL: BICRON SERIAL NO.: B845M
 BACKGROUND 3 FT. 14 $\mu\text{rem/h}$ SURVEYOR: K. BOSAROV

| LOCATION (ATTACH MAP OF AREA IF NECESSARY) | 3 Ft. Dose Rate ($\mu\text{rem/h}$) | 3 Ft. Net Dose Rate ($\mu\text{rem/h}$) | AREA AVERAGE ($\mu\text{rem/h}$) | 1 Ft. Dose Rate ($\mu\text{rem/h}$) |
|--------------------------------------------------|---------------------------------------------|-------------------------------------------------|------------------------------------------|---------------------------------------------|
| BOREHOLE I.D. # | | | | |
| #35 EE | 15 | 1 | | 15 |
| #59 EE2 | 10 | -4 | | 10 |
| #34 DD | 15 | 1 | | 15 |
| #33 CC | 15 | 1 | -0.25 | 15 |
| #32 BB | 20 | 6 | | 20 |
| #31 AA | 20 | 6 | | 20 |
| #30 Z | 10 | -4 | 3 | 10 |
| #29 Y | 10 | -4 | | 10 |
| #28 X | 10 | -4 | | 10 |
| #27 W | 10 | -4 | -0.67 | 15 |
| #26 V | 10 | -4 | | 10 |
| #25 U | 20 | 6 | | 25 |
| #81 Tc | 25 | 14 | 5 | 35 |
| #82 Ss | 20 | 6 | | 30 |
| #22 R | 20 | 6 | | 25 |
| #21 Q | 40 | 26 | 13 | 35 |
| #20 P | 60 | 46 | | 80 |
| #19 O | 45 | 31 | | 50 |
| #18 N | 45 | 31 | 36 | 50 |
| Reviewed By: <i>K. Bosarov</i> | Date: <u>5-22-95</u> | | | |

DOSE RATE LOG

SUPPLEMENTAL
 SITE: ORF-PROCESS - STANDARDS REF 480 DATE: 5.19.95
 INST. MODEL: BICRON SERIAL NO.: 13845M
 BACKGROUND 3 FT. 14 μ rem/h SURVEYOR: K. COSAROV

| LOCATION (ATTACH MAP OF AREA IF NECESSARY) | 3 Ft. Dose Rate (μ rem/h) | 3 Ft. Net Dose Rate (μ rem/h) | AREA AVERAGE (μ rem/h) | 1 Ft. Dose Rate (μ rem/h) |
|--------------------------------------------------|--------------------------------------|------------------------------------------|-----------------------------------|--------------------------------------|
| BOREHOLE I.D. # | | | | |
| #17 M | 85 | 71 | | 90 |
| #16 L | 30 | 16 | | 35 |
| #15 K | 40 | 26 | 38 | 50 |
| #14 J | 30 | 16 | | 35 |
| #13 I | 53 | 39 | | 65 |
| #12 H | 90 | 76 | 44 | 120 |
| #11 G | 85 | 71 | | 100 |
| #10 F | 110 | 96 | | 150 |
| #9 E | 121 | 107 | 91 | 154 |
| #8 D | 200 | 186 | | 275 |
| #7 C | 132 | 118 | | 165 |
| #6 B | 50 | 36 | 113 | 50 |
| #95 Aa | 35 | 21 | | 35 |
| #1 -A1a | 35 | 21 | | 35 |
| #61 -A3 | 20 | 6 | | 20 |
| #99 -B1a | 30 | 16 | | 30 |
| #62 -B2 | 20 | 6 | 14 | 20 |
| | | | | |
| | | | | |
| | | | | |

Reviewed By: [Signature]

Date: 5-22-95

DOSE RATE LOG

SITE: ORF-PROCESS - SUPPLEMENTAL STANDARDS RE480 DATE: 5-19-95
 INST. MODEL: BICRON SERIAL NO.: B845m
 BACKGROUND 3 FT. 14 $\mu\text{rem/h}$ SURVEYOR: K. COSGROVE

| LOCATION (ATTACH MAP OF AREA IF NECESSARY) | 3 Ft. Dose Rate ($\mu\text{rem/h}$) | 3 Ft. Net Dose Rate ($\mu\text{rem/h}$) | AREA AVERAGE ($\mu\text{rem/h}$) | 1 Ft. Dose Rate ($\mu\text{rem/h}$) |
|--------------------------------------------------|------------------------------------------------------|-------------------------------------------------|------------------------------------------|---------------------------------------------|
| BOREHOLE I.D. # | ^{KCC} ⁵⁻¹⁴⁻⁹⁵ 5 | | | |
| #101 -C1 | 25 | 11 | | 30 |
| #103 -C2 | 10 | -4 | | 15 |
| #103 -D1 | 20 | 6 | | 20 |
| #104 -D2 | 10 | -4 | | 15 |
| #104 -E1 | 25 | 11 | | 30 |
| #105 -E2 | 20 | 6 | 4 | 15 |
| #105 -F1 | 20 | 6 | | 25 |
| #106 -F2 | 15 | 1 | | 10 |
| #107 -G1a | 15 | 1 | | 15 |
| #107 -G2 | 10 | -4 | | 10 |
| #108 -H1 | 10 | -4 | | 10 |
| #108 -H2 | 10 | -4 | -0.67 | 10 |
| #109 -I1 | 15 | 1 | | 15 |
| #109 -I2 | 10 | -4 | | 10 |
| #110 -J1 | 15 | 1 | | 10 |
| #110 -J2 | 10 | -4 | -2 | 10 |
| N A | | | | |

Reviewed By: A. J. Clemons

Date: 5-22-95

BOREHOLE LOG

COPY

LOGGING CREW: B. Hiel, K. Cosgrove
K. Counsell
N/A

SHEET 1 OF 30 PAGE 1

DATE: 1-6-95

PROPERTY ID: RF-480

INSTRUMENT ID NO. ESP-1st 2591 W/SPA-3
#43

AREA: Supplemental Standard area
South of RR @ ORF.

NOTES: 1. ALL HOLES ARE 4" DIA. UNLESS OTHERWISE NOTED.
2. RECORD UNUSUAL CONDITIONS, SUCH AS THE PRESENCE OF WATER IN BOREHOLES AND DEPTH, CASING TYPE AND THICKNESS IF USED, CONCRETE CORES AND THICKNESS, OBSTRUCTIONS, UTILITIES, ETC., IN THE REMARKS SECTION.

| BH#1 | | BH#2 | | BH#3 | | BH#4 | |
|-----------------------------|-------------|-----------------------------|-------------|-----------------------------|-------------|-----------------------------|-------------|
| HOLE ID: <u>-A1a</u> | | HOLE ID: <u>-A1</u> | | HOLE ID: <u>-A</u> | | HOLE ID: <u>-Aa</u> | |
| TIME DRILLED: <u>N/A</u> | | TIME DRILLED: <u>N/A</u> | | TIME DRILLED: <u>N/A</u> | | TIME DRILLED: <u>N/A</u> | |
| TIME LOGGED: <u>N/A</u> | | TIME LOGGED: <u>N/A</u> | | TIME LOGGED: <u>N/A</u> | | TIME LOGGED: <u>N/A</u> | |
| SOIL TYPE: <u>RR Balast</u> | | SOIL TYPE: <u>RR Balast</u> | | SOIL TYPE: <u>RR Balast</u> | | SOIL TYPE: <u>RR Balast</u> | |
| DEPTH | COUNTS/1MIN | DEPTH | COUNTS/1MIN | DEPTH | COUNTS/1MIN | DEPTH | COUNTS/1MIN |
| SURFACE | 6910 | SURFACE | 2930 | SURFACE | 11800 | SURFACE | 6400 |
| 0" | 6710 | 0" | 2750 | 0" | 15700 | 0" | 7440 |
| 6" | 9100 | 6" | 2630 | 6" | 23700 | 6" | 12100 |
| 12" | 5640 | 12" | 2690 | 12" | 21600 | 12" | 19050 |
| 18" | 3600 | 18" | 2480 | 18" | 6850 | 18" | 18300 |
| 24" | 3030 | 24" | 2270 | 24" | 4530 | 24" | 13400 |
| 30" | 2990 | 30" | 2270 | 30" | 3590 | 30" | 9680 |
| 36" | 2680 | 36" | 1970 | 36" | 3560 | 36" | 6000 |
| 42" | | 42" | | 42" | | 42" | 5970 |
| 48" | | 48" | | 48" | | 48" | A.R. |
| 54" | | 54" | | 54" | | 54" | |
| 60" | | 60" | N/A | 60" | | 60" | |
| 66" | | 66" | | 66" | | 66" | N/A |
| 72" | | 72" | | 72" | | 72" | |
| 78" | | 78" | | 78" | | 78" | |
| 84" | | 84" | | 84" | | 84" | |
| 90" | | 90" | | 90" | | 90" | |
| 96" | | 96" | | 96" | | 96" | |

REMARKS: AR = AUGER REFUSAL

-A1a) N 25816 E 61362 BH#1

-A1) N 25826 E 61362 BH#2

-A) N 25816 E 61297 BH#3

-Aa) N 25804 E 61297 BH#4

BOREHOLE LOG

COPY

LOGGING CREW: Bill K. Crograve
K. Connville
N/A

SHEET 1a OF 30 PAGE 2

DATE: 1-6-95

PROPERTY ID: RF-480

INSTRUMENT ID NO. ESP-1 # 2591 W/SPA-3
#43

AREA: Supplemental Standard area
South of RR @ ORF

- NOTES: 1. ALL HOLES ARE 4" DIA. UNLESS OTHERWISE NOTED.
 2. RECORD UNUSUAL CONDITIONS, SUCH AS THE PRESENCE OF WATER IN BOREHOLES AND DEPTH, CASING TYPE AND THICKNESS IF USED, CONCRETE CORES AND THICKNESS, OBSTRUCTIONS, UTILITIES, ETC., IN THE REMARKS SECTION.

BH #5

| DEPTH | COUNTS/.1MIN | DEPTH | COUNTS/.1MIN | DEPTH | COUNTS/.1MIN | DEPTH | COUNTS/.1MIN |
|---------|--------------|---------|--------------|---------|--------------|---------|--------------|
| SURFACE | 5950 | SURFACE | | SURFACE | | SURFACE | |
| 0" | 9440 | 0" | | 0" | | 0" | |
| 6" | 14500 | 6" | | 6" | | 6" | |
| 12" | 9320 | 12" | | 12" | | 12" | |
| 18" | 5760 | 18" | | 18" | | 18" | |
| 24" | 4490 | 24" | | 24" | | 24" | |
| 30" | 4040 | 30" | | 30" | | 30" | |
| 36" | AR | 36" | | 36" | | 36" | |
| 42" | | 42" | | 42" | | 42" | |
| 48" | | 48" | | 48" | | 48" | |
| 54" | | 54" | | 54" | | 54" | |
| 60" | | 60" | | 60" | | 60" | |
| 66" | | 66" | | 66" | | 66" | |
| 72" | | 72" | | 72" | | 72" | |
| 78" | | 78" | | 78" | | 78" | |
| 84" | | 84" | | 84" | | 84" | |
| 90" | | 90" | | 90" | | 90" | |
| 96" | | 96" | | 96" | | 96" | |

REMARKS: AR = Auger refusal

A) N 25799 E 61224 BH#5

BOREHOLE LOG

LOGGING CREW: K. Cosgrove, K. Couvill SHEET 2 OF 30 PAGE 3
B. Hill DATE: 1-6-95
N/A PROPERTY ID: RF-480
 INSTRUMENT ID NO. ESP-1 #2591 W/SPA-3 AREA: Supplemental Standard area
#43 South of R.R. @ CRF.

NOTES: 1. ALL HOLES ARE 4" DIA. UNLESS OTHERWISE NOTED.
 2. RECORD UNUSUAL CONDITIONS, SUCH AS THE PRESENCE OF WATER IN BOREHOLES AND DEPTH, CASING TYPE AND THICKNESS IF USED, CONCRETE CORES AND THICKNESS, OBSTRUCTIONS, UTILITIES, ETC. IN THE REMARKS SECTION.

| BH #6 | | BH #7 | | BH #8 | | BH #9 | |
|----------------------|---------------|----------------------|---------------|----------------------|---------------|----------------------|---------------|
| HOLE ID: | TIME DRILLED: | HOLE ID: | TIME DRILLED: | HOLE ID: | TIME DRILLED: | HOLE ID: | TIME DRILLED: |
| B | N/A | C | N/A | D | N/A | E | N/A |
| TIME LOGGED: | | TIME LOGGED: | | TIME LOGGED: | | TIME LOGGED: | |
| SOIL TYPE: RR Balast | | SOIL TYPE: RR Balast | | SOIL TYPE: RR Balast | | SOIL TYPE: RR Balast | |
| DEPTH | COUNTS/1MIN | DEPTH | COUNTS/1MIN | DEPTH | COUNTS/1MIN | DEPTH | COUNTS/1MIN |
| SURFACE | 19500 | SURFACE | 4500 | SURFACE | 53300 | SURFACE | 54500 |
| 0" | 16900 | 0" | 49800 | 0" | 47600 | 0" | 56200 |
| 6" | 25900 | 6" | 78300 | 6" | 84100 | 6" | 97000 |
| 12" | 17400 | 12" | 39200 | 12" | 45900 | 12" | 57200 |
| 18" | 11700 | 18" | 11800 | 18" | 15300 | 18" | 21200 |
| 24" | A.R. | 24" | 6000 | 24" | 9750 | 24" | 10600 |
| 30" | | 30" | 5210 | 30" | 7480 | 30" | 6640 |
| 36" | | 36" | 5620 | 36" | 6680 | 36" | 6250 |
| 42" | | 42" | A.R. | 42" | 7180 | 42" | 5660 |
| 48" | | 48" | | 48" | 6530 | 48" | A.R. |
| 54" | | 54" | | 54" | | 54" | |
| 60" | | 60" | N | 60" | | 60" | |
| 66" | | 66" | | 66" | | 66" | |
| 72" | | 72" | | 72" | | 72" | |
| 78" | | 78" | | 78" | | 78" | |
| 84" | | 84" | | 84" | | 84" | |
| 90" | | 90" | | 90" | | 90" | |
| 96" | | 96" | | 96" | | 96" | |

REMARKS: AR = AUGER REFUSAL

- B) N 25776 E 61136 BH #6
- C) N 25764 E 61077 BH #7
- D) N 25746 E 61003 BH #8
- E) N 25733 E 60929 BH #9

BOREHOLE LOG

COPY

LOGGING CREW: K. Churchill, K. Cosgrave
B. Hill

SHEET 3 OF 30 PAGE 4
DATE: 1-6-95

INSTRUMENT ID NO. ESP-1 #2591 W/SOA-3
#43

PROPERTY ID: RF-480
AREA: Supplemental Standard Area
South of RR @ ORF.

NOTES: 1. ALL HOLES ARE 4" DIA. UNLESS OTHERWISE NOTED.
2. RECORD UNUSUAL CONDITIONS, SUCH AS THE PRESENCE OF WATER IN BOREHOLES AND DEPTH, CASING TYPE AND THICKNESS IF USED, CONCRETE CORES AND THICKNESS, OBSTRUCTIONS, UTILITIES, ETC., IN THE REMARKS SECTION.

| BH #10 | | BH #11 | | BH #12 | | BH #13 | |
|--------------|------------------|--------------|------------------|--------------|------------------|--------------|------------------|
| HOLE ID: | TIME DRILLED: | HOLE ID: | TIME DRILLED: | HOLE ID: | TIME DRILLED: | HOLE ID: | TIME DRILLED: |
| <u>F</u> | <u>N/A</u> | <u>G</u> | <u>N/A</u> | <u>H</u> | <u>N/A</u> | <u>I</u> | <u>N/A</u> |
| TIME LOGGED: | <u>N/A</u> | TIME LOGGED: | <u>N/A</u> | TIME LOGGED: | <u>N/A</u> | TIME LOGGED: | <u>N/A</u> |
| SOIL TYPE: | <u>RR Balast</u> | SOIL TYPE: | <u>RR Balast</u> | SOIL TYPE: | <u>RR Balast</u> | SOIL TYPE: | <u>RR Balast</u> |
| DEPTH | COUNTS/1MIN | DEPTH | COUNTS/1MIN | DEPTH | COUNTS/1MIN | DEPTH | COUNTS/1MIN |
| SURFACE | <u>35800</u> | SURFACE | <u>26000</u> | SURFACE | <u>33400</u> | SURFACE | <u>19400</u> |
| 0" | <u>46800</u> | 0" | <u>37100</u> | 0" | <u>41500</u> | 0" | <u>18200</u> |
| 6" | <u>96500</u> | 6" | <u>45800</u> | 6" | <u>58600</u> | 6" | <u>23300</u> |
| 12" | <u>73300</u> | 12" | <u>16200</u> | 12" | <u>26100</u> | 12" | <u>16200</u> |
| 18" | <u>27300</u> | 18" | <u>5580</u> | 18" | <u>9050</u> | 18" | <u>10700</u> |
| 24" | <u>14900</u> | 24" | <u>4070</u> | 24" | <u>5370</u> | 24" | <u>5710</u> |
| 30" | <u>12300</u> | 30" | <u>4250</u> | 30" | <u>4200</u> | 30" | <u>4010</u> |
| 36" | <u>8580</u> | 36" | <u>A.R.</u> | 36" | <u>3990</u> | 36" | <u>3360</u> |
| 42" | <u>8030</u> | 42" | | 42" | | 42" | <u>3190</u> |
| 48" | <u>8300</u> | 48" | | 48" | | 48" | <u>2960</u> |
| 54" | | 54" | | 54" | | 54" | |
| 60" | | 60" | | 60" | | 60" | |
| 66" | | 66" | | 66" | <u>N</u> | 66" | |
| 72" | | 72" | | 72" | <u>A</u> | 72" | |
| 78" | | 78" | | 78" | | 78" | |
| 84" | | 84" | | 84" | | 84" | |
| 90" | | 90" | | 90" | | 90" | |
| 96" | | 96" | | 96" | | 96" | |

REMARKS: AR = AUGER REFUSAL

F) N 25705 E 60814 BH #10

G) N 25690 E 60746 BH #11

H) N 25676 E 60675 BH #12

I) N 25656 E 60599 BH #13

ML

BOREHOLE LOG

COPY

LOGGING CREW: K. Chevill, K. Coogrove
B. Hill

SHEET 5 OF 31 PAGE 6
DATE: 1-6-95

INSTRUMENT ID NO. ESP-1 #2591 W/SPT-3
#43

PROPERTY ID: RF-480
AREA: Supplemental standard area
South of RR @ ORF.

NOTES: 1. ALL HOLES ARE 4" DIA. UNLESS OTHERWISE NOTED.
2. RECORD UNUSUAL CONDITIONS, SUCH AS THE PRESENCE OF WATER IN BOREHOLES AND DEPTH, CASING TYPE AND THICKNESS IF USED, CONCRETE CORES AND THICKNESS, OBSTRUCTIONS, UTILITIES, ETC., IN THE REMARKS SECTION.

| BH #18 | | BH #19 | | BH #20 | | BH #21 | |
|-----------|---------------|-----------|---------------|-----------|---------------|-----------|---------------|
| HOLE ID: | TIME DRILLED: | HOLE ID: | TIME DRILLED: | HOLE ID: | TIME DRILLED: | HOLE ID: | TIME DRILLED: |
| N | N/A | O | N/A | P | N/A | Q | N/A |
| RR Balast | | RR Balast | | RR Balast | | RR Balast | |
| DEPTH | COUNTS/1MIN | DEPTH | COUNTS/1MIN | DEPTH | COUNTS/1MIN | DEPTH | COUNTS/1MIN |
| SURFACE | 11700 | SURFACE | 16500 | SURFACE | 10300 | SURFACE | 6350 |
| 0" | 10000 | 0" | 13300 | 0" | 12500 | 0" | 7760 |
| 6" | 10100 | 6" | 12900 | 6" | 8940 | 6" | 10900 |
| 12" | 6990 | 12" | 6330 | 12" | 4180 | 12" | 6330 |
| 18" | 4060 | 18" | 2420 | 18" | 3720 | 18" | 3720 |
| 24" | 3240 | 24" | 2600 | 24" | 3550 | 24" | 3220 |
| 30" | 2680 | 30" | A.R. | 30" | 3380 | 30" | 3150 |
| 36" | 3040 | 36" | | 36" | 3340 | 36" | 3100 |
| 42" | | 42" | | 42" | | 42" | |
| 48" | | 48" | | 48" | | 48" | |
| 54" | | 54" | | 54" | | 54" | |
| 60" | | 60" | N | 60" | | 60" | |
| 66" | | 66" | | 66" | | 66" | |
| 72" | | 72" | A | 72" | | 72" | |
| 78" | | 78" | | 78" | | 78" | |
| 84" | | 84" | | 84" | | 84" | |
| 90" | | 90" | | 90" | | 90" | |
| 96" | | 96" | | 96" | | 96" | |

REMARKS: AR = AUGER REFUSAL

N) N25570 E 60224 BH #18

O) N25549 E 60153 BH #19

P) N25535 E 60075 BH #20

Q) N25517 E 59991 BH #21

BOREHOLE LOG

COPY

LOGGING CREW: K. CAURVILLE
G. BOLDEN
K. COSGROVE

SHEET 7 OF 30 PAGE 8
DATE: 1-11-95

INSTRUMENT ID NO. ESP-1 #1692 SPA-3 #35

PROPERTY ID: RF-480
AREA: SUPPLEMENTAL STANDARD AREA SOUTH OF RR @ ORF

NOTES: 1. ALL HOLES ARE 4" DIA. UNLESS OTHERWISE NOTED.
2. RECORD UNUSUAL CONDITIONS, SUCH AS THE PRESENCE OF WATER IN BOREHOLES AND DEPTH, CASING TYPE AND THICKNESS IF USED, CONCRETE CORES AND THICKNESS, OBSTRUCTIONS, UTILITIES, ETC., IN THE REMARKS SECTION.

| BH #26 | | BH #27 | | BH #28 | | BH #29 | |
|----------------------|---------------|----------------------|---------------|----------------------|---------------|----------------------|---------------|
| HOLE ID: | TIME DRILLED: | HOLE ID: | TIME DRILLED: | HOLE ID: | TIME DRILLED: | HOLE ID: | TIME DRILLED: |
| V | N/A | W | N/A | X | N/A | Y | N/A |
| TIME LOGGED: | | TIME LOGGED: | | TIME LOGGED: | | TIME LOGGED: | |
| SOIL TYPE: RR BALAST | | SOIL TYPE: RR BALAST | | SOIL TYPE: RR BALAST | | SOIL TYPE: RR BALAST | |
| DEPTH | COUNTS/1MIN | DEPTH | COUNTS/1MIN | DEPTH | COUNTS/1MIN | DEPTH | COUNTS/1MIN |
| SURFACE | 4240/1730 | SURFACE | 1980 | SURFACE | 1200 | SURFACE | 1530 |
| 0" | 2040 | 0" | 2190 | 0" | 1250 | 0" | 1560 |
| 6" | 2900 | 6" | 3870 | 6" | 1360 | 6" | 2090 |
| 12" | 3560 | 12" | 5060 | 12" | 1650 | 12" | 2420 |
| 18" | 3200 | 18" | 3380 | 18" | 1780 | 18" | 2760 |
| 24" | 2840 | 24" | 2920 | 24" | AR | 24" | AR |
| 30" | 2750 | 30" | 2870 | 30" | | 30" | |
| 36" | AR | 36" | AR | 36" | | 36" | |
| 42" | | 42" | | 42" | | 42" | |
| 48" | | 48" | | 48" | | 48" | |
| 54" | | 54" | | 54" | | 54" | |
| 60" | | 60" | | 60" | | 60" | |
| 66" | | 66" | | 66" | | 66" | |
| 72" | | 72" | | 72" | | 72" | |
| 78" | | 78" | | 78" | | 78" | |
| 84" | | 84" | | 84" | | 84" | |
| 90" | | 90" | | 90" | | 90" | |
| 96" | | 96" | | 96" | | 96" | |

REMARKS: AR = AUGER REFUSAL

V) N25434 E59615 BH #26

W) N25418 E59541 BH #27

X) N25396 E59460 BH #28

Y) N25382 E59387 BH #29

OK

BOREHOLE LOG

COPY

LOGGING CREW: K. COURVILLE
P. HILL
K. CASARONE

SHEET 8 OF 30 PAGE 9

DATE: 1-11-95

PROPERTY ID: RF-480

INSTRUMENT ID NO. ESP-1 #11092 SPA-3 #35

AREA: SUPPLEMENTAL STANDARD AREA SOUTH OF RR @ ORF

NOTES: 1. ALL HOLES ARE 4" DIA. UNLESS OTHERWISE NOTED.
2. RECORD UNUSUAL CONDITIONS, SUCH AS THE PRESENCE OF WATER IN BOREHOLES AND DEPTH, CASING TYPE AND THICKNESS IF USED, CONCRETE CORES AND THICKNESS, OBSTRUCTIONS, UTILITIES, ETC., IN THE REMARKS SECTION.

| BH #30 | | BH #31 | | BH #32 | | BH #33 | |
|--------------|------------------|--------------|--------------------|--------------|------------------|--------------|------------------|
| HOLE ID: | TIME DRILLED: | HOLE ID: | TIME DRILLED: | HOLE ID: | TIME DRILLED: | HOLE ID: | TIME DRILLED: |
| <u>Z</u> | <u>N/A</u> | <u>AA</u> | <u>N/A</u> | <u>BB</u> | <u>N/A</u> | <u>CC</u> | <u>N/A</u> |
| TIME LOGGED: | <u>N/A</u> | TIME LOGGED: | <u>N/A</u> | TIME LOGGED: | <u>N/A</u> | TIME LOGGED: | <u>N/A</u> |
| SOIL TYPE: | <u>RR BALAST</u> | SOIL TYPE: | <u>K.R. BALAST</u> | SOIL TYPE: | <u>RR BALAST</u> | SOIL TYPE: | <u>RR BALAST</u> |
| DEPTH | COUNTS/1MIN | DEPTH | COUNTS/1MIN | DEPTH | COUNTS/1MIN | DEPTH | COUNTS/1MIN |
| SURFACE | <u>1240</u> | SURFACE | <u>2310</u> | SURFACE | <u>3050</u> | SURFACE | <u>2940</u> |
| 0" | <u>1450</u> | 0" | <u>2290</u> | 0" | <u>3220</u> | 0" | <u>2780</u> |
| 6" | <u>1570</u> | 6" | <u>2900</u> | 6" | <u>3850</u> | 6" | <u>3070</u> |
| 12" | <u>1750</u> | 12" | <u>3070</u> | 12" | <u>3680</u> | 12" | <u>3100</u> |
| 18" | <u>11620</u> | 18" | <u>3030</u> | 18" | <u>3200</u> | 18" | <u>2710</u> |
| 24" | <u>1590</u> | 24" | <u>2540</u> | 24" | <u>2450</u> | 24" | <u>2290</u> |
| 30" | <u>1550</u> | 30" | <u>2540</u> | 30" | <u>2250</u> | 30" | <u>2310</u> |
| 36" | <u>1770</u> | 36" | <u>AR</u> | 36" | <u>AR</u> | 36" | <u>AR</u> |
| 42" | | 42" | | 42" | | 42" | |
| 48" | | 48" | | 48" | | 48" | |
| 54" | | 54" | | 54" | | 54" | |
| 60" | | 60" | | 60" | | 60" | |
| 66" | | 66" | <u>N</u> | 66" | | 66" | |
| 72" | | 72" | <u>A</u> | 72" | | 72" | |
| 78" | | 78" | | 78" | | 78" | |
| 84" | | 84" | | 84" | | 84" | |
| 90" | | 90" | | 90" | | 90" | |
| 96" | | 96" | | 96" | | 96" | |

REMARKS: AR = AUGER REFUSAL

- Z) N 25371 E 59319 BH#30
- AA) N 25358 E 59236 BH#31
- BB) N 25348 E 59150 BH#32
- CC) N 25350 E 59062 BH#33

BOREHOLE LOG

COPY

BURVILLE
 WADEN
 W. GROVE
 #1 #1092 SPA-3 #35

SHEET 9 OF 30 PAGE 10
 DATE: 1-11-95
 PROPERTY ID: RF-480
 AREA: SUPPLEMENTAL STANDARD AREA
SOUTH OF RR @ ORF

OF 31 PAGE 11
1-95
RF-480
ENTAIL STANDARD AREA
F RR @ ORF

ARE 4" DIA. UNLESS OTHERWISE NOTED.
 USUAL CONDITIONS, SUCH AS THE PRESENCE OF WATER IN BOREHOLES AND
 LOG TYPE AND THICKNESS IF USED, CONCRETE CORES AND THICKNESS,
 PIPES, UTILITIES, ETC., IN THE REMARKS SECTION.

ENTER IN BOREHOLES AND
 S AND THICKNESS.

| BH # 35 | | BH # 36 | | BH # 37 | |
|-------------------------|-----------------------------|-------------------------|-----------------------------|-------------------------|-----------------------------|
| HOLE ID: <u>EE</u> | TIME DRILLED: <u>N/A</u> | HOLE ID: <u>FF</u> | TIME DRILLED: <u>N/A</u> | HOLE ID: <u>GG</u> | TIME DRILLED: <u>N/A</u> |
| TIME LOGGED: <u>N/A</u> | SOIL TYPE: <u>RR BALAST</u> | TIME LOGGED: <u>N/A</u> | SOIL TYPE: <u>RR BALAST</u> | TIME LOGGED: <u>N/A</u> | SOIL TYPE: <u>RR BALAST</u> |
| DEPTH | COUNTS/1MIN | DEPTH | COUNTS/1MIN | DEPTH | COUNTS/1MIN |
| SURFACE | 2480 | SURFACE | 1660 | SURFACE | 1670 |
| 0" | 2340 | 0" | 1850 | 0" | 1960 |
| 6" | 2820 | 6" | 2260 | 6" | 2710 |
| 12" | 2960 | 12" | 3060 | 12" | 4320 |
| 18" | 2800 | 18" | 3000 | 18" | 3300 |
| 24" | 2670 | 24" | 2790 | 24" | 2960 |
| 30" | 2540 | 30" | 2720 | 30" | 2500 |
| 36" | 2420 | 36" | 2630 | 36" | 2390 |
| 42" | | 42" | | 42" | |
| 48" | | 48" | | 48" | |
| 54" | | 54" | | 54" | |
| 60" | | 60" | | 60" | |
| 66" | <u>N</u> | 66" | | 66" | |
| 72" | <u>A</u> | 72" | | 72" | |
| 78" | | 78" | | 78" | |
| 84" | | 84" | | 84" | |
| 90" | | 90" | | 90" | |
| 96" | | 96" | | 96" | |

| BH # 41 | |
|-------------------------|-----------------------------|
| HOLE ID: <u>KK</u> | TIME DRILLED: <u>N/A</u> |
| TIME LOGGED: <u>N/A</u> | SOIL TYPE: <u>RR BALAST</u> |
| DEPTH | COUNTS/1MIN |
| SURFACE | 2430 |
| 0" | 2620 |
| 6" | 3370 |
| 12" | 4140 |
| 18" | 4550 |
| 24" | 4570 |
| 30" | 3730 |
| 36" | 3300 |
| 42" | 3380 |
| 48" | 3500 |
| 54" | 3500 |
| 60" | 3250 |
| 66" | |
| 72" | |
| 78" | |
| 84" | |
| 90" | |
| 96" | |

REFUSAL
 E 58993 BH #34
 E 58948 BH #35
 E 58875 BH #36
 E 58803 BH #37

cc

cc

BOREHOLE LOG

LOGGING CREW: K. COURVILLE
K. CASAROVE

SHEET 11 OF 31 PAGE 12
REV. 5-1-93
 DATE: 1-12-95

INSTRUMENT ID NO. ESP-1 #1692 SPA-3 #35

PROPERTY ID: RF-480
 AREA: SUPPLEMENTAL STANDARD AREA SOUTH OF RR @ ORF

- NOTES: 1. ALL HOLES ARE 4" DIA. UNLESS OTHERWISE NOTED.
 2. RECORD UNUSUAL CONDITIONS, SUCH AS THE PRESENCE OF WATER IN BOREHOLES AND DEPTH, CASING TYPE AND THICKNESS IF USED, CONCRETE CORES AND THICKNESS, OBSTRUCTIONS, UTILITIES, ETC., IN THE REMARKS SECTION.

| <small>BH # 42</small> | | <small>BH # 43</small> | | | | | |
|-----------------------------|--------------|-----------------------------|--------------|--------------------------|--------------|--------------------------|--------------|
| HOLE ID: | COUNTS/.1MIN | HOLE ID: | COUNTS/.1MIN | HOLE ID: | COUNTS/.1MIN | HOLE ID: | COUNTS/.1MIN |
| 2L | | M7M | | NA | | NA | |
| TIME DRILLED: <u>N/A</u> | | TIME DRILLED: <u>N/A</u> | | TIME DRILLED: <u>N/A</u> | | TIME DRILLED: <u>N/A</u> | |
| TIME LOGGED: <u>N/A</u> | | TIME LOGGED: <u>N/A</u> | | TIME LOGGED: <u>N/A</u> | | TIME LOGGED: <u>N/A</u> | |
| SOIL TYPE: <u>RR BALAST</u> | | SOIL TYPE: <u>RR BALAST</u> | | SOIL TYPE: <u>NA</u> | | SOIL TYPE: <u>NA</u> | |
| DEPTH | COUNTS/.1MIN | DEPTH | COUNTS/.1MIN | DEPTH | COUNTS/.1MIN | DEPTH | COUNTS/.1MIN |
| SURFACE | 2430 | SURFACE | 1710 | SURFACE | | SURFACE | |
| 0" | 2620 | 0" | 1890 | 0" | | 0" | |
| 6" | 3370 | 6" | 1970 | 6" | | 6" | |
| 12" | 4140 | 12" | 2400 | 12" | | 12" | |
| 18" | 4550 | 18" | 2540 | 18" | | 18" | |
| 24" | 4570 | 24" | 2640 | 24" | | 24" | |
| 30" | 3730 | 30" | 2630 | 30" | | 30" | |
| 36" | 3300 | 36" | 2530 | 36" | | 36" | |
| 42" | 3380 | 42" | | 42" | | 42" | |
| 48" | 3500 | 48" | | 48" | | 48" | |
| 54" | 3500 | 54" | | 54" | | 54" | |
| 60" | 3250 | 60" | | 60" | | 60" | |
| 66" | | 66" | | 66" | | 66" | |
| 72" | | 72" | | 72" | | 72" | |
| 78" | | 78" | | 78" | | 78" | |
| 84" | | 84" | | 84" | | 84" | |
| 90" | | 90" | | 90" | | 90" | |
| 96" | | 96" | | 96" | | 96" | |

REMARKS: BOREHOLE # M7M IS THE LAST HOLE DRILLED TO THE "WEST" ON THE SOUTH SIDE OF THE RR.

2L) N 25475 E 58440 BH # 42

M7M) N 25501 E 58371 BH # 43

alt

BOREHOLE LOG

LOGGING CREW: K. COURVILLE
K. COSAROVE

SHEET 13 OF 30 PAGE 14
1000 8-27-13
 DATE: 1-12-95

PROPERTY ID: RF 480

INSTRUMENT ID NO. ESP-1 # 1692 SPA-3 # 35

AREA: SUPPLEMENTAL STANDARD AREA
NORTH OF RR @ ORF

NOTES: 1. ALL HOLES ARE 4" DIA. UNLESS OTHERWISE NOTED.
 2. RECORD UNUSUAL CONDITIONS, SUCH AS THE PRESENCE OF WATER IN BOREHOLES AND DEPTH, CASING TYPE AND THICKNESS IF USED, CONCRETE CORES AND THICKNESS, OBSTRUCTIONS, UTILITIES, ETC., IN THE REMARKS SECTION.

| BH #47 | | BH #48 | | BH #49 | | BH #50 | |
|-----------------------------|---------------|-----------------------------|---------------|-----------------------------|---------------|-----------------------------|-----------------------|
| HOLE ID: | TIME DRILLED: | HOLE ID: | TIME DRILLED: | HOLE ID: | TIME DRILLED: | HOLE ID: | TIME DRILLED: |
| <u>LL-2</u> | <u>N/A</u> | <u>KK-2</u> | <u>N/A</u> | <u>JJ-2</u> | <u>N/A</u> | <u>SS-3</u> | <u>N/A</u> |
| TIME LOGGED: | | TIME LOGGED: | | TIME LOGGED: | | TIME LOGGED: | |
| SOIL TYPE: <u>RR BALAST</u> | | SOIL TYPE: <u>RR BALAST</u> | | SOIL TYPE: <u>RR BALAST</u> | | SOIL TYPE: <u>RR BALAST</u> | |
| DEPTH | COUNTS/1MIN | DEPTH | COUNTS/1MIN | DEPTH | COUNTS/1MIN | DEPTH | COUNTS/1MIN |
| SURFACE | <u>1750</u> | SURFACE | <u>1520</u> | SURFACE | <u>1860</u> | SURFACE | <u>1930</u> |
| 0" | <u>1910</u> | 0" | <u>1740</u> | 0" | <u>2060</u> | 0" | <u>2000</u> |
| 6" | <u>2170</u> | 6" | <u>1980</u> | 6" | <u>2460</u> | 6" | <u>2110</u> |
| 12" | <u>2250</u> | 12" | <u>2880</u> | 12" | <u>3090</u> | 12" | <u>3100</u> |
| 18" | <u>2860</u> | 18" | <u>3060</u> | 18" | <u>2910</u> | 18" | <u>3780</u> |
| 24" | <u>2640</u> | 24" | <u>2600</u> | 24" | <u>2590</u> | 24" | <u>6120</u> |
| 30" | <u>2480</u> | 30" | <u>2530</u> | 30" | <u>2240</u> | 30" | <u>6220</u> |
| 36" | <u>2340</u> | 36" | <u>2320</u> | 36" | <u>2290</u> | 36" | <u>GROUND WATER *</u> |
| 42" | | 42" | <u>2110</u> | 42" | <u>2240</u> | 42" | |
| 48" | | 48" | | 48" | | 48" | |
| 54" | | 54" | | 54" | | 54" | |
| 60" | | 60" | | 60" | | 60" | |
| 66" | | 66" | <u>N</u> | 66" | | 66" | |
| 72" | | 72" | <u>A</u> | 72" | | 72" | |
| 78" | | 78" | | 78" | | 78" | |
| 84" | | 84" | | 84" | | 84" | |
| 90" | | 90" | | 90" | | 90" | |
| 96" | | 96" | | 96" | | 96" | |

REMARKS: * WERENT ABLE TO DO A SECOND FLIGHT BECAUSE OF WATER.

- LL-2) N 25504 E 58440 BH #47
- KK-2) N 25478 E 58512 BH #48
- JJ-2) N 25456 E 58583 BH #49
- JJ-3) N 25464 E 58583 BH #50

ac

BOREHOLE LOG

LOGGING CREW: K. COURVILLE
K. COSGROVE

SHEET 14 OF 30 PAGE 15
REC 5-12-95
 DATE: 1-12-95

PROPERTY ID: RF 480

INSTRUMENT ID NO. ESP-1 #1692 SPA-3 #35

AREA: SUPPLEMENTAL STANDARD AREA
NORTH OF RR @ ORF

- NOTES: 1. ALL HOLES ARE 4" DIA. UNLESS OTHERWISE NOTED.
 2. RECORD UNUSUAL CONDITIONS, SUCH AS THE PRESENCE OF WATER IN BOREHOLES AND DEPTH, CASING TYPE AND THICKNESS IF USED, CONCRETE CORES AND THICKNESS, OBSTRUCTIONS, UTILITIES, ETC., IN THE REMARKS SECTION.

BH #51 BH #52 BH #53 BH #54

| BH #51 | | BH #52 | | BH #53 | | BH #54 | |
|-----------------------------|---------------|-----------------------------|---------------|-----------------------------|---------------|-----------------------------|---------------|
| HOLE ID: | TIME DRILLED: | HOLE ID: | TIME DRILLED: | HOLE ID: | TIME DRILLED: | HOLE ID: | TIME DRILLED: |
| <u>II-4</u> | <u>N/A</u> | <u>II-2</u> | <u>N/A</u> | <u>HH-2</u> | <u>N/A</u> | <u>GG-2</u> | <u>N/A</u> |
| TIME LOGGED: | | TIME LOGGED: | | TIME LOGGED: | | TIME LOGGED: | |
| SOIL TYPE: <u>RR BALAST</u> | | SOIL TYPE: <u>RR BALAST</u> | | SOIL TYPE: <u>RR BALAST</u> | | SOIL TYPE: <u>RR BALAST</u> | |
| DEPTH | COUNTS/.1MIN | DEPTH | COUNTS/.1MIN | DEPTH | COUNTS/.1MIN | DEPTH | COUNTS/.1MIN |
| SURFACE | <u>1500</u> | SURFACE | <u>1760</u> | SURFACE | <u>1610</u> | SURFACE | <u>1790</u> |
| 0" | <u>1500</u> | 0" | <u>1740</u> | 0" | <u>1670</u> | 0" | <u>1750</u> |
| 6" | <u>1900</u> | 6" | <u>2020</u> | 6" | <u>1960</u> | 6" | <u>2200</u> |
| 12" | <u>2170</u> | 12" | <u>2290</u> | 12" | <u>2250</u> | 12" | <u>2970</u> |
| 18" | <u>2540</u> | 18" | <u>2260</u> | 18" | <u>2200</u> | 18" | <u>2730</u> |
| 24" | <u>2710</u> | 24" | <u>2480</u> | 24" | <u>2670</u> | 24" | <u>2690</u> |
| 30" | <u>2690</u> | 30" | <u>2450</u> | 30" | <u>2690</u> | 30" | <u>2730</u> |
| 36" | <u>2730</u> | 36" | <u>2110</u> | 36" | <u>2660</u> | 36" | <u>2740</u> |
| 42" | <u>2400</u> | 42" | | 42" | | 42" | |
| 48" | | 48" | | 48" | | 48" | |
| 54" | | 54" | | 54" | | 54" | |
| 60" | | 60" | | 60" | | 60" | |
| 66" | | 66" | <u>N</u> | 66" | | 66" | |
| 72" | | 72" | <u>A</u> | 72" | | 72" | |
| 78" | | 78" | | 78" | | 78" | |
| 84" | | 84" | | 84" | | 84" | |
| 90" | | 90" | | 90" | | 90" | |
| 96" | | 96" | | 96" | | 96" | |

REMARKS: II-4) N 25479 E 58583 BH #51
II-2) N 25433 E 58647 BH #52
HH-2) N 25417 E 58729 BH #53
GG-2) N 25412 E 58803 BH #54

AK

BOREHOLE LOG

LOGGING CREW: K. COURVILLE
K. POSGROVE

SHEET 15 OF 31 PAGE 16
DATE: 1-12-95

INSTRUMENT ID NO. ESP-1 #1718 SPA-3 #42

PROPERTY ID: RF 480
AREA: SUPPLEMENTAL STANDARD AREA
NORTH OF RR @ ORF

NOTES. 1. ALL HOLES ARE 4" DIA. UNLESS OTHERWISE NOTED.
2. RECORD UNUSUAL CONDITIONS, SUCH AS THE PRESENCE OF WATER IN BOREHOLES AND DEPTH, CASING TYPE AND THICKNESS IF USED, CONCRETE CORES AND THICKNESS, OBSTRUCTIONS, UTILITIES, ETC., IN THE REMARKS SECTION.

| BH # 55 | | BH # 56 | | BH # 57 | | BH # 58 | |
|-----------|---------------|-----------|---------------|-----------|---------------|-----------|---------------|
| HOLE ID: | TIME DRILLED: | HOLE ID: | TIME DRILLED: | HOLE ID: | TIME DRILLED: | HOLE ID: | TIME DRILLED: |
| GG-3 | N/A | FF-2 | R/A | FF-3 | N/A | FF-4 | N/A |
| RR BALAST | | RR BALAST | | RR BALAST | | RR BALAST | |
| DEPTH | COUNTS/.1MIN | DEPTH | COUNTS/.1MIN | DEPTH | COUNTS/.1MIN | DEPTH | COUNTS/.1MIN |
| SURFACE | 1540 | SURFACE | 1650 | SURFACE | 1880 | SURFACE | 1640 |
| 0" | 1580 | 0" | 1710 | 0" | 1990 | 0" | 2700 |
| 6" | 2000 | 6" | 2030 | 6" | 2650 | 6" | 3830 |
| 12" | 2270 | 12" | 2430 | 12" | 4510 | 12" | 4600 |
| 18" | 2500 | 18" | 2390 | 18" | 4070 | 18" | 3310 |
| 24" | 2810 | 24" | 2370 | 24" | AR | 24" | 2740 |
| 30" | 2810 | 30" | 2370 | 30" | | 30" | 2600 |
| 36" | 2730 | 36" | AR | 36" | | 36" | 2540 |
| 42" | | 42" | | 42" | | 42" | |
| 48" | | 48" | | 48" | | 48" | |
| 54" | | 54" | | 54" | | 54" | |
| 60" | | 60" | N | 60" | | 60" | |
| 66" | | 66" | | 66" | | 66" | |
| 72" | | 72" | | 72" | | 72" | |
| 78" | | 78" | A | 78" | | 78" | |
| 84" | | 84" | | 84" | | 84" | |
| 90" | | 90" | | 90" | | 90" | |
| 96" | | 96" | | 96" | | 96" | |

REMARKS: AR = ANNEAL REFUSAL

GG-3) N 25417 E 58803 BH # 55

FF-2) N 25391 E 58875 BH # 56

FF-3) N 25401 E 58875 BH # 57

FF-4) N 25415 E 58875 BH # 58

BOREHOLE LOG

SHEET 16 OF 30 PAGE 17

DATE: 1-12-95

PROPERTY ID: RF 480

A-3 # 42
 AREA: SUPPLEMENTAL STANDARD AREA
NORTH OF RR @ ORF

OTHERWISE NOTED.
 NS, SUCH AS THE PRESENCE OF WATER IN BOREHOLES AND
 CKNESS IF USED, CONCRETE CORES AND THICKNESS,
 C., IN THE REMARKS SECTION.

| BH # | HOLE ID: | TIME DRILLED: | TIME LOGGED: | SOIL TYPE: |
|---------|------------|---------------|--------------|------------------|
| BH # 61 | <u>-A3</u> | <u>N/A</u> | <u>N/A</u> | <u>RR BALAST</u> |
| BH # 62 | <u>-B2</u> | <u>N/A</u> | <u>N/A</u> | <u>RR BALAST</u> |

| DEPTH | COUNTS/.1MIN | DEPTH | COUNTS/.1MIN |
|---------|-------------------------------------|---------|-------------------------------------|
| SURFACE | 4330 | SURFACE | 2200 |
| 0" | 7540 | 0" | 2010 |
| 6" | 10400 | 6" | 1800 |
| 12" | 10700 | 12" | 2260 |
| 18" | 9390 | 18" | 2180 |
| 24" | 8040 | 24" | 1970 |
| 30" | AR | 30" | AR |
| 36" | | 36" | |
| 42" | STOPPED AT THE BASE OF THE HILL. | 42" | STOPPED AT THE BASE OF THE HILL. |
| 48" | | 48" | |
| 54" | | 54" | |
| 60" | | 60" | |
| 66" | | 66" | |
| 72" | | 72" | |
| 78" | | 78" | |
| 84" | | 84" | |
| 90" | | 90" | |
| 96" | | 96" | |

AT THE EAST SIDE OF OLD RIFLE
 TRACKS.

#59 -A3) N25865 E 61362 BH#61
 #60 -B2) N25876 E 61436 BH#62

SHEET 17 OF 30 PAGE 18

DATE: 1-13-95

PROPERTY ID: RF 480

AREA: SUPPLEMENTAL STANDARD AREA
NORTH OF RR @ ORF

OTHERWISE NOTED.
 PRESENCE OF WATER IN BOREHOLES AND
 ONCRETE CORES AND THICKNESS,
 SECTION.

| BH # | HOLE ID: | TIME DRILLED: | TIME LOGGED: | SOIL TYPE: |
|---------|------------|---------------|--------------|------------------|
| BH # 65 | <u>-E2</u> | <u>N/A</u> | <u>N/A</u> | <u>RR BALAST</u> |
| BH # 66 | <u>-F2</u> | <u>N/A</u> | <u>N/A</u> | <u>RR BALAST</u> |

| DEPTH | COUNTS/.1MIN | DEPTH | COUNTS/.1MIN |
|---------|--------------|---------|--------------|
| SURFACE | 3210 | SURFACE | 1860 |
| 0" | 3690 | 0" | 2020 |
| 6" | 5750 | 6" | 2030 |
| 12" | 8250 | 12" | 2710 |
| 18" | 9250 | 18" | 3200 |
| 24" | 6820 | 24" | 3790 |
| 30" | 5830 | 30" | 3850 |
| 36" | AR | 36" | AR |
| 42" | | 42" | |
| 48" | | 48" | |
| 54" | | 54" | |
| 60" | | 60" | |
| 66" | | 66" | |
| 72" | | 72" | |
| 78" | | 78" | |
| 84" | | 84" | |
| 90" | | 90" | |
| 96" | | 96" | |

STOPPED AT THE
 BASE OF ROCK FACE

all

BOREHOLE LOG

LOGGING CREW: L. Curviller
G. Bogdan

SHEET 18 OF 30 PAGE 19
KPL 5-88-15
 DATE: 1-13-95
 PROPERTY ID: RF 480

INSTRUMENT ID NO. ESP-1 # 1718 SPH-3 # 42

AREA: SUPPLEMENTAL STANDARD AREA
North of RR @ ORF

NOTES: 1. ALL HOLES ARE 4" DIA. UNLESS OTHERWISE NOTED.
 2. RECORD UNUSUAL CONDITIONS, SUCH AS THE PRESENCE OF WATER IN BOREHOLES AND DEPTH, CASING TYPE AND THICKNESS IF USED, CONCRETE CORES AND THICKNESS, OBSTRUCTIONS, UTILITIES, ETC., IN THE REMARKS SECTION.

| BH #67 | | BH #68 | | BH #69 | | BH #70 | |
|------------------------------|---------------|------------------------------|---------------|------------------------------|---------------|------------------------------|---------------|
| HOLE ID: | TIME DRILLED: | HOLE ID: | TIME DRILLED: | HOLE ID: | TIME DRILLED: | HOLE ID: | TIME DRILLED: |
| <u>-G2</u> | <u>N/A</u> | <u>-H2</u> | <u>N/A</u> | <u>-I2</u> | <u>N/A</u> | <u>-J2</u> | <u>N/A</u> |
| TIME LOGGED: <u>N/A</u> | | TIME LOGGED: <u>N/A</u> | | TIME LOGGED: <u>N/A</u> | | TIME LOGGED: <u>N/A</u> | |
| SOIL TYPE: <u>RR BALLAST</u> | | SOIL TYPE: <u>RR BALLAST</u> | | SOIL TYPE: <u>RR BALLAST</u> | | SOIL TYPE: <u>RR BALLAST</u> | |
| DEPTH | COUNTS/1MIN | DEPTH | COUNTS/1MIN | DEPTH | COUNTS/1MIN | DEPTH | COUNTS/1MIN |
| SURFACE | <u>1930</u> | SURFACE | <u>1680</u> | SURFACE | <u>1730</u> | SURFACE | <u>1540</u> |
| 0" | <u>2010</u> | 0" | <u>1690</u> | 0" | <u>1880</u> | 0" | <u>1710</u> |
| 6" | <u>2170</u> | 6" | <u>2030</u> | 6" | <u>1970</u> | 6" | <u>1770</u> |
| 12" | <u>2250</u> | 12" | <u>2310</u> | 12" | <u>2150</u> | 12" | <u>2020</u> |
| 18" | <u>2580</u> | 18" | <u>2450</u> | 18" | <u>2450</u> | 18" | <u>2120</u> |
| 24" | <u>2930</u> | 24" | <u>2700</u> | 24" | <u>3270</u> | 24" | <u>2570</u> |
| 30" | <u>3000</u> | 30" | <u>2870</u> | 30" | <u>4310</u> | 30" | <u>2800</u> |
| 36" | <u>2980</u> | 36" | <u>2730</u> | 36" | <u>4240</u> | 36" | <u>3110</u> |
| 42" | | 42" | | 42" | <u>4290</u> | 42" | <u>3600</u> |
| 48" | | 48" | | 48" | <u>3870</u> | 48" | <u>3240</u> |
| 54" | | 54" | | 54" | | 54" | |
| 60" | | 60" | | 60" | | 60" | |
| 66" | | 66" | | 66" | | 66" | |
| 72" | | 72" | | 72" | | 72" | |
| 78" | | 78" | | 78" | | 78" | |
| 84" | | 84" | | 84" | <u>A</u> | 84" | |
| 90" | | 90" | | 90" | | 90" | |
| 96" | | 96" | | 96" | | 96" | |

REMARKS: Borehole # -J2 is the last hole drilled to the "EAST" on the north side of the RR.

- G2) N25964 E61801 BH #67
- H2) N25988 E61873 BH #68
- I2) N26020 E61945 BH #69
- J2) N26046 E62018 BH #70

RL

BOREHOLE LOG

LOGGING CREW: K. COSGROVE, D. WALKER,
B. DEWOLFE, E. OUELLETTE

SHEET 19 OF ⁵²~~43~~ 31 PAGE 20

DATE: 5-10-95

PROPERTY ID: VP-479-South 5-10-95

INSTRUMENT ID NO. ESP-1#1187 SPA3TH40

AREA: SPS SOUTH OF RR TRACK

- NOTES: 1. ALL HOLES ARE 4" DIA. UNLESS OTHERWISE NOTED.
2. RECORD UNUSUAL CONDITIONS, SUCH AS THE PRESENCE OF WATER IN BOREHOLES AND DEPTH, CASING TYPE AND THICKNESS IF USED, CONCRETE CORES AND THICKNESS, OBSTRUCTIONS, UTILITIES, ETC., IN THE REMARKS SECTION.

| BH #71 | | BH #72 | | BH #73 | | BH #74 | |
|--------------|---------------|--------------|---------------|--------------|---------------|--------------|---------------|
| HOLE ID: | TIME DRILLED: | HOLE ID: | TIME DRILLED: | HOLE ID: | TIME DRILLED: | HOLE ID: | TIME DRILLED: |
| JJS | N/A | JJ6 | N/A | FF5 | N/A | FF6 | N/A |
| TIME LOGGED: | N/A | TIME LOGGED: | N/A | TIME LOGGED: | N/A | TIME LOGGED: | N/A |
| SOIL TYPE: | A | SOIL TYPE: | A | SOIL TYPE: | A | SOIL TYPE: | A |
| DEPTH | COUNTS/.1MIN | DEPTH | COUNTS/.1MIN | DEPTH | COUNTS/.1MIN | DEPTH | COUNTS/.1MIN |
| SURFACE | 1900 | SURFACE | 2030 | SURFACE | 1550 | SURFACE | 1680 |
| 0" | 1810 | 0" | 2060 | 0" | 1340 | 0" | 1770 |
| 6" | 2180 | 6" | 2180 | 6" | 1400 | 6" | 2440 |
| 12" | 2780 | 12" | 2860 | 12" | 1520 | 12" | 3470 |
| 18" | 2630 | 18" | 2920 | 18" | 1560 | 18" | 2940 |
| 24" | 2820 | 24" | 2900 | 24" | 1570 | 24" | 2970 |
| 30" | 3170 | 30" | 2790 | 30" | 1580 | 30" | 2910 |
| 36" | 3410 | 36" | 3100 | 36" | 1620 | 36" | 3000 |
| 42" | | 42" | | 42" | | 42" | |
| 48" | | 48" | | 48" | | 48" | |
| 54" | | 54" | | 54" | | 54" | |
| 60" | | 60" | | 60" | | 60" | |
| 66" | | 66" | | 66" | | 66" | |
| 72" | | 72" | | 72" | | 72" | |
| 78" | | 78" | | 78" | | 78" | |
| 84" | | 84" | | 84" | | 84" | |
| 90" | | 90" | | 90" | | 90" | |
| 96" | | 96" | | 96" | | 96" | |

REMARKS:

N25464
JJS - E 58573 BH #71

N25464
JJ6 - E 58593 BH #72

N25425
FF5 - E 58875 BH #73

N25415
FF6 - E 58885 BH #74

BOREHOLE LOG

LOGGING CREW: K. COSGRAVE, D. WELKER,
B. DELUXE, E. CURELLETTE

SHEET 20 OF ^{SEE 5-11-95} ~~30~~ 31 PAGE 21

DATE: 5-10-95

PROPERTY ID: VP-479

INSTRUMENT ID NO. ESP-1# 1687 / SPA-3# 40

AREA: SOUTH OF RR TRACK

- NOTES: 1. ALL HOLES ARE 4" DIA. UNLESS OTHERWISE NOTED.
2. RECORD UNUSUAL CONDITIONS, SUCH AS THE PRESENCE OF WATER IN BOREHOLES AND DEPTH, CASING TYPE AND THICKNESS IF USED, CONCRETE CORES AND THICKNESS, OBSTRUCTIONS, UTILITIES, ETC., IN THE REMARKS SECTION.

| BH # 75 | | BH # 76 | | BH # 77 | | BH # 78 | |
|--------------|---------------|--------------|---------------|--------------|---------------|--------------|---------------|
| HOLE ID: | TIME DRILLED: | HOLE ID: | TIME DRILLED: | HOLE ID: | TIME DRILLED: | HOLE ID: | TIME DRILLED: |
| FF7 | N/A | FF8 | N/A | EE3 | N/A | AAa | N/A |
| TIME LOGGED: | N/A | TIME LOGGED: | N/A | TIME LOGGED: | N/A | TIME LOGGED: | N/A |
| SOIL TYPE: | A | SOIL TYPE: | A | SOIL TYPE: | A | SOIL TYPE: | A |
| DEPTH | COUNTS/.1MIN | DEPTH | COUNTS/.1MIN | DEPTH | COUNTS/.1MIN | DEPTH | COUNTS/.1MIN |
| SURFACE | 1650 | SURFACE | 1920 | SURFACE | 1600 | SURFACE | 1810 |
| 0" | 1670 | 0" | 1830 | 0" | 1800 | 0" | 1830 |
| 6" | 1590 | 6" | 2820 | 6" | 2150 | 6" | 2420 |
| 12" | 2020 | 12" | 3580 | 12" | 2750 | 12" | 2960 |
| 18" | 3270 | 18" | 2880 | 18" | 3010 | 18" | 2730 |
| 24" | 3750 | 24" | 2690 | 24" | 3140 | 24" | 2380 |
| 30" | 4010 | 30" | 2470 | 30" | 3970 | 30" | 2260 |
| 36" | 3990 | 36" | 2550 | 36" | 3820 | 36" | 2280 |
| 42" | | 42" | | 42" | | 42" | |
| 48" | | 48" | | 48" | | 48" | |
| 54" | | 54" | | 54" | | 54" | |
| 60" | | 60" | | 60" | | 60" | |
| 66" | | 66" | | 66" | | 66" | |
| 72" | | 72" | | 72" | | 72" | |
| 78" | | 78" | | 78" | | 78" | |
| 84" | | 84" | | 84" | | 84" | |
| 90" | | 90" | | 90" | | 90" | |
| 96" | | 96" | | 96" | | 96" | |

REMARKS: 6-2-10-8
N 25415 N 25415
FF7 - E 58870 BH # 75
N 25401
FF8 - E 58885 BH # 76
N 25385
EE3 - E 58935 BH # 77
N 25358
AAa - E 59245 BH # 78

OK

BOREHOLE LOG

LOGGING CREW: K. COSGROVE, D. WELKER,
B. DEWOLFE, E. OUELLETTE

SHEET ^{KCC 5/21/95} 31 OF ^{KCC 5/21/95} 31 PAGE 22

DATE: 5-10-95

PROPERTY ID: VP-479

INSTRUMENT ID NO. ESP-1#11687 SA-3#40

AREA: SOUTH OF RR TRACK

- NOTES: 1. ALL HOLES ARE 4" DIA. UNLESS OTHERWISE NOTED.
2. RECORD UNUSUAL CONDITIONS, SUCH AS THE PRESENCE OF WATER IN BOREHOLES AND DEPTH, CASING TYPE AND THICKNESS IF USED, CONCRETE CORES AND THICKNESS, OBSTRUCTIONS, UTILITIES, ETC., IN THE REMARKS SECTION.

| BH #79 | | BH #80 | | BH #81 | | BH #82 | |
|------------|---------------|------------|---------------|------------|---------------|------------|---------------|
| HOLE ID: | TIME DRILLED: | HOLE ID: | TIME DRILLED: | HOLE ID: | TIME DRILLED: | HOLE ID: | TIME DRILLED: |
| <u>VV</u> | <u>N/A</u> | <u>VU</u> | <u>N/A</u> | <u>TT</u> | <u>N/A</u> | <u>SS</u> | <u>N/A</u> |
| <u>N/A</u> | <u>N/A</u> | <u>N/A</u> | <u>N/A</u> | <u>N/A</u> | <u>N/A</u> | <u>N/A</u> | <u>N/A</u> |
| <u>N/A</u> | <u>N/A</u> | <u>N/A</u> | <u>N/A</u> | <u>N/A</u> | <u>N/A</u> | <u>N/A</u> | <u>N/A</u> |
| DEPTH | COUNTS/.1MIN | DEPTH | COUNTS/.1MIN | DEPTH | COUNTS/.1MIN | DEPTH | COUNTS/.1MIN |
| SURFACE | 1250 | SURFACE | 2550 | SURFACE | 7290 | SURFACE | 5230 |
| 0" | 1200 | 0" | 1880 | 0" | 5970 | 0" | 5220 |
| 6" | 1290 | 6" | 2190 | 6" | 7430 | 6" | 5880 |
| 12" | 1540 | 12" | 2660 | 12" | 5480 | 12" | 4460 |
| 18" | 1700 | 18" | 3080 | 18" | 4400 | 18" | 3690 |
| 24" | 1750 | 24" | 2850 | 24" | 4290 | 24" | 3360 |
| 30" | 1830 | 30" | 2690 | 30" | 4220 | 30" | 3350 |
| 36" | 1970 | 36" | 2600 | 36" | AD | 36" | 3200 |
| 42" | | 42" | | 42" | | 42" | |
| 48" | | 48" | | 48" | | 48" | |
| 54" | | 54" | | 54" | | 54" | |
| 60" | | 60" | | 60" | | 60" | |
| 66" | | 66" | | 66" | | 66" | |
| 72" | | 72" | | 72" | | 72" | |
| 78" | | 78" | | 78" | | 78" | |
| 84" | | 84" | | 84" | | 84" | |
| 90" | | 90" | | 90" | | 90" | |
| 96" | | 96" | | 96" | | 96" | |

REMARKS:

VV - N 25424
VV - E 5945 BH #79

VU - N 25444
VU - E 59689 BH #80

TT - N 25463
TT - E 59770 BH #81

SS - N 25479
SS - E 59846 BH #82

AD = AUGER REFUSAL

BOPFHOLE LOG

LOGGING CREW: K. COSGROVE, D. WELKER,
B. DEWOLFE, E. DUBLETTE

SHEET 422 OF 31 PAGE 23

DATE: 5-10-95

PROPERTY ID: VP-479

INSTRUMENT ID NO. ESP-1 #1687 / SPA-3 #40

AREA: SPS SOUTH OF RR TRACK

NOTES: 1. ALL HOLES ARE 4" DIA. UNLESS OTHERWISE NOTED.
2. RECORD UNUSUAL CONDITIONS, SUCH AS THE PRESENCE OF WATER IN BOREHOLES AND DEPTH, CASING TYPE AND THICKNESS IF USED, CONCRETE CORES AND THICKNESS, OBSTRUCTIONS, UTILITIES, ETC., IN THE REMARKS SECTION.

| BH #83 | | BH #84 | | BH #85 | | | |
|--------------------------|--------------------------|--------------------------|--------------------------|--------------------------|--------------------------|--------------------------|--------------------------|
| HOLE ID: <u>Rr</u> | HOLE ID: <u>Qq</u> | HOLE ID: <u>Pp</u> | HOLE ID: <u>Oo</u> | HOLE ID: <u>Rr</u> | HOLE ID: <u>Qq</u> | HOLE ID: <u>Pp</u> | HOLE ID: <u>Oo</u> |
| TIME DRILLED: <u>N/A</u> | TIME DRILLED: <u>N/A</u> | TIME DRILLED: <u>N/A</u> | TIME DRILLED: <u>N/A</u> | TIME DRILLED: <u>N/A</u> | TIME DRILLED: <u>N/A</u> | TIME DRILLED: <u>N/A</u> | TIME DRILLED: <u>N/A</u> |
| TIME LOGGED: <u>N/A</u> | TIME LOGGED: <u>N/A</u> | TIME LOGGED: <u>N/A</u> | TIME LOGGED: <u>N/A</u> | TIME LOGGED: <u>N/A</u> | TIME LOGGED: <u>N/A</u> | TIME LOGGED: <u>N/A</u> | TIME LOGGED: <u>N/A</u> |
| SOIL TYPE: <u>A</u> | SOIL TYPE: <u>A</u> | SOIL TYPE: <u>A</u> | SOIL TYPE: <u>A</u> | SOIL TYPE: <u>A</u> | SOIL TYPE: <u>A</u> | SOIL TYPE: <u>A</u> | SOIL TYPE: <u>A</u> |
| DEPTH | COUNTS/.1MIN | DEPTH | COUNTS/.1MIN | DEPTH | COUNTS/.1MIN | DEPTH | COUNTS/.1MIN |
| SURFACE | 3090 | SURFACE | 7490 | SURFACE | 4650 | SURFACE | 5780 |
| 0" | 2810 | 0" | 5160 | 0" | 5630 | 0" | 4700 |
| 6" | 3960 | 6" | 4550 | 6" | 5200 | 6" | 4690 |
| 12" | 4110 | 12" | 5180 | 12" | 4980 | 12" | 5120 |
| 18" | 4160 | 18" | 4830 | 18" | 4460 | 18" | 5400 |
| 24" | 4040 | 24" | 4160 | 24" | 4070 | 24" | 5020 |
| 30" | 3700 | 30" | 3500 | 30" | 3510 | 30" | 4640 |
| 36" | 3750 | 36" | 3370 | 36" | 3310 | 36" | 4320 |
| 42" | | 42" | | 42" | | 42" | |
| 48" | | 48" | | 48" | | 48" | |
| 54" | | 54" | | 54" | | 54" | |
| 60" | | 60" | | 60" | | 60" | |
| 66" | | 66" | | 66" | | 66" | |
| 72" | | 72" | | 72" | | 72" | |
| 78" | | 78" | | 78" | | 78" | |
| 84" | | 84" | | 84" | | 84" | |
| 90" | | 90" | | 90" | | 90" | |
| 96" | | 96" | | 96" | | 96" | |

REMARKS:

Rr - E 59923 BH #83

Qq - E 59991 BH #84

Pp - E 60075

Oo - E 60153 BH #85

AR = AUGER REFUSAL

OK

BOREHOLE LOG

LOGGING CREW: K. COSGROVE, T. WELKER,
B. DEJOLFE, E. OUELLETTE

SHEET 523 OF #30 PAGE 24
DATE: 5-10-95

INSTRUMENT ID NO. ESP-1 #1687 / SPA-3 #40

PROPERTY ID: VP-479
AREA: SPS SOUTH OF RR TRACK

NOTES: 1. ALL HOLES ARE 4" DIA. UNLESS OTHERWISE NOTED.
2. RECORD UNUSUAL CONDITIONS, SUCH AS THE PRESENCE OF WATER IN BOREHOLES AND DEPTH, CASING TYPE AND THICKNESS IF USED, CONCRETE CORES AND THICKNESS, OBSTRUCTIONS, UTILITIES, ETC., IN THE REMARKS SECTION.

| BH #86 | | BH #87 | | BH #88 | | | |
|-------------------------|-------------------------|-------------------------|-------------------------|-------------------------|-------------------------|-------------------------|-------------------------|
| HOLE ID: <u>N</u> | HOLE ID: <u>Mm</u> | HOLE ID: <u>Ll</u> | HOLE ID: <u>Kk</u> | HOLE ID: <u>N</u> | HOLE ID: <u>Mm</u> | HOLE ID: <u>Ll</u> | HOLE ID: <u>Kk</u> |
| TIME DRILLED: <u>NA</u> | TIME DRILLED: <u>NA</u> | TIME DRILLED: <u>NA</u> | TIME DRILLED: <u>NA</u> | TIME DRILLED: <u>NA</u> | TIME DRILLED: <u>NA</u> | TIME DRILLED: <u>NA</u> | TIME DRILLED: <u>NA</u> |
| TIME LOGGED: <u>NA</u> | TIME LOGGED: <u>NA</u> | TIME LOGGED: <u>NA</u> | TIME LOGGED: <u>NA</u> | TIME LOGGED: <u>NA</u> | TIME LOGGED: <u>NA</u> | TIME LOGGED: <u>NA</u> | TIME LOGGED: <u>NA</u> |
| SOIL TYPE: <u>NA</u> | SOIL TYPE: <u>NA</u> | SOIL TYPE: <u>NA</u> | SOIL TYPE: <u>NA</u> | SOIL TYPE: <u>NA</u> | SOIL TYPE: <u>NA</u> | SOIL TYPE: <u>NA</u> | SOIL TYPE: <u>NA</u> |
| DEPTH | COUNTS/1MIN | DEPTH | COUNTS/1MIN | DEPTH | COUNTS/1MIN | DEPTH | COUNTS/1MIN |
| SURFACE | 9400 | SURFACE | 12300 | SURFACE | 5930 | SURFACE | 11900 |
| 0" | 9310 | 0" | 11900 | 0" | 6350 | 0" | 9210 |
| 6" | 9500 | 6" | 11600 | 6" | 9900 | 6" | 11100 |
| 12" | 7770 | 12" | 11400 | 12" | 15000 | 12" | 10400 |
| 18" | 4900 | 18" | 8610 | 18" | 9480 | 18" | 8770 |
| 24" | 3580 | 24" | 7970 | 24" | 7710 | 24" | 7420 |
| 30" | 3550 | 30" | 7750 | 30" | 5920 | 30" | 5720 |
| 36" | AR | 36" | AR | 36" | 5290 | 36" | 4320 |
| 42" | | 42" | | 42" | 4450 | 42" | |
| 48" | | 48" | | 48" | 4290 | 48" | |
| 54" | | 54" | | 54" | | 54" | |
| 60" | N | 60" | | 60" | | 60" | N |
| 66" | | 66" | | 66" | | 66" | NA |
| 72" | | 72" | A | 72" | N | 72" | A |
| 78" | | 78" | | 78" | NA | 78" | |
| 84" | | 84" | | 84" | | 84" | |
| 90" | | 90" | | 90" | | 90" | |
| 96" | | 96" | | 96" | | 96" | |

REMARKS:
N 25581 25585 BH # 86
Mm - E60224 BH # 86
N 25581
Mm - E60290
N 25584
Ll - E60303 BH # 87
N 25615
Kk - E60446 BH # 88
AR = AUGER REFUSAL

24

BOREHOLE LOG

LOGGING CREW: K COSGROVE, D. WELKER,
B. DEWOLFE, E. QUILLITE

SHEET ^{REC 5-22-95} 24 OF 31 H-30 PAGE 25
DATE: 5-10-95/5-11-95
PROPERTY ID: VP-479
AREA: SPS SOUTH OF RR TRACK

INSTRUMENT ID NO. ESP-1[#] 1187 / SPA-3[#] 40

- NOTES: 1. ALL HOLES ARE 4" DIA. UNLESS OTHERWISE NOTED.
2. RECORD UNUSUAL CONDITIONS, SUCH AS THE PRESENCE OF WATER IN BOREHOLES AND DEPTH, CASING TYPE AND THICKNESS IF USED, CONCRETE CORES AND THICKNESS, OBSTRUCTIONS, UTILITIES, ETC., IN THE REMARKS SECTION.

BH # 89 BH # 90 BH # 91 BH # 92

| HOLE ID: <u>Li</u> | | HOLE ID: <u>Hh</u> | | HOLE ID: <u>Gg</u> | | HOLE ID: <u>Ff</u> | |
|--------------------------|--------------|--------------------------|---------------|--------------------------|--------------|--------------------------|--------------|
| TIME DRILLED: <u>N/A</u> | | TIME DRILLED: <u>N/A</u> | | TIME DRILLED: <u>N/A</u> | | TIME DRILLED: <u>N/A</u> | |
| TIME LOGGED: <u>N/A</u> | | TIME LOGGED: <u>N/A</u> | | TIME LOGGED: <u>N/A</u> | | TIME LOGGED: <u>N/A</u> | |
| SOIL TYPE: <u>A</u> | | SOIL TYPE: <u>A</u> | | SOIL TYPE: <u>A</u> | | SOIL TYPE: <u>A</u> | |
| DEPTH | COUNTS/.1MIN | DEPTH | COUNTS/.1 MIN | DEPTH | COUNTS/.1MIN | DEPTH | COUNTS/.1MIN |
| SURFACE | 12,000 | SURFACE | 19,000 | SURFACE | 18,700 | SURFACE | 27,500 |
| 0" | 8740 | 0" | 13,500 | 0" | 19,300 | 0" | 41,500 |
| 6" | 8090 | 6" | 13,100 | 6" | 24,300 | 6" | 57,300 |
| 12" | 8120 | 12" | 13,200 | 12" | 21,500 | 12" | 26,900 |
| 18" | 6330 | 18" | 10,300 | 18" | 11,900 | 18" | 14,000 |
| 24" | 5950 | 24" | 7700 | 24" | 7450 | 24" | 8920 |
| 30" | 5090 | 30" | 4620 | 30" | 6190 | 30" | 5830 |
| 36" | 4300 | 36" | 4370 | 36" | 4110 | 36" | 5450 |
| 42" | | 42" | | 42" | 3880 | 42" | 5550 |
| 48" | | 48" | | 48" | | 48" | 7280 |
| 54" | | 54" | | 54" | | 54" | AR |
| 60" | | 60" | | 60" | | 60" | |
| 66" | | 66" | | 66" | | 66" | |
| 72" | | 72" | | 72" | | 72" | |
| 78" | | 78" | | 78" | | 78" | |
| 84" | | 84" | | 84" | | 84" | |
| 90" | | 90" | | 90" | | 90" | |
| 96" | | 96" | | 96" | | 96" | |

REMARKS:

Li - N 25655
Li - E 60599 BH # 89
Hh - N 25671
Hh - E 60675 BH # 90
Gg - N 25685
Gg - E 60746 BH # 91
Ff - N 25728
Ff - E 60814 BH # 92
AR = AVERAGE REFUSAL

BOREHOLE LOG

LOGGING CREW: K. COSGROVE B. DUWOLFE
J. CHAPMAN E. OUELLETTE
N/A

SHEET 725 OF 31 ~~130~~ PAGE 26
 DATE: 5-11-95
 PROPERTY ID: UP-479
 AREA: SPS SOUTH OF RR TRACKS

INSTRUMENT ID NO. GSP-1 #1664 / SPA-3 #26

NOTES: 1. ALL HOLES ARE 4" DIA. UNLESS OTHERWISE NOTED.
 2. RECORD UNUSUAL CONDITIONS, SUCH AS THE PRESENCE OF WATER IN BOREHOLES AND
 DEPTH, CASING TYPE AND THICKNESS IF USED, CONCRETE CORES AND THICKNESS,
 OBSTRUCTIONS, UTILITIES, ETC., IN THE REMARKS SECTION.

| BH #93 | | BH #94 | | BH #95 | | BH #96 | |
|--------------------------|--------------------------|--------------------------|--------------------------|--------------------------|--------------------------|--------------------------|--------------------------|
| HOLE ID: <u>Ee</u> | HOLE ID: <u>Cc</u> | HOLE ID: <u>Aa</u> | HOLE ID: <u>-Aa1</u> | HOLE ID: <u>Ee</u> | HOLE ID: <u>Cc</u> | HOLE ID: <u>Aa</u> | HOLE ID: <u>-Aa1</u> |
| TIME DRILLED: <u>N/A</u> | TIME DRILLED: <u>N/A</u> | TIME DRILLED: <u>N/A</u> | TIME DRILLED: <u>N/A</u> | TIME DRILLED: <u>N/A</u> | TIME DRILLED: <u>N/A</u> | TIME DRILLED: <u>N/A</u> | TIME DRILLED: <u>N/A</u> |
| TIME LOGGED: <u>N/A</u> | TIME LOGGED: <u>N/A</u> | TIME LOGGED: <u>N/A</u> | TIME LOGGED: <u>N/A</u> | TIME LOGGED: <u>N/A</u> | TIME LOGGED: <u>N/A</u> | TIME LOGGED: <u>N/A</u> | TIME LOGGED: <u>N/A</u> |
| SOIL TYPE: <u>A</u> | SOIL TYPE: <u>A</u> | SOIL TYPE: <u>A</u> | SOIL TYPE: <u>A</u> | SOIL TYPE: <u>A</u> | SOIL TYPE: <u>A</u> | SOIL TYPE: <u>A</u> | SOIL TYPE: <u>A</u> |
| DEPTH | COUNTS/.1MIN | DEPTH | COUNTS/.1MIN | DEPTH | COUNTS/.1MIN | DEPTH | COUNTS/.1MIN |
| SURFACE | 13100 | SURFACE | 24100 | SURFACE | 6540 | SURFACE | 4100 |
| 0" | 12300 | 0" | 14300 | 0" | 5430 | 0" | 3730 |
| 6" | 15300 | 6" | 11500 | 6" | 5380 | 6" | 4190 |
| 12" | 13400 | 12" | 10800 | 12" | 5180 | 12" | 5030 |
| 18" | 6740 | 18" | 9490 | 18" | 4220 | 18" | 6030 |
| 24" | 4700 | 24" | 7340 | 24" | 3320 | 24" | 7150 |
| 30" | 4350 | 30" | 6240 | 30" | 2870 | 30" | 9760 |
| 36" | 4350 | 36" | 5420 | 36" | 3000 | 36" | 13400 |
| 42" | | 42" | AR | 42" | | 42" | 10500 |
| 48" | | 48" | | 48" | | 48" | 7710 |
| 54" | | 54" | | 54" | | 54" | 8650 |
| 60" | | 60" | | 60" | | 60" | 8410 |
| 66" | N/A | 66" | N/A | 66" | N/A | 66" | 7930 |
| 72" | A | 72" | A | 72" | A | 72" | |
| 78" | | 78" | | 78" | | 78" | N/A |
| 84" | | 84" | | 84" | | 84" | A |
| 90" | | 90" | | 90" | | 90" | |
| 96" | | 96" | | 96" | | 96" | |

REMARKS:

N 25725
Ee - E 60929 BH #93
N 25758
Cc - E 61077 BH #94
N 25794
Aa - E 61224 BH #95
N 25816 25799 BH 5-11-95
- Aa1 - E 61297 BH #96
AR - AUGER REFUSAL

BOREHOLE LOG

LOGGING CREW: K. COSSGROVE B. DEWOLF
J. CHAPMAN E. QUELLETTE
MA
 INSTRUMENT ID NO. ESP-1" 161A/SPA-3" 26

SHEET 26 OF 31 PAGE 27
 DATE: 5-11-95
 PROPERTY ID: VP 479
 AREA: SPS SOUTH OF RR TRACKS

NOTES: 1. ALL HOLES ARE 4" DIA. UNLESS OTHERWISE NOTED.
 2. RECORD UNUSUAL CONDITIONS, SUCH AS THE PRESENCE OF WATER IN BOREHOLES AND DEPTH, CASING TYPE AND THICKNESS IF USED, CONCRETE CORES AND THICKNESS, OBSTRUCTIONS, UTILITIES, ETC., IN THE REMARKS SECTION.

| BH # 97 | | BH # 98 | | BH # 99 | | BH # 100 | |
|----------------------|---------------------|----------------------|----------------------|---------------------|---------------------|---------------------|---------------------|
| HOLE ID: <u>-A1b</u> | HOLE ID: <u>-B1</u> | HOLE ID: <u>-B1a</u> | HOLE ID: <u>-B1b</u> | TIME DRILLED: _____ | TIME DRILLED: _____ | TIME DRILLED: _____ | TIME DRILLED: _____ |
| TIME LOGGED: _____ | TIME LOGGED: _____ | TIME LOGGED: _____ | TIME LOGGED: _____ | SOIL TYPE: _____ | SOIL TYPE: _____ | SOIL TYPE: _____ | SOIL TYPE: _____ |
| DEPTH | COUNTS/.1MIN | DEPTH | COUNTS/.1MIN | DEPTH | COUNTS/.1MIN | DEPTH | COUNTS/.1MIN |
| SURFACE | 3880 | SURFACE | 5630 | SURFACE | 6630 | SURFACE | 5270 |
| 0" | 3860 | 0" | 5630 | 0" | 5690 | 0" | 5820 |
| 6" | 3700 | 6" | 7480 | 6" | 8570 | 6" | 9500 |
| 12" | 3390 | 12" | 6180 | 12" | 10000 | 12" | 13900 |
| 18" | 3330 | 18" | 3650 | 18" | 6330 | 18" | 15700 |
| 24" | 3480 | 24" | 2520 | 24" | 5110 | 24" | 17600 |
| 30" | 3720 | 30" | 2060 | 30" | 4770 | 30" | 15900 |
| 36" | 3590 | 36" | 1820 | 36" | 3980 | 36" | AR |
| 42" | | 42" | | 42" | 2440 | 42" | |
| 48" | | 48" | | 48" | | 48" | |
| 54" | | 54" | | 54" | | 54" | |
| 60" | | 60" | | 60" | | 60" | |
| 66" | N | 66" | N | 66" | N | 66" | N |
| 72" | A | 72" | A | 72" | A | 72" | A |
| 78" | | 78" | | 78" | | 78" | |
| 84" | | 84" | | 84" | | 84" | |
| 90" | | 90" | | 90" | | 90" | |
| 96" | | 96" | | 96" | | 96" | |

REMARKS: _____
N 25812
-A1b E 61362 BH # 97
N 25846
-B1 E 61436 BH # 98
N 25736
-B1a E 1436 BH # 99
N 25826
-B1b E 61436 BH # 100
AR - AUGER REFUSAL

BOREHOLE LOG

LOGGING CREW: K. COSGROVE, J. CHAPMAN

SHEET 927 OF 431 PAGE 28

B. DEWOLFE, E. WILLETTE

DATE: 5-11-95

INSTRUMENT ID NO. ESP-1 #1664 / SPA-3 #26

PROPERTY ID: VP419

AREA: SPS - SOUTH OF RR TRACK

- NOTES: 1. ALL HOLES ARE 4" DIA. UNLESS OTHERWISE NOTED.
 2. RECORD UNUSUAL CONDITIONS, SUCH AS THE PRESENCE OF WATER IN BOREHOLES AND DEPTH, CASING TYPE AND THICKNESS IF USED, CONCRETE CORES AND THICKNESS, OBSTRUCTIONS, UTILITIES, ETC., IN THE REMARKS SECTION.

| BH #101 | | BH #102 | | BH #103 | | BH #104 | |
|--------------|---------------|--------------|---------------|--------------|---------------|--------------|---------------|
| HOLE ID: | TIME DRILLED: | HOLE ID: | TIME DRILLED: | HOLE ID: | TIME DRILLED: | HOLE ID: | TIME DRILLED: |
| <u>-C1</u> | <u>N/A</u> | <u>-C1a</u> | <u>N/A</u> | <u>-D1</u> | <u>N/A</u> | <u>-E1</u> | <u>N/A</u> |
| TIME LOGGED: | SOIL TYPE: | TIME LOGGED: | SOIL TYPE: | TIME LOGGED: | SOIL TYPE: | TIME LOGGED: | SOIL TYPE: |
| <u>N/A</u> | <u>A</u> | <u>N/A</u> | <u>A</u> | <u>N/A</u> | <u>A</u> | <u>N/A</u> | <u>A</u> |
| DEPTH | COUNTS/.1MIN | DEPTH | COUNTS/.1MIN | DEPTH | COUNTS/.1MIN | DEPTH | COUNTS/.1MIN |
| SURFACE | 3510 | SURFACE | 3180 | SURFACE | 3200 | SURFACE | 5130 6190 |
| 0" | 3330 | 0" | 3140 | 0" | 2800 | 0" | 6240 5430 |
| 6" | 3780 | 6" | 4010 | 6" | 3360 | 6" | 5020 6240 |
| 12" | 3610 | 12" | 4940 | 12" | 3210 | 12" | 4870 5070 |
| 18" | 3010 | 18" | 6780 | 18" | 2500 | 18" | 3440 4070 |
| 24" | 2820 | 24" | 8340 | 24" | 2170 | 24" | 3310 3440 |
| 30" | 2590 | 30" | 7950 | 30" | 2110 | 30" | 3310 |
| 36" | 2490 | 36" | 7820 | 36" | 2110 | 36" | 3090 |
| 42" | N A | 42" | AR | 42" | N A | 42" | N A |
| 48" | | 48" | 48" | | | | |
| 54" | | 54" | 54" | | | | |
| 60" | | 60" | 60" | | | | |
| 66" | | 66" | 66" | | | | |
| 72" | | 72" | 72" | | | | |
| 78" | | 78" | 78" | | | | |
| 84" | | 84" | 84" | | | | |
| 90" | | 90" | 90" | | | | |
| 96" | | 96" | 96" | | | | |

REMARKS:

-C1 N 25807 BH #101
 E 61572

-C1a N 25872 25857 bad BH #102
 E 61572 silts

-D1 N 25874 BH #103
 E 61583

-E1 N 25888 BH #104
 E 6157

AR = AUGER REFUSAL

al

BOREHOLE LOG

LOGGING CREW: K. COEGRUE B. De WOLFE
J. CHAPMAN E. OUELLETTE
1/2
 INSTRUMENT ID NO. ESP-1 #144 / SPA-3 #26

SHEET 1828 OF 31 PAGE 29
 DATE: 5-11-95
 PROPERTY ID: VP-479
 AREA: SPS SOUTH OF RR TRACKS

NOTES: 1. ALL HOLES ARE 4" DIA. UNLESS OTHERWISE NOTED.
 2. RECORD UNUSUAL CONDITIONS, SUCH AS THE PRESENCE OF WATER IN BOREHOLES AND DEPTH, CASING TYPE AND THICKNESS IF USED, CONCRETE CORES AND THICKNESS, OBSTRUCTIONS, UTILITIES, ETC., IN THE REMARKS SECTION.

| BH #105 | | BH #106 | | BH #107 | | BH #108 | |
|-------------------------|-------------------------|-------------------------|-------------------------|--------------------------|--------------------------|--------------------------|--------------------------|
| HOLE ID: <u>-F1</u> | HOLE ID: <u>-G1</u> | HOLE ID: <u>-G1a</u> | HOLE ID: <u>-H2 -H1</u> | TIME DRILLED: <u>N/A</u> | TIME DRILLED: <u>N/A</u> | TIME DRILLED: <u>N/A</u> | TIME DRILLED: <u>N/A</u> |
| TIME LOGGED: <u>N/A</u> | TIME LOGGED: <u>N/A</u> | TIME LOGGED: <u>N/A</u> | TIME LOGGED: <u>N/A</u> | SOIL TYPE: <u>A</u> | SOIL TYPE: <u>A</u> | SOIL TYPE: <u>A</u> | SOIL TYPE: <u>A</u> |
| DEPTH | COUNTS/.1MIN | DEPTH | COUNTS/.1MIN | DEPTH | COUNTS/.1MIN | DEPTH | COUNTS/.1MIN |
| SURFACE | 6220 | SURFACE | 1920 | SURFACE | 3090 | SURFACE | 2060 |
| 0" | 4290 | 0" | 1960 | 0" | 2090 | 0" | 2370 |
| 6" | 5040 | 6" | 2280 | 6" | 2820 | 6" | 3410 |
| 12" | 4420 | 12" | 2690 | 12" | 3920 | 12" | 4970 |
| 18" | 3250 | 18" | 2980 | 18" | 3450 | 18" | 7210 |
| 24" | 2740 | 24" | 2920 | 24" | 3170 | 24" | 5150 |
| 30" | 2310 | 30" | AR | 30" | 2770 | 30" | 4750 |
| 36" | 2290 | 36" | | 36" | 2460 | 36" | AR |
| 42" | | 42" | | 42" | | 42" | |
| 48" | | 48" | | 48" | | 48" | |
| 54" | | 54" | | 54" | | 54" | |
| 60" | | 60" | N | 60" | | 60" | |
| 66" | N | 66" | A | 66" | N | 66" | N |
| 72" | A | 72" | | 72" | A | 72" | A |
| 78" | | 78" | | 78" | | 78" | |
| 84" | | 84" | | 84" | | 84" | |
| 90" | | 90" | | 90" | | 90" | |
| 96" | | 96" | | 96" | | 96" | |

REMARKS:
N 25916
-F1 E 61729 BH #105
N 25937
-G1 E 61801 BH #106
N 25919
-G1a E 61801 BH #107
-H1 (SPS) 26002 25974 5-11-95
-H2 E 61873 BH #108
AR- AUGER REFUSAL

BOREHOLE LOG

LOGGING CREW: K. COSSGROVE B. DeWOLF
J. CHAPMAN E. OUELLETTE
MA

SHEET H 29 OF 31 ~~H 30~~ PAGE 30
 DATE: 5-11-95

INSTRUMENT ID NO. GSP-1 # 1664 / SPA-3 # 26

PROPERTY ID: VP-479
 AREA: SPS- SOUTH OF RR TRACK

NOTES: 1. ALL HOLES ARE 4" DIA. UNLESS OTHERWISE NOTED.
 2. RECORD UNUSUAL CONDITIONS, SUCH AS THE PRESENCE OF WATER IN BOREHOLES AND DEPTH, CASING TYPE AND THICKNESS IF USED, CONCRETE CORES AND THICKNESS, OBSTRUCTIONS, UTILITIES, ETC., IN THE REMARKS SECTION.

BH # 109

BH # 110

| DEPTH | COUNTS/.1MIN | DEPTH | COUNTS/.1MIN | DEPTH | COUNTS/.1MIN | DEPTH | COUNTS/.1MIN |
|---------|--------------|---------|--------------|---------|--------------|---------|--------------|
| SURFACE | 3150 | SURFACE | 2070 | SURFACE | | SURFACE | |
| 0" | 3220 | 0" | 2020 | 0" | | 0" | |
| 6" | 4490 | 6" | 2440 | 6" | | 6" | |
| 12" | 4860 | 12" | 2980 | 12" | | 12" | |
| 18" | 4110 | 18" | 3060 | 18" | | 18" | |
| 24" | 2960 | 24" | 2640 | 24" | | 24" | |
| 30" | 2410 | 30" | 2590 | 30" | | 30" | |
| 36" | AR | 36" | AR | 36" | | 36" | |
| 42" | | 42" | | 42" | | 42" | |
| 48" | | 48" | | 48" | | 48" | |
| 54" | | 54" | | 54" | | 54" | |
| 60" | | 60" | | 60" | | 60" | |
| 66" | N | 66" | N | 66" | | 66" | |
| 72" | A | 72" | A | 72" | | 72" | |
| 78" | | 78" | | 78" | | 78" | |
| 84" | | 84" | | 84" | | 84" | |
| 90" | | 90" | | 90" | | 90" | |
| 96" | | 96" | | 96" | | 96" | |

REMARKS: N 25995
I₂ - E 61945 BH # 109
N 26026
-J₃ - E 62018 BH # 110

AR - AUGER REFUSAL

~~N~~
~~A~~

BOREHOLE LOG

LOGGING CREW: E. OUELLETTE B. DENNIE
K. LOSGRIVE

SHEET 30 OF 31 PAGE 31

DATE: 5-22-95

PROPERTY ID: ORF 595

INSTRUMENT ID NO. ESP-1 # 1687 SPA-3 # 40

AREA: NORTH OF RR TRACK

- NOTES: 1. ALL HOLES ARE 4" DIA. UNLESS OTHERWISE NOTED.
2. RECORD UNUSUAL CONDITIONS, SUCH AS THE PRESENCE OF WATER IN BOREHOLES AND DEPTH, CASING TYPE AND THICKNESS IF USED, CONCRETE CORES AND THICKNESS, OBSTRUCTIONS, UTILITIES, ETC., IN THE REMARKS SECTION.

BH # 111

BH # 112

| DEPTH | COUNTS/.1MIN | DEPTH | COUNTS/.1MIN | DEPTH | COUNTS/.1MIN | DEPTH | COUNTS/.1MIN |
|---------|--------------|---------|--------------|---------|--------------|---------|--------------|
| SURFACE | 1700 | SURFACE | 1910 | SURFACE | | SURFACE | |
| 0" | 1750 | 0" | 1980 | 0" | | 0" | |
| 6" | 2100 | 6" | 2250 | 6" | | 6" | |
| 12" | 2150 | 12" | 2340 | 12" | | 12" | |
| 18" | 2250 | 18" | 3000 | 18" | | 18" | |
| 24" | 2720 | 24" | 2130 | 24" | | 24" | |
| 30" | 3010 | 30" | 3170 | 30" | | 30" | |
| 36" | 3230 | 36" | 3420 | 36" | | 36" | |
| 42" | | 42" | | 42" | | 42" | |
| 48" | | 48" | | 48" | | 48" | |
| 54" | | 54" | | 54" | | 54" | |
| 60" | | 60" | | 60" | | 60" | |
| 66" | | 66" | | 66" | | 66" | |
| 72" | | 72" | | 72" | | 72" | |
| 78" | | 78" | | 78" | | 78" | |
| 84" | | 84" | | 84" | | 84" | |
| 90" | | 90" | | 90" | | 90" | |
| 96" | | 96" | | 96" | | 96" | |

REMARKS: EE4 - E 58348 BH # 111
N 25395
N 25401
FFA - E 58870 BH # 112

ML

BOREHOLE LOG

LOGGING CREW: A. Simons

SHEET 1 OF 3 PAGE 1

S. JAMES

DATE: 3-8-96

PROPERTY ID: VP 480

INSTRUMENT ID NO. ESP-1 / 1690 SPA-406467-31

AREA: _____

- NOTES: 1. ALL HOLES ARE 4" DIA. UNLESS OTHERWISE NOTED.
2. RECORD UNUSUAL CONDITIONS, SUCH AS THE PRESENCE OF WATER IN BOREHOLES AND DEPTH, CASING TYPE AND THICKNESS IF USED, CONCRETE CORES AND THICKNESS, OBSTRUCTIONS, UTILITIES, ETC., IN THE REMARKS SECTION.

| DEPTH | CPTM | DEPTH | CPTM | DEPTH | CPTM | DEPTH | CPTM |
|---------|-------|---------|-------|---------|-------|---------|------|
| SURFACE | 1540 | SURFACE | 1770 | SURFACE | 6470 | SURFACE | 4570 |
| 0" | 1650 | 0" | 1800 | 0" | 7250 | 0" | 4830 |
| 6" | 1610 | 6" | 1980 | 6" | 10200 | 6" | 5780 |
| 12" | 1780 | 12" | 2460 | 12" | 13200 | 12" | 6750 |
| 18" | 2150 | 18" | 2880 | 18" | 14600 | 18" | 7210 |
| 24" | 2100 | 24" | 2550 | 24" | 16800 | 24" | 7670 |
| 30" | WATER | 30" | WATER | 30" | 16200 | 30" | AR |
| 36" | | 36" | | 36" | WATER | 36" | |
| 42" | | 42" | | 42" | | 42" | |
| 48" | | 48" | | 48" | | 48" | |
| 54" | | 54" | | 54" | | 54" | |
| 60" | | 60" | | 60" | | 60" | |
| 66" | | 66" | | 66" | | 66" | |
| 72" | | 72" | | 72" | | 72" | |
| 78" | | 78" | | 78" | | 78" | |
| 84" | | 84" | | 84" | | 84" | |
| 90" | | 90" | | 90" | | 90" | |
| 96" | | 96" | | 96" | | 96" | |

REMARKS: These Boreholes define the extent of contamination south of the R/R tracks

REVIEWED BY: A. Simons DATE: 3-11-96

BOREHOLE LOG

LOGGING CREW: A. CLEMONS

SHEET: 2 OF 3 PAGE: 2

S. JAMES

DATE: 3-8-96

PROPERTY ID: VP 480

STRUMENT ID NO. _____

AREA: _____

- NOTES: 1. ALL HOLES ARE 4" DIA. UNLESS OTHERWISE NOTED.
2. RECORD UNUSUAL CONDITIONS, SUCH AS THE PRESENCE OF WATER IN BOREHOLES AND DEPTH, CASING TYPE AND THICKNESS IF USED, CONCRETE CORES AND THICKNESS, OBSTRUCTIONS UTILITIES, ETC., IN THE REMARKS SECTION.

| DEPTH | CPTM | DEPTH | CPTM | DEPTH | CPTM | DEPTH | CPTM |
|---------|--------|---------|-------|---------|------|---------|------|
| SURFACE | 3440 | SURFACE | 1450 | SURFACE | 2060 | SURFACE | 1790 |
| 0" | 3150 | 0" | 1350 | 0" | 2110 | 0" | 1780 |
| 6" | 4210 | 6" | 1290 | 6" | 4800 | 6" | 2110 |
| 12" | 5780 | 12" | 1740 | 12" | 4710 | 12" | 2230 |
| 18" | 7950 | 18" | WATER | 18" | 6180 | 18" | 2230 |
| 24" | 7950 | 24" | | 24" | 5710 | 24" | 2410 |
| 30" | 11,300 | 30" | | 30" | AR | 30" | 2350 |
| 36" | AR | 36" | | 36" | | 36" | AR |
| 42" | | 42" | | 42" | | 42" | |
| 48" | | 48" | | 48" | | 48" | |
| 54" | | 54" | | 54" | | 54" | |
| 60" | | 60" | | 60" | | 60" | |
| 66" | | 66" | | 66" | | 66" | |
| 72" | | 72" | | 72" | | 72" | |
| 78" | | 78" | | 78" | | 78" | |
| 84" | | 84" | | 84" | | 84" | |
| 90" | | 90" | | 90" | | 90" | |
| 96" | | 96" | | 96" | | 16" | |

REMARKS: These Boreholes define the extent of contamination to south of the R/R tracks

REVIEWED BY: A. Clemmons

DATE: 3-11-96

BOREHOLE LOG

DIGGING CREW: A. Clemons

SHEET 3 OF 3 PAGE 3

S. James

DATE: 3-8-96

PROPERTY ID: VP 480

INSTRUMENT ID NO. _____

AREA: _____

- NOTES: 1. ALL HOLES ARE 4" DIA. UNLESS OTHERWISE NOTED.
2. RECORD UNUSUAL CONDITIONS, SUCH AS THE PRESENCE OF WATER IN BOREHOLES AND DEPTH, CASING TYPE AND THICKNESS IF USED, CONCRETE CORES AND THICKNESS, OBSTRUCTIONS, UTILITIES, ETC., IN THE REMARKS SECTION.

| DEPTH | CPTM | DEPTH | CPTM | DEPTH | CPTM | DEPTH | CPTM |
|---------|-------|---------|-------|---------|------|---------|------|
| SURFACE | 1470 | SURFACE | 1210 | SURFACE | | SURFACE | |
| 0" | 1120 | 0" | 1260 | 0" | | 0" | |
| 6" | 1330 | 6" | 1440 | 6" | | 6" | |
| 12" | 1540 | 12" | 1540 | 12" | | 12" | |
| 18" | 1700 | 18" | 1580 | 18" | | 18" | |
| 24" | WATER | 24" | WATER | 24" | | 24" | |
| 30" | | 30" | | 30" | | 30" | |
| 36" | | 36" | | 36" | | 36" | |
| 42" | | 42" | | 42" | | 42" | |
| 48" | | 48" | | 48" | | 48" | |
| 54" | | 54" | | 54" | | 54" | |
| 60" | | 60" | | 60" | | 60" | |
| 66" | | 66" | | 66" | | 66" | |
| 72" | | 72" | | 72" | | 72" | |
| 78" | | 78" | | 78" | | 78" | |
| 84" | | 84" | | 84" | | 84" | |
| 90" | | 90" | | 90" | | 90" | |
| 96" | | 96" | | 96" | | 96" | |

BH #121
BOREHOLE ID: -IJA
COORD: N25942 E61950
SS or SC #'s/DEPTH: _____

BH #122
BOREHOLE ID: -JJA
COORD: N25954 E62017
SS or SC #'s/DEPTH: _____

BOREHOLE ID: _____
COORD: _____
SS or SC #'s/DEPTH: _____

BOREHOLE ID: _____
COORD: _____
SS or SC #'s/DEPTH: _____

NOTES: Edge of H₂O
70' from center of RR

NOTES: Edge of H₂O
48' from center of RR

NOTES: _____

NOTES: _____

REMARKS: -I & -J were south of the track where the bank is @ 20' higher than the track. These boreholes are the southern limit of contamination

REVIEWED BY: A. Clemons

DATE: 3-11-96

OCS SAMPLE LOG

SITE NAME RIFLE, CO

| COUNT DATE INITIAL 20 DAY | SAMPLE ID & LOCATION | DATE SAMPLED | DATE SEALED | OCS # INITIAL 20 DAY | BI-214 pCi INITIAL 20 DAY | TI-208 pCi INITIAL 20 DAY | MASS (grams) WET DRY | RE-226 pCi/g INITIAL 20 DAY | TH-232 pCi/g INITIAL 20 DAY | DEPTH <15cm >15cm | TECH INITIAL 20 DAY | COMMENTS |
|---------------------------|----------------------|--------------|-------------|----------------------|---------------------------|---------------------------|----------------------|-----------------------------|-----------------------------|-------------------|---------------------|-------------------------------------------------|
| 9-6-94 | RFL-SE-3956 | 9-6-94 | | 530 | 2459 | 966.8 | 422 | 5.8 | 2.3 | ✓ | 92 | 3+55, 1+40 |
| N/A | VP500 | | | | | | | | | | | |
| 9-6-94 | RFL-SE-3957 | 9-6-94 | | 434 | 3760 | 983.9 | 531 | 7.1 | 1.9 | ✓ | 83 | 3+55, 1+35 1480 ACPM |
| N/A | VP500 | | | | | | | | | | | |
| 9-6-94 | RFL-SE-3958 | 9-6-94 | | 534 | 2686 | 1034 | 397 | 6.8 | 2.4 | ✓ | 83 | E BANK S END 1000 ACPM |
| N/A | VP500 | | | | | | | | | | | |
| 9-6-94 | RFL-SE-3959 | 9-6-94 | | 452 | 3405 | 888.2 | 304 | 11.2 | 2.9 | ✓ | 83 | Δ 1420 ACPM 2+95, 0+50 |
| N/A | VP500 | | | | | | | | | | | |
| 9-7-94 | RFL-SE-3960 | 9-7-94 | | 400 | 1922 | 1088 | 503 | 3.8 | 2.2 | ✓ | 83 | SE CORNER Composite |
| N/A | VP500 | | | | | | | | | | | |
| 9-7-94 | RFL-SE-3961 | 9-7-94 | | 410 | 380.1 | 966.5 | 521 | 0.73 | 1.9 | ✓ | 83 | 12'E-8 SE CORNER |
| N/A | VP500 | | | | | | | | | | | |
| 9-8-94 | RFL-SE-3962 | 9-7-94 | | 400 | 6811 | 1271 | 439 | 15.6 | 2.9 | ✓ | 90 | 4+35, 0+15L+ |
| N/A | VP500 | | | | | | | | | | | |
| 9-8-94 | ORF-SS-3963 | 9-8-94 | | 500 | 699.9 | 1168 | 586 | 1.2 | 2.0 | ✓ | 90 | 6'-7' Elev. 5299.4 N 25395 E 58951 |
| 10-6-94 | -1 | 9-7-94 | 9-10-94 | 438 | 629.1 | 1188 | 576 | 1.1 | 2.1 | ✓ | 90 | 5/5 2'-3' Elev. 5299.4 N 25395 E 58951 |
| 9-8-94 | ORF-SS-3964 | 9-7-94 | 9-10-94 | 402 | 1153 | 1054 | 620 | 1.9 | 1.7 | ✓ | 90 | 5/5 3'-4' Elev. 5300 N 25391 E 58947 |
| 10-7-94 | -1 | 9-7-94 | 9-10-94 | 518 | 992.0 | 1034 | 574 | 1.7 | 1.8 | ✓ | 90 | |
| 9-8-94 | ORF-SS-3965 | 9-7-94 | 9-10-94 | 502 | 1163 | 1254 | 594 | 2.0 | 2.1 | ✓ | 90 | |
| 10-6-94 | -2 | 9-7-94 | 9-10-94 | 538 | 1125 | 1005 | 579 | 1.9 | 1.7 | ✓ | 90 | |

Site Correction Factor = 1.8
 VP Correction Factor (if applicable) = 1.8
 Count Time = 500 SEC, unless otherwise noted

COPY

REVIEWED BY:

Robert H. Farnell
Site HP Manager

OCS SAMPLE LOG

SITE NAME RIFLE, CO

| COUNT DATE INITIAL 20 DAY | SAMPLE ID & LOCATION | DATE SAMPLED | DATE SEALED | OCS # INITIAL 20 DAY | B-214 pCi INITIAL 20 DAY | Tl-206 pCi INITIAL 20 DAY | MASS (grams) WET DRY | Re-226 pCi/g INITIAL/CORR. 20 DAY | Th-232 pCi/g INITIAL 20 DAY | DEPTH <15cm >15cm | TECH INITIAL 20 DAY | COMMENTS |
|---------------------------|----------------------|--------------|-------------|----------------------|--------------------------|---------------------------|----------------------|-----------------------------------|-----------------------------|-------------------|---------------------|---------------------------|
| 9-8-94 | ORF-SS-3966 | 9-7-94 | 9-10-94 | 404 | 1380 | 1036 | 625 | 2.2 | 1.7 | | YU | S/S 0'-1' Elev. 5300 CC |
| 10-7-94 | - 2 | 9-7-94 | 9-10-94 | 418 | 3925 | 1162 | 535 | 4.5 | 2.2 | ✓ | YU | N 25391 E 58997 |
| 9-8-94 | ORF-SS-3967 | 9-7-94 | 9-10-94 | 504 | 9046 | 1130 | 613 | 1.5 | 1.8 | | YU | S/S 3'-4' Elev. 5299.4 EE |
| 10-7-94 | - 1 | 9-7-94 | 9-10-94 | 420 | 1354 | 839.0 | 597 | 2.3 | 1.4 | ✓ | YU | N 25395 E 58951 |
| 9-8-94 | ORF-SS-3968 | 9-7-94 | 9-10-94 | 406 | 1260 | 949.1 | 628 | 2.0 | 1.5 | | YU | S/S 0'-1' Elev. 5299.4 EE |
| 10-7-94 | - 1 | 9-7-94 | 9-10-94 | 520 | 1327 | 1139 | 606 | 2.2 | 1.9 | ✓ | YU | N 25395 E 58951 |
| 9-8-94 | ORF-SS-3969 | 9-7-94 | 9-10-94 | 506 | 288830 | 13037 | 635 | 7.9 | 20.5 | | YU | S/S 0'-1' Elev. 5302 AA |
| 10-7-94 | - 5 | 9-7-94 | 9-10-94 | 422 | 42720 | 12819 | 543 | 786.9 | 236 | ✓ | YU | N 25394 E 58935 |
| 9-8-94 | ORF-SS-3970 | 9-7-94 | 9-10-94 | 408 | 1893 | 1132 | 605 | 3.1 | 1.9 | | YU | S/S 2'-3' Elev. 5300 CC |
| 10-7-94 | - 2 | 9-7-94 | 9-10-94 | 522 | 2111 | 1206 | 588 | 3.6 | 2.1 | ✓ | YU | N 25391 E 58997 |
| 9-8-94 | ORF-SS-3971 | 9-7-94 | 9-10-94 | 508 | 4319 | 1292 | 661 | 6.5 | 2.0 | | YU | S/S 7'-8' Elev. 5300.4 BB |
| 10-6-94 | - 4 | 9-7-94 | 9-10-94 | 440 | 4470 | 1215 | 647 | 6.9 | 1.9 | ✓ | YU | N 25392 E 59156 |
| 9-8-94 | RFL-SE-3972 | 9-7-94 | 9-10-94 | 410 | 3811 | 1080 | 446 | 8.5 | 2.4 | | YU | 4+00, 0+8514 |
| N/A | - VP 500 | 9-8-94 | | | | | | | | ✓ | | |
| 9-8-94 | ORF-SS-3973 | 9-7-94 | 9-10-94 | 510 | 856.3 | 832.8 | 639 | 1.3 | 1.3 | | YU | S/S 1'-2' Elev. 5299.4 EE |
| 10-7-94 | - 1 | 9-7-94 | 9-10-94 | 424 | 1040 | 812.7 | 548 | 1.9 | 1.5 | ✓ | YU | N 25395 E 58951 |
| 9-8-94 | ORF-SS-3974 | 9-7-94 | 9-10-94 | 412 | 9899 | 888.2 | 639 | 1.5 | 1.4 | | YU | S/S 4'-5' Elev. 5299.4 EE |
| 10-6-94 | - 1 | 9-7-94 | 9-10-94 | 540 | 980.2 | 976.4 | 630 | 1.6 | 1.5 | ✓ | YU | N 25395 E 58951 |
| 9-8-94 | ORF-SS-3975 | 9-7-94 | 9-10-94 | 512 | 728.7 | 957.2 | 598 | 1.2 | 1.6 | | YU | S/S 5'-6' Elev. 5299.4 EE |
| 10-7-94 | - 1 | 9-7-94 | 9-10-94 | 524 | 642.3 | 947.7 | 587 | 1.1 | 1.6 | ✓ | YU | N 25395 E 58951 |

Site Correction Factor = 1.8
 VP Correction Factor (if applicable) = 1.8
 Count Time = 500 SEC, unless otherwise noted

COPY

REVIEWED BY: John A. General
 Site HP Manager

OCS SAMPLE LCG

SITE NAME Riflo Co

| COUNT DATE INITIAL 20 DAY | SAMPLE ID & LOCATION | DATE SAMPLED | DATE SEALED | OCS # INITIAL 20 DAY | BI-214 PCI INITIAL 20 DAY | TI-208 PCI INITIAL 20 DAY | MASS (grams) WET DRY | Ra-226 pCi/g INITIAL/CORR. 20 DAY | Th-232 pCi/g INITIAL 20 DAY | DEPTH <15cm >15cm | TECH INITIAL 20 DAY | COMMENTS |
|---------------------------|----------------------|--------------|-------------|----------------------|---------------------------|---------------------------|----------------------|-----------------------------------|-----------------------------|-------------------|---------------------|------------------------|
| 9-8-94 | ORF-SS-3976 | 9-7-94 | 9-10-94 | 414 | 1659 | 740.1 | 572 | 2.9 | 1.3 | ✓ | 83 | 8'-9" 5/8 Elev. 5299.4 |
| 10-6-94 | -1 | 9-7-94 | 9-10-94 | 442 | 1735 | 971.1 | 562 | 3.1 | 1.7 | ✓ | 90 | N. 25395 Elev. 5300.9 |
| 9-8-94 | ORF-SS-3977 | 9-7-94 | 9-10-94 | 514 | 2249 | 1235 | 640 | 3.5 | 1.9 | ✓ | 83 | 0'-1" 5/8 Elev. 5300.9 |
| 10-7-94 | -3 | 9-7-94 | 9-10-94 | 426 | 3109 | 1127 | 566 | 5.5 | 2.0 | ✓ | 90 | N. 29931 Elev. 5300.9 |
| 9-8-94 | ORF-SS-3978 | 9-7-94 | 9-10-94 | 416 | 1588 | 818.5 | 565 | 2.8 | 1.4 | ✓ | 83 | 1'-6" 3/8 Elev. 5300 |
| 10-7-94 | -2 | 9-7-94 | 9-10-94 | 526 | 2163 | 909.4 | 510 | 5.2 | 1.8 | ✓ | 90 | N. 25391 Elev. 5300 |
| 10-6-94 | ORF-SS-3979 | 9-7-94 | 9-10-94 | 516 | 3193 | 928.5 | 646 | 4.9 | 1.4 | ✓ | 83 | E. 59058 Elev. 5300.9 |
| 10-6-94 | -2 | 9-7-94 | 9-10-94 | 542 | 4064 | 1015 | 637 | 6.4 | 1.6 | ✓ | 90 | 4'-5" 5/8 Elev. 5300 |
| 9-8-94 | ORF-SS-3980 | 9-7-94 | 9-10-94 | 418 | 3618 | 1036 | 633 | 5.7 | 1.6 | ✓ | 83 | N. 25391 Elev. 5300 |
| 10-7-94 | -2 | 9-7-94 | 9-10-94 | 428 | 4510 | 1031 | 620 | 7.3 | 1.7 | ✓ | 90 | E. 58997 Elev. 5300.9 |
| 9-8-94 | ORF-SS-3981 | 9-7-94 | 9-10-94 | 578 | 1299 | 938.1 | 647 | 2.0 | 1.4 | ✓ | 83 | 6'-7" 5/8 Elev. 5300 |
| 10-7-94 | -2 | 9-7-94 | 9-10-94 | 528 | 2111 | 775.4 | 523 | 4.0 | 1.5 | ✓ | 90 | N. 25391 Elev. 5300 |
| 9-8-94 | ORF-SS-3982 | 9-7-94 | 9-10-94 | 422 | 2576 | 1297 | 615 | 4.8 | 2.1 | ✓ | 83 | E. 58997 Elev. 5300.9 |
| 10-7-94 | -1 | 9-7-94 | 9-10-94 | 430 | 3896 | 1119 | 602 | 6.5 | 1.9 | ✓ | 90 | 7'-8" 3/8 Elev. 5300.9 |
| 9-8-94 | ORF-SS-3983 | 9-7-94 | 9-10-94 | 520 | 2223 | 457.2 | 580 | 3.8 | 1.7 | ✓ | 83 | N. 25391 Elev. 5300.9 |
| 10-7-94 | -3 | 9-7-94 | 9-10-94 | 530 | 3122 | 823.2 | 526 | 5.9 | 1.6 | ✓ | 90 | E. 59058 Elev. 5300.9 |
| 9-8-94 | ORF-SS-3984 | 9-7-94 | 9-10-94 | 424 | 2616 | 940.4 | 558 | 4.7 | 1.7 | ✓ | 90 | 2'-3" Elev. 5300.9 |
| 10-7-94 | -3 | 9-7-94 | 9-10-94 | 550 | 3765 | 813.6 | 513 | 7.3 | 1.6 | ✓ | 90 | N. 25391 Elev. 5300.9 |
| 9-8-94 | ORF-SS-3985 | 9-7-94 | 9-10-94 | 522 | 4889 | 1063 | 635 | 7.7 | 1.7 | ✓ | 90 | 5'-5" Elev. 5300.9 |
| 10-6-94 | -3 | 9-7-94 | 9-10-94 | 544 | 6139 | 1149 | 614 | 10.0 | 1.9 | ✓ | 90 | 3'-4" Elev. 5300.9 |

Site Correction Factor = 1.8
 VP Correction Factor (if applicable) = 1.8
 Count Time = 500 S.C., unless otherwise noted

COPY

REVIEWED BY: Robert K. Fennell
 Site HP Manager

OCS SAMPLE LOG

SITE NAME RIFLE, CO

| COUNT DATE INITIAL 20 DAY | SAMPLE ID & LOCATION | DATE SAMPLED | DATE SEALED | OCS # INITIAL 20 DAY | BF-214 PCI INITIAL 20 DAY | TI-208 PCI INITIAL 20 DAY | MASS (grams) WET DRY | R-226 PCUG INITIAL 20 DAY | Th-232 pChg INITIAL 20 DAY | DEPTH <15cm >15cm | TECH INITIAL 20 DAY | COMMENTS |
|---------------------------|----------------------|-------------------|-------------|----------------------|---------------------------|---------------------------|----------------------|---------------------------|----------------------------|-------------------|---------------------|----------------------------------------------------------------|
| | | | | | | | | | | | | |
| 9-8-94 | ORF-SS-3986 | 9-7-94 | 9-10-94 | 426 | 1412 | 853.3 | 581 | 2.4 | 1.5 | | YU | S/S 4'-5' Elev. 5300.9 N 25391 E 59058 DD |
| 10-7-94 | -3 | 9-7-94 | | 432 | 1785 | 1614 | 557 | 3.2 | 1.8 | ✓ | YU | |
| 9-8-94 | ORF-SS-3987 | 9-7-94 | 9-10-94 | 524 | 1200 | 1063 | 560 | 2.1 | 1.9 | | YU | S/S 5'-6' Elev. 5300.9 N 25391 E 59058 DD |
| 10-6-94 | -3 | 9-7-94 | 9-10-94 | 444 | 1328 | 1258 | 550 | 2.4 | 2.3 | ✓ | YU | |
| 9-8-94 | RFL-SE-3988 | 9-7-94 | 9-10-94 | 428 | 1722 | 931.7 | 493 | 3.5 | 1.9 | ✓ | YU | Concrete Pad S.W. Corner of Bldg. |
| 9-8-94 | -VP500 | 9-8-94 | | | | | | | | | | |
| 9-8-94 | RFL-SE-3989 | 9-7-94 | 9-10-94 | 526 | 3337 | 1043 | 668 | 4.8 | 1.6 | | YU | S/S 0'-1' Elev. 5300.4 N 25392 E 59156 BB |
| 10-7-94 | -4 | 9-7-94 | 9-10-94 | 454 | 4826 | 935.0 | 545.74 | 8.4 | 1.6 | ✓ | YU | |
| 9-8-94 | ORF-SS-3990 | 9-7-94 | 9-10-94 | 430 | 1460 | 783.7 | 604 | 10.7 | 1.3 | | YU | S/S 1'-2' Elev. 5300.9 N 25392 E 59156 BB |
| 10-7-94 | -4 | 9-7-94 | 9-10-94 | 552 | 9542 | 1359 | 577 | 16.5 | 2.4 | ✓ | YU | |
| 9-8-94 | ORF-SS-3991 | 9-7-94 | 9-10-94 | 528 | 11094 | 1053 | 533 | 20.8 | 2.0 | | YU | S/S 2'-3' Elev. 5300.4 N 25392 E 59156 BB |
| 10-7-94 | -4 | 9-7-94 | 9-10-94 | 530 | 16597 | 1340 | 473 | 35.4 | 2.8 | ✓ | YU | |
| 9-8-94 | ORF-SS-3992 | 9-7-94 | 9-10-94 | 432 | 28317 | 1820 | 564 | 50.3 | 3.2 | | SS | S/S 3'-4' Elev. 5300.4 N 25392 E 59156 BB |
| 10-7-94 | -4 | 9-7-94 | 9-10-94 | 434 | 40368 | 1643 | 518 | 77.9 | 3.2 | ✓ | YU | |
| 9-8-94 | ORF-SS-3993 | 9-7-94 | 9-10-94 | 530 | 34583 | 1570 | 559 | 44.0 | 2.8 | | SS | S/S 4'-5' Elev. 5300.4 N 25392 E 59156 BB |
| 10-7-94 | -4 | 9-7-94 | 9-10-94 | 456 | 37970 | 1756 | 529 | 71.8 | 3.3 | ✓ | YU | |
| 9-8-94 | ORF-SS-3994 | 9-7-94 | 9-10-94 | 434 | 150400 | 6008 | 602 | 249.8 | 10.0 | | YU | S/S 5'-6' Elev. 5300.4 N 25392 E 59156 BB |
| 10-7-94 | -4 | 9-7-94 | 9-10-94 | 554 | 220210 | 9716 | 573 | 384.3 | 16.9 | ✓ | YU | |
| 9-8-94 | ORF-SS-3995 | 9-7-94 | 9-10-94 | 532 | 13091 | 1091 | 598 | 21.9 | 1.8 | | YU | S/S 6'-7' Elev. 5300.4 N 25392 E 59156 Look for block BB |
| 10-7-94 | -4 | 9-7-94 | 9-10-94 | 534 | 16692 | 1484 | 563 | 29.6 | 2.6 | ✓ | YU | |

Site Correction Factor = 1.8
 IP Correction Factor (applicable) = 1.8
 Count Time = 51 SEC, unless otherwise noted

REVIEWED BY: John A. Farnell
 Site HP Manager

COPY

OCS SAMPLE LOG

SITE NAME RIFLE, CO

| COUNT DATE INITIAL 20 DAY | SAMPLE ID & LOCATION | DATE SAMPLED | DATE SEALED | OCS # INITIAL 20 DAY | BI-214 pCi INITIAL 20 DAY | TI-208 pCi INITIAL 20 DAY | MASS (gram) WET DRY | P-228 Ci/g INITIAL/CORR. 20 DAY | Th-232 pCi/g INITIAL 20 DAY | DEPTH <15cm >15cm | TECH INITIAL 20 DAY | COMMENTS |
|---------------------------|----------------------|--------------|-------------|----------------------|---------------------------|---------------------------|---------------------|---------------------------------|-----------------------------|-------------------|---------------------|-----------------------------------------------|
| 9-8-94 | ORF-SS-3996 | | | 436 | 31167 | 1411 | 610 | 48.7 | 2.2 | | YU | S/S Elev. 5302 N 25394 E 59235 1'-2' AA |
| 10-7-94 | -5 | 9-7-94 | 9-10-94 | 458 | 39627 | 2010 | 614 | 64.5 | 3.3 | ✓ | YU | |
| 9-8-94 | ORF-SS-3997 | | | 534 | 2129 | 947.7 | 610 | 3.5 | 1.6 | | YU | S/S Elev. 5302 2'-3' AA |
| 10-7-94 | -5 | 9-7-94 | 9-10-94 | 556 | 2536 | 1364 | 601 | 4.2 | 2.1 | ✓ | YU | N 25394 E 59235 AA |
| 9-8-94 | ORF-SS-3998 | | | 438 | 1932 | 1045 | 611 | 3.2 | 1.7 | | YU | S/S Elev. 5302 3'-4' AA |
| 10-7-94 | -5 | 9-7-94 | 9-10-94 | 436 | 2597 | 1022 | 601 | 4.3 | 1.7 | ✓ | YU | N 25394 E 59235 AA |
| 9-8-94 | ORF-SS-3999 | | | 536 | 7661 | 1024 | 658 | 11.0-2.8 | 1.6 | | YU | S/S Elev. 5302 4'-5' AA |
| 10-7-94 | -5 | 9-7-94 | 9-10-94 | 460 | 9114 | 1416 | 647 | 14.1 | 2.2 | ✓ | YU | N 25394 E 59235 AA |
| 9-8-94 | ORF-SS-4000 | | | 440 | 7693 | 923.0 | 436 | 17.6 | 2.1 | | YU | 0'-1' Elev. 5302.1 N 25401 E 59307 Z |
| 10-7-94 | -6 | 9-7-94 | 9-10-94 | 536 | 10923 | 1168 | 420 | 26.0 | 2.8 | ✓ | YU | S/S Elev. 5302.1 1'-2' Z |
| 9-8-94 | ORF-SS-4001 | | | 538 | 2948 | 679.6 | 249 | 11.8 | 2.7 | | YU | N 25401 E 59307 Z |
| 10-7-94 | -6 | 9-7-94 | 9-10-94 | 448 | 4208 | 576.7 | 240 | 17.5 | 2.4 | ✓ | YU | S/S Elev. 5302.1 2'-3' Z |
| 9-8-94 | ORF-SS-4002 | | | 442 | 23775 | 1402 | 480 | 49.5 | 2.9 | | YU | N 25401 E 59307 Z |
| 10-7-94 | -6 | 9-7-94 | 9-10-94 | 558 | 35214 | 1895 | 468 | 75.2 | 4.0 | ✓ | YU | S/S Elev. 5302.1 3'-4' Z |
| 9-8-94 | ORF-SS-4003 | | | 540 | 5083 | 959.2 | 512 | 9.9 | 1.9 | | YU | N 25401 E 59307 Z |
| 10-7-94 | -6 | 9-7-94 | 9-10-94 | 546 | 6793 | 8711 | 505 | 13.5 | 1.7 | ✓ | YU | S/S Elev. 5302.1 4'-5' Z |
| 9-8-94 | ORF-SS-4004 | | | 542 | 4855 | 871.1 | 494 | 9.8 | 1.8 | | YU | N 25401 E 59307 Z |
| 10-7-94 | -6 | 9-7-94 | 9-10-94 | 462 | 6951 | 961.2 | 488 | 14.2 | 2.0 | ✓ | YU | S/S Elev. 5302.1 4'-5' Z |
| 9-8-94 | RFL-SE-4005 | | | 444 | 4306 | 1193 | 430 | 10.0 | 2.8 | | YU | ©12"-18" 3+75, 1+10 Lt. |
| NK | -VP500 | 9-8-94 | | | | | | | | ✓ | | |

Site Correction Factor = 1.8
 VP Correction Factor (if applicable) = 1.8
 Count Time = 500 SEC, unless otherwise noted

REVIEWED BY: John R. Jones
 Site HP Manager

COPY

OCS SAMPLE LOG

SITE NAME RIFLE, CO

| COUNT DATE INITIAL 20 DAY | SAMPLE ID & LOCATION | DATE SAMPLED | DATE SEALED | OCS # INITIAL 20 DAY | BI-214 pCi INITIAL 20 DAY | TI-208 pCi INITIAL 20 DAY | MASS (grams) WET DRY | Re-226 pCi INITIAL/CORR. 20 DAY | Th-232 pCi INITIAL 20 DAY | DEPTH <15cm >15cm | TECH INITIAL 20 DAY | COMMENTS |
|---------------------------|----------------------|--------------|-------------|----------------------|---------------------------|---------------------------|----------------------|---------------------------------|---------------------------|-------------------|---------------------|----------------------------|
| 9-9-94 | RFL-SS-4016 | 9-8-94 | 9-10-94 | 510 | 2019 | 1615 | 402 | 5.0 | 2.5 | | PU | S/S Comp #4 Hosp. Hill rd. |
| 10-10-94 | #4 | 9-8-94 | 9-10-94 | 568 | 4287 | 823.2 | 369 | 11.6 | 2.2 | ✓ | WUW | |
| 9-9-94 | RFL-SS-4017 | 9-8-94 | 9-10-94 | 410 | 1839 | 879.5 | 443 | 4.2 | 2.0 | | PU | S/S Comp #5 Hosp. Hill rd. |
| 10-10-94 | #5 | 9-8-94 | 9-10-94 | 470 | 3530 | 943.7 | 420 | 8.4 | 2.2 | ✓ | WUW | |
| 9-9-94 | RFL-SS-4018 | 9-8-94 | 9-10-94 | 512 | 1369 | 1130 | 518 | 2.6 | 2.2 | | PU | S/S Comp #6 Hosp. Hill rd. |
| 10-10-94 | #6 | 9-8-94 | 9-10-94 | 570 | 2140 | 890.2 | 485 | 4.4 | 1.8 | ✓ | WUW | |
| 9-9-94 | RFL-SS-4019 | 9-8-94 | 9-10-94 | 412 | 2028 | 966.5 | 653 | 3.1 | 1.5 | | PU | S/S Comp #7 Hosp. Hill rd. |
| 10-10-94 | #7 | 9-8-94 | 9-10-94 | 472 | 3135 | 865.1 | 601 | 5.2 | 1.4 | ✓ | WUW | |
| 9-9-94 | ORF-SS-4020 | 9-8-94 | 9-10-94 | 514 | 728.1 | 947.7 | 648 | 1.1 | 1.5 | | PU | 0' + 1' Elev. 5301.2 |
| 10-10-94 | -13 | 9-8-94 | 9-10-94 | 572 | 852.8 | 995.5 | 524 | 1.6 | 1.9 | ✓ | WUW | N 25518 E 59836 S |
| 9-9-94 | RFL-SE-4021 | 9-8-94 | 9-10-94 | 414 | 3875 | 1097 | 445 | 8.7 | 2.5 | | PU | 3+25, 0+80 ft. |
| N/A | -VP 500 | 9-9-94 | | | | | | | | ✓ | | |
| 9-9-94 | ORF-SS-4022 | 9-8-94 | 9-10-94 | 516 | 380.7 | 1206 | 643 | 0.59 | 1.9 | | PU | S/S 1'-2' Elev. 5301.2 |
| 10-10-94 | -13 | 9-8-94 | 9-10-94 | 474 | 1147 | 1084 | 526 | 2.2 | 2.1 | ✓ | WUW | N 25518 E 59836 S |
| 9-9-94 | ORF-SS-4023 | 9-8-94 | 9-10-94 | 416 | 797.4 | 853.3 | 488 | 1.6 | 1.7 | | PU | S/S 2'-3' Elev. 5301.2 |
| 10-6-94 | -13 | 9-8-94 | 9-10-94 | 534 | 1013 | 938.1 | 446 | 2.3 | 2.1 | ✓ | PU | N 25518 E 59836 S |
| 9-9-94 | ORF-SS-4024 | 9-8-94 | 9-10-94 | 518 | 1222 | 851.9 | 398 | 3.1 | 2.1 | | PU | S/S 3'-4' Elev. 5301.2 |
| 10-6-94 | -13 | 9-8-94 | 9-10-94 | 436 | 1564 | 987.4 | 390 | 4.0 | 2.5 | ✓ | PU | N 25518 E 59836 S |
| 9-9-94 | ORF-SS-4025 | 9-8-94 | 9-10-94 | 418 | 1121 | 766.3 | 556 | 2.0 | 1.4 | | PU | S/S 4'-5' Elev. 5301.2 |
| 10-10-94 | -13 | 9-8-94 | 9-10-94 | 574 | 1441 | 1024 | 543 | 2.7 | 1.9 | ✓ | WUW | N 25518 E 59836 S |

Site Correction Factor = 1.8

VP Correction Factor (if applicable) = 1.8

Count Time = 500 SEC., unless otherwise noted

COPY

REVIEWED BY:

John R. Farnell
Site HP Manager

OCS SAMPLE LOG

SITE NAME RIFLE, CO

| COUNT DATE INITIAL 20 DAY | SAMPLE ID & LOCATION | DATE SAMPLED | DATE SEALED | OCS # INITIAL 20 DAY | BI-214 pCi INITIAL 20 DAY | TI-208 pCi INITIAL 20 DAY | MASS (grams) WET DRY | Ra-226 pCi/g INITIAL/CORR 20 DAY | Th-232 pCi/g INITIAL 20 DAY | DEPTH <15cm >15cm | TECH INITIAL 20 DAY | COMMENTS |
|---------------------------|----------------------|--------------|-------------|----------------------|---------------------------|---------------------------|----------------------|----------------------------------|-----------------------------|-------------------|---------------------|------------------------|
| | | | | | | | | | | | | |
| 9-9-94 | ORF-SS-4026 | 9-8-94 | 9-10-94 | 520 | 5979 | 1101 | 475 | 12.6 | 2.3 | | PU | S/S 6'-7' Elev. 5301.2 |
| 10-10-94 | -13 | 9-8-94 | 9-10-94 | 476 | 7828 | 970.0 | 467 | 16.8 | 2.1 | ✓ | WUW | N 25518 E 59836 S |
| 9-9-94 | ORF-SS-4027 | 9-8-94 | 9-10-94 | 420 | 1265 | 835.9 | 560 | 2.3 | 1.5 | | PU | S/S 5'-6' Elev. 5301.2 |
| 10-6-94 | -13 | 9-8-94 | 9-10-94 | 534 | 1475 | 996.0 | 547 | 2.7 | 1.8 | ✓ | PU | N 25518 E 59836 S |
| 9-9-94 | ORF-SS-4028 | 9-8-94 | 9-10-94 | 522 | 1376 | 804.1 | 572 | 2.4 | 1.4 | | PU | S/S 0'-1' Elev. 5302.1 |
| 10-10-94 | -15 | 9-8-94 | 9-10-94 | 480 | 2181 | 777.7 | 528 | 4.1 | 1.5 | ✓ | WUW | N 25550 E 59984 Q |
| 9-9-94 | ORF-SS-4029 | 9-8-94 | 9-10-94 | 422 | 1849 | 748.8 | 529 | 3.5 | 1.4 | | PU | S/S 1'-2' Elev. 5302.1 |
| 10-10-94 | -15 | 9-8-94 | 9-10-94 | 580 | 2866 | 851.9 | 493 | 5.8 | 1.7 | ✓ | WUW | N 25550 E 59984 Q |
| 9-9-94 | ORF-SS-4030 | 9-8-94 | 9-10-94 | 524 | 1860 | 976.4 | 576 | 3.2 | 1.7 | | PU | S/S 2'-3' Elev. 5302.1 |
| 10-10-94 | -15 | 9-8-94 | 9-10-94 | 482 | 2504 | 1049 | 543 | 4.6 | 1.9 | ✓ | WUW | N 25550 E 59984 Q |
| 9-9-94 | ORF-SS-4031 | 9-8-94 | 9-10-94 | 424 | 7840 | 1036 | 654 | 1.2 | 1.6 | | PU | S/S 4'-5' Elev. 5302.1 |
| 10-10-94 | -15 | 9-8-94 | 9-10-94 | 582 | 838.5 | 995.5 | 633 | 1.3 | 1.6 | ✓ | WUW | N 26650 E 59984 Q |
| 9-9-94 | ORF-SS-4032 | 9-8-94 | 9-10-94 | 526 | 1018 | 1110 | 600 | 1.7 | 1.9 | | PU | S/S 3'-4' Elev. 5302.1 |
| 10-7-94 | -15 | 9-8-94 | 9-10-94 | 444 | 1432 | 935.0 | 581 | 2.5 | 1.6 | ✓ | PU | N 25550 E 59984 Q |
| 9-9-94 | ORF-SS-4033 | 9-8-94 | 9-10-94 | 426 | 1015 | 696.6 | 323 | 3.1 | 2.2 | | PU | S/S 5'-6' Elev. 5302.1 |
| 10-6-94 | -15 | 9-8-94 | 9-10-94 | 546 | 1243 | 737.1 | 314 | 4.3 | 2.3 | ✓ | PU | N 25550 E 59984 Q |
| 9-9-94 | ORF-SS-4034 | 9-8-94 | 9-10-94 | 528 | 6421 | 986.0 | 517 | 12.4 | 1.9 | | PU | S/S 6'-7' Elev. 5302.1 |
| 10-7-94 | -15 | 9-8-94 | 9-10-94 | 512 | 8097 | 918.9 | 508 | 15.9 | 1.8 | ✓ | PU | N 25550 E 59984 Q |
| 9-9-94 | ORF-SS-4035 | 9-8-94 | 9-10-94 | 428 | 6228 | 801.1 | 567 | 1.1 | 1.4 | | 83 | S/S 0'-1' Elev. 5302.2 |
| 10-10-94 | -8 | 9-8-94 | 9-10-94 | 484 | 748.3 | 821.4 | 516 | 1.5 | 1.6 | ✓ | WUW | N 25428 E 59456 X |

Site Correction Factor = 1.8
 VP Correction Factor (if applicable) = 1.8
 Count Time = 500 SEC. unless otherwise noted

VIEWED BY: John H. [Signature]
 Site HP Manager

COPY

OCS SAMPLE LOG

SITE NAME RIFE

| COUNT DATE INITIAL 20 DAY | SAMPLE ID & LOCATION | DATE SAMPLED | DATE SEALED | OCS # INITIAL 20 DAY | BI-214 pCi INITIAL 20 DAY | TI-208 pCi INITIAL 20 DAY | MASS (grams) WET DRY | Re-226 pCi/g INITIAL 20 DAY | TR-232 pCi/g INITIAL 20 DAY | DEPTH <15cm >15cm | TECH INITIAL 20 DAY | COMMENTS |
|---------------------------|----------------------|--------------|-------------|----------------------|---------------------------|---------------------------|----------------------|-----------------------------|-----------------------------|-------------------|---------------------|----------------------------------------------|
| 9-9-94 | ORF-SS-4036 | 9-8-94 | 9-10-94 | 530 | 3309 | 1063 | 636 | 5.2 | 1.7 | | 95 | 5'± 1'-2' Elev 5302.2 N 25428 E 59456 |
| 10-6-94 | -8 | 9-9-94 | | 446 | 4421 | 1031 | 614 | 7.2 | 1.7 | | 70U | X |
| 9-9-94 | RFL-SE-4037 | 9-9-94 | | 490 | 3171 | 888.2 | 498 | 6.4 | 1.8 | | 95 | 2+95, 0+92 |
| N/A | VP 500 | | | | | A | | | | | | |
| 9-9-94 | RFL-SE-4038 | 9-9-94 | | 532 | 2872 | 1149 | 485 | 5.9 | 2.4 | | 45 | 0 36"-40" 3+10, 0+90 |
| N/A | VP 500 | | | | | A | | | | | | |
| 9-9-94 | RFL-SE-4039 | 9-9-94 | | 432 | 3531 | 975.2 | 462 | 7.6 | 2.1 | | 95 | 0 29"-30" 3+15, 0+80 |
| N/A | VP 500 | | | | | A | | | | | | |
| 9-9-94 | RFL-SE-4040 | 9-9-94 | | 594 | 4010 | 842.4 | 369 | 10.9 | 2.3 | | 95 | 3+05, 0+55 |
| N/A | VP 500 | | | | | A | | | | | | |
| 9-9-94 | RFL-SS-4041 | 9-9-94 | 9-10-94 | 536 | 1816 | 966.8 | 631 | 8.9 | 1.5 | | 95 | 5'± Hosp. hill rd. Camp. |
| 10-7-94 | #8 | 9-9-94 | | 450 | 2247 | 1022 | 595 | 3.9 | 1.7 | | 90U | |
| 9-9-94 | ORF-SS-4042 | 8-9-94 | 9-10-94 | 434 | 710.8 | 1080 | 625 | 1.1 | 1.7 | | 90U | 5'± 0'-3' Elev. 5302.2 N 25428 E 59456 |
| 10-10-94 | -8 | 9-9-94 | | 584 | 5426 | 1168 | 600 | 0.90 | 1.9 | | WRW | X |
| 9-9-94 | ORF-SS-4043 | 8-9-94 | 9-10-94 | 538 | 1092 | 1043 | 624 | 1.8 | 1.7 | | 90U | 5'± 3'-4' Elev. 5302.2 N 25428 E 59456 |
| 10-10-94 | -8 | 9-9-94 | | 486 | 1145 | 1057 | 610 | 1.9 | 1.7 | | WRW | X |
| 9-9-94 | ORF-SS-4044 | 8-9-94 | 9-10-94 | 436 | 1298 | 1071 | 495 | 26.2 | 2.2 | | 90U | 5'± 4'-5' Elev. 5302.2 N 25428 E 59456 |
| 10-10-94 | -8 | 9-9-94 | | 586 | 1938.5 | 1445 | 485 | 40.0 | 3.0 | | WRW | X |
| 9-9-94 | ORF-SS-4045 | 9-8-94 | 9-10-94 | 540 | 677.6 | 727.5 | 268 | 2.5 | 2.7 | | 90U | 5'± 0'-1' Elev. 5302.6 N 25411 E 59382 |
| 10-10-94 | -7 | 9-8-94 | | 488 | 866.6 | 515.6 | 745 | 3.5 | 2.1 | | WRW | Y |

REVIEWED BY: 
 Site HP Manager

COPY

Site Correction Factor = 1.8
 VP Correction Factor (if applicable) = 1.8
 Count Time = 500 Secs, unless otherwise noted

OCS SAMPLE LOG

SITE NAME RIFLE, CO

| COUNT DATE INITIAL 20 DAY | SAMPLE ID & LOCATION | DATE SAMPLED | DATE SEALED | OCS # INITIAL 20 DAY | BI-214 pCi INITIAL 20 DAY | TI-208 pCi INITIAL 20 DAY | MASS (grams) WET DRY | Ra-226 pCi/g INITIAL CORR. 20 DAY | Th-232 pCi/g INITIAL 20 DAY | DEPTH <15cm >15cm | TECH INITIAL 20 DAY | COMMENTS |
|---------------------------|-----------------------|--------------|-------------|----------------------|---------------------------|---------------------------|----------------------|-----------------------------------|-----------------------------|-------------------|---------------------|-----------------------------------------------|
| 9-9-94 N A | RFL-SE-4046 -VP500 | 9-9-94 | | 512 N | 3392 N | 1331 A | 459 | 7.4 | 2.9 | ✓ | YU | 1390 ACPTM 2+97, 0+95 |
| 9-9-94 N A | RFL-SE-4047 -VP500 | 9-9-94 | | 438 N | 2177 N | 1306 A | 460 | 4.7 | 2.8 | ✓ | YU | Δ CPTM 1150 3+10, 1+05 |
| 9-9-94 | ORF-SS-4048 | 9-8-94 | 9-10-94 | 544 | 1101 | 746.6 | 430 | 2.6 | 1.7 | ✓ | YU | YS 1'-2' Elev. 5302.6 N 25411 E 59382 Y |
| 10-6-94 | -7 | 9-8-94 | 9-10-94 | 434 | 1720 | 812.7 | 418 | 4.1 | 1.9 | ✓ | YU | YS 2'-3' Elev. 5302.6 N 25411 E 59382 Y |
| 9-9-94 | ORF-SS-4049 | 9-8-94 | 9-10-94 | 440 | 811.2 | 870.7 | 591 | 1.4 | 1.5 | ✓ | YU | YS 3'-4' Elev. 5302.6 N 25411 E 59382 Y |
| 10-7-94 | -7 | 9-8-94 | 9-10-94 | 446 | 1191 | 1005 | 570 | 2.1 | 1.8 | ✓ | YU | YS 0'+1' Elev. 5302.7 N 25535 E 59912 R |
| 9-9-94 | ORF-SS-4050 | 9-8-94 | 9-10-94 | 546 | 4441 | 670.1 | 399 | 11.1 | 1.7 | ✓ | YU | YS 1'-2' Elev. 5302.7 N 25535 E 59912 R |
| 10-10-94 | -7 | 9-8-94 | 9-10-94 | 588 | 6358 | 899.8 | 388 | 16.4 | 2.3 | ✓ | WUW | YS 1'-2' Elev. 5302.7 N 25535 E 59912 R |
| 9-9-94 | ORF-SS-4051 | 9-8-94 | 9-10-94 | 442 | 4472 | 1210 | 563 | 7.9 | 2.1 | ✓ | YU | YS 1'-2' Elev. 5302.7 N 25535 E 59912 R |
| 10-10-94 | -14 | 9-8-94 | 9-10-94 | 490 | 7045 | 882.6 | 532 | 13.2 | 1.7 | ✓ | WUW | YS 1'-2' Elev. 5302.7 N 25535 E 59912 R |
| 9-9-94 | ORF-SS-4052 | 9-8-94 | 9-10-94 | 548 | 1130 | 861.5 | 563 | 2.0 | 1.5 | ✓ | YU | YS 1'-2' Elev. 5302.7 N 25535 E 59912 R |
| 10-10-94 | -14 | 9-8-94 | 9-10-94 | 590 | 908.0 | 1072 | 540 | 1.7 | 2.0 | ✓ | WUW | YS 1'-2' Elev. 5302.7 N 25535 E 59912 R |
| 9-9-94 | ORF-SS-4053 | 9-8-94 | 9-10-94 | 444 | 19922 | 1524 | 589 | 33.8 | 2.6 | ✓ | YU | YS 2'-3' Elev. 5302.7 N 25535 E 59912 R |
| 10-10-94 | -14 | 9-8-94 | 9-10-94 | 492 | 28145 | 1538 | 567 | 49.6 | 2.7 | ✓ | WUW | YS 2'-3' Elev. 5302.7 N 25535 E 59912 R |
| 9-9-94 | ORF-SS-4054 | 9-8-94 | 9-10-94 | 550 | 1322 | 746.6 | 554 | 2.4 | 1.3 | ✓ | YU | YS 3'-4' Elev. 5302.7 N 25535 E 59912 R |
| 10-7-94 | -14 | 9-8-94 | 9-10-94 | 548 | 2090 | 899.7 | 542 | 3.9 | 1.7 | ✓ | YU | YS 3'-4' Elev. 5302.7 N 25535 E 59912 R |
| 9-9-94 | ORF-SS-4055 | 9-8-94 | 9-10-94 | 446 | 941.5 | 827.2 | 553 | 1.7 | 1.5 | ✓ | YU | YS 4'-5' Elev. 5302.7 N 25535 E 59912 R |
| 10-10-94 | -14 | 9-8-94 | 9-10-94 | 592 | 961.3 | 1015 | 540 | 1.8 | 1.9 | ✓ | WUW | YS 4'-5' Elev. 5302.7 N 25535 E 59912 R |

Site Correction Factor = 1.8
 VP Correction Factor (if applicable) = 1.8
 Count Time = 500 SEC. unless otherwise noted

REVIEWED BY: [Signature]
 Site Mgr Manager

COPY

OCS SAMPLE LOG

SITE NAME RIFLE CO

| COUNT DATE INITIAL 20 DAY | SAMPLE ID & LOCATION | DATE SAMPLED | DATE SEALED | OCS # INITIAL 20 DAY | BI-214 pCi INITIAL 20 DAY | TI-208 pCi INITIAL 20 DAY | MASS (grams) WET DRY | Ra-226 pCi/g INITIAL 20 DAY | Th-232 pCi/g INITIAL 20 DAY | DEPTH <15cm >15cm | TECH INITIAL 20 DAY | COMMENTS |
|---------------------------|----------------------|--------------|-------------|----------------------|---------------------------|---------------------------|----------------------|-----------------------------|-----------------------------|-------------------|---------------------|---------------------------------|
| 9-9-94 | ORF-SS-4056 | 9-8-94 | 9-10-94 | 552 | 1819 | 899.8 | 494 | 3.7 | 1.8 | | PO | S/S 5'-6" Elev. 5302.7 |
| 10-10-94 | -14 | | | 494 | 2140 | 821.4 | 482 | 4.4 | 1.7 | ✓ | WW | N 25535 E 59912 R |
| 9-9-94 | RFL-SE-4057 | 9-9-94 | | 448 | 3004 | 957.8 | 365 | 8.2 | 2.6 | ✓ | PO | 1+90, 1+80 |
| N A | VP 500 | | | | N | A | | | | | | |
| 9-9-94 | RFL-SE-4058 | 9-9-94 | | 554 | 4257 | 1015 | 469 | 9.1 | 2.2 | ✓ | PO | 3+05, 1+45 |
| N A | -VP 500 | | | | N | A | | | | | | |
| 9-9-94 | RFL-SE-4059 | 9-9-94 | | 450 | 2770 | 862.0 | 323 | 8.6 | 2.7 | ✓ | PO | 2+90, 0+50 1690 Δ.C.P.T.M |
| N A | -VP 500 | | | | N | A | | | | | | |
| 9-9-94 | ORF-SS-4060 | 9-8-94 | 9-10-94 | 556 | 3825 | 1177 | 533 | 7.2 | 2.2 | ✓ | PO | S/S 6'-7" Elev. 5302.7 |
| 10-10-94 | -14 | | | 594 | 6180 | 1120 | 520 | 11.9 | 2.2 | ✓ | WW | N 25535 E 59912 R |
| 9-9-94 | RFL-SS-4061 | 9-9-94 | 9-10-94 | 452 | 2474 | 992.6 | 721 | 3.4 | 1.4 | ✓ | PO | S/S hosp. hill rd. #10 @ 24" |
| 10-10-94 | RFL-SS-4062 | 9-9-94 | 9-10-94 | 496 | 3866 | 925.0 | 697 | 5.5 | 1.3 | ✓ | WW | S/S hosp. hill rd. #10 Comp. |
| 9-9-94 | RFL-SE-4063 | 9-9-94 | 9-10-94 | 558 | 1945 | 966.8 | 685 | 2.8 | 1.4 | ✓ | PO | Lilac 2 |
| N A | -VP 500 | | | 596 | 2996 | 871.1 | 663 | 4.5 | 1.3 | ✓ | WW | |
| 9-9-94 | RFL-SE-4064 | 9-9-94 | | 454 | 3443 | 975.2 | 390 | 8.8 | 2.5 | ✓ | PO | Lilac 1 |
| N A | -VP 500 | | | | N | A | | | | | | |
| 9-9-94 | RFL-SE-4065 | 9-9-94 | 9-10-94 | 560 | 4233 | 1292 | 448 | 9.4 | 2.9 | ✓ | PO | |
| 10-7-94 | - | 9-9-94 | 9-10-94 | 456 | 4974 | 940.4 | 608 | 8.2 | 1.5 | ✓ | PO | S/S hosp. hill rd. #9 @ 20" |
| 10-7-94 | - | 9-9-94 | 9-10-94 | 544 | 5423 | 1129 | 573 | 9.5 | 2.0 | ✓ | PO | |

Site Correction Factor = 1.8
 VP Correction Factor (if applicable) = 1.8
 Count Time = 500 SEC., unless otherwise noted

REVIEWED BY: *[Signature]*
 Site HP Manager

COPY

OCS SAMPLE LOG

SITE NAME RIFLE, CO

| COUNT DATE INITIAL 20 DAY | SAMPLE ID & LOCATION | DATE SAMPLED | DATE SEALED | OCS # INITIAL 20 DAY | BI-214 PCI INITIAL 20 DAY | TI-208 PCI INITIAL 20 DAY | MASS (grams) WET DRY | Ra-226 pCi/g INITIAL 20 DAY | Th-232 pCi/g INITIAL 20 DAY | DEPTH <15cm >15cm | TECH INITIAL 20 DAY | COMMENTS |
|---------------------------|----------------------|--------------|-------------|----------------------|---------------------------|---------------------------|----------------------|-----------------------------|-----------------------------|-------------------|---------------------|-----------------------------------------------|
| | | | | | | | | | | | | |
| 9-9-94 | RFL-SS-4066 | 9-9-94 | 9-10-94 | 562 | 1125 | 1005 | 646 | 1.7 | 1.6 | | PU | SB hosp. hill rd. #9 Comp. |
| 10-7-94 | | 9-9-94 | | 452 | 1681 | 1014 | 622 | 2.7 | 1.6 | ✓ | PU | |
| 9-10-94 | ORF-SS-4067 | | | 400 | 472.4 | 827.2 | 513 | 0.92 | 1.6 | | PU | SS 0'-1' Elev. 5302.8 N 25447 E 59537 W |
| 10-12-94 | -9 | 9-8-94 | 9-12-94 | 422 | 622.8 | 908.8 | 448 | 1.4 | 2.0 | ✓ | PU | |
| 9-10-94 | ORF-SS-4068 | | | 500 | 1289 | 459.5 | 411 | 3.1 | 1.1 | | PU | SS 1'-2' Elev. 5302.8 N 25447 E 59537 W |
| 10-12-94 | -9 | 9-8-94 | 9-12-94 | 554 | 1599 | 813.6 | 388 | 4.1 | 2.1 | ✓ | WUW | |
| 9-10-94 | ORF-SS-4069 | | | 402 | 2119 | 705.3 | 373 | 5.7 | 1.9 | | PU | SS 2'-3' Elev. 5302.8 N 25447 E 59537 W |
| 10-12-94 | -9 | 9-8-94 | 9-12-94 | 454 | 3866 | 865.1 | 357 | 10.8 | 2.4 | ✓ | WUW | |
| 9-10-94 | ORF-SS-4070 | | | 502 | 1684 | 708.4 | 497 | 3.4 | 1.4 | | PU | SS 3'-4' Elev. 5302.8 N 25447 E 59537 W |
| 10-12-94 | -9 | 9-8-94 | 9-12-94 | 528 | 1855 | 909.4 | 481 | 3.9 | 1.9 | ✓ | PU | |
| 9-10-94 | ORF-SS-4071 | | | 404 | 1329 | 792.4 | 359 | 36.6 | 2.2 | | PU | SS 4'-5' Elev. 5302.8 N 25447 E 59537 W |
| 10-12-94 | -9 | 9-8-94 | 9-12-94 | 562 | 19359 | 957.2 | 348 | 55.6 | 2.8 | ✓ | WUW | |
| 9-10-94 | ORF-SS-4072 | | | 504 | 1745 | 871.1 | 562 | 3.1 | 1.6 | | PU | SS 0'-1' Elev. 5303.3 N 25479 E 59674 U |
| 10-12-94 | -11 | 9-8-94 | 9-12-94 | 424 | 2069 | 1022 | 524 | 3.9 | 2.0 | ✓ | PU | |
| 9-10-94 | ORF-SS-4073 | | | 406 | 1548 | 792.4 | 493 | 3.1 | 1.6 | | PU | SS 1'-2' Elev. 5303.3 N 25479 E 59674 U |
| 10-12-94 | -11 | 9-8-94 | 9-12-94 | 530 | 2332 | 765.8 | 462 | 5.0 | 1.7 | ✓ | PU | |
| 9-10-94 | ORF-SS-4074 | | | 506 | 1332 | 574.3 | 244 | 5.5 | 2.4 | | PU | SS 2'-3' Elev. 5303.3 N 25479 E 59674 U |
| 10-12-94 | -11 | 9-8-94 | 9-12-94 | 456 | 1536 | 602.9 | 228 | 6.7 | 2.6 | ✓ | WUW | |
| 9-10-94 | ORF-SS-4075 | | | 408 | 13620 | 5756 | 511 | 267.6 | 11.3 | | PU | SS 3'-4' Elev. 5303.3 N 25479 E 59674 U |
| 10-12-94 | -11 | 9-8-94 | 9-12-94 | 564 | 18060 | 7332 | 504 | 358.3 | 14.5 | ✓ | PU | |

Site Correction Factor = 1.8
 VP Correction Factor (if applicable) = 1.8
 Count Time = 500 SEC, unless otherwise noted

COPY

REVIEWED BY: [Signature]
 Site HR Manager

OCS SAMPLE LOG

RIFLE, CO

| COUNT DATE INITIAL 20 DAY | SAMPLE ID & LOCATION | DATE SAMPLED | DATE SEALED | OCS # INITIAL 20 DAY | BI-214 pCi INITIAL 20 DAY | TI-208 pCi INITIAL 20 DAY | MASS (grams) WET DRY | Pa-226 pCi/g INITIAL/CORR 20 DAY | Tb-232 pCi/g INITIAL 20 DAY | DEPTH <15cm >15cm | TECH INITIAL 20 DAY | COMMENTS |
|---------------------------|----------------------|--------------|-------------|----------------------|---------------------------|---------------------------|----------------------|----------------------------------|-----------------------------|-------------------|---------------------|----------------------------------------------|
| 9-10-94 | ORF-SS-4076 | 9-8-94 | 9-12-94 | 508 | 10659 | 1063 | 499 | 21.4 | 2.1 | - | YU | S/S 4'-5' Elev. 53033 N 25479 E 59674 |
| 10-12-94 | -11 | 9-8-94 | 9-12-94 | 458 | 14946 | 1320 | 481 | 31.1 | 2.7 | - | YU | U |
| 9-10-94 | ORF-SS-4077 | 9-8-94 | 9-12-94 | 410 | 1077 | 766.3 | 566 | 1.9 | 1.4 | ✓ | YU | S/S 0'-11' Elev. 53036 N 25464 E 59608 |
| 10-12-94 | -10 | 9-8-94 | 9-12-94 | 460 | 1323 | 917.5 | 536 | 2.5 | 1.7 | ✓ | YU | ✓ |
| 9-10-94 | ORF-SS-4078 | 9-8-94 | 9-12-94 | 510 | 715.8 | 871.1 | 598 | 1.2 | 1.5 | - | YU | S/S 1'-2' Elev. 53036 N 25464 E 59608 |
| 10-12-94 | -10 | 9-8-94 | 9-12-94 | 566 | 967.7 | 1110 | 565 | 1.7 | 2.0 | ✓ | YU | ✓ |
| 9-10-94 | ORF-SS-4079 | 9-8-94 | 9-12-94 | 412 | 1204 | 1054 | 583 | 2.1 | 1.8 | - | YU | S/S 2'-3' Elev. 53036 N 25464 E 59608 |
| 10-12-94 | -10 | 9-8-94 | 9-12-94 | 462 | 1630 | 1154 | 562 | 2.9 | 2.1 | ✓ | YU | ✓ |
| 9-10-94 | ORF-SS-4080 | 9-8-94 | 9-12-94 | 512 | 970.9 | 622.3 | 502 | 1.9 | 1.2 | - | YU | S/S 3'-4' Elev. 53036 N 25464 E 59608 |
| 10-12-94 | -10 | 9-8-94 | 9-12-94 | 568 | 766.5 | 880.7 | 488 | 1.6 | 1.8 | ✓ | YU | ✓ |
| 9-10-94 | ORF-SS-4081 | 9-8-94 | 9-12-94 | 414 | 924.8 | 862.0 | 586 | 1.6 | 1.5 | - | YU | S/S 4'-5' Elev. 53036 N 25464 E 59608 |
| 10-12-94 | -10 | 9-8-94 | 9-12-94 | 464 | 1134 | 1215 | 575 | 2.0 | 2.1 | ✓ | YU | ✓ |
| 9-10-94 | ORF-SS-4082 | 9-8-94 | 9-12-94 | 514 | 536.2 | 1072 | 567 | 0.95 | 1.9 | - | YU | S/S 0'-1' Elev. 53037 N 25499 E 59762 |
| 10-12-94 | -12 | 9-8-94 | 9-12-94 | 570 | 715.1 | 966.8 | 503 | 1.4 | 1.9 | - | YU | T |
| 9-10-94 | ORF-SS-4083 | 9-8-94 | 9-12-94 | 416 | 673.6 | 801.1 | 423 | 1.6 | 1.9 | - | YU | S/S 1'-2' Elev. 53037 N 25499 E 59762 |
| 10-12-94 | -12 | 9-8-94 | 9-12-94 | 466 | 888.9 | 690.3 | 382 | 2.3 | 1.8 | ✓ | WNW | T |
| 9-10-94 | ORF-SS-4084 | 9-8-94 | 9-12-94 | 576 | 2057 | 938.1 | 547 | 3.8 | 1.7 | - | YU | S/S 2'-3' Elev. 53037 N 25499 E 59762 |
| 10-12-94 | -12 | 9-8-94 | 9-12-94 | 426 | 2489 | 952.5 | 521 | 4.8 | 1.8 | ✓ | WNW | T |
| 9-10-94 | ORF-SS-4085 | 9-8-94 | 9-12-94 | 418 | 1373 | 740.1 | 460 | 3.0 | 1.6 | - | YU | S/S 3'-4' Elev. 53037 N 25499 E 59762 |
| 10-12-94 | -12 | 9-8-94 | 9-12-94 | 532 | 2231 | 871.1 | 442 | 5.0 | 2.0 | ✓ | WNW | T |

Site Correction Factor = 1.8
 VP Correction Factor (if applicable) = 1.8
 Count Time = 500 SEC. unless otherwise noted

REVIEWED BY: *[Signature]*
 Site HP Manager

COPY

OCS SAMPLE LOG

SITE NAME RIFLECO

| COUNT DATE INITIAL 20 DAY | SAMPLE ID & LOCATION | DATE SAMPLED | DATE SEALED | OCS # INITIAL 20 DAY | BI-214 pCi INITIAL 20 DAY | TI-208 pCi INITIAL 20 DAY | MASS (grams) WET DRY | Ra-226 pCi/g INITIAL/CORR. 20 DAY | Th-232 pCi/g INITIAL 20 DAY | DEPTH <15cm >15cm | TECH INITIAL 20 DAY | COMMENTS |
|---------------------------|----------------------|--------------|-------------|----------------------|---------------------------|---------------------------|----------------------|-----------------------------------|-----------------------------|-------------------|---------------------|---------------------------------------------|
| | | | | | | | | | | | | |
| 9-10-94 | ORF-SS-4086 | 9-8-94 | 9-12-94 | 518 | 5821 | 986.0 | 500 | 11.6 | 2.0 | | PU | 9S 4'-5' Elev. 5303.7 N 25499 E 59762 |
| 10-12-94 | -12 | 9-8-94 | 9-12-94 | 488 | 7453 | 1024 | 488 | 15.3 | 2.1 | ✓ | W/W | I |
| 9-10-94 | ORF-SS-4087 | 9-8-94 | 9-12-94 | 420 | 11849 | 896.9 | 427 | 27.2 | 2.1 | ✓ | PU | 9S 3'-4' Elev. 5305.1 N 25673 E 60589 |
| 10-12-94 | -23 | 9-8-94 | 9-12-94 | 534 | 19633 | 1197 | 411 | 47.8 | 2.9 | ✓ | W/W | I |
| 9-10-94 | ORF-SS-4088 | 9-8-94 | 9-12-94 | 520 | 8570 | 1149 | 329 | 26.0 | 3.5 | ✓ | PU | 9S 4'-5' Elev. 5305.1 N 25693 E 60589 |
| 10-12-94 | -23 | 9-8-94 | 9-12-94 | 428 | 11105 | 1223 | 318 | 34.9 | 3.8 | ✓ | W/W | I |
| 9-10-94 | ORF-SS-4089 | 9-8-94 | 9-12-94 | 422 | 11209 | 992.6 | 509 | 22.0 | 2.0 | ✓ | PU | 9S 5'-6' Elev. 5305.1 N 25693 E 60589 |
| 10-12-94 | -23 | 9-8-94 | 9-12-94 | 536 | 21011 | 1618 | 479 | 43.9 | 3.4 | ✓ | W/W | I |
| 9-10-94 | ORF-SS-4090 | 9-8-94 | 9-12-94 | 522 | 7314 | 890.2 | 602 | 1.2 | 1.5 | ✓ | PU | 9S 0'-1' Elev. 5305.2 N 25602 E 60216 |
| 10-12-94 | -18 | 9-8-94 | 9-12-94 | 430 | 791.2 | 803.9 | 526 | 1.5 | 1.5 | ✓ | W/W | N |
| 9-10-94 | ORF-SS-4091 | 9-8-94 | 9-12-94 | 424 | 7677 | 687.9 | 247 | 31.1 | 2.8 | ✓ | PU | 9S 4'-5' Elev. 5305.2 N 25637 E 60348 |
| 10-12-94 | -20 | 9-8-94 | 9-12-94 | 540 | 11080 | 737.1 | 230 | 48.2 | 3.2 | ✓ | W/W | L |
| 9-10-94 | ORF-SS-4092 | 9-8-94 | 9-12-94 | 540 | 1377 | 1034 | 524 | 2.6 | 2.0 | ✓ | PU | 9S 5'-6' Elev. 5305.2 N 25602 E 60216 |
| 10-12-94 | -18 | 9-8-94 | 9-12-94 | 574 | 1411 | 899.8 | 513 | 2.8 | 1.8 | ✓ | W/W | N |
| 9-10-94 | ORF-SS-4093 | 9-8-94 | 9-12-94 | 426 | 6967 | 1167 | 548 | 12.7 | 2.1 | ✓ | PU | 9S 3'-4' Elev. 5306.2 N 25619 E 60282 |
| 10-12-94 | -19 | 9-8-94 | 9-12-94 | 434 | 9784 | 1372 | 537 | 18.2 | 2.6 | ✓ | W/W | M |
| 9-10-94 | ORF-SS-4094 | 9-8-94 | 9-12-94 | 526 | 2715 | 1158 | 378 | 7.2 | 3.1 | ✓ | PU | 9S 1'-2' Elev. 5306.3 N 25657 E 60436 |
| 10-12-94 | -21 | 9-8-94 | 9-12-94 | 542 | 4869 | 861.5 | 347 | 14.0 | 2.5 | ✓ | W/W | K |
| 9-10-94 | ORF-SS-4095 | 9-8-94 | 9-12-94 | 428 | 8085 | 731.4 | 568 | 1.4 | 1.3 | ✓ | PU | 9S 0'-1' Elev. 5306.4 N 25729 E 60736 |
| 10-12-94 | -25 | 9-8-94 | 9-12-94 | 436 | 766.5 | 1162 | 553 | 1.4 | 2.1 | ✓ | W/W | G |

Site Correction Factor = 1.8

VP Correction Factor (if applicable) = 1.8

Count Time = 500 SEC., unless otherwise noted

COPY

REVIEWED BY:

Robert A. Tamm
Site HP Manager

OCS SAMPLE LOG

SITE NAME RIFLE, CO

| COUNT DATE INITIAL 20 DAY | SAMPLE ID & LOCATION | DATE SAMPLED | DATE SEALED | OCS # | BI-214 pCi INITIAL 20 DAY | TI-208 pCi INITIAL 20 DAY | MASS (grams) WET DRY | Re-226 pCi/g INITIAL 20 DAY | Th-232 pCi/g INITIAL 20 DAY | DEPTH <15cm >15cm | TECH INITIAL 20 DAY | COMMENTS |
|---------------------------|----------------------|--------------|-------------|-------|---------------------------|---------------------------|----------------------|-----------------------------|-----------------------------|-------------------|---------------------|------------------------|
| | | | | | | | | | | | | |
| 9-10-94 | ORF-SS-4096 | 9-8-94 | 9-12-94 | 528 | 41357 | 2479 | 530 | 89.4 | 4.7 | | YU | S/S 3'-4' Elev. 5306.4 |
| 10-12-94 | -25 | 9-8-94 | | 468 | 85474 | 3312 | 512 | 106.9 | 6.5 | ✓ | WUW | N 25729 E 60736 |
| 9-10-94 | ORF-SS-4097 | 9-8-94 | 9-12-94 | 430 | 40598 | 1289 | 504 | 80.6 | 2.6 | | YU | S/S 4'-5' Elev. 5306.4 |
| 10-12-94 | -25 | 9-8-94 | | 544 | 61806 | 2489 | 475 | 130.1 | 5.2 | ✓ | WUW | N 25729 E 60736 |
| 9-10-94 | ORF-SS-4098 | 9-8-94 | 9-12-94 | 530 | 40234 | 3300 | 389 | 102.9 | 5.7 | | YU | S/S 6'-7' Elev. 5306.4 |
| 10-12-94 | -25 | 9-8-94 | | 438 | 64253 | 3076 | 376 | 170.9 | 8.2 | ✓ | WUW | N 25729 E 60736 |
| 9-10-94 | ORF-SS-4099 | 9-8-94 | 9-12-94 | 432 | 142160 | 5190 | 579 | 237.3 | 8.7 | | YU | S/S 7'-8' Elev. 5306.4 |
| 10-12-94 | -25 | 9-8-94 | | 576 | 204250 | 10826 | 592 | 446.4 | 18.3 | ✓ | WUW | N 25729 E 60736 |
| 9-10-94 | ORF-SS-4100 | 9-8-94 | 9-12-94 | 522 | 6896 | 813.6 | 521 | 13.2 | 1.6 | | YU | S/S 0'-1' Elev. 5307.5 |
| 10-12-94 | -24 | 9-8-94 | | 546 | 10837 | 1273 | 440 | 24.6 | 2.9 | ✓ | WUW | N 25707 E 60668 |
| 9-10-94 | ORF-SS-4101 | 9-8-94 | 9-12-94 | 434 | 4295 | 1219 | 546 | 7.9 | 2.2 | | YU | S/S 4'-5' Elev. 5307.5 |
| 10-12-94 | -24 | 9-8-94 | | 440 | 6595 | 1031 | 534 | 12.4 | 1.9 | ✓ | WUW | N 25707 E 60668 |
| 9-10-94 | ORF-SS-4102 | 9-8-94 | 9-12-94 | 534 | 29419 | 1618 | 373 | 78.9 | 4.3 | | YU | S/S 5'-6' Elev. 5307.5 |
| 10-12-94 | -24 | 9-8-94 | | 470 | 41616 | 2639 | 360 | 115.6 | 7.3 | ✓ | WUW | N 25707 E 60668 |
| 9-10-94 | ORF-SS-4103 | 9-8-94 | 9-12-94 | 436 | 623.6 | 1202 | 512 | 1.2 | 2.3 | | YU | S/S 0'-1' Elev. 5306.4 |
| 10-12-94 | -22 | 9-8-94 | | 578 | 1199 | 928.5 | 505 | 2.4 | 1.8 | ✓ | WUW | N 25675 E 60523 |
| 9-10-94 | ORF-SS-4104 | 9-8-94 | 9-12-94 | 536 | 6203 | 813.6 | 481 | 12.9 | 1.7 | | YU | S/S 1'-2' Elev. 5305.1 |
| 10-12-94 | -23 | 9-8-94 | | 548 | 10255 | 909.4 | 426 | 24.1 | 2.1 | ✓ | WUW | N 25673 E 60589 |
| 9-10-94 | ORF-SS-4105 | 9-8-94 | 9-12-94 | 438 | 40672 | 2429 | 567 | 71.7 | 4.3 | | YU | S/S 0'-1' Elev. 5305.5 |
| 10-12-94 | -16 | 9-8-94 | | 472 | 64529 | 3111 | 458 | 140.9 | 6.8 | ✓ | WUW | N 25571 E 60064 |

Site Correction Factor = 1.8
 VP Correction Factor (if applicable) = 1.8
 Count Time = 500 SEC., unless otherwise noted

REVIEWED BY: *John R. Tancil*
 Site HP Manager

COPY
 F5-IN-001-1, Rev. 1

Count Time = 500 SEC, unless otherwise noted

VP Correction Factor (if applicable) = 1.8

Site Correction Factor = 1.8

REVIEWED BY: *[Signature]*

COPY

Site HPI Manager

| COUNT | INITIAL | DATE | 20 DAY | INITIAL | DATE | 20 DAY | SEATED | DATE | SAMPLED | DATE | SAMPLED | LOCATION | 20 DAY | INITIAL | DATE | 20 DAY | COMMENTS |
|----------|-------------|---------|---------|---------|-------|--------|--------|-------|---------|------|---------|---------------------------------|--------|---------|------|--------|----------|
| 9-10-94 | ORF-SS-4106 | 9-8-94 | 9-12-94 | 538 | 59910 | 2470 | 537 | 111.6 | 4.6 | ✓ | WWD | S/S 1'-2' ELEV. 5303.5 | | | | | |
| 10-12-94 | -16 | 9-8-94 | 9-12-94 | 442 | 91284 | 3495 | 457 | 199.8 | 7.6 | ✓ | WWD | S/S 2'-3' ELEV. 5303.5 | | | | | |
| 9-10-94 | ORF-SS-4107 | 9-8-94 | 9-12-94 | 440 | 2317 | 731.4 | 369 | 6.3 | 2.0 | ✓ | WWD | S/S 2'-3' ELEV. 5303.5 | | | | | |
| 10-12-94 | -16 | 9-8-94 | 9-12-94 | 550 | 2483 | 670.1 | 353 | 7.0 | 1.9 | ✓ | WWD | S/S 2'-3' ELEV. 5303.5 | | | | | |
| 9-10-94 | ORF-SS-4108 | 9-8-94 | 9-12-94 | 540 | 17918 | 1321 | 591 | 30.3 | 2.2 | ✓ | WWD | S/S 3'-4' ELEV. 5303.5 | | | | | |
| 10-12-94 | -16 | 9-8-94 | 9-12-94 | 580 | 24853 | 1646 | 568 | 44.5 | 3.9 | ✓ | WWD | S/S 4'-5' ELEV. 5303.5 | | | | | |
| 9-10-94 | ORF-SS-4109 | 9-8-94 | 9-12-94 | 442 | 1551 | 931.7 | 495 | 3.1 | 1.9 | ✓ | WWD | S/S 4'-5' ELEV. 5303.5 | | | | | |
| 10-12-94 | -16 | 9-8-94 | 9-12-94 | 444 | 2523 | 1049 | 484 | 5.2 | 2.2 | ✓ | WWD | S/S 5'-6' ELEV. 5303.5 | | | | | |
| 9-10-94 | ORF-SS-4110 | 9-8-94 | 9-12-94 | 542 | 1230 | 756.2 | 319 | 3.9 | 2.4 | ✓ | WWD | S/S 5'-6' ELEV. 5303.5 | | | | | |
| 10-12-94 | -16 | 9-8-94 | 9-12-94 | 446 | 2164 | 644.1 | 311 | 7.0 | 2.1 | ✓ | WWD | S/S 0'-1' ELEV. 5305.1 | | | | | |
| 9-10-94 | ORF-SS-4111 | 9-8-94 | 9-12-94 | 444 | 8990 | 1184 | 519 | 17.3 | 2.3 | ✓ | WWD | S/S 0'-1' ELEV. 5305.1 | | | | | |
| 10-12-94 | -23 | 9-8-94 | 9-12-94 | 552 | 16317 | 1331 | 437 | 37.3 | 3.0 | ✓ | WWD | S/S 2'-3' ELEV. 5305.1 | | | | | |
| 9-10-94 | ORF-SS-4112 | 9-8-94 | 9-12-94 | 544 | 8405 | 813.6 | 315 | 26.7 | 2.6 | ✓ | WWD | S/S 2'-3' ELEV. 5305.1 | | | | | |
| 10-12-94 | -23 | 9-8-94 | 9-12-94 | 448 | 13185 | 1066 | 290 | 47.5 | 3.7 | ✓ | WWD | S/S 2'-3' ELEV. 5305.1 | | | | | |
| 9-12-94 | ORF-SS-4113 | 9-12-94 | 9-12-94 | 500 | 3639 | 1503 | 464 | 7.8 | 3.2 | ✓ | WWD | 3+10, 1+40 | | | | | |
| 9-12-94 | RFL-SE-4114 | 9-12-94 | 9-12-94 | 400 | 4781 | 1088 | 415 | 11.5 | 2.6 | ✓ | WWD | 2+95, 1+55 | | | | | |
| 9-12-94 | ORF-SS-4115 | 9-12-94 | 9-12-94 | 502 | 6358 | 957.2 | 748 | 0.85 | 1.3 | ✓ | WWD | Area E 30' N of middle haul rd. | | | | | |
| 10/13/94 | *1 | 9-12-94 | 9/13/94 | 518 | 504.8 | 708.4 | 728 | 0.69 | 0.97 | ✓ | WWD | | | | | | |

OCS SAMPLE LOG

RIFLE CO

SITE NAME

OCS SAMPLE LOG

SITE NAME RIFLECO

| COUNT DATE INITIAL 20 DAY | SAMPLE ID DATE & LOCATION | DATE SAMPLED | DATE SEALED | OCS # INITIAL 20 DAY | BI-214 pCi INITIAL 20 DAY | TI-208 pCi INITIAL 20 DAY | MASS (grams) WET DRY | Ra-226 pCi/g INITIAL/CORR. 20 DAY | Th-232 pCi/g INITIAL 20 DAY | DEPTH <15cm >15cm | TECH INITIAL 20 DAY | COMMENTS |
|---------------------------|---------------------------|--------------|-------------|----------------------|---------------------------|---------------------------|----------------------|-----------------------------------|-----------------------------|-------------------|---------------------|----------------------------------------------------|
| 9-12-94 | ORF-SS-4116 | 9-12-94 | 9-13-94 | 402 | 714.0 | 582 | 582 | 1.7 | 1.2 | | PU | Area E 35' N. of middle haul rd. |
| 10-13-94 | #2 | 9-12-94 | | 464 | 465.5 | 576.7 | 566 | 0.82 | 1.0 | ✓ | W/W | |
| 9-12-94 | ORF-SS-4117 | 9-8-94 | 9-13-94 | 404 | 2550 | 696.6 | 480 | 5.3 | 1.5 | | PU | 7/5 3'-4' Elev. 5305.2 N 25585 E 60143 |
| 10-13-94 | -17 | 9-8-94 | | 566 | 3356 | 1005 | 471 | 6.9 | 2.1 | ✓ | PU | |
| 9-12-94 | ORF-SS-4118 | 9-8-94 | 9-13-94 | 504 | 979.1 | 851.9 | 359 | 2.7 | 2.4 | | PU | 7/5 0'-1' Elev. 5305.2 N 25585 E 60143 |
| 10-13-94 | -17 | 9-8-94 | | 466 | 1848 | 471.9 | 320 | 5.8 | 1.5 | ✓ | PU | |
| 9-12-94 | ORF-SS-4119 | 9-8-94 | 9-13-94 | 406 | 746.9 | 661.8 | 612 | 1.2 | 1.1 | | PU | 7/5 1'-2' Elev. 5305.2 N 25585 E 60143 |
| 10-13-94 | -17 | 9-8-94 | | 468 | 992.9 | 996.2 | 582 | 1.7 | 1.7 | ✓ | PU | |
| 9-12-94 | ORF-SS-4120 | 9-8-94 | 9-13-94 | 506 | 626.6 | 1034 | 539 | 1.2 | 1.9 | | PU | 7/5 2'-3' Elev. 5305.2 N 25585 E 60143 |
| 10-13-94 | -17 | 9-8-94 | | 568 | 1002 | 986.0 | 526 | 1.9 | 1.9 | ✓ | PU | |
| 9-12-94 | ORF-SS-4121 | 9-8-94 | 9-13-94 | 408 | 3927 | 1210 | 515 | 7.6 | 2.3 | | PU | 7/5 3'-4' Elev. 5305.2 N 25637 E 60348 |
| 10-13-94 | -20 | 9-8-94 | | 470 | 5329 | 952.5 | 505 | 10.6 | 1.9 | ✓ | PU | |
| 9-12-94 | ORF-SS-4122 | 9-8-94 | 9-13-94 | 508 | 659.1 | 986.0 | 478 | 1.4 | 2.1 | | PU | 7/5 4'-5' Elev. 5305.2 N 22400 25585 E 60143 |
| 10-13-94 | -17 | 9-8-94 | | 570 | 1163 | 717.9 | 463 | 2.5 | 1.6 | ✓ | PU | |
| 9-12-94 | RF-SE-4123 | 9-12-94 | | 410 | 4505 | 1028 | 372 | 12.1 | 2.8 | | PU | Lilac 3 @48"-54" 1610 ΔOPTI 3+00, 1+40 |
| 9-12-94 | BFL-SE-4124 | 9-12-94 | | 510 | 3581 | 1063 | 402 | 8.9 | 2.6 | ✓ | PU | |
| 9-12-94 | ORF-SS-4125 | 9-12-94 | | 412 | 739.3 | 740.1 | 506 | 1.5 | 1.5 | | PU | 7/5 1'-2' Elev. 5305.2 N 25602 E 60216 |
| 10-13-94 | -18 | 9-8-94 | 9-13-94 | 472 | 668.8 | 716.5 | 472 | 1.4 | 1.5 | ✓ | PU | |

Site Correction Factor = 1.8
 VP Correction Factor (if applicable) = 1.8
 Count Time = 500 SEC, unless otherwise noted

REVIEWED BY: *[Signature]*
 Site RP Manager

COPY

OCS SAMPLE LOG

SITE NAME RIFLECO

| COUNT DATE INITIAL 20 DAY | SAMPLE ID & LOCATION | DATE SAMPLED | DATE SEALED | OCS # INITIAL 20 DAY | BI-214 pCi INITIAL 20 DAY | TI-208 pCi INITIAL 20 DAY | MASS (grams) WET DRY | Re-226 pCi/g INITIAL 20 DAY | Th-232 pCi/g INITIAL 20 DAY | DEPTH <15cm >15cm | TECH INITIAL 20 DAY | COMMENTS |
|---------------------------|----------------------|--------------|-------------|----------------------|---------------------------|---------------------------|----------------------|-----------------------------|-----------------------------|-------------------|---------------------|---------------------------|
| 9-12-94 | ORF-SS-4126 | 9-8-94 | 9-13-94 | 512 | 488.8 | 1005 | 454 | 1.1 | 2.2 | | 9U | 9/5 2'-3' Elev. 5305.2 |
| 10-13-94 | -18 | 9-8-94 | 9-13-94 | 572 | 405.1 | 928.5 | 439 | 0.92 | 2.1 | ✓ | 9U | N 25602 E 60216 N |
| 9-12-94 | RFL-SE-4127 | 9-12-94 | | 514 | 537.1 | 1306 | 432 | 12.4 | 2.8 | ✓ | 9U | S.W. Deck Composite |
| N A | -VP500 | 9-12-94 | | | | A | | | | | | |
| 9-12-94 | RFL-SE-4128 | 9-12-94 | | 424 | 185.1 | 1254 | 534 | 3.5 | 2.3 | ✓ | 9U | 1100 ΔCPTM 3+05, 1+35 |
| N A | -VP500 | 9-12-94 | | | | A | | | | | | |
| 9-12-94 | RFL-SE-4129 | 9-12-94 | | 528 | 1734.0 | 1225 | 404 | 42.9 | 3.0 | ✓ | 9U | 1960 ΔCPTM 3+00, 1+25 |
| N A | -VP500 | 9-12-94 | | | | A | | | | | | |
| 9-12-94 | RFL-SE-4130 | 9-12-94 | | 426 | 248.1 | 1302 | 476 | 5.2 | 2.5 | ✓ | 9U | NE Corner Grid 1 |
| N A | -VP500 | 9-12-94 | | | | A | | | | | | |
| 9-12-94 | RFL-SE-4131 | 9-12-94 | | 438 | 2729 | 1079 | 482 | 5.7 | 2.1 | ✓ | 9U | 2+80, 1+55 10-20 ΔCPTM |
| N A | -VP500 | 9-12-94 | | | | A | | | | | | |
| 9-12-94 | RFL-SS-4132 | 9-12-94 | 9-13-94 | 474 | 421.4 | 748.8 | 518 | 8.1 | 1.4 | ✓ | 9U | 4+55, 0+2R |
| 10-13-94 | -VP500 | 9-12-94 | | 474 | 648.3 | 777.7 | 499 | 13.0 | 1.6 | ✓ | WUW | 4+30, 0+6R |
| 9-12-94 | RFL-SS-4133 | 9-12-94 | 9-13-94 | 572 | 721.4 | 871.1 | 508 | 14.2 | 1.7 | ✓ | 9U | |
| 10-13-94 | -VP500 | 9-12-94 | | 574 | 1233.8 | 1369 | 493 | 25.0 | 2.8 | ✓ | WUW | 4+50, 0+24. |
| 9-12-94 | RFL-SS-4134 | 9-12-94 | 9-13-94 | 476 | 441.6 | 822.0 | 474 | 9.8 | 1.8 | ✓ | 9U | |
| 10-13-94 | -VP500 | 9-12-94 | | 576 | 771.6 | 1101 | 455 | 17.0 | 2.4 | ✓ | WUW | |
| 9-12-94 | RFL-SS-4135 | 9-12-94 | 9-13-94 | 574 | 357.1 | 1225 | 467 | 7.6 | 2.6 | ✓ | 9U | 3+95, 0+85L4. |
| 10-13-94 | -VP500 | 9-12-94 | | 476 | 639.8 | 1241 | 441 | 14.5 | 2.8 | ✓ | WUW | |

Site Correction Factor = 1.8
 VP Correction Factor (if applicable) = 1.8
 Count Time = 500 SEC., unless otherwise noted

REVIEWED BY: [Signature]
 Site HP Manager

COPY

A MURKIN KNUDSEN COMPANY

OCS SAMPLE LOG

SITE NAME BIFLE CO

| COUNT DATE INITIAL 20 DAY | SAMPLE ID & LOCATION | DATE SAMPLED | DATE SEALED | OCS # INITIAL 20 DAY | B-214 pCi INITIAL 20 DAY | Tl-208 pCi INITIAL 20 DAY | MASS (grams) WET DRY | Re-226 pCi/g INITIAL/CORR 20 DAY | Th-232 pCi/g INITIAL 20 DAY | DEPTH <15cm >15cm | TECH INITIAL 20 DAY | COMMENTS |
|---------------------------|----------------------|--------------|-------------|----------------------|--------------------------|---------------------------|----------------------|----------------------------------|-----------------------------|-------------------|---------------------|------------------------------------------------|
| 9-14-94 | RFL-SS-415H | | | 508 | 715.7 | 976.4 | 496 | 1.4 | 2.0 | | PU | |
| 10-18-94 | VP500-Hole#5 | 9-13-94 | 9-15-94 | 440 | 1170 | 987.4 | 472 | 2.5 | 2.1 | ✓ | W/W | |
| 9-14-94 | RFL-SS-415S | | | 510 | 732.4 | 1120 | 506 | 1.4 | 2.2 | ✓ | PU | |
| 10-18-94 | VP500-Hole#6 | 9-13-94 | 9-15-94 | 520 | 1050 | 1043 | 481 | 2.2 | 2.2 | ✓ | W/W | |
| 9-14-94 | RFL-SS-415S | | | 512 | 798.5 | 1043 | 578 | 0.69 | 1.8 | | PU | |
| 10-18-94 | VP500-Hole#7 | 9-13-94 | 9-15-94 | 442 | 855.5 | 1162 | 543 | 1.6 | 2.1 | ✓ | W/W | |
| 9-14-94 | RFL-SS-4157 | | | 514 | 638.5 | 890.2 | 530 | 1.2 | 1.7 | | PU | |
| 10-11-94 | VP500-Hole#8 | 9-13-94 | 9-15-94 | 540 | 778.0 | 1053 | 499 | 1.6 | 2.1 | ✓ | PU | |
| 9-14-94 | ORF-SS-4158 | | | 516 | 624.2 | 890.2 | 503 | 1.2 | 1.8 | ✓ | W/W | S/S 3'-4' Elev. 5305.2 N 25602 E 60216 N |
| 10-11-94 | VP500-Hole#18 | 9-8-94 | 9-15-94 | 442 | 1223 | 873.8 | 497 | 2.5 | 1.8 | ✓ | W/W | |
| 9-14-94 | ORF-SS-4159 | | | 518 | 6550 | 1091 | 388 | 16.9 | 2.8 | | PU | |
| 10-11-94 | -18 | 9-8-94 | 9-15-94 | 438 | 8013 | 550.5 | 380 | 21.1 | 1.4 | ✓ | PU | |
| 9-14-94 | ORF-SS-4160 | | | 520 | 804.2 | 909.4 | 511 | 1.5 | 1.7 | | PU | S/S 0-1' Elev. 5305.2 N 25637 E 60348 L |
| 10-18-94 | -20 | 9-8-94 | 9-15-94 | 446 | 1000 | 935.0 | 500 | 2.0 | 1.9 | ✓ | W/W | |
| 9-14-94 | ORF-SS-4161 | | | 522 | 1352 | 765.8 | 521 | 2.6 | 1.5 | | PU | S/S 1'-2' Elev. 5305.2 N 25637 E 60348 L |
| 10-18-94 | -20 | 9-8-94 | 9-15-94 | 532 | 1549 | 708.4 | 510 | 3.0 | 1.4 | ✓ | W/W | |
| 9-14-94 | ORF-SS-4162 | | | 524 | 3072 | 938.1 | 451 | 6.8 | 2.1 | | PU | S/S 2'-3' Elev. 5305.2 N 25637 E 60348 L |
| 10-18-94 | -20 | 9-8-94 | 9-15-94 | 448 | 4307 | 891.3 | 427 | 10.1 | 2.1 | ✓ | W/W | |
| 9-14-94 | ORF-SS-4163 | | | 526 | 2244 | 737.1 | 422 | 5.3 | 1.7 | | PU | S/S 5'-6' Elev. 5305.2 N 25637 E 60348 L |
| 10-11-94 | -20 | 9-8-94 | 9-15-94 | 542 | 2619 | 890.2 | 412 | 6.4 | 2.2 | ✓ | W/W | |

Site Correction Factor = 1.8
 VP Correction Factor (if applicable) = 1.8
 Count Time = 500 SEC., unless otherwise noted

REVIEWED BY: 
 Site HP Manager

COPY

OCS SAMPLE LOG

SITE NAME RIFLECO

| COUNT DATE INITIAL 20 DAY | SAMPLE ID & LOCATION | DATE SAMPLED | DATE SEALED | OCS # INITIAL 20 DAY | BI-214 pCi INITIAL 20 DAY | TI-208 pCi INITIAL 20 DAY | MASS (grams) WET DRY | Re-228 pCi/g INITIAL/CORR 20 DAY | Th-232 pCi/g | DEPTH | TECH | COMMENTS |
|---------------------------|----------------------|--------------|-------------|----------------------|---------------------------|---------------------------|----------------------|----------------------------------|--------------|-------|------|---------------------------------------------------------|
| 9-14-94 | ORF-SS-4164 | 9-14-94 | 9-15-94 | 528 | 22174 | 1465 | 554 | 40.0 | OK | | | Area E+D border 30' N from bottom ditch brown sand |
| 10-18-94 | #1 | 9-14-94 | | 534 | 538.9 | 1005 | 519 | 1.0 | OK | | | |
| 7-14-94 | ORF-SS-4165 | 9-14-94 | 9-15-94 | 530 | 11428 | 1560 | 590 | 19.4 | OK | | | Area E+D border 25' N of bottom of ditch black sand |
| 10-11-94 | #2 | 9-14-94 | | 544 | 740.1 | 1235 | 529 | 1.4 | OK | | | |
| 7-14-94 | ORF-SS-4166 | 9-14-94 | 9-15-94 | 532 | 3551 | 823.2 | 652 | 5.4 | | | | Area D+E border 25' N of bottom of ditch dark brown mud |
| 10-11-94 | #3 | 9-14-94 | | 538 | 937.3 | 976.4 | 522 | 1.8 | | | | |
| 9-13-94 | ORF-SS-4167 | 9-13-94 | | 446 | 9712 | 1167 | 831 | 11.7 | 1.4 | NA | YU | west sump hole |
| 7-13-94 | #1 | 9-13-94 | | | | | | | | | | |
| 7-13-94 | ORF-SS-4168 | 9-13-94 | | 558 | 11136 | 1149 | 754 | 14.8 | 1.5 | NA | YU | west sump hole |
| 7-13-94 | #2 | 9-13-94 | | | | | | | | | | |
| 7-14-94 | ORF-SS-4169 | 9-8-94 | 9-15-94 | 534 | 15300 | 6490 | 624 | 245.2 | 10.4 | | YU | S/S 6'-7' Elev. 530 N 25637 E 60348 |
| 10-18-94 | -20 | 9-8-94 | | 450 | 196640 | 672.0 | 620 | 317.2 | 1.1 | ✓ | UNW | |
| 7-14-94 | ORF-SS-4170 | 9-8-94 | 9-15-94 | 536 | 4197 | 1072 | 495 | 8.5 | 2.2 | | YU | S/S 0'-1' Elev. 5306 N 25619 E 60282 |
| 10-11-94 | -19 | 9-8-94 | | 444 | 5402 | 699.1 | 431 | 12.5 | 1.6 | ✓ | UNW | |
| 7-14-94 | ORF-SS-4171 | 9-8-94 | 9-15-94 | 538 | 1692 | 1043 | 427 | 4.0 | 2.4 | | YU | S/S 1'-2' Elev. 530 N 25619 E 60282 |
| 10-18-94 | -19 | 9-8-94 | | 536 | 3113 | 1120 | 361 | 8.6 | 3.1 | ✓ | UNW | |
| 7-14-94 | ORF-SS-4172 | 9-8-94 | 9-15-94 | 540 | 1374 | 957.2 | 539 | 2.6 | 1.8 | | YU | S/S 2'-3' Elev. 5306 N 25619 E 60282 |
| 10-18-94 | -19 | 9-8-94 | | 452 | 2061 | 856.4 | 467 | 4.4 | 1.8 | ✓ | UNW | |
| 7-14-94 | ORF-SS-4173 | 9-8-94 | 9-15-94 | 542 | 1192 | 1149 | 524 | 2.3 | 2.2 | | YU | S/S 0'-1' Elev. 5306 N 25657 E 60436 |
| 10-18-94 | -21 | 9-8-94 | | 538 | 2836 | 1043 | 501 | 5.7 | 2.1 | ✓ | YU | |

Correction Factor = 1.8
 Correction Factor (if applicable) = 1.8
 Count Time = 500 SEC., unless otherwise noted

COPY

REVIEWED BY: [Signature]
 Site HP Manager

OCS SAMPLE LOG

SITE NAME RIFLE, CO

| COUNT DATE INITIAL 20 DAY | SAMPLE ID & LOCATION | DATE SAMPLED | DATE SEALED | OCS # INITIAL 20 DAY | IB-214 pCi INITIAL 20 DAY | TI-200 pCi INITIAL 20 DAY | MASS (grams) WET DRY | Re-226 pCi/g INITIAL/CORR. 20 DAY | Th-232 pCi/g INITIAL 20 DAY | DEPTH <15cm >15cm | TECH INITIAL 20 DAY | COMMENTS |
|---------------------------|----------------------|--------------|-------------|----------------------|---------------------------|---------------------------|----------------------|-----------------------------------|-----------------------------|-------------------|---------------------|---------------------------------------------------|
| 9-14-94 | ORF-SS-4174 | 9-8-94 | 9-15-94 | 544 | 3168 | 1082 | 387 | 8.2 | 2.8 | ✓ | SB | Elev 5600.3 N. 25657 5306.3 E. 60436 +2'-3' |
| 10-11-94 | 21 | 9-8-94 | 9-15-94 | 546 | 5418 | 727.5 | 358 | 15.1 | 2.0 | ✓ | PU | Elev 5306.3 N. 25657 E. 60436 +3'-4' |
| 9-14-94 | ORF-SS-4175 | 9-8-94 | 9-15-94 | 546 | 7429 | 871.1 | 295 | 25.2 | 3.0 | ✓ | SB | Elev 5306.3 N. 25657 E. 60436 +3'-4' |
| 10-18-94 | -21 | 9-8-94 | 9-15-94 | 454 | 11666 | 966.2 | 286 | 40.8 | 3.4 | ✓ | PU | Elev 5306.3 N. 25657 E. 60436 +4'-5' |
| 9-14-94 | ORF-SS-4176 | 9-8-94 | 9-15-94 | 548 | 91988 | 4850 | 574 | 160.2 | 7.4 | ✓ | SB | Elev 5306.3 N. 25657 E. 60436 +4'-5' |
| 10-18-94 | 21 | 9-8-94 | 9-15-94 | 456 | 130020 | 4159 | 569 | 228.5 | 7.3 | ✓ | WLU | Elev 5306.4 N. 25675 E. 60523 +1'-2" |
| 9-14-94 | ORF-SS-4177 | 9-8-94 | 9-15-94 | 550 | 4775 | 737.1 | 323 | 14.8 | 2.3 | ✓ | SB | Elev 5306.4 N. 25675 E. 60523 +1'-2" |
| 10-11-94 | 22 | 9-8-94 | 9-15-94 | 446 | 6658 | 1031 | 316 | 21.1 | 3.3 | ✓ | PU | Elev 5306.4 N. 25675 E. 60523 +2'-3' |
| 9-14-94 | ORF-SS-4178 | 9-8-94 | 9-15-94 | 552 | 7296 | 813.6 | 275 | 26.5 | 3.0 | ✓ | SB | Elev 5306.4 N. 25675 E. 60523 +2'-3' |
| 10-11-94 | 22 | 9-8-94 | 9-15-94 | 448 | 12176 | 978.7 | 256 | 47.6 | 3.8 | ✓ | WLU | S/S 3'4" Elev 5306.4 N 25675 E 60523 |
| 9-14-94 | ORF-SS-4179 | 9-8-94 | 9-15-94 | 554 | 5877 | 1072 | 294 | 20.0 | 3.6 | ✓ | PU | S/S 3'4" Elev 5306.4 N 25675 E 60523 |
| 10-18-94 | -22 | 9-8-94 | 9-15-94 | 458 | 9102 | 1215 | 281 | 32.4 | 4.3 | ✓ | WLU | S/S 3'4" Elev 5306.4 N 25675 E 60523 |
| 9-14-94 | ORF-SS-4180 | 9-8-94 | 9-15-94 | 556 | 3459 | 1158 | 533 | 6.5 | 2.2 | ✓ | SB | S/S 3'4" Elev 5306.4 N. 25675 E. 60523 |
| 10-18-94 | 22 | 9-8-94 | 9-15-94 | 540 | 5742 | 976.4 | 521 | 11.0 | 1.9 | ✓ | WLU | S/S 3'4" Elev 5306.4 N. 25675 E. 60523 |
| 9-15-94 | ORF-SE-4181 | 9-15-94 | 9-15-94 | 516 | 2054 | 1206 | 471 | 4.4 | 2.6 | ✓ | SB | Composite 1+83, 1+82.5 |
| 9-15-94 | 1P500 | 9-15-94 | 9-15-94 | | N | A | | | | ✓ | SB | Area E Black Sandy Material |
| 9-15-94 | ORF-SS-4182 | 9-15-94 | 9-15-94 | 524 | 71057 | 3561 | 444 | 160.0 | 8.0 | ✓ | SB | Area E Black Sandy Material |
| 10-18-94 | #1 | 9-15-94 | 9-15-94 | 542 | 78212 | 3216 | 386 | 202.6 | 8.3 | ✓ | WLU | 3x35, 1+55 |
| 9-15-94 | ORF-SE-4183 | 9-15-94 | 9-15-94 | 534 | 9137 | 1158 | 478 | 1.9 | 2.4 | ✓ | SB | 3x35, 1+55 |
| 9-15-94 | 1P500 | 9-15-94 | 9-15-94 | | N | A | | | | ✓ | SB | |

REVIEWED BY: *[Signature]*
Site HTP Manager

COPY

Site Correction Factor = 1.8
VP Correction Factor (if applicable) = 1.8
Count Time = 500 SEC., unless otherwise noted

OCS SAMPLE LOG

RIFLE Co.

SITE NAME

| COUNT DATE INITIAL 20 DAY | SAMPLE ID & LOCATION | DATE SAMPLED | DATE SEALED | OCS # INITIAL 20 DAY | BI-214 pCi INITIAL 20 DAY | TI-208 pCi INITIAL 20 DAY | MASS (grams) WET DRY | Re-226 pCi/g INITIAL/CORR. 20 DAY | Th-232 pCi/g INITIAL 20 DAY | DEPTH <15cm >15cm | TECH INITIAL 20 DAY | COMMENTS |
|---------------------------|----------------------|--------------|-------------|----------------------|---------------------------|---------------------------|----------------------|-----------------------------------|-----------------------------|-------------------|---------------------|-------------------------------------------|
| 9-15-94 N A | RFL-SE-4184 VP 500 | 9-15-94 | | 536 N A | 2073 N A | 9572 A | 534 | 3.9 | 1.8 | ✓ | 93 | 450, 0+00. Composite |
| 9-15-94 N A | RFL-SE-4185 VP 500 | 9-15-94 | | 538 N A | 788.2 N A | 670.1 A | 593 | 1.3 | 1.1 | ✓ | 93 | 4030, 0+LR |
| 9-16-94 N A | ORF-SE-4186 #4 | 9-15-94 | | 500 N A | 46820 N A | 24409 A | 675 | 693.5 | 36.2 | ✓ | 9U | Area E Middle Area SW of Acc |
| 9-16-94 N A | ORF-SE-4187 #5 | 9-15-94 | | 502 N A | 20530 N A | 11056 A | 783 | 262.3 | 14.1 | ✓ | 9U | Area E Middle Area SW of acc |
| 9-16-94 N A | ORF-SE-4188 #3 | 9-15-94 | | 504 N A | 792810 N A | 44731 A | 573 | 13836 4384 | 78.1 | ✓ | 9U | Area E Middle Area SW of Acc |
| 9-16-94 N A | ORF-SE-4189 #2 | 9-15-94 | | 506 N A | 308180 N A | 17489 A | 336 | 484.6 | 27.5 | ✓ | 9U | Area E Middle Area SW of Acc |
| 9-16-94 N A | ORF-SE-4190 #1 | 9-15-94 | | 508 N A | 385740 N A | 21624 A | 756 | 510.2 | 28.6 | ✓ | 9U | Area E Middle Area SW of Acc |
| 10-17-94 | ORF-SS-4191 #25 | 9-8-94 | 9-17-94 | 524 | 2127 | 989 | 393 | 5.4 | 2.3 | | 93 | 4/5 +1'-2' Elev. 5306.4 N. 25729 E. 60736 |
| 9-16-94 | ORF-SS-4192 -25 | 9-8-94 | 9-17-94 | 444 | 2837 | 752.3 | 368 | 7.7 | 2.0 | | WUW | 4/5 +2'-3' Elev. 5306.4 N. 25729 E. 60736 |
| 10-17-94 | ORF-SS-4193 -25 | 9-8-94 | 9-17-94 | 544 | 52817 | 1876 | 470 | 116.6 | 5.9 | ✓ | WUW | 4/5 +5'-6' Elev. 5306.4 N. 25729 E. 60736 |
| 9-16-94 | ORF-SS-4193 -25 | 9-8-94 | 9-17-94 | 528 | 30059 | 1675 | 436 | 68.9 | 3.8 | | 93 | 4/5 +5'-6' Elev. 5306.4 N. 25729 E. 60736 |
| 10-17-94 | ORF-SS-4193 -25 | 9-8-94 | 9-17-94 | 546 | 50722 | 2766 | 418 | 121.3 | 6.6 | ✓ | WUW | 4/5 +5'-6' Elev. 5306.4 N. 25729 E. 60736 |

REVIEWED BY: *John R. Fennell*
Site Mgr Manager

COPY

Correction Factor = 1.8
P Correction Factor (if applicable) = 1.8
Count Time = 500 Sec. unless otherwise noted

OCS SAMPLE LOG

RIFLE Co.

E NAME

| COUNT DATE INITIAL 20 DAY | SAMPLE ID & LOCATION | DATE SAMPLED | DATE SEALED | OCS # INITIAL 20 DAY | BI-214 pCI INITIAL 20 DAY | TI-200 pCI INITIAL 20 DAY | MASS (grams) WET DRY | Re-226 pCi/g INITIAL 20 DAY | Th-232 pCi/g INITIAL 20 DAY | DEPTH <15cm >15cm | TECH INITIAL 20 DAY | COMMENTS |
|---------------------------|----------------------|--------------|-------------|----------------------|---------------------------|---------------------------|----------------------|-----------------------------|-----------------------------|-------------------|---------------------|--------------------------------------------|
| 16-94 | ORF-55-4194 | 9-8-94 | 9-17-94 | 530 | 6114 | 986.0 | 496 | 12.3 | 2.0 | ✓ | WUW | S/S 1'-2' Elev. 5307.5 N. 25707 E. 60668 H |
| 17-94 | -24 | 9-8-94 | 9-17-94 | 446 | 8557 | 1014 | 481 | 17.8 | 2.1 | ✓ | WUW | S/S 2'-3' Elev. 5307.5 N. 25707 E. 60668 H |
| 16-94 | ORF-55-4195 | 9-8-94 | 9-17-94 | 532 | 3420 | 689.2 | 496 | 6.9 | 1.4 | ✓ | WUW | S/S 2'-3' Elev. 5307.5 N. 25707 E. 60668 H |
| 17-94 | -24 | 9-8-94 | 9-17-94 | 548 | 4562 | 1082 | 476 | 9.6 | 2.3 | ✓ | WUW | S/S 2'-3' Elev. 5307.5 N. 25707 E. 60668 H |
| 16-94 | ORF-55-4196 | 9-8-94 | 9-17-94 | 534 | 12029 | 1139 | 522 | 23.0 | 2.2 | ✓ | WUW | S/S 2'-3' Elev. 5307.5 N. 25707 E. 60668 H |
| 17-94 | -24 | 9-8-94 | 9-17-94 | 448 | 18176 | 1136 | 513 | 35.4 | 2.2 | ✓ | WUW | S/S 2'-3' Elev. 5307.5 N. 25707 E. 60668 H |
| 16-94 | ORF-55-4197 | 9-9-94 | 9-17-94 | 536 | 49540 | 2623 | 388 | 127.7 | 6.8 | ✓ | WUW | S/S 0'-1' Elev. 5309.2 N. 25780 E. 61055 C |
| 17-94 | -29 | 9-9-94 | 9-17-94 | 450 | 76857 | 3111 | 377 | 203.9 | 8.3 | ✓ | WUW | S/S 1'-2' Elev. 5309.2 N. 25780 E. 61055 C |
| 16-94 | ORF-55-4198 | 9-9-94 | 9-17-94 | 538 | 6453 | 9285 | 385 | 16.8 | 2.4 | ✓ | WUW | S/S 1'-2' Elev. 5309.2 N. 25780 E. 61055 C |
| 17-94 | -29 | 9-9-94 | 9-17-94 | 550 | 9873 | 1388 | 376 | 26.3 | 3.7 | ✓ | WUW | S/S 1'-2' Elev. 5309.2 N. 25780 E. 61055 C |
| 16-94 | ORF-55-4199 | 9-9-94 | 9-17-94 | 540 | 7660 | 909.7 | 480 | 16.0 | 1.9 | ✓ | WUW | S/S 2'-3' Elev. 5309.2 N. 25780 E. 61055 C |
| 17-94 | -29 | 9-9-94 | 9-17-94 | 552 | 13606 | 1302 | 452 | 30.1 | 2.9 | ✓ | WUW | S/S 2'-3' Elev. 5309.2 N. 25780 E. 61055 C |
| 16-94 | ORF-55-4200 | 9-9-94 | 9-17-94 | 542 | 11298 | 1110 | 382 | 29.6 | 2.9 | ✓ | WUW | S/S 3'-4' Elev. 5309.2 N. 25780 E. 61055 C |
| 17-94 | -29 | 9-9-94 | 9-17-94 | 452 | 19693 | 1258 | 335 | 58.8 | 3.8 | ✓ | WUW | S/S 3'-4' Elev. 5309.2 N. 25780 E. 61055 C |
| 7-94 | ORF-55-4201 | 9-8-94 | 9-19-94 | 500 | 13027 | 1417 | 445 | 29.3 | 3.2 | ✓ | WUW | S/S 2'-1' Elev. 5307.1 N. 25785 E. 60985 D |
| 19-94 | -28 | 9-8-94 | 9-19-94 | 478 | 18990 | 1136 | 424 | 44.8 | 2.7 | ✓ | WUW | S/S 2'-1' Elev. 5307.1 N. 25785 E. 60985 D |
| 17-94 | ORF-55-4202 | 9-8-94 | 9-19-94 | 502 | 17349 | 1465 | 427 | 40.6 | 3.4 | ✓ | WUW | S/S 2'-1' Elev. 5307.1 N. 25785 E. 60985 D |
| 19-94 | -28 | 9-8-94 | 9-19-94 | 580 | 25083 | 1551 | 398 | 63.0 | 3.9 | ✓ | WUW | S/S 2'-1' Elev. 5307.1 N. 25785 E. 60985 D |
| 17-94 | ORF-55-4203 | 9-8-94 | 9-19-94 | 504 | 21699 | 1522 | 403 | 53.8 | 3.8 | ✓ | WUW | S/S 2'-3' Elev. 5307.1 N. 25783 E. 60985 D |
| 19-94 | -28 | 9-8-94 | 9-19-94 | 480 | 33528 | 1608 | 372 | 90.1 | 4.3 | ✓ | WUW | S/S 2'-3' Elev. 5307.1 N. 25783 E. 60985 D |

Correction Factor = 1.8

Correction Factor (if applicable) = 1.8

Count Time = 500 Sec., unless otherwise noted

COPY

REVIEWED BY:

John P. Fennell
Site HP Manager

OCS SAMPLE LOG

TE NAME RIFLECO

| COUNT DATE INITIAL 20 DAY | SAMPLE ID & LOCATION | DATE SAMPLED | DATE SEALED | OCS # INITIAL 20 DAY | BH-214 pCi INITIAL 20 DAY | TI-208 pCi INITIAL 20 DAY | MASS (grams) WET DRY | Rb-228 pCi/g INITIAL 20 DAY | Th-232 pCi/g INITIAL 20 DAY | DEPTH <15cm >15cm | TECH INITIAL 20 DAY | COMMENTS |
|---------------------------|----------------------|--------------|-------------|----------------------|---------------------------|---------------------------|----------------------|-----------------------------|-----------------------------|-------------------|---------------------|------------------------------------------------|
| 7-17-94 | ORF-SS-4204 | 9-8-94 | 9-19-94 | 506 | 20065 | 1790 | 492 | 40.8 | 3.6 | | YU | S/S 3'-4' Elev. 5307.1 N 25783 E 60985 D |
| 7-19-94 | -28 | 9-8-94 | 9-19-94 | 488 | 26510 | 1870 | 471 | 56.3 | 4.0 | ✓ | B/YU | |
| 7-17-94 | ORF-SS-4205 | 9-8-94 | 9-19-94 | 508 | 14011 | 1484 | 461 | 30.4 | 3.2 | ✓ | YU | S/S 4'-5' Elev. 5307.1 N 25783 E 60985 D |
| 7-19-94 | -28 | 9-8-94 | 9-19-94 | 588 | 18481 | 1608 | 442 | 41.8 | 3.6 | ✓ | B/YU | |
| 7-17-94 | ORF-SS-4206 | 9-8-94 | 9-19-94 | 510 | 11283 | 986.0 | 348 | 32.4 | 2.8 | | YU | S/S 5'-6' Elev. 5307.1 N 25783 E 60985 D |
| 7-19-94 | -28 | 9-8-94 | 9-19-94 | 490 | 17654 | 1477 | 334 | 52.9 | 4.4 | ✓ | B/YU | |
| 7-17-94 | ORF-SS-4207 | 9-8-94 | 9-19-94 | 512 | 3300 | 1024 | 435 | 7.6 | 2.4 | | YU | S/S 0'-1' Elev. 5307.2 N 25742 E 60804 F |
| 7-19-94 | -26 | 9-8-94 | 9-19-94 | 590 | 5713 | 871.1 | 390 | 14.6 | 2.2 | ✓ | B/YU | |
| 7-17-94 | ORF-SS-4208 | 9-8-94 | 9-19-94 | 514 | 20220 | 1216 | 348 | 58.1 | 3.5 | | YU | S/S 1'-2' Elev. 5307.2 N 25742 E 60804 F |
| 7-20-94 | -26 | 9-8-94 | 9-19-94 | 400 | 31003 | 1870 | 314 | 98.7 | 6.0 | ✓ | YU | |
| 7-17-94 | ORF-SS-4209 | 9-8-94 | 9-19-94 | 516 | 80159 | 3369 | 548 | 146.3 | 6.1 | | YU | S/S 2'-3' Elev. 5307.2 N 25742 E 60804 F |
| 7-20-94 | -26 | 9-8-94 | 9-19-94 | 500 | 123700 | 506.4 | 529 | 233.8 | 9.6 | ✓ | YU | PASS K 7.5 |
| 7-17-94 | ORF-SS-4210 | 9-8-94 | 9-19-94 | 518 | 18032 | 1417 | 481 | 37.5 | 2.9 | | YU | S/S 3'-4' Elev. 5307.2 N 25742 E 60804 F |
| 7-20-94 | -26 | 9-8-94 | 9-19-94 | 402 | 33570 | 1590 | 439 | 76.5 | 3.6 | ✓ | YU | |
| 7-17-94 | ORF-SS-4211 | 9-8-94 | 9-19-94 | 520 | 21977 | 1398 | 369 | 59.6 | 3.8 | | YU | S/S 4'-5' Elev. 5307.2 N 25742 E 60804 F |
| 7-20-94 | -26 | 9-8-94 | 9-19-94 | 502 | 37599 | 1848 | 324 | 116.0 | 5.7 | ✓ | YU | |
| 7-17-94 | ORF-SS-4212 | 9-8-94 | 9-19-94 | 522 | 11008 | 1264 | 363 | 30.3 | 3.5 | | YU | S/S 5'-6' Elev. 5307.2 N 25742 E 60804 F |
| 7-20-94 | -26 | 9-8-94 | 9-19-94 | 404 | 14849 | 1582 | 345 | 43.0 | 4.6 | ✓ | YU | |
| 7-17-94 | ORF-SS-4213 | 9-8-94 | 9-19-94 | 524 | 57712 | 2958 | 407 | 141.8 | 7.3 | | YU | S/S 6'-7' Elev. 5307.1 N 25783 E 60985 D |
| 7-20-94 | -28 | 9-8-94 | 9-19-94 | 504 | 86594 | 3915 | 391 | 221.5 | 10.0 | ✓ | YU | |

Correction Factor = 1.8
 Correction Factor (if applicable) = 1.8
 Count Time = 500 SEC., unless otherwise noted

REVIEWED BY: [Signature]
 Site ITP Manager

COPY

OCS SAMPLE LOG

TE NAME RIFLE, CO

| COUNT DATE INITIAL 20 DAY | SAMPLE ID & LOCATION | DATE SAMPLED | DATE SEALED | OCS # INITIAL 20 DAY | BI-214 pCi INITIAL 20 DAY | TI-208 pCi INITIAL 20 DAY | MASS (grams) WET DRY | Pa-210 pCi/g INITIAL/CORR 20 DAY | Tb-232 pCi/g INITIAL 20 DAY | DEPTH <15cm >15cm | TECH INITIAL 20 DAY | COMMENTS |
|---------------------------|----------------------|--------------|-------------|----------------------|---------------------------|---------------------------|----------------------|----------------------------------|-----------------------------|-------------------|---------------------|------------------------------------------------|
| 7-17-94 | ORF-SS-4214 | 9-8-94 | 9-19-94 | 526 | 5112 | 1187 | 409 | 12.5 | 2.9 | ✓ | YU | S/S 0'-1' Elev. 5309.1 N 25762 E 60898 E |
| 7-20-94 | -27 | 9-8-94 | 9-19-94 | 406 | 7649 | 1302 | 373 | 20.5 | 3.5 | ✓ | YU | |
| 7-17-94 | ORF-SS-4215 | 9-8-94 | 9-19-94 | 528 | 25464 | 1369 | 423 | 60.2 | 3.2 | ✓ | YU | S/S 1'-2' Elev. 5309.1 N 25762 E 60898 E |
| 7-20-94 | -27 | 9-8-94 | 9-19-94 | 506 | 43777 | 2278 | 390 | 112.3 | 5.8 | ✓ | YU | |
| 7-17-94 | ORF-SS-4216 | 9-8-94 | 9-19-94 | 530 | 5258 | 689.2 | 301 | 17.5 | 2.3 | ✓ | YU | S/S 2'-3' Elev. 5309.1 N 25762 E 60898 E |
| 7-20-94 | -27 | 9-8-94 | 9-19-94 | 408 | 7812 | 856.4 | 263 | 29.7 | 3.3 | ✓ | YU | |
| 7-17-94 | ORF-SS-4217 | 9-8-94 | 9-19-94 | 532 | 4295 | 1158 | 372 | 11.5 | 3.1 | ✓ | YU | S/S 3'-4' Elev. 5309.1 N 25762 E 60898 E |
| 7-20-94 | -27 | 9-8-94 | 9-19-94 | 508 | 7155 | 1158 | 356 | 20.1 | 3.3 | ✓ | YU | |
| 7-17-94 | ORF-SS-4218 | 9-8-94 | 9-19-94 | 534 | 82246 | 3571 | 609 | 135.1 | 5.9 | ✓ | YU | S/S 4'-5' Elev. 5309.1 N 25762 E 60898 E |
| 7-20-94 | -27 | 9-8-94 | 9-19-94 | 410 | 121940 | 5007 | 597 | 204.3 | 8.4 | ✓ | YU | |
| 7-17-94 | ORF-SS-4219 | 9-8-94 | 9-19-94 | 536 | 2618 | 670.1 | 285 | 9.2 | 2.4 | ✓ | YU | S/S 0'-1' Elev. 5313.0 N 25813 E 61128 B |
| 7-20-94 | -30 | 9-8-94 | 9-19-94 | 510 | 4347 | 966.8 | 251 | 17.3 | 3.9 | ✓ | YU | |
| 7-17-94 | ORF-SS-4220 | 9-8-94 | 9-19-94 | 538 | 17243 | 1484 | 434 | 39.7 | 3.4 | ✓ | YU | S/S 1'-2' Elev. 5313.0 N 25813 E 61128 B |
| 7-20-94 | -30 | 9-8-94 | 9-19-94 | 412 | 29760 | 1617 | 409 | 72.8 | 4.0 | ✓ | YU | |
| 7-17-94 | ORF-SS-4221 | 9-8-94 | 9-19-94 | 540 | 32020 | 1599 | 667 | 48.0 | 2.4 | ✓ | YU | S/S 2'-3' Elev. 5313.0 N 25813 E 61128 B |
| 7-20-94 | -30 | 9-8-94 | 9-19-94 | 512 | 46889 | 2747 | 647 | 72.5 | 4.2 | ✓ | YU | |
| 7-17-94 | ORF-SE-4222 | 9-19-94 | | 508 | 409.8 | 784.9 | 593 | 0.69 | 1.3 | ✓ | YU | 1060 CPTM S. of HOC |
| 7-20-94 | #1 | 9-19-94 | | | | A | | | | ✓ | | |
| 7-17-94 | ORF-SE-4223 | 9-19-94 | | 510 | 24119 | 1579 | 604 | 39.9 | 2.6 | ✓ | YU | 3000 CPTM S. of HOC |
| 7-20-94 | #2 | 9-19-94 | | | | A | | | | ✓ | | |

REVIEWED BY: *Robert J. Jensen*
Site HTP Manager

COPY

Correction Factor = 1.8
Correction Factor (if applicable) = 1.8
Count Time = 500 SEC, unless otherwise noted



MORRISON KNUDSEN COMPANY
A MORRISON KNUDSEN COMPANY



CWM Federal Environmental Services, Inc.

Attachment #7

RIFE, Co

OCS SAMPLE LOG

SITE NAME

| COUNT DATE INITIAL 20 DAY | SAMPLE ID & LOCATION | DATE SAMPLED | DATE SEALED | OCS # INITIAL 20 DAY | BI-214 pCi INITIAL 20 DAY | TI-208 pCi INITIAL 20 DAY | MASS (grams) WET DRY | Ra-226 pCi/g INITIAL/CORR 20 DAY | Th-232 pCi/g INITIAL 20 DAY | DEPTH <15cm >15cm | TECH INITIAL 20 DAY | COMMENTS |
|---------------------------|----------------------|--------------|-------------|----------------------|---------------------------|---------------------------|----------------------|----------------------------------|-----------------------------|-------------------|---------------------|-----------------------------------|
| 5-9-95 | RFL-SS-8194 | 5-9-95 | | 510 | 705.9 | 539.8 | 736 | 0.96 | 0.73 | ✓ | W/W | TH-230 C/F |
| 5-9-95 | J-14-19 | 5-9-95 | | 416 | 724.4 | 629.2 | 609 | 1.2 | 1.0 | ✓ | W/W | TH-230 C/F |
| 5-10-95 | J-14-14 | 5-9-95 | | 456 | 58232 | 1346 | 633 | 100.4 | 2.1 | ✓ | KC | 0-2' SPS-P BH#20 |
| 5-31-95 | RFL-SS-8196 | 5-10-95 | | 604 | 60705 | 2893 | 572 | 106.1 | 4.2 | ✓ | KC | River BANK 2-4' SPS-P BH#20 |
| 5-10-95 | VP 479-480 | 5-10-95 | 5-11-95 | 554 | 54749 | 2381 | 429 | 127.6 | 5.6 | ✓ | KC | River BANK 0-2' SPS-Q BH#21 |
| 5-31-95 | RFL-SS-8197 | 5-10-95 | 5-11-95 | 606 | 87379 | 3155 | 304 | 287.9 | 10.3 | ✓ | KC | River BANK 0-2' SPS-Q BH#21 |
| 5-10-95 | VP 479-480 | 5-10-95 | 5-11-95 | 458 | 35476 | 1442 | 550 | 64.5 | 2.6 | ✓ | KC | River BANK 2-4' SPS-Q BH#21 |
| 5-31-95 | RFL-SS-8199 | 5-10-95 | 5-11-95 | 608 | 55212 | 2068 | 463 | 119.6 | 4.5 | ✓ | KC | River BANK 2-4' SPS-Q BH#21 |
| 5-10-95 | VP 479-480 | 5-10-95 | 5-11-95 | 556 | 58245 | 2092 | 356 | 119.6 | 5.9 | ✓ | KC | River BANK 0-2' SPS-R BH#22 |
| 5-31-95 | RFL-SS-8200 | 5-10-95 | 5-11-95 | 610 | 86324 | 3320 | 299 | 288.7 | 11.1 | ✓ | KC | River BANK 0-2' SPS-R BH#22 |
| 5-10-95 | VP 479-480 | 5-10-95 | 5-11-95 | 460 | 11128 | 1276 | 644 | 17.3 | 2.0 | ✓ | KC | River BANK 2-4' SPS-R BH#22 |
| 5-31-95 | RFL-SS-8201 | 5-10-95 | 5-11-95 | 612 | 15480 | 1178 | 584 | 26.5 | 2.0 | ✓ | KC | River BANK 2-4' SPS-R BH#22 |
| 5-10-95 | VP 479-480 | 5-10-95 | 5-11-95 | 558 | 13721 | 1224 | 656 | 20.9 | 1.9 | ✓ | KC | River BANK 4-6' SPS-R BH#22 |
| 5-31-95 | RFL-SS-8202 | 5-10-95 | 5-11-95 | 614 | 16185 | 1224 | 631 | 25.6 | 1.9 | ✓ | KC | River BANK 0-2' SPS-S BH#2 |
| 5-10-95 | VP 479-480 | 5-10-95 | 5-11-95 | 462 | 9843 | 1110 | 763 | 12.9 | 1.5 | ✓ | KC | River BANK 0-2' SPS-S BH#2 |
| 5-31-95 | RFL-SS-8203 | 5-10-95 | 5-11-95 | 616 | 12836 | 1076 | 726 | 17.7 | 1.5 | ✓ | KC | River BANK 0-2' SPS-S BH#2 |
| 5-10-95 | VP 479-480 | 5-10-95 | 5-11-95 | 560 | 14264 | 1147 | 690 | 20.7 | 1.7 | ✓ | KC | River BANK 0-2' SPS-S BH#2 |
| 5-31-95 | RFL-SS-8204 | 5-10-95 | 5-11-95 | 520 | 18614 | 1118 | 438 | 29.2 | 1.8 | ✓ | KC | River BANK 0-2' SPS-S BH#2 |

Site Correction Factor = 1.08
 VP Correction Factor (if applicable) = 1.7
 Count Time = 500 Sec, unless otherwise noted

REVIEWED BY: *John H. Howard*
 Site HP Manager

COPY



MK-FLUORUSON COMPANY
A MORRISON KRODSEH COMPANY



CWM Federal Environmental Services, Inc.

OCS SAMPLE LOG

SITE NAME Rifle, CO

| COUNT DATE INITIAL 20 DAY | SAMPLE ID & LOCATION | DATE SAMPLED | DATE SEALED | OCS # INITIAL 20 DAY | BI-214 pCi INITIAL 20 DAY | TI-208 pCi INITIAL 20 DAY | MASS (grams) WET DRY | Pa-226 pCi/g INITIAL/CORR. 20 DAY | Th-232 pCi/g INITIAL 20 DAY | DEPTH <15cm >15cm | TECH INITIAL 20 DAY | COMMENTS |
|---------------------------|----------------------|--------------|-------------|----------------------|---------------------------|---------------------------|----------------------|-----------------------------------|-----------------------------|-------------------|---------------------|-------------------|
| 5-10-95 | RFL-55-8204 | | | 464 | 20817 | 1320 | 663 | 31.4 | 2.0 | | KC | 2-4' SPS-S Bld#2 |
| 5-31-95 | VP 479-480 | 5-10-95 | 5-11-95 | 618 | 32197 | 1790 | 599 | 53.8 | 3.0 | ✓ | KC | River BANK |
| 5-10-95 | RFL-55-8205 | | | 562 | 6217 | 1051 | 811 | 7.7 | 1.3 | | KC | 4-6' SPS-S Bld#2 |
| 5-31-95 | VP 479-480 | 5-10-95 | 5-11-95 | 620 | 7482 | 1002 | 766 | 9.8 | 1.3 | ✓ | KC | River BANK |
| 5-10-95 | RFL-55-8206 | | | 466 | 5055 | 1014 | 693 | 9.3 | 1.65 | | KC | 6-8' SPS-S Bld#2 |
| 5-31-95 | VP 479-480 | 5-10-95 | 5-11-95 | 422 | 6324 | 1267 | 674 | 9.4 | 1.9 | ✓ | KC | River BANK |
| 5-10-95 | RFL-55-8207 | | | 564 | 3714 | 1060 | 629 | 5.9 | 1.7 | | KC | 0-2' SPS-TE Bld#2 |
| 5-31-95 | VP 479-480 | 5-10-95 | 5-11-95 | 522 | 5549 | 1060 | 559 | 9.9 | 1.9 | ✓ | KC | River BANK |
| 5-10-95 | RFL-55-8208 | | | 468 | 4669 | 961.2 | 704 | 6.6 | 1.4 | | KC | 2-4' SPS-TE Bld#2 |
| 5-31-95 | VP 479-480 | 5-10-95 | 5-11-95 | 622 | 5910 | 881.0 | 663 | 8.9 | 1.3 | ✓ | KC | River BANK |
| 5-10-95 | RFL-55-8209 | | | 566 | 4190 | 790.4 | 637 | 6.6 | 1.2 | | KC | 0-2' SPS-U Bld#2 |
| 5-31-95 | VP 479-480 | 5-10-95 | 5-11-95 | 424 | 5111 | 1066 | 570 | 9.0 | 1.9 | ✓ | KC | River BANK |
| 5-10-95 | RFL-55-8210 | | | 470 | 5780 | 943.7 | 559 | 10.3 | 1.7 | | KC | 2-4' SPS-U Bld#2 |
| 5-31-95 | VP 479-480 | 5-10-95 | 5-11-95 | 524 | 9399 | 867.5 | 449 | 20.9 | 1.9 | ✓ | KC | River BANK |
| 5-10-95 | RFL-55-8211 | | | 568 | 1674 | 119.5 | 681 | 2.5 | 1.8 | | KC | 0-2' SPS-U Bld#2 |
| 5-31-95 | VP 479-480 | 5-10-95 | 5-11-95 | 624 | 1873 | 102.9 | 604 | 3.1 | 1.7 | ✓ | KC | River BANK |
| 5-10-95 | RFL-55-8212 | | | 472 | 2953 | 110.1 | 577 | 5.1 | 1.9 | | KC | 2-4' SPS-U Bld#2 |
| 5-31-95 | VP 479-480 | 5-10-95 | 5-11-95 | 426 | 3555 | 121.5 | 516 | 6.9 | 2.4 | ✓ | OC | River BANK |
| 5-10-95 | RFL-55-8213 | | | 570 | 3021 | 867.5 | 647 | 4.7 | 1.3 | | KC | 4-6' SPS-U Bld#2 |
| 5-31-95 | VP 479-480 | 5-10-95 | 5-11-95 | 526 | 4334 | 1070 | 568 | 7.9 | 1.8 | ✓ | OC | River BANK |

Site Correction Factor = 1.8
 VP Correction Factor (if applicable) = 1.7
 Count Time = 500 sec. unless otherwise noted

COPY

REVIEWED BY: [Signature]
 Site HP Manager

OCS SAMPLE LOG

| COUNT DATE INITIAL 20 DAY | SAMPLE ID # & LOCATION | DATE SAMPLED | DATE SEALED | OCS # INITIAL 20 DAY | BI-214 pCi INITIAL 20 DAY | TI-208 pCi INITIAL 20 DAY | MASS (grams) WET DRY | Ra-226 pCi/g INITIAL/CORR 20 DAY | Th-232 pCi/g INITIAL 20 DAY | DEPTH <15cm >15cm | TECH INITIAL 20 DAY | COMMENTS |
|---------------------------|------------------------|--------------|-------------|----------------------|---------------------------|---------------------------|----------------------|----------------------------------|-----------------------------|-------------------|---------------------|---------------------|
| 5-10-95 | RFL-55-8214 | | | 572 | 538.4 | 848.2 | 624 | 0.860 | 1.4 | | KC | 6'-8' SPS-W |
| 5-31-95 | VP479-480 | 5-10-95 | 5-11-95 | 626 | 990.1 | 723.4 | 552 | 1.8 | 1.3 | ✓ | DC | RIVER BANK |
| 5-11-95 | RFL-55-8215-480 | 5-10-95 | | 400 | 50269 | 1503 | 551 | 91.2 | 2.7 | ✓ | KC | 0-2' SPS-G BHT#11 |
| 6-3-95 | VP479 | 5-10-95 | 5-14-95 | 426 | 86783 | 3321 | 477 | 181.9 | 7.0 | | WDW | RIVER BANK |
| 5-11-95 | RFL-55-8216 | | | 500 | 40669 | 441 | 591 | 68.8 | 3.1 | ✓ | KC | 2'-4' SPS-G BHT#11 |
| 6-3-95 | VP479 | 5-10-95 | 5-14-95 | 600 | 64179 | 2764 | 538 | 119.3 | 5.1 | | WDW | RIVER BANK |
| 5-11-95 | RFL-55-8217 | | | 402 | 26101 | 1215 | 532 | 49.1 | 2.3 | - | KC | 4'-6' SPS-G BHT#11 |
| 6-3-95 | VP479 | 5-10-95 | 5-14-95 | 540 | 47855 | 2053 | 449 | 106.6 | 4.4 | ✓ | WDW | RIVER BANK |
| 5-11-95 | RFL-55-8218 | | | 502 | 13318 | 1388 | 664 | 20.1 | 2.1 | ✓ | KC | 6'-8' SPS-G BHT#11 |
| 6-3-95 | VP479 | 5-10-95 | 5-14-95 | 438 | 20276 | 1521 | 619 | 32.8 | 2.5 | ✓ | WDW | RIVER BANK |
| 5-11-95 | RFL-55-8219 | | | 404 | 5243 | 803.9 | 653 | 0.80 | 1.2 | ✓ | KC | 8'-10' SPS-G BHT#11 |
| 6-3-95 | VP479 | 5-10-95 | 5-14-95 | 542 | 894.5 | 732.5 | 494 | 1.8 | 1.5 | KC ✓ | WDW | RIVER BANK |
| 5-11-95 | RFL-55-8220 | | | 504 | 9376 | 1089 | 622 | 15.1 | 1.8 | ✓ | KC | 0-2' SPS-H |
| 6-3-95 | VP479 | 5-10-95 | 5-14-95 | 440 | 12567 | 1022 | 600 | 20.9 | 1.7 | ✓ | WDW | RIVER BANK |
| 5-11-95 | RFL-55-8221 | | | 406 | 51948 | 2071 | 596 | 87.2 | 3.5 | ✓ | KC | 2'-4' SPS-H BHT#11 |
| 6-3-95 | VP479 | 5-10-95 | 5-14-95 | 604 | 8981 | 3033 | 554 | 162.1 | 5.5 | ✓ | WDW | RIVER BANK |
| 5-11-95 | RFL-55-8222 | | | 506 | 8262 | 751.8 | 318 | 25.0 | 2.4 | ✓ | KC | 4'-6' SPS-H BHT#11 |
| 6-3-95 | VP479 | 5-10-95 | 5-14-95 | 544 | 12787 | 1176 | 280 | 45.7 | 4.2 | ✓ | WDW | RIVER BANK |
| 5-11-95 | RFL-55-8223 | | | 408 | 11322 | 1732 | 578 | 19.6 | 2.1 | ✓ | KC | 0-2' SPS-I BHT#11 |
| 6-3-95 | VP479 | 5-10-95 | 5-14-95 | 442 | 19915 | 1320 | 510 | 39.0 | 2.6 | ✓ | WDW | RIVER BANK |

SITE NAME: RFL, CO

Site Correction Factor = 1.8

VP Correction Factor (if applicable) = 1.7

Count Time = 500 Sec. unless otherwise noted

REVIEWED BY: *Robert R. Samuel* Site HP Manager

COPY



MK-FERGUSON COMPANY
A MORRISON KNUDSEN COMPANY

CWM Federal Environmental Services, Inc.

OCS SAMPLE LOG

SITE NAME Rifle, CO

| COUNT DATE INITIAL 20 DAY | SAMPLE ID DATE & LOCATION | DATE SAMPLED | DATE SEALED | OCS # INITIAL 20 DAY | BI-214 pCi INITIAL 20 DAY | TI-208 pCi INITIAL 20 DAY | MASS (grams) WET DRY | Pa-226 pCi/g INITIAL 20 DAY | Th-232 pCi/g INITIAL 20 DAY | DEPTH <15cm >15cm | TECH INITIAL 20 DAY | COMMENTS |
|---------------------------|---------------------------|--------------|-------------|----------------------|---------------------------|---------------------------|----------------------|-----------------------------|-----------------------------|-------------------|---------------------|------------------|
| 5-11-95 | RFL-55-8224 | 5-10-95 | 5-14-95 | 508 | 14857 | 1009 | 524 | 28.3 | 2.1 | ✓ | KC | 2'-4' SPS-I |
| 6-3-95 | U P479 | 5-10-95 | 5-14-95 | 606 | 26281 | 1465 | 457 | 57.5 | 3.2 | | WDW | River BANK BH#13 |
| 5-11-95 | RFL-55-8225 | 5-10-95 | 5-14-95 | 410 | 17157 | 970.0 | 569 | 30.2 | 1.7 | ✓ | KC | 4'-6' SPS-I |
| 6-3-95 | U P479 | 5-10-95 | 5-14-95 | 546 | 29108 | 1860 | 495 | 58.8 | 3.8 | ✓ | WDW | River BANK BH#13 |
| 5-11-95 | RFL-55-8226 | 5-10-95 | 5-14-95 | 510 | 19421 | 1157 | 506 | 38.4 | 2.3 | ✓ | KC | 0-2' SPS-I |
| 6-3-95 | U P479 | 5-10-95 | 5-14-95 | 444 | 32665 | 1765 | 448 | 72.9 | 3.9 | ✓ | WDW | River BANK BH#14 |
| 5-11-95 | RFL-55-8227 | 5-10-95 | 5-14-95 | 412 | 19494 | 1302 | 504 | 38.7 | 2.6 | ✓ | KC | 2'-4' SPS-I |
| 6-3-95 | U P479 | 5-10-95 | 5-14-95 | 608 | 29661 | 1159 | 455 | 65.2 | 2.5 | ✓ | WDW | River BANK BH#14 |
| 5-11-95 | RFL-55-8228 | 5-10-95 | 5-14-95 | 512 | 24768 | 1427 | 637 | 38.9 | 2.2 | ✓ | KC | 4'-6' SPS-I |
| 6-3-95 | U P479 | 5-10-95 | 5-14-95 | 548 | 33341 | 2034 | 615 | 54.2 | 3.3 | ✓ | WDW | River BANK BH#14 |
| 5-11-95 | RFL-55-8229 | 5-10-95 | 5-14-95 | 414 | 10979 | 821.4 | 456 | 24.1 | 1.8 | ✓ | KC | 0-2' SPS-I |
| 6-3-95 | U P479 | 5-10-95 | 5-14-95 | 446 | 19199 | 1066 | 378 | 50.8 | 2.8 | ✓ | WDW | River BANK BH#15 |
| 5-11-95 | RFL-55-8230 | 5-10-95 | 5-14-95 | 514 | 9818 | 1359 | 497 | 19.8 | 2.7 | ✓ | KC | 2'-4' SPS-I |
| 6-3-95 | U P479 | 5-10-95 | 5-14-95 | 610 | 17317 | 1224 | 428 | 40.5 | 2.9 | ✓ | WDW | River BANK BH#15 |
| 5-11-95 | RFL-55-8231 | 5-10-95 | 5-14-95 | 416 | 7119 | 786.5 | 433 | 16.4 | 1.8 | ✓ | KC | 0-2' SPS-I |
| 6-3-95 | U P479 | 5-10-95 | 5-14-95 | 550 | 11493 | 1301 | 384 | 29.9 | 3.4 | ✓ | WDW | River BANK BH#16 |
| 5-11-95 | RFL-55-8232 | 5-10-95 | 5-14-95 | 516 | 4065 | 886.8 | 547 | 8.5 | 1.6 | ✓ | KC | 2'-4' SPS-I |
| 6-3-95 | U P479 | 5-10-95 | 5-14-95 | 448 | 6398 | 970.0 | 513 | 12.5 | 1.9 | ✓ | WDW | River BANK BH#16 |
| 5-11-95 | RFL-55-8233 | 5-10-95 | 5-14-95 | 420 | 7275 | 891.3 | 564 | 12.9 | 1.6 | ✓ | KC | 4'-6' SPS-I |
| 6-3-95 | U P479 | 5-10-95 | 5-14-95 | 612 | 11445 | 1233 | 534 | 21.4 | 2.3 | ✓ | WDW | River BANK BH#16 |

Site Correction Factor = 1.8
 rp Correction Factor (if applicable) = 1.7
 Count Time = 500 Sec unless otherwise noted

REVIEWED BY: John R. [Signature]
 Site HP Manager

COPY

OCS SAMPLE LOG

RIFLE Co

| COUNT DATE INITIAL 20 DAY | SAMPLE ID & LOCATION | DATE SAMPLED | DATE SEALED | OCS # INITIAL 20 DAY | BI-214 PCI INITIAL 20 DAY | TI-208 PCI INITIAL 20 DAY | MASS (grams) WET DRY | RI-226 pCi/g INITIAL 20 DAY | TH-232 pCi/g INITIAL 20 DAY | DEPTH <15cm >15cm | TECH INITIAL 20 DAY | COMMENTS |
|---------------------------|----------------------|--------------|-------------|----------------------|---------------------------|---------------------------|----------------------|-----------------------------|-----------------------------|-------------------|---------------------|---------------------|
| 5-11-95 | RFL-55-8264 | 5-11-95 | | 482 | 287.6 | 1066 | 632 | 0.46 | 1.7 | ✓ | WDW | TH-230 C/F |
| 5-11-95 | K-22-13 | 5-11-95 | | 582 | 452.6 | 713.3 | 708 | 0.64 | 1.0 | ✓ | WDW | TH-230 C/F |
| 5-11-95 | RFL-55-8265 | 5-11-95 | | 484 | 553.7 | 707.8 | 747 | 0.74 | 0.95 | ✓ | WDW | TH-230 C/F |
| 5-11-95 | K-22-14 | 5-11-95 | | 584 | 551.5 | 828.9 | 737 | 0.75 | 1.1 | ✓ | WDW | TH-230 C/F |
| 5-11-95 | RFL-55-8266 | 5-11-95 | | 486 | 594.2 | 734.0 | 720 | 0.83 | 1.0 | ✓ | WDW | TH-230 C/F |
| 5-11-95 | K-23-01 | 5-11-95 | | 584 | 338.7 | 822.6 | 737 | 0.46 | 1.1 | ✓ | WDW | TH-230 C/F |
| 5-11-95 | RFL-55-8267 | 5-11-95 | | 488 | 335.2 | 1031 | 454 | 0.74 | 2.3 | ✓ | WDW | TH-230 C/F |
| 5-11-95 | K-23-06 | 5-11-95 | | 588 | 308.3 | 954.2 | 504 | 6.1 | 1.9 | ✓ | WDW | Sup. STD. "A" 0-2" |
| 5-11-95 | RFL-55-8269 | 5-11-95 | | 558 | 6031 | 1041 | 414 | 2.5 | 2.5 | ✓ | WDW | RIVER BANK. BH#3 |
| 5-11-95 | RFL-55-8270 | 5-11-95 | | 490 | 4778 | 970.0 | 593 | 8.1 | 1.6 | ✓ | WDW | Sup. STD. "A" 2-4" |
| 6-3-95 | VP 479 RR | 5-11-95 | 5-14-95 | 456 | 8250 | 786.5 | 488 | 16.9 | 1.6 | ✓ | WDW | RIVER BANK BH#3 |
| 5-11-95 | RFL-55-8272 | 5-11-95 | 5-14-95 | 590 | 3768 | 1128 | 673 | 5.6 | 1.7 | ✓ | WDW | Sup. STD. "A1" 0-2" |
| 6-3-95 | VP 479 RR | 5-11-95 | 5-14-95 | 620 | 6025 | 1048 | 572 | 10.5 | 1.8 | ✓ | WDW | RIVER BANK BH#2 |

REVIEWED BY: *John F. Finner*
Site HP Manager

COPY

Site Correction Factor = 1.8
VP Correction Factor (if applicable) = 1.7
Count Time = 500 SEC unless otherwise noted

OCS SAMPLE LOG

SITE NAME

RIFLE Co

| COUNT DATE INITIAL 20 DAY | SAMPLE ID & LOCATION | DATE SAMPLED | DATE SEALED | OCS # INITIAL 20 DAY | BI-214 pCi INITIAL 20 DAY | TI-208 pCi INITIAL 20 DAY | MASS (grams) WET DRY | Re-226 pCi/g INITIAL 20 DAY | Th-232 pCi/g INITIAL 20 DAY | DEPTH <15cm >15cm | TECH INITIAL 20 DAY | COMMENTS |
|---------------------------|----------------------|--------------|-------------|----------------------|---------------------------|---------------------------|----------------------|-----------------------------|-----------------------------|-------------------|---------------------|-----------------------|
| 5-11-95 | RFL-SS-8314 | 5-11-95 | 5-14-95 | 4032 | 1201 | 1119 | 700 | 1.7 | 1.6 | ✓ | WDM | Sup. STD. 4-6' "-I" |
| 6-3-95 | VP 479 RR 480 | 5-11-95 | 5-14-95 | 4658 | 902.4 | 1188 | 611 | 1.5 | 1.9 | ✓ | WDM | Top of Rock |
| 5-11-95 | RFL-SS-8315 | 5-11-95 | 5-14-95 | 5032 | 1754 | 973.5 | 702 | 2.5 | 1.4 | ✓ | WDM | Sup. STD. 4-6' "-I" |
| 6-3-95 | VP 479 RR 480 | 5-11-95 | 5-14-95 | 592 | 2626 | 1041 | 608 | 4.3 | 1.7 | ✓ | WDM | RIVER BANK |
| 5-11-95 | RFL-SS-8316 | 5-11-95 | 5-14-95 | 4034 | 4962 | 830.1 | 587 | 8.5 | 1.4 | ✓ | WDM | Sup. STD. 6-8' "-I" |
| 6-3-95 | VP 479 RR 480 | 5-11-95 | 5-14-95 | 490 | 8075 | 1241 | 491 | 16.4 | 2.5 | ✓ | WDM | RIVER BANK |
| 5-11-95 | RFL-SS-8317 | 5-11-95 | 5-14-95 | 5034 | 36819 | 1793 | 515 | 71.5 | 3.5 | ✓ | WDM | Sup. STD. 0-2' "A" |
| 6-3-95 | VP 479 RR 480 | 5-11-95 | 5-14-95 | 6018 | 59539 | 2244 | 424 | 140.4 | 5.3 | ✓ | WDM | RIVER BANK BH#5 |
| 5-11-95 | RFL-SS-8318 | 5-11-95 | 5-14-95 | 4036 | 22472 | 996.2 | 370 | 60.7 | 2.7 | ✓ | WDM | Sup. STD. 2-4' "A" |
| 6-3-95 | VP 479 RR 480 | 5-11-95 | 5-14-95 | 650 | 40526 | 1382 | 227 | 178.5 | 6.1 | ✓ | WDM | RIVER BANK BH#5 |
| 5-11-95 | RFL-SS-8319 | 5-11-95 | 5-14-95 | 5036 | 11262 | 1002 | 468 | 24.1 | 2.1 | ✓ | WDM | Sup. STD. 0-2' "B" |
| 6-3-95 | VP 479 RR 480 | 5-11-95 | 5-14-95 | 594 | 20071 | 1484 | 381 | 52.7 | 3.9 | ✓ | WDM | RIVER BANK BH#6 |
| 5-11-95 | RFL-SS-8320 | 5-11-95 | 5-14-95 | 4038 | 16065 | 1258 | 553 | 29.1 | 2.3 | ✓ | WDM | Sup. STD. "B" |
| 6-3-95 | VP 479 RR 480 | 5-11-95 | 5-14-95 | 492 | 28247 | 1521 | 486 | 58.3 | 3.1 | ✓ | WDM | 2-4' BH#6 |
| 5-11-95 | RFL-SS-8321 | 5-11-95 | 5-14-95 | 5038 | 28874 | 1494 | 600 | 48.1 | 2.5 | ✓ | WDM | Sup. STD. "B" |
| 6-3-95 | VP 479 RR 480 | 5-11-95 | 5-14-95 | 652 | 47667 | 1827 | 496 | 96.1 | 3.7 | ✓ | WDM | 4-6' BH#6 |
| 5-12-95 | RFL-SS-8322 | 5-11-95 | 5-14-95 | 4040 | 145.4 | 1180 | 513 | 0.28 | 2.3 | ✓ | WDM | Sup. STD. "B" |
| 6-3-95 | VP 479 RR 480 | 5-11-95 | 5-14-95 | 596 | 761.5 | 896.4 | 422 | 1.8 | 2.1 | ✓ | WDM | 6-8' BH#6 |
| 5-12-95 | RFL-SS-8323 | 5-11-95 | 5-14-95 | 5040 | 24730 | 1263 | 237 | 104.3 | 5.3 | ✓ | WDM | Sup. STD. "C" |
| 6-3-95 | VP 479 RR 480 | 5-11-95 | 5-14-95 | 494 | 50677 | 1800 | 149 | 340.1 | 12.1 | ✓ | WDM | 0-2' RIVER BANK. BH#7 |

Site Correction Factor = 1.8

VP Correction Factor (if applicable) = 1.7

Count Time = 500 SEC., unless otherwise noted

REVIEWED BY: *[Signature]*
Site RIP Manager

COPY

OCS SAMPLE LOG

SITE NAME: RIFLE CO

| COUNT DATE INITIAL 20 DAY | SAMPLE ID & LOCATION | DATE SAMPLED | DATE SEALED | OCS # INITIAL 20 DAY | BI-214 pCi INITIAL 20 DAY | TI-208 pCi INITIAL 20 DAY | MASS (grams) WET DRY | RA-226 pCi/g INITIAL 20 DAY | TR-232 pCi/g INITIAL 20 DAY | DEPTH <15cm >15cm | TECH INITIAL 20 DAY | COMMENTS |
|---------------------------|----------------------|--------------|-------------|----------------------|---------------------------|---------------------------|----------------------|-----------------------------|-----------------------------|-------------------|---------------------|-------------------------------------------|
| 5-12-95 | RFL-SS-8324 480 | 5-11-95 | 5-14-95 | 4042 | 25591 | 1267 | 338 | 75.7 | 3.7 | ✓ | W/D | Sup. STD. "C" 2-4' RIVER BANK BH#7 |
| 6-3-95 | VP 479 RR | 5-11-95 | 5-14-95 | 654 | 4893 | 1910 | 212 | 227.3 | 9.0 | ✓ | W/D | Sup. STD. "C" 4-6' RIVER BANK BH#7 |
| 5-12-95 | RFL-SS-8325 480 | 5-11-95 | 5-14-95 | 5042 | 6046 | 636.2 | 529 | 1.6 | 1.4 | ✓ | W/D | Sup. STD. "C" 6-8' RIVER BANK BH#7 |
| 6-3-95 | VP 479 RR | 5-11-95 | 5-14-95 | 598 | 760.5 | 751.8 | 461 | 0.96 | 1.7 | ✓ | W/D | Sup. STD. "D" 0-2' RIVER BANK BH#8 |
| 5-12-95 | RFL-SS-8326 480 | 5-11-95 | 5-14-95 | 4044 | 524.3 | 943.7 | 544 | 1.3 | 1.8 | ✓ | W/D | Sup. STD. "D" 2-4' RIVER BANK BH#8 |
| 6-3-95 | VP 479 RR | 5-11-95 | 5-14-95 | 496 | 493.3 | 955.5 | 377 | 0.99 | 1.5 | ✓ | W/D | Sup. STD. "D" 4-6' RIVER BANK BH#8 |
| 5-12-95 | RFL-SS-8327 480 | 5-11-95 | 5-14-95 | 5044 | 522.5 | 819.3 | 529 | 2.0 | 1.9 | ✓ | W/D | Sup. STD. "D" 6-8' RIVER BANK BH#8 |
| 6-5-95 | VP 479 RR | 5-11-95 | 5-14-95 | 500 | 780.2 | 722.9 | 381 | 188.0 | 6.2 | ✓ | W/D | Sup. STD. "D" 0-2' RIVER BANK BH#8 |
| 5-12-95 | RFL-SS-8328 480 | 5-11-95 | 5-14-95 | 4046 | 102470 | 3373 | 545 | 386.9 | 3.3 | ✓ | W/D | Sup. STD. "D" 4-6' RIVER BANK BH#8 |
| 6-5-95 | VP 479 RR | 5-11-95 | 5-14-95 | 400 | 179910 | 6493 | 465 | 54.1 | 6.0 | ✓ | W/D | Sup. STD. "D" 6-8' RIVER BANK BH#8 |
| 5-12-95 | RFL-SS-8329 480 | 5-11-95 | 5-14-95 | 5046 | 29559 | 1783 | 546 | 110.9 | 3.5 | ✓ | W/D | Sup. STD. "E" 0-2' RIVER BANK BH#9 |
| 6-5-95 | VP 479 RR | 5-11-95 | 5-14-95 | 502 | 51680 | 2805 | 466 | 76.7 | 7.3 | ✓ | W/D | Sup. STD. "E" 2-4' RIVER BANK BH#9 |
| 5-12-95 | RFL-SS-8330 480 | 5-11-95 | 5-14-95 | 4048 | 30362 | 1389 | 396 | 182.8 | 1.3 | ✓ | W/D | Sup. STD. "E" 0-2' RIVER BANK BH#9 |
| 6-5-95 | VP 479 RR | 5-11-95 | 5-14-95 | 402 | 58325 | 2324 | 319 | 13.3 | 2.3 | ✓ | W/D | Sup. STD. "F" 0-2' RIVER BANK BH#10 |
| 5-12-95 | RFL-SS-8331 480 | 5-11-95 | 5-14-95 | 5048 | 9109 | 1022 | 686 | 23.0 | 1.3 | ✓ | W/D | Sup. STD. "F" 2-4' RIVER BANK BH#10 |
| 6-5-95 | VP 479 RR | 5-11-95 | 5-14-95 | 504 | 14129 | 1407 | 665 | 0.99 | 1.5 | ✓ | W/D | Sup. STD. "F" 6-8' RIVER BANK BH#10 |
| 5-12-95 | RFL-SS-8332 480 | 5-11-95 | 5-14-95 | 4050 | 5894 | 751.5 | 593 | 2.2 | 1.3 | ✓ | W/D | Sup. STD. "F" 0-2' RIVER BANK BH#10 |
| 6-5-95 | VP 479 RR | 5-11-95 | 5-14-95 | 404 | 862.7 | 611.7 | 395 | 52.8 | 2.8 | ✓ | W/D | Sup. STD. "F" 6-8' RIVER BANK BH#10 |
| 5-12-95 | RFL-SS-8333 480 | 5-11-95 | 5-14-95 | 5050 | 36337 | 1947 | 688 | 93.6 | 4.7 | ✓ | W/D | Sup. STD. "F" 0-2' RIVER BANK BH#10 |
| 6-5-95 | VP 479 RR | 5-11-95 | 5-14-95 | 506 | 58577 | 2930 | 626 | | | ✓ | W/D | |

REVIEWED BY: Robert J. Starnes
Site HP Manager

COPY

Site Correction Factor = 1.8
 VP Correction Factor (if applicable) = 1.7
 Count Time = 500 SEC, unless otherwise noted



MK-FERGUSON COMPANY
A MORRISON KRUGSEN COMPANY



CWM Federal Environmental Services, Inc.

OCS SAMPLE LOG

RIFLE Co

SITE NAME


| COUNT DATE INITIAL 20 DAY | SAMPLE ID & LOCATION | DATE SAMPLED | DATE SEALED | DCS # INITIAL 20 DAY | BI-214 pCi INITIAL 20 DAY | TI-208 pCi INITIAL 20 DAY | MASS (grams) WET DRY | Pa-226 pCi/g INITIAL/CORR 20 DAY | Th-232 pCi/g INITIAL 20 DAY | DEPTH <15cm >15cm | TECH INITIAL 20 DAY | COMMENTS |
|---------------------------|----------------------|--------------|-------------|----------------------|---------------------------|---------------------------|----------------------|----------------------------------|-----------------------------|-------------------|---------------------|-------------------------------------|
| 5-12-95 | RFL-SS-8334 | 5-11-95 | 5-14-95 | 4052 | 48897 | 1861 | 455 | 107.5 | 4.1 | ✓ | W/DW | Sup. STD. "F" 2-4' RIVER BANK BH#10 |
| 6-5-95 | VP 479 RR | 5-11-95 | 5-14-95 | 406 | 92967 | 2971 | 336 | 276.7 | 8.8 | ✓ | W/DW | Sup. STD. "F" 4-6' RIVER BANK BH#10 |
| 5-15-95 | K-8-6 | 5-15-95 | 5-15-95 | | | | | | | | | |
| 5-15-95 | RFL-SS-8343 | 5-15-95 | 5-15-95 | | | | | | | | | |
| 5-15-95 | K-8-7 | 5-15-95 | 5-15-95 | | | | | | | | | |

Site Correction Factor = 1.8
VP Correction Factor (if applicable) = 1.7 unless otherwise noted

COPY


REVIEWED BY:

Robert Stenzel
Site HP Manager

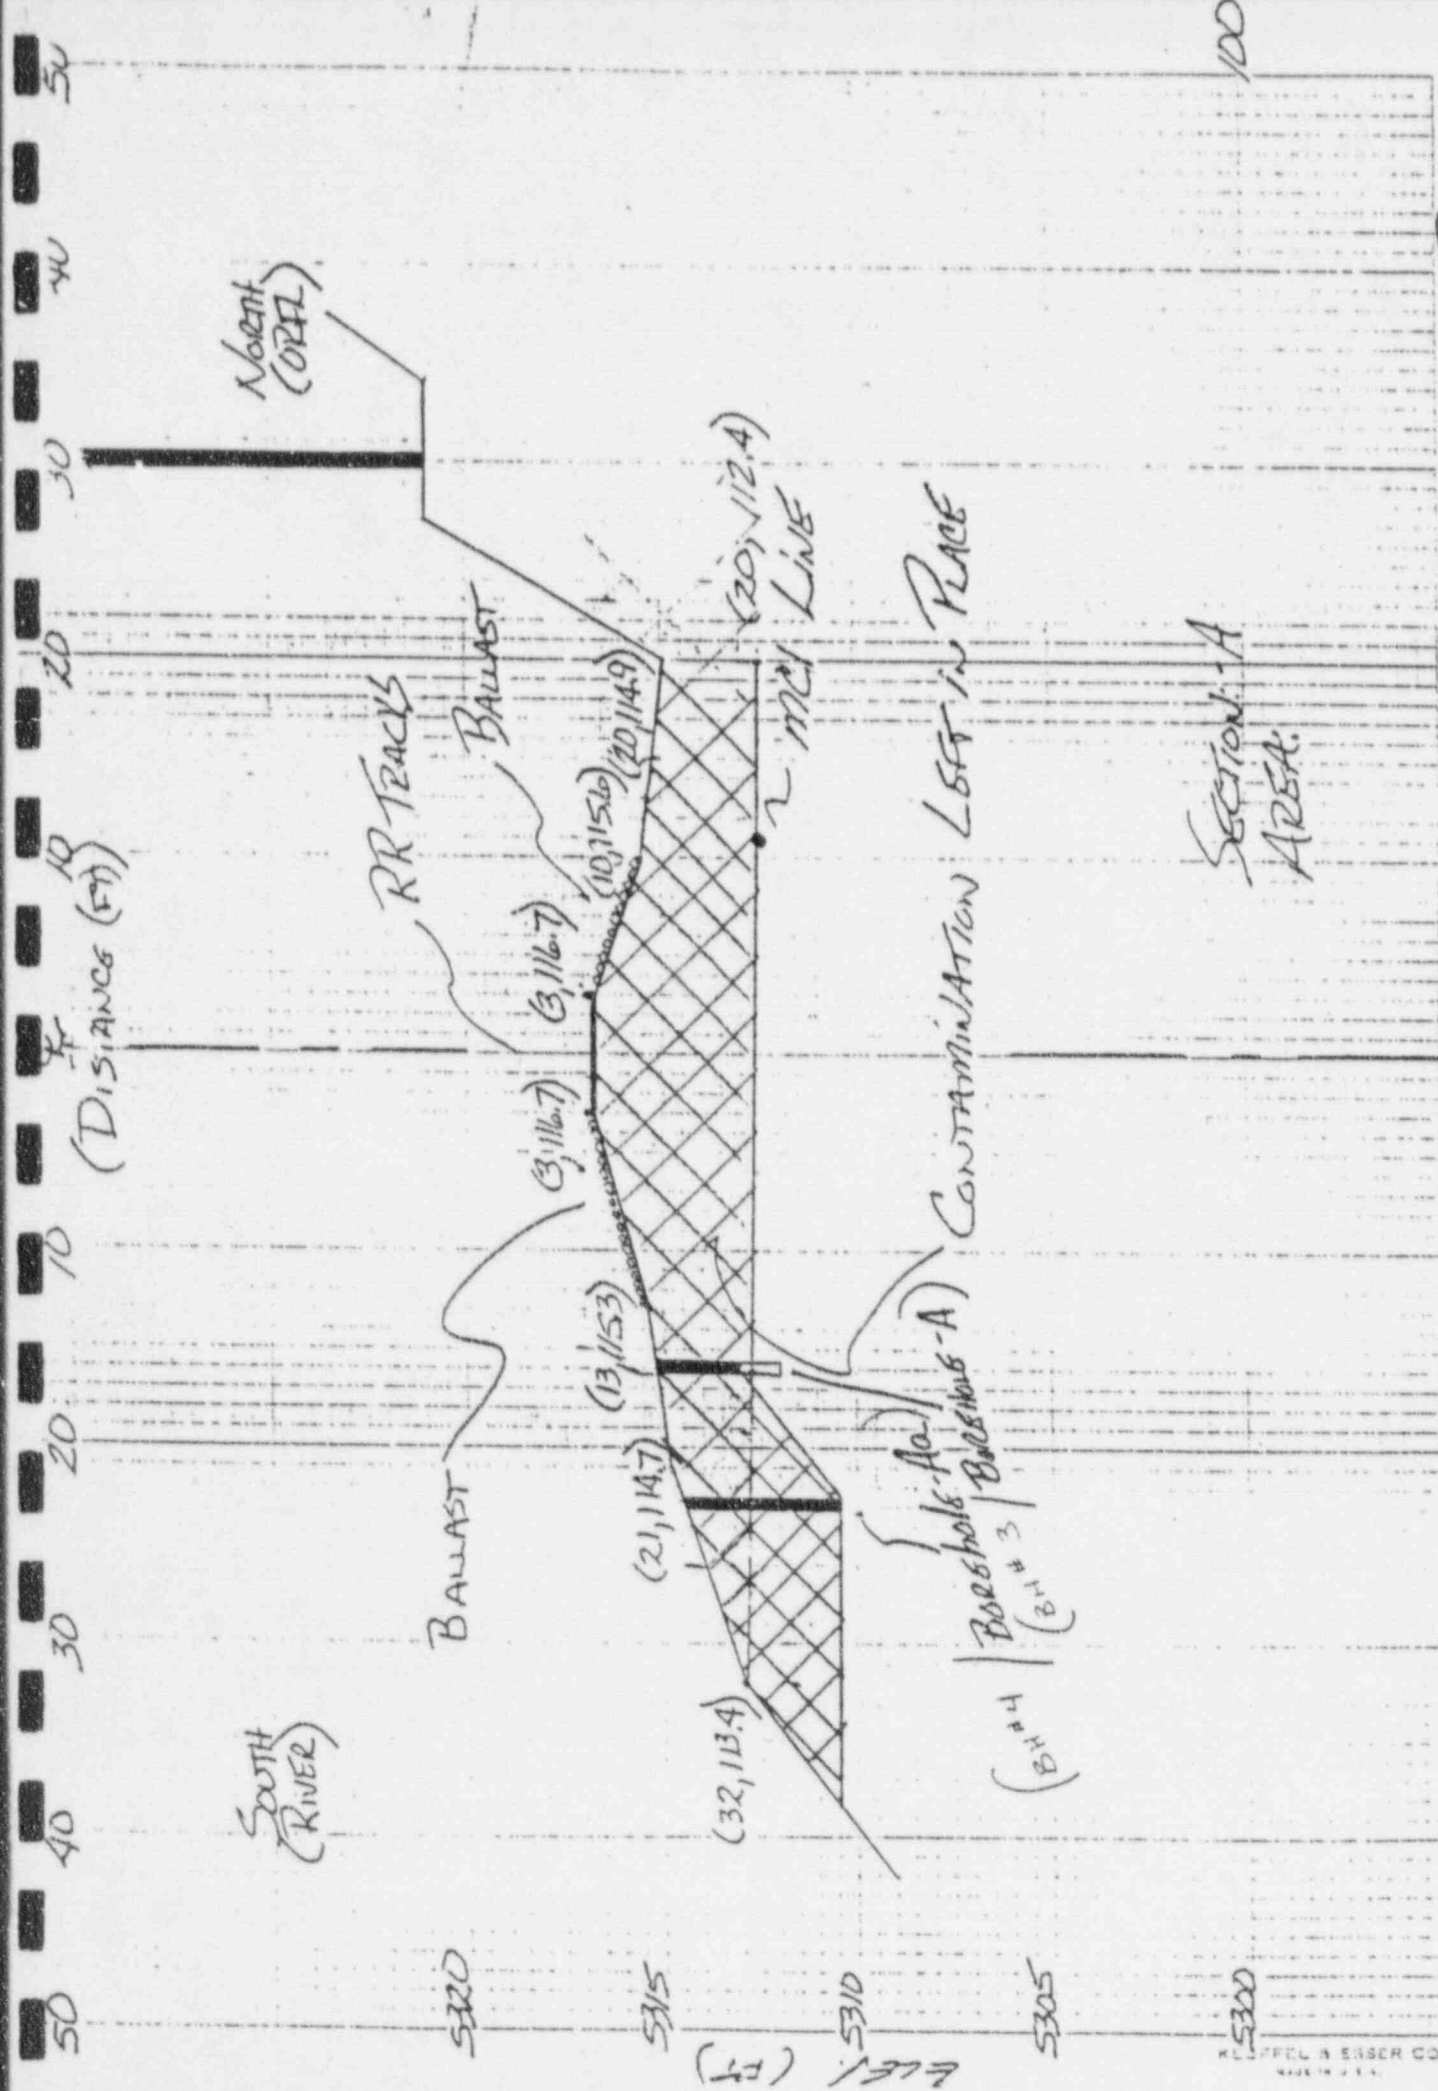


SUPPLEMENTAL STANDARDS

OLD RIFLE - RAILROAD RIGHT OF WAY - RF-480

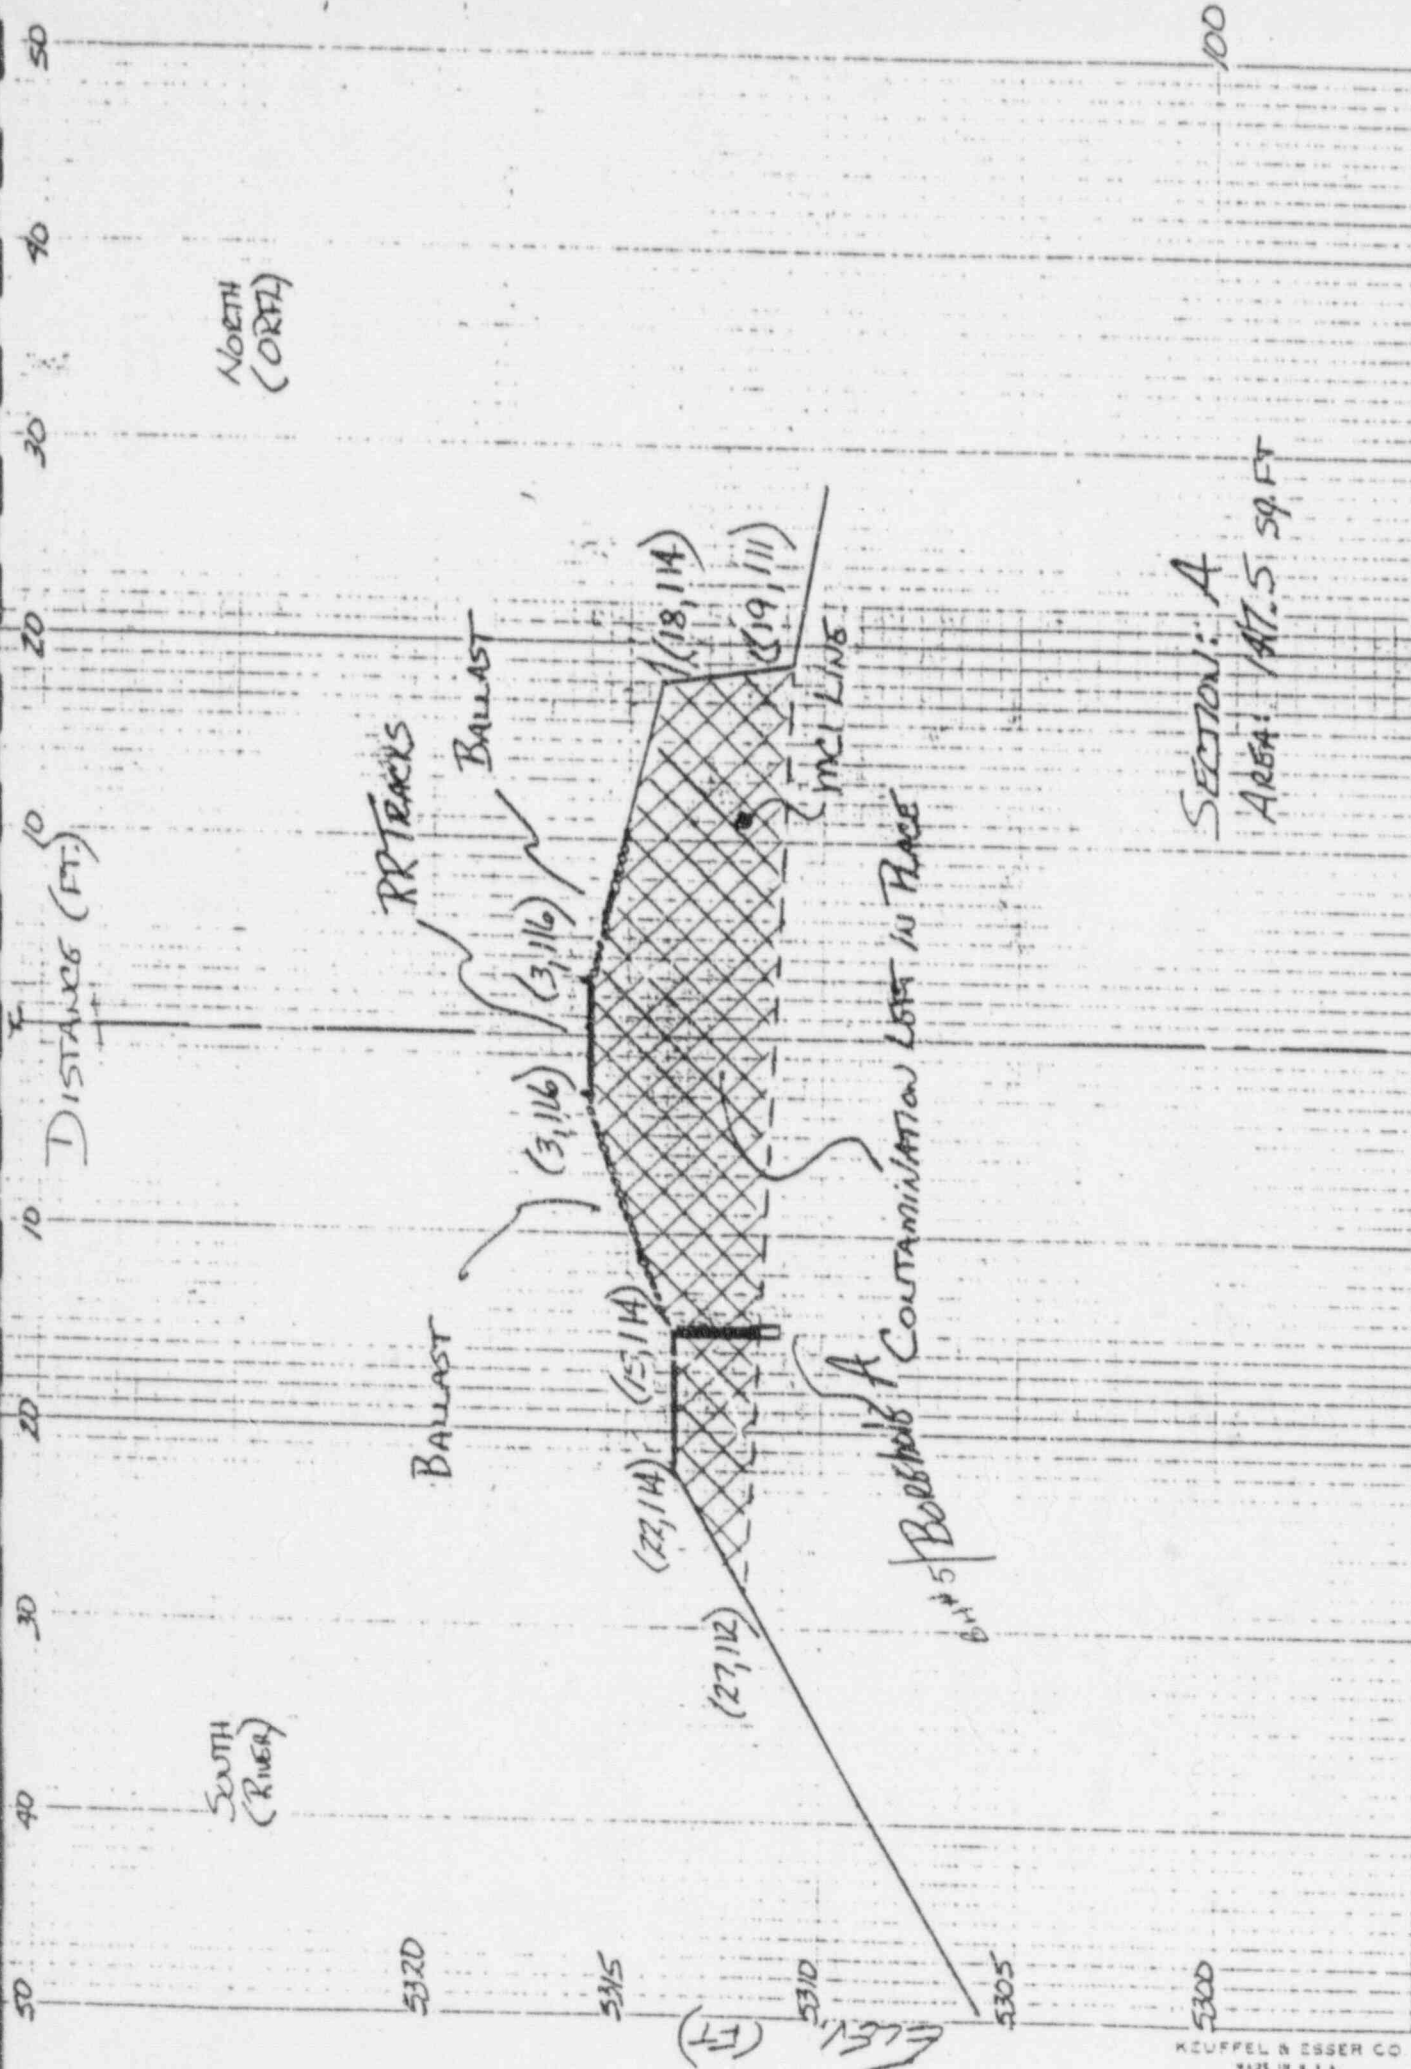

OLD RIFLE - RAILROAD RIGHT OF WAY - RF-480 SUPPLEMENTAL STANDARDS

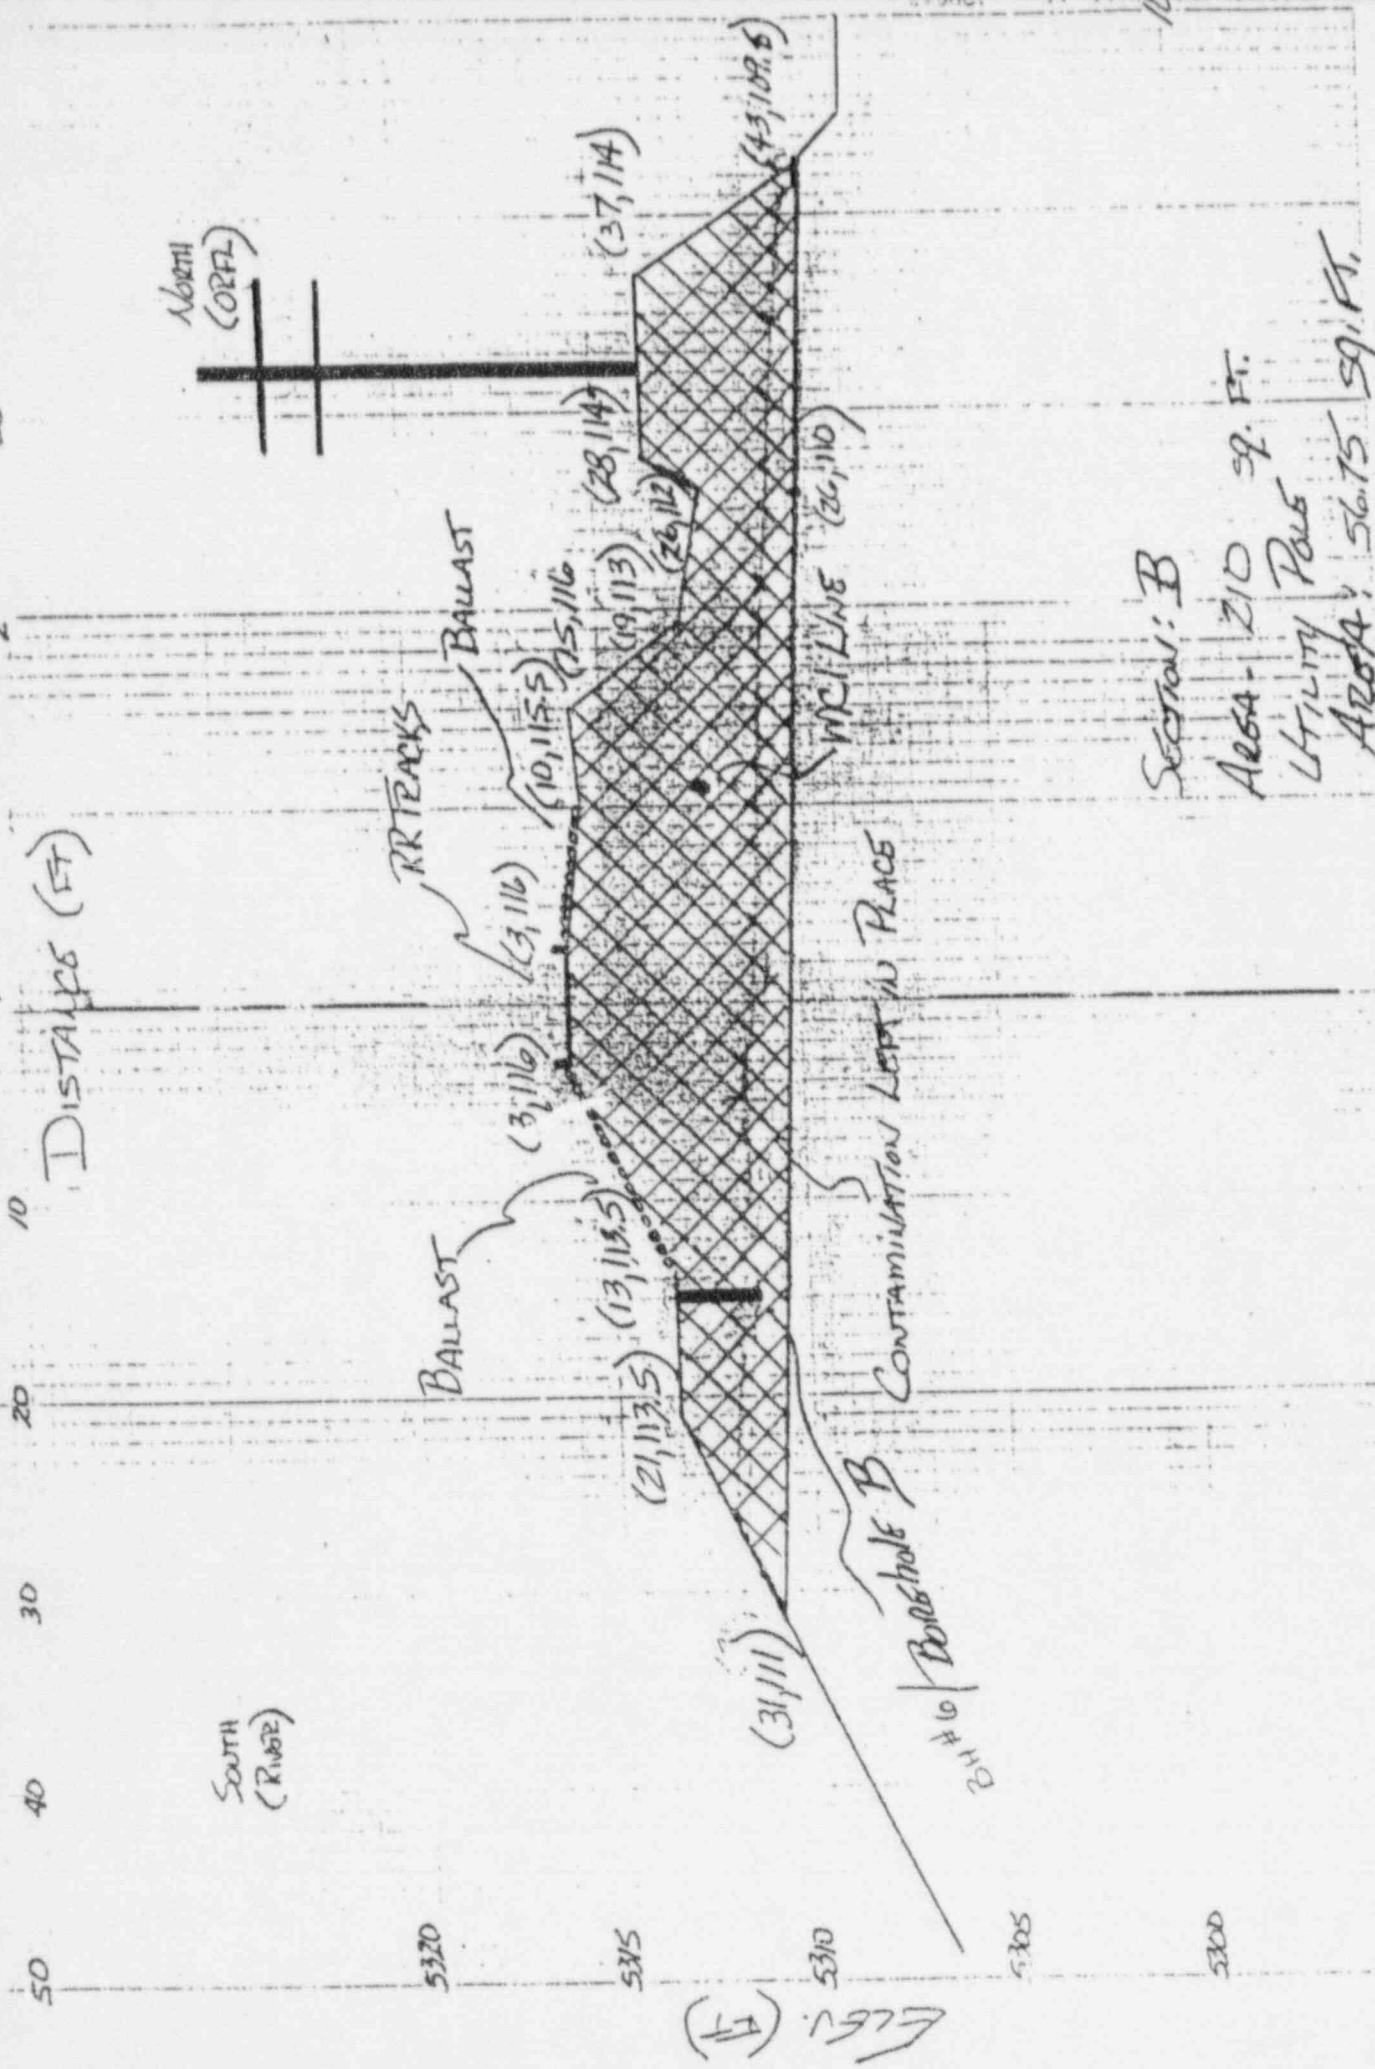

Section: B
 Area: 210 sq. ft.
 Utility Pole
 AREA: 56.75 sq. ft.
 SUPPLEMENTAL STANDARDS


OLD RIFLE - RAILROAD RIGHT OF WAY - RF-480

50 40 30 20 10 DISTANCES (FT) 10 20 30 40 50




ELEV. (FT)
5320
5315
5310
5305
5300

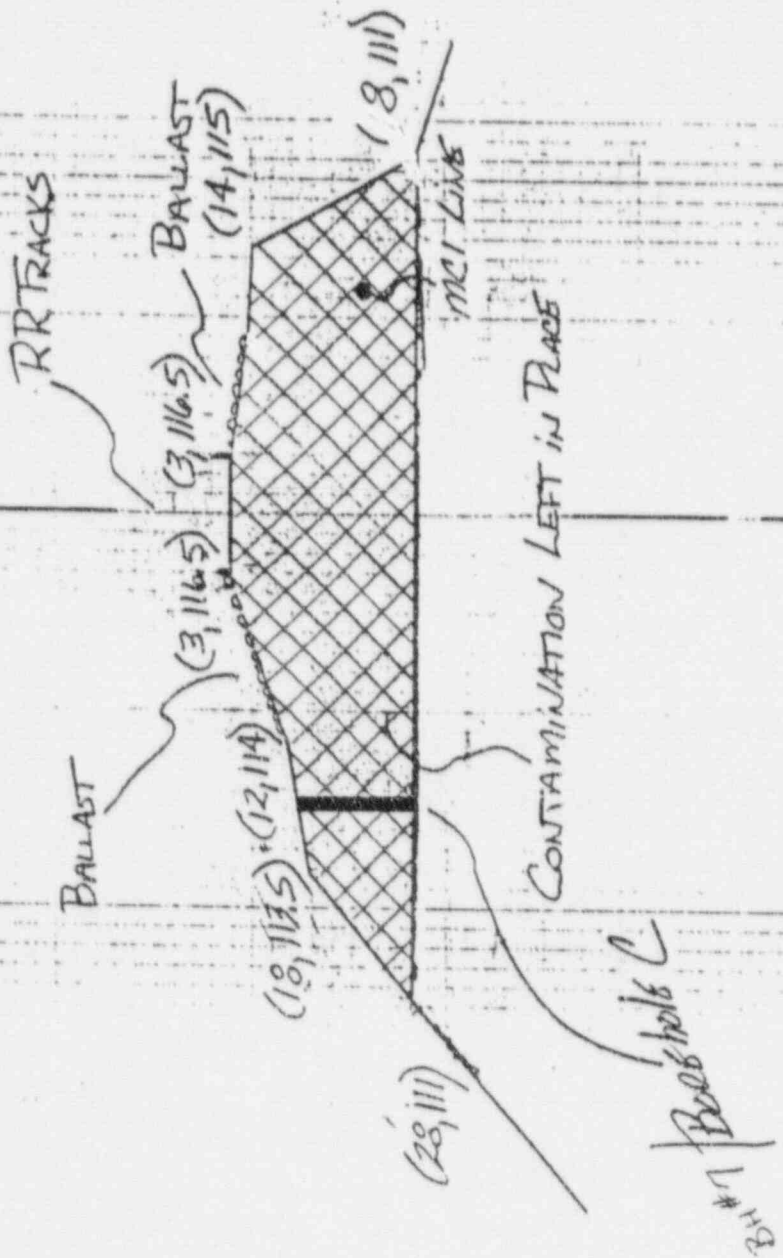

SECTION: C
AREA - 100.5 sq. FT.

OLD RIFLE - RAILROAD RIGHT OF WAY - RF-480 SUPPLEMENTAL STANDARDS

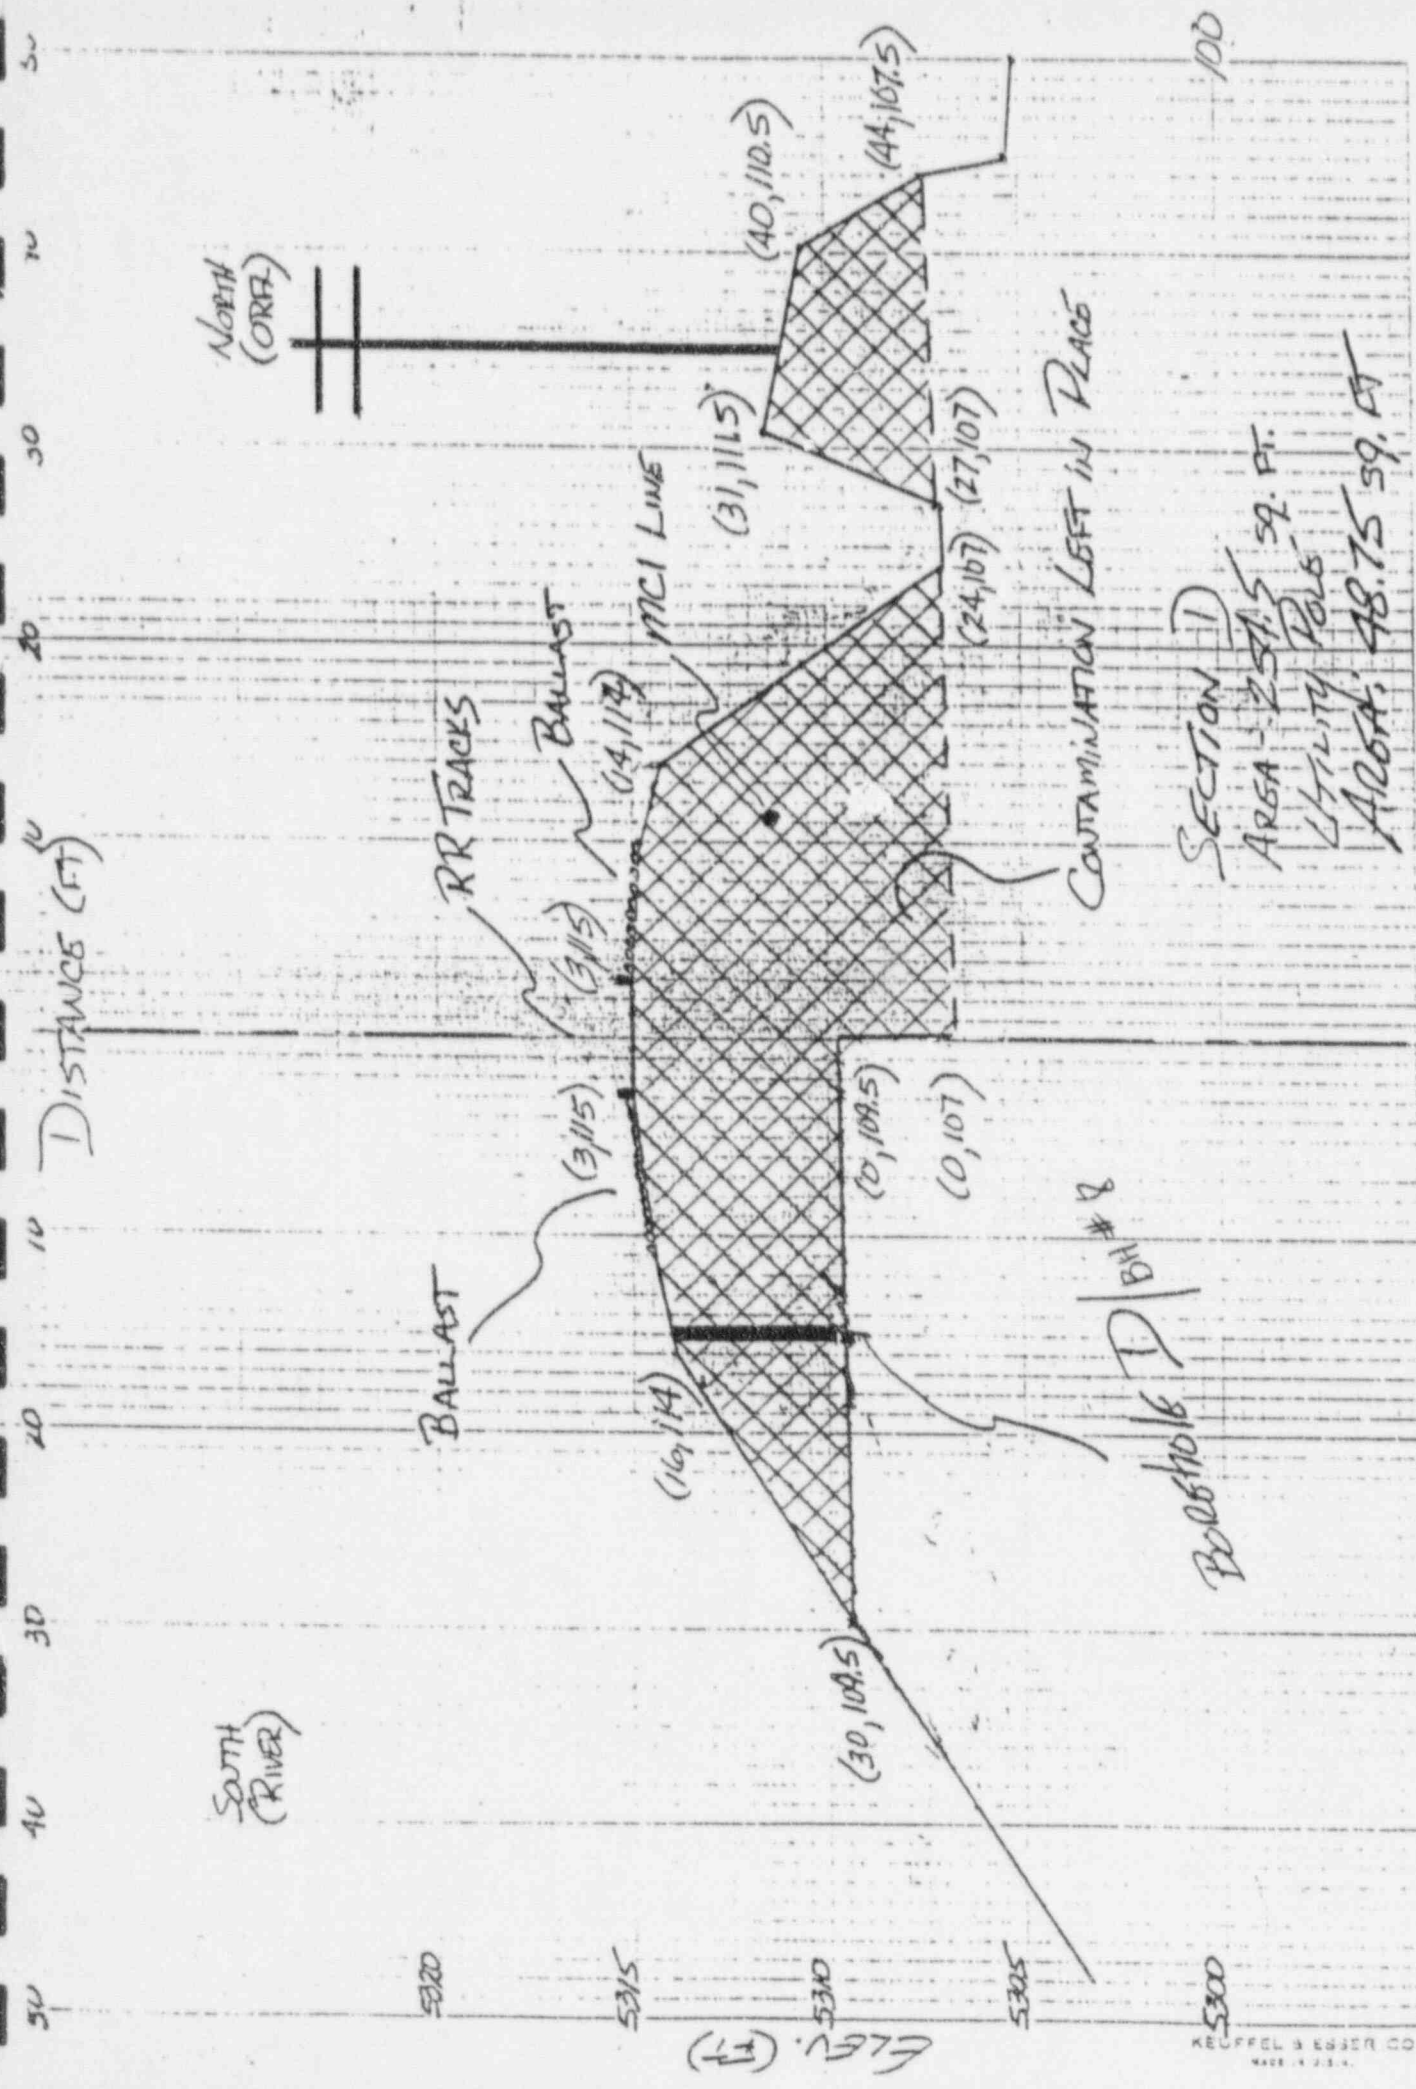


SECTION D

 UTILITY POLE
 AREA: 48.75 SQ. FT

SUPPLEMENTAL STANDARDS

OLD RIFLE - RAILROAD RIGHT OF WAY - RF-180

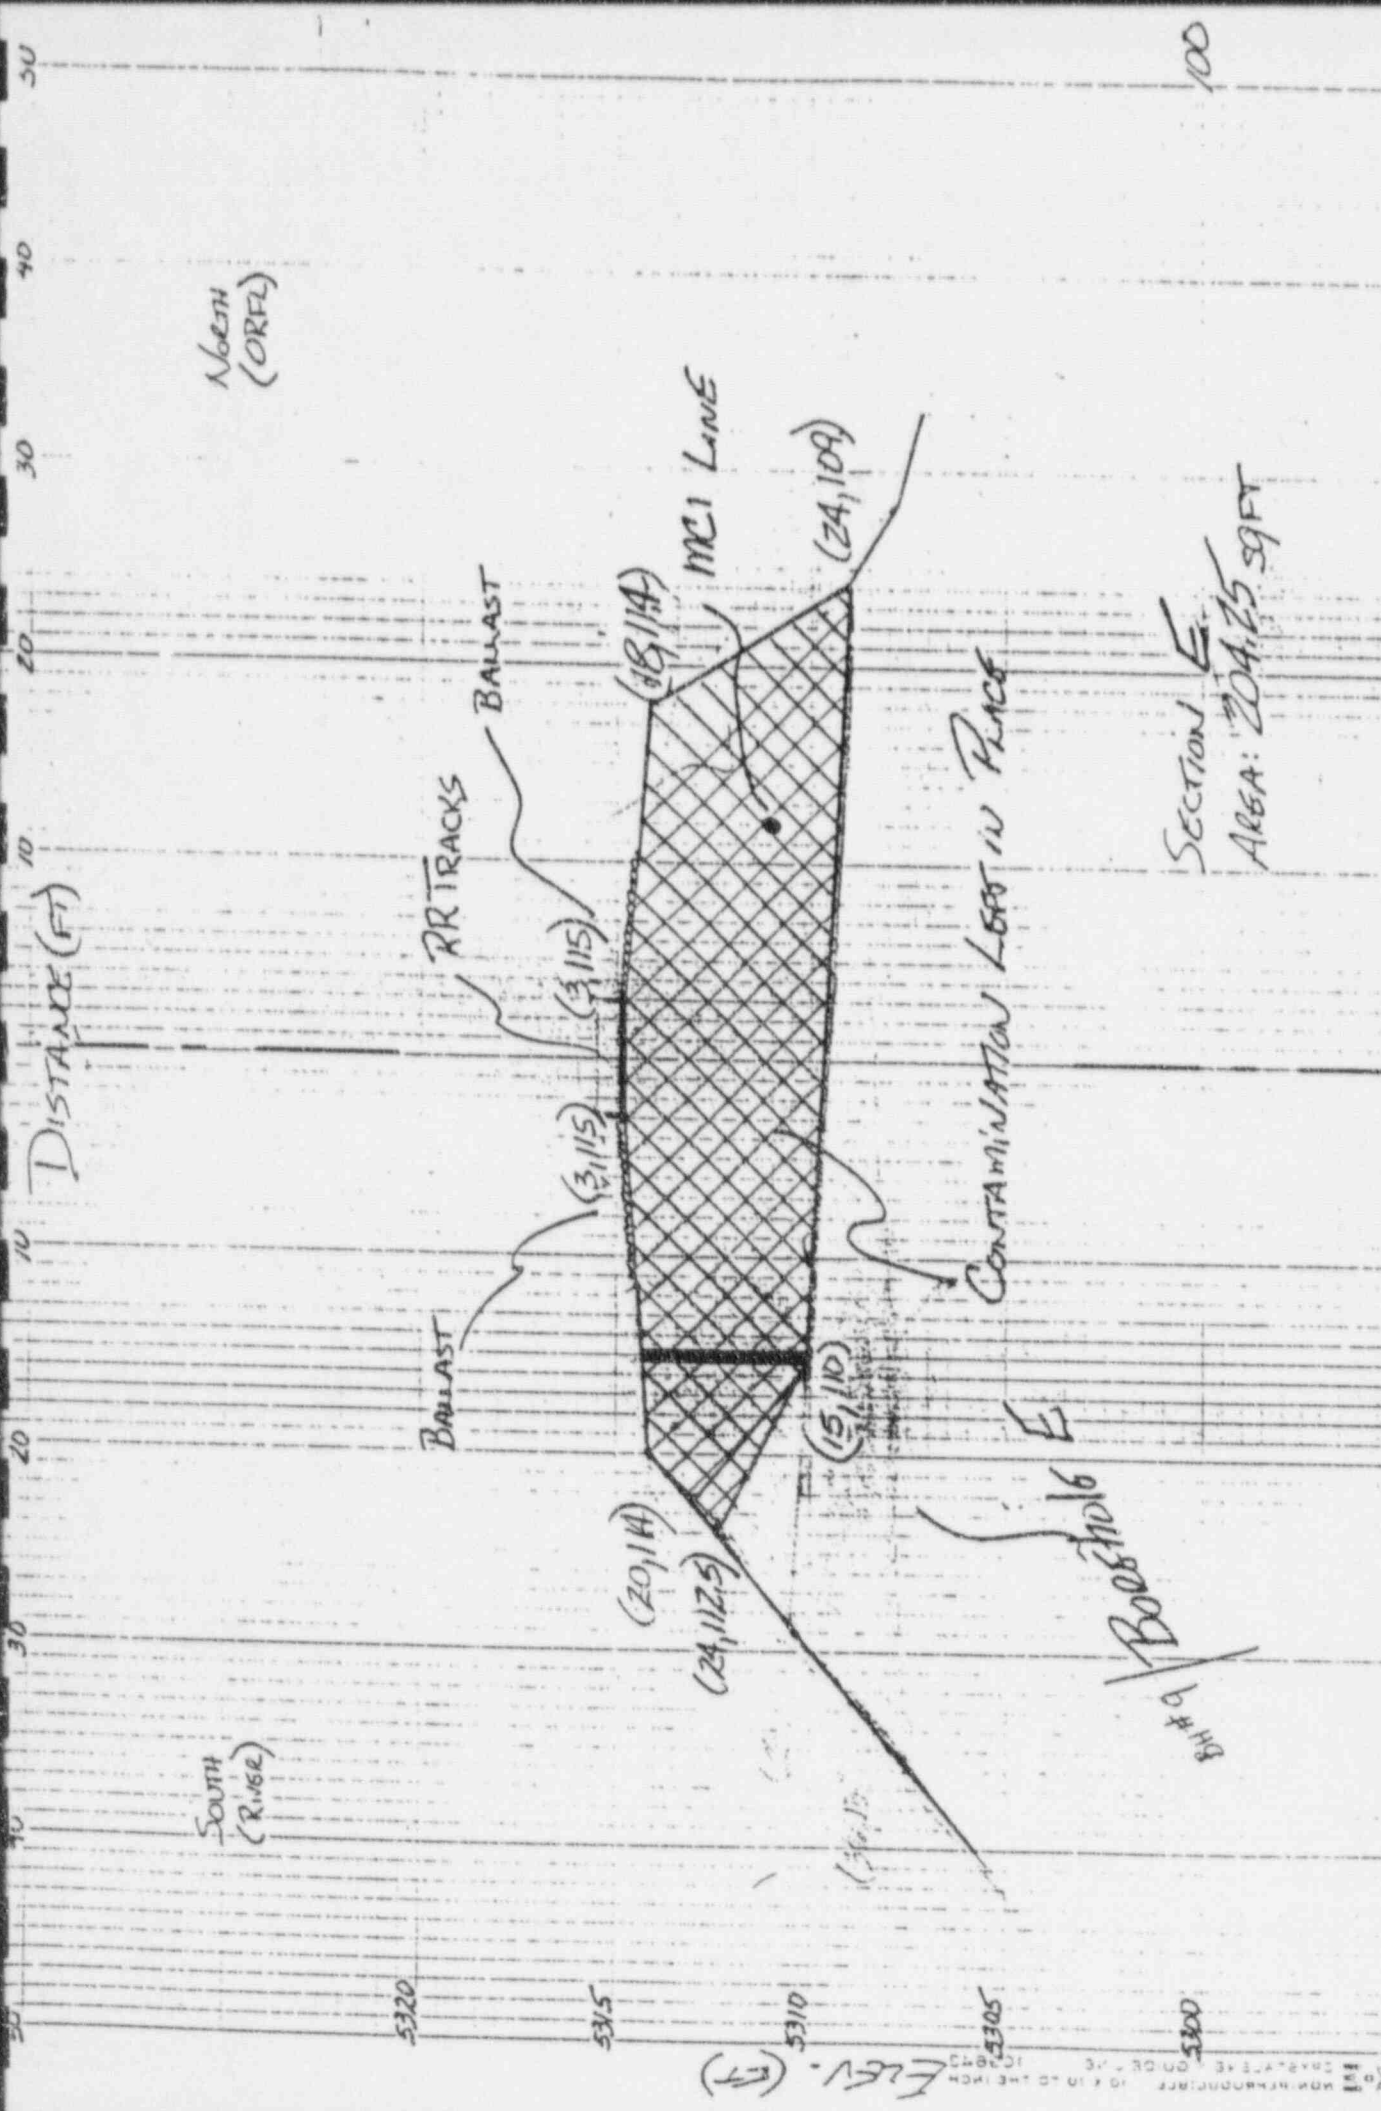

OLD RIFLE - RAILROAD RIGHT OF WAY - RI-480 SUPPLEMENTAL STANDARDS

DISTANCE (FT)


North (REF)

5320

5315

5310

5305

5300

BALLAST

RR TRACKS BALLAST

(14, 114)

(18, 114)

(37, 113)

(46, 116)

MCI LINE

(27, 110)

CONTAMINATION LEFT IN PLACE

(32, 107)

BH #10 Borehole



(55, 106)

(FT) (Elev)

SECTION: F
AREA: 259.0 SQ. FT.
UTILITY POLE
AREA: 95 SQ. FT.

Old Right - RAILROAD RIGHT OF WAY - RF 480

SUPPLEMENTAL STANCHION

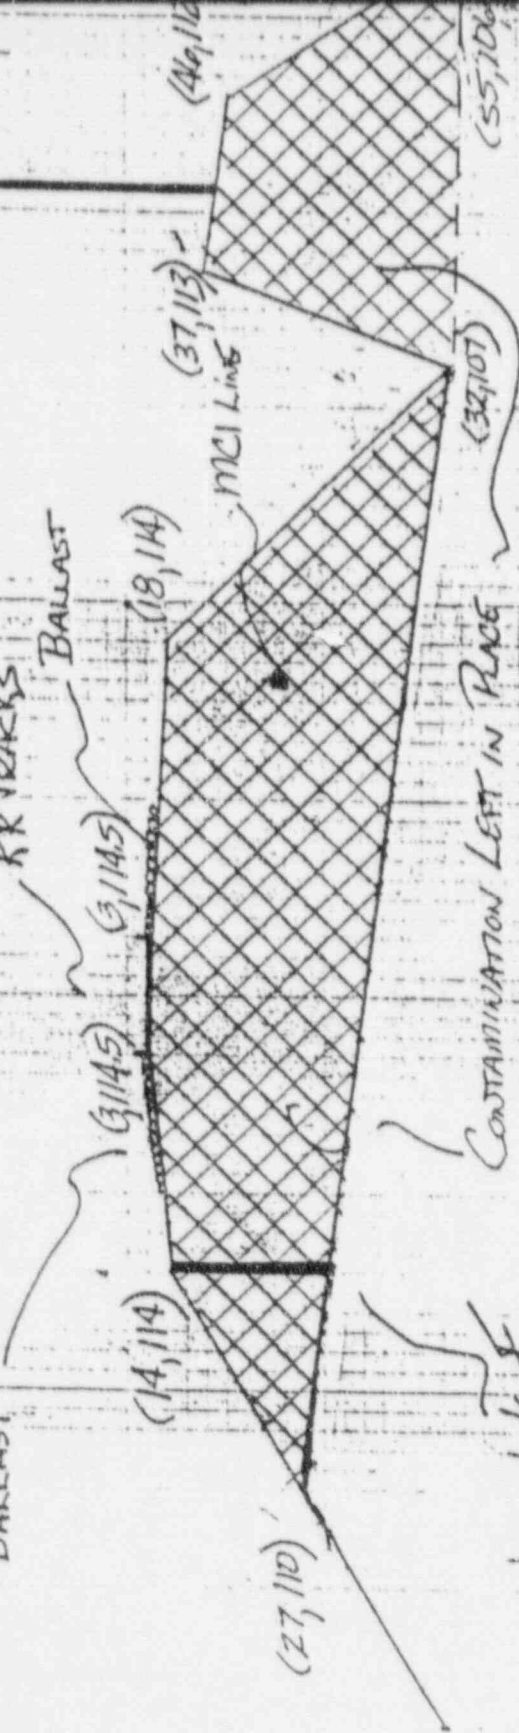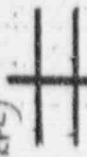


50 40 30 20 10 DISTANCE (FT) 10

North (ORFL)

South (RIVER)


5320 5315 5310 5305 5300 ELEV. (FT)

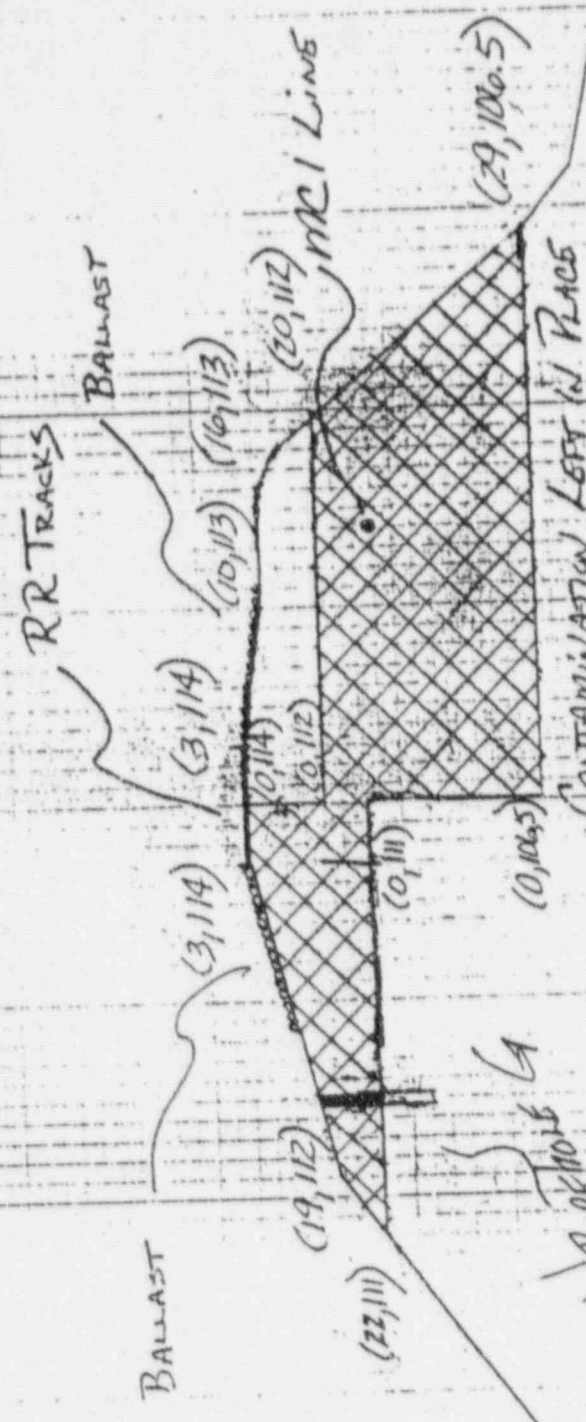


SECTION: GA
AREA: 177.25 SQ. FT

SUPPLEMENTAL STANDARDS

Old Field - Railroad Right of Way - RF-480

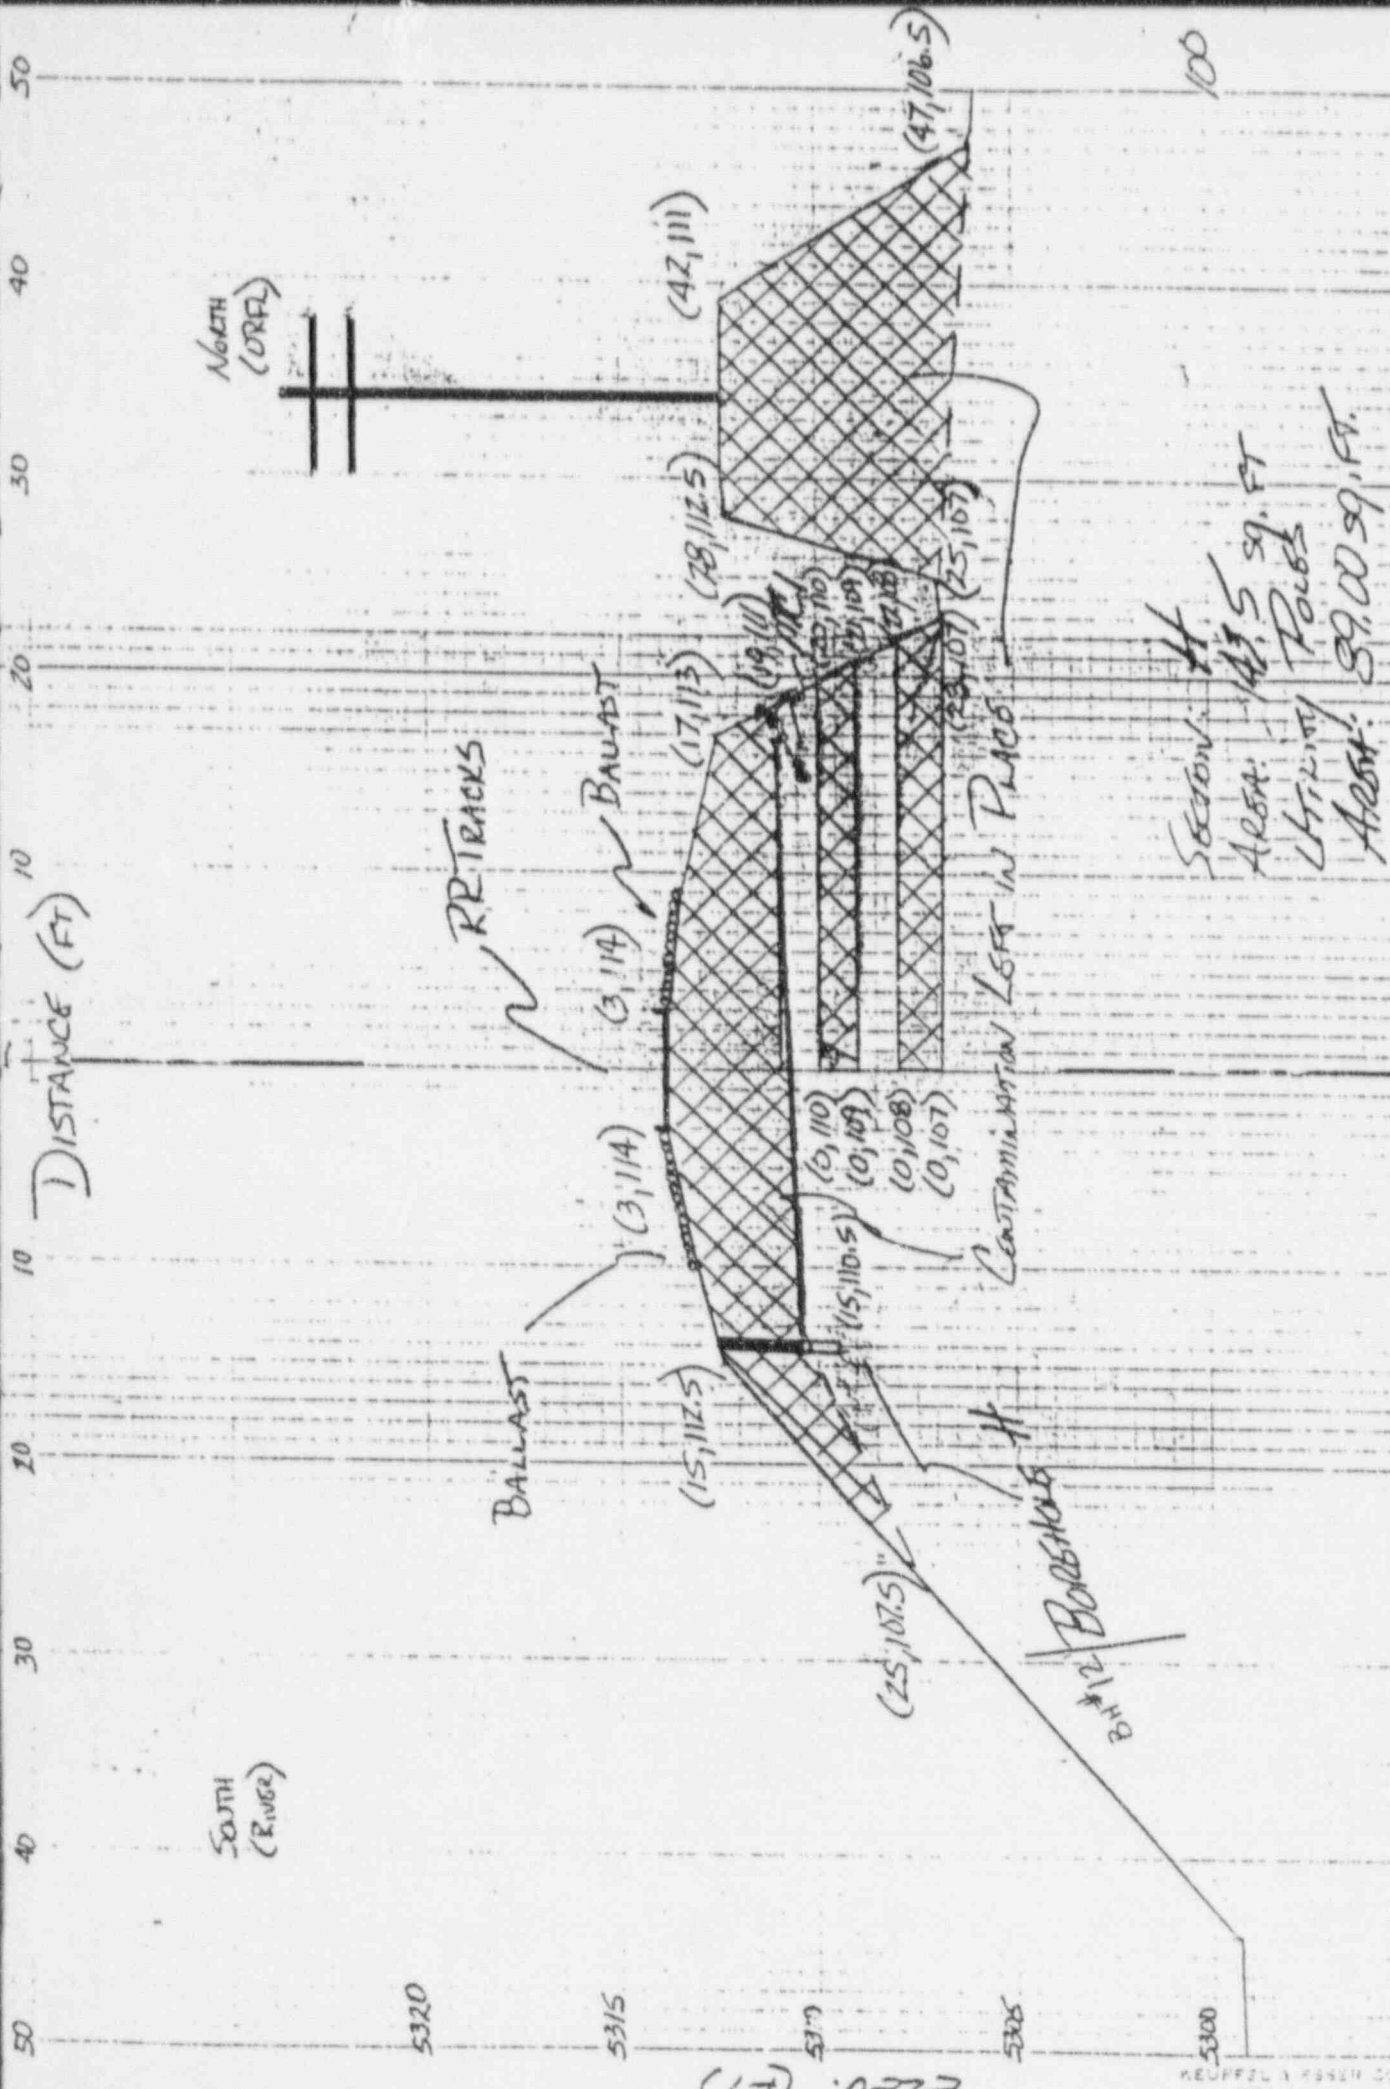


OLD RIFLE - RAILROAD RIGHT OF WAY - RF-480
 SUPPLEMENTAL STANDARDS

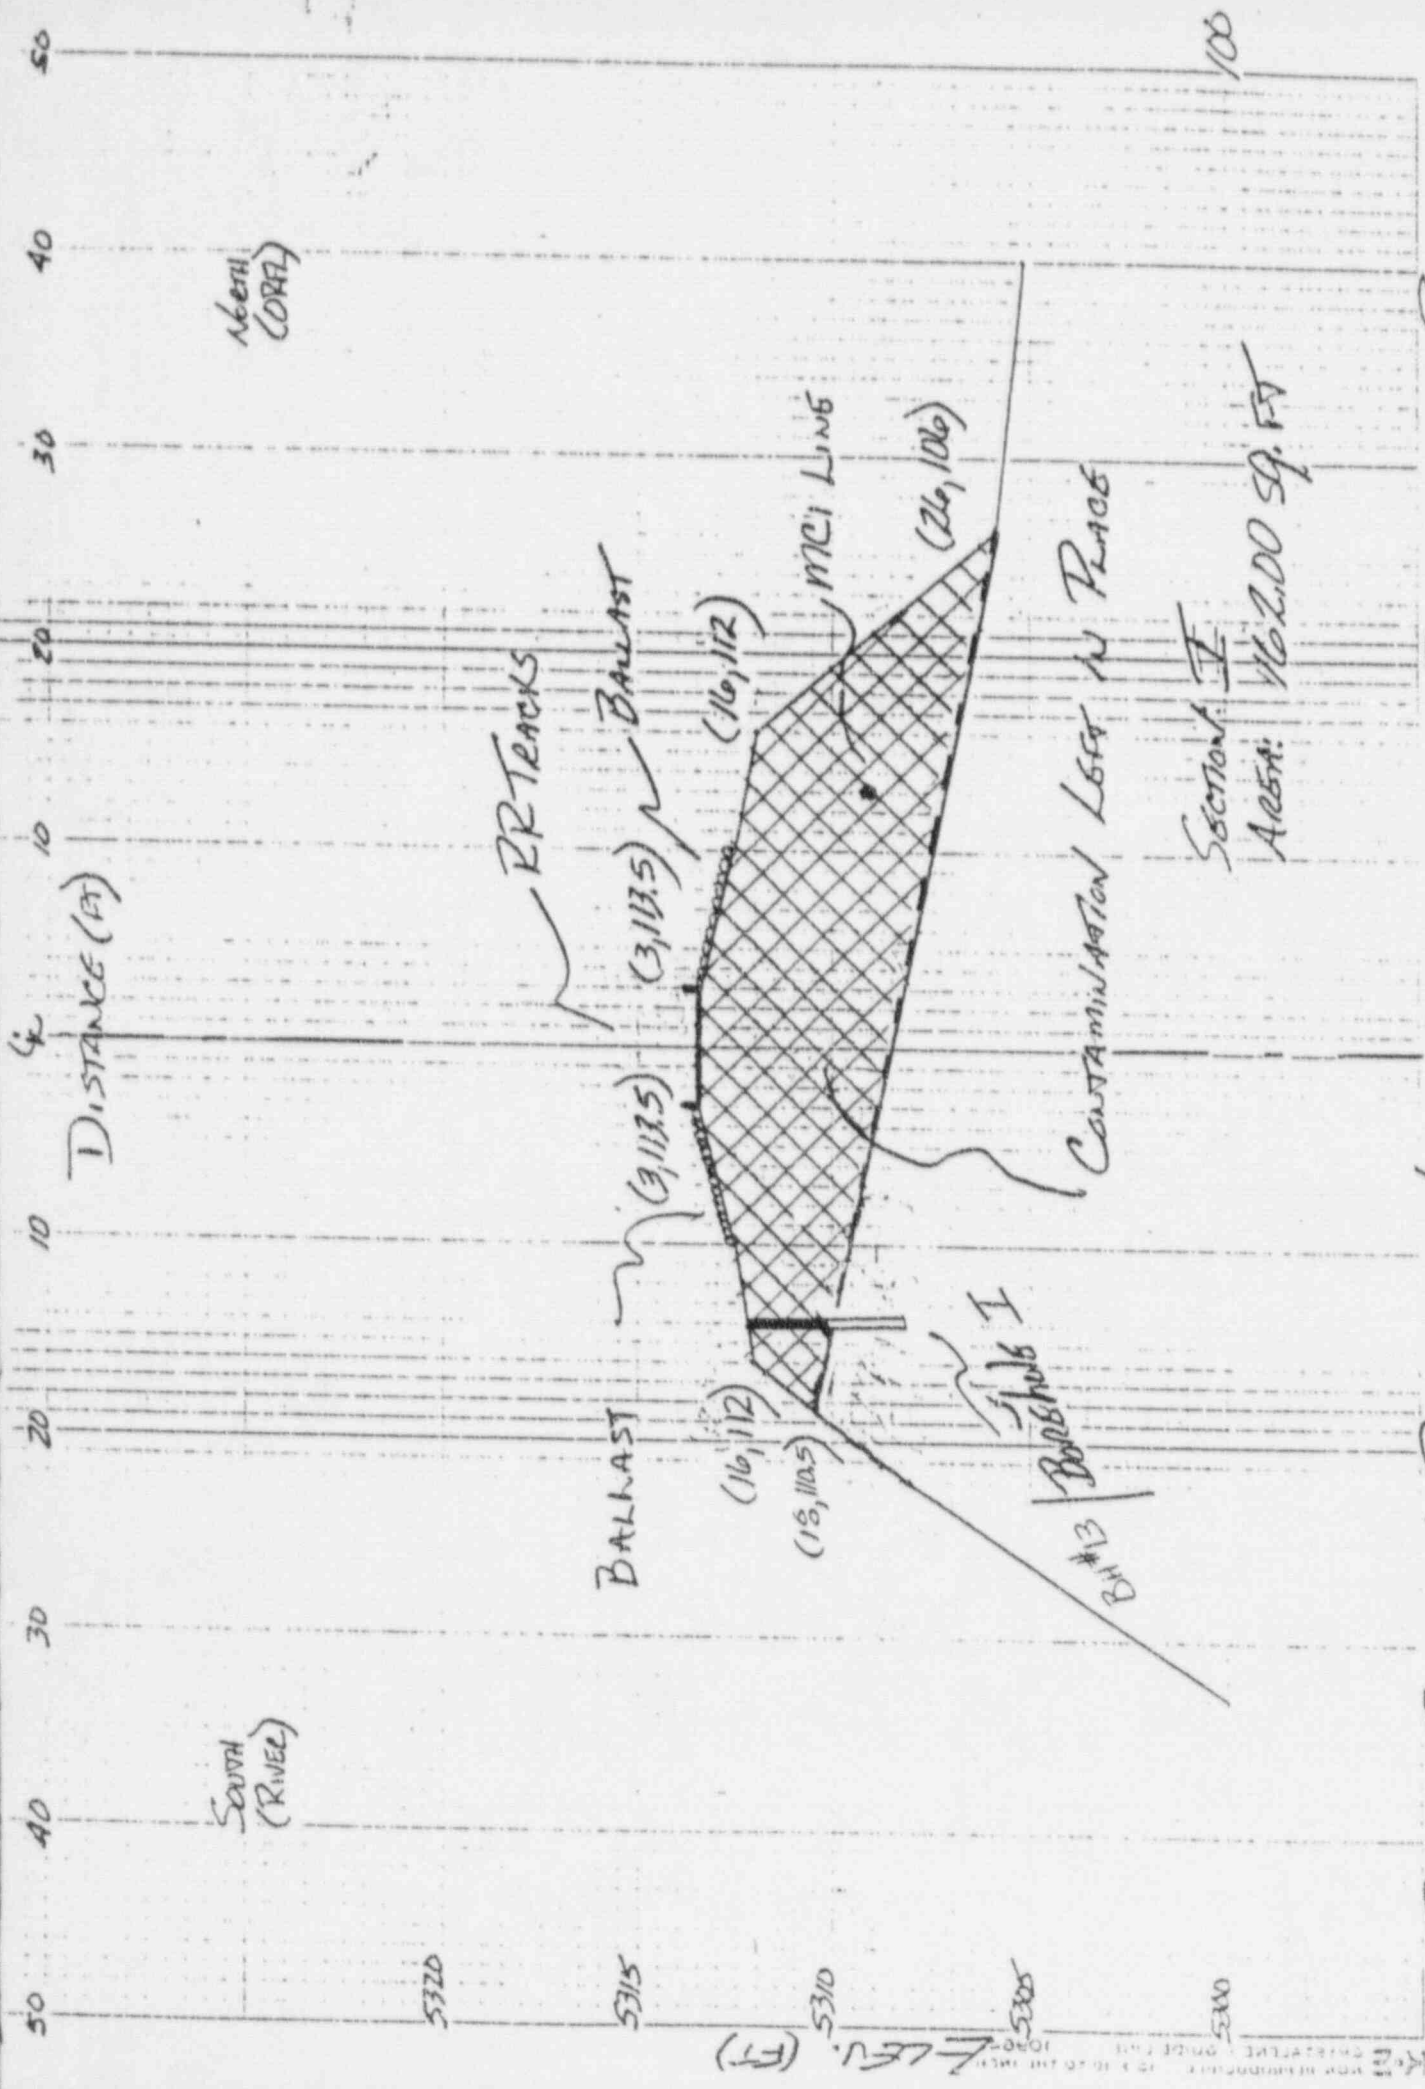

SECTION I

SUPPLEMENTAL STANDARDS

OLD RIFLE - RAILROAD RIGHT OF WAY - RF 480

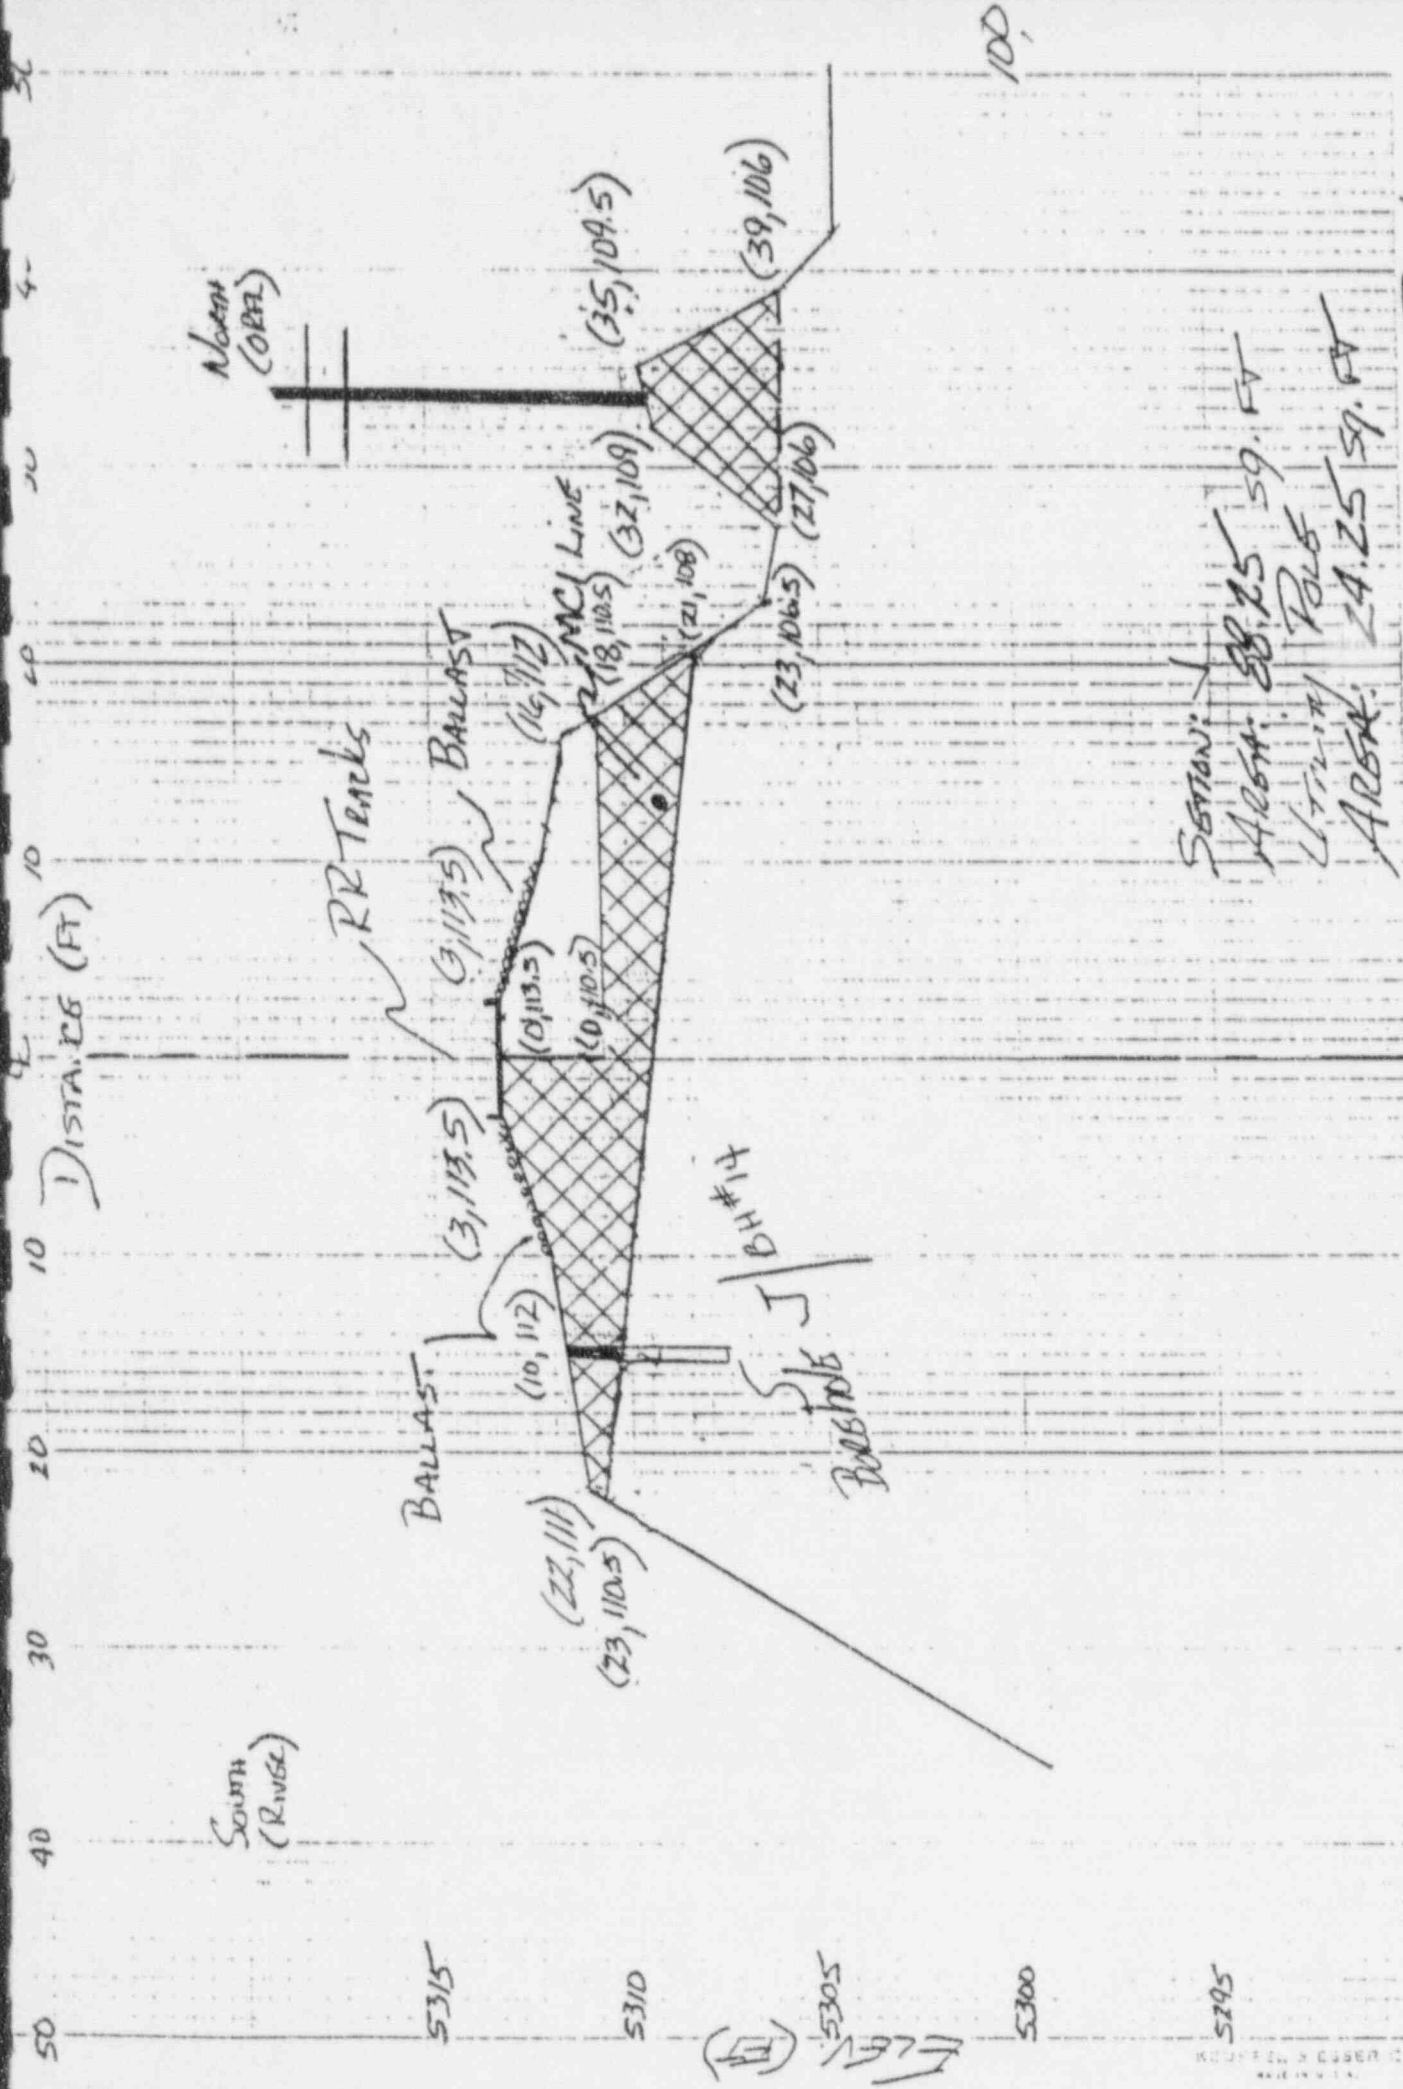

 UTILITY POLE
 AREA: 24.25 59. FT

SUPPLEMENTAL STANDARD

OLD RIFLE - RAILROAD RIGHTS OF WAY - RF-400

5315

5310


5305

5300

5295


1571


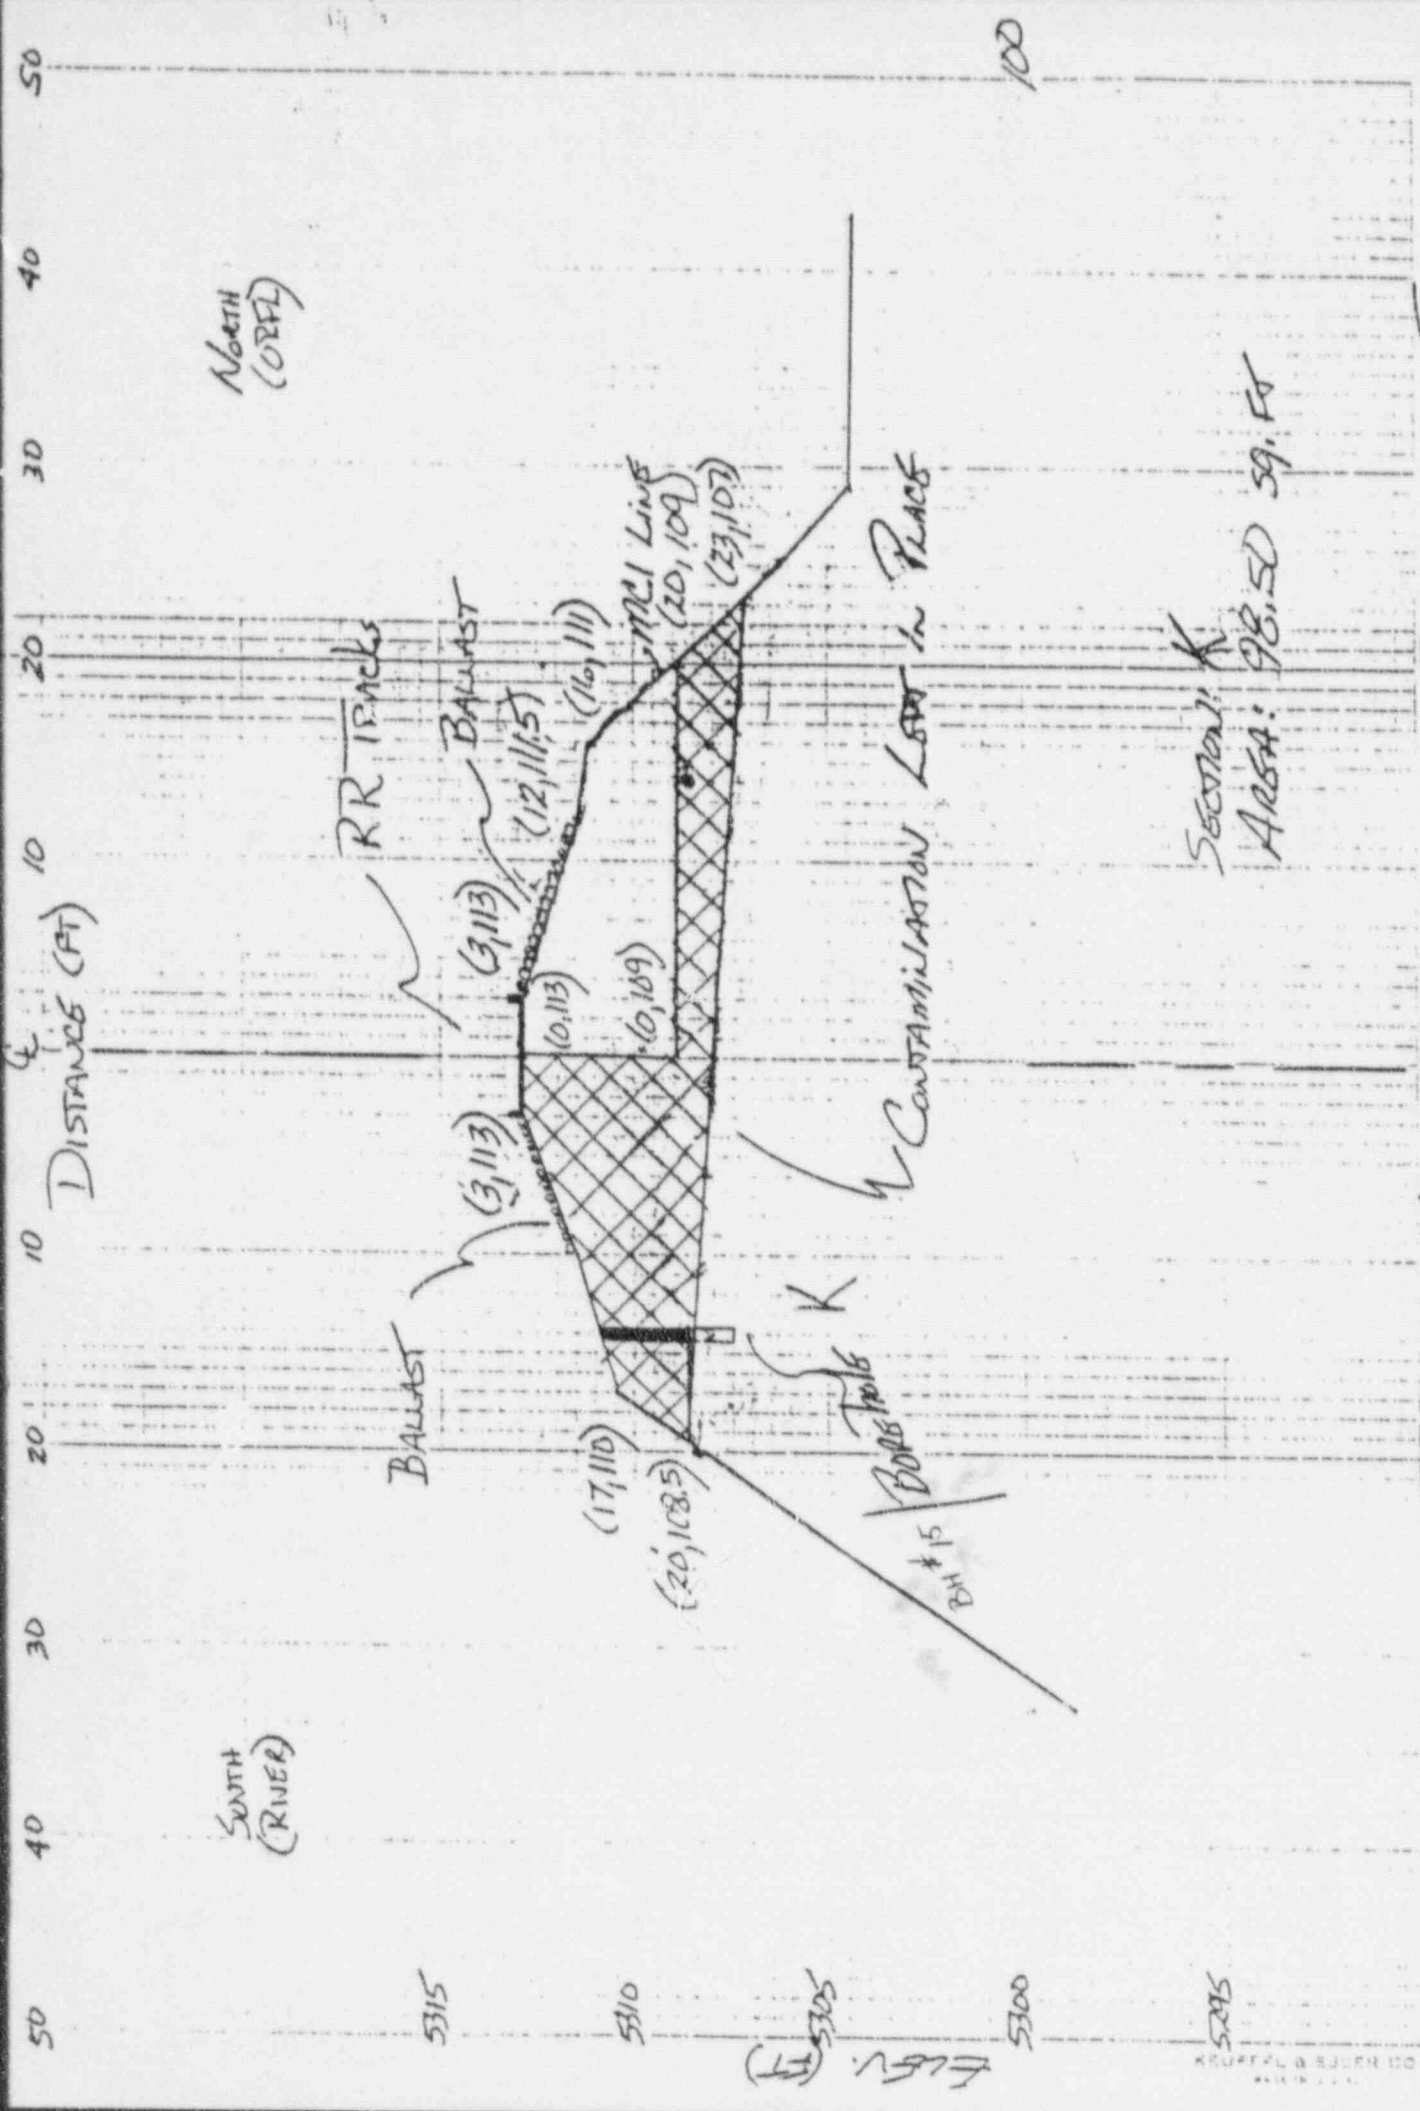

SECTION: K
 AREA: 98.50 SQ. FT

OLD RIFLE - RAILROAD RIGHT OF WAY - RF-430 SUPPLEMENTAL STANDARDS

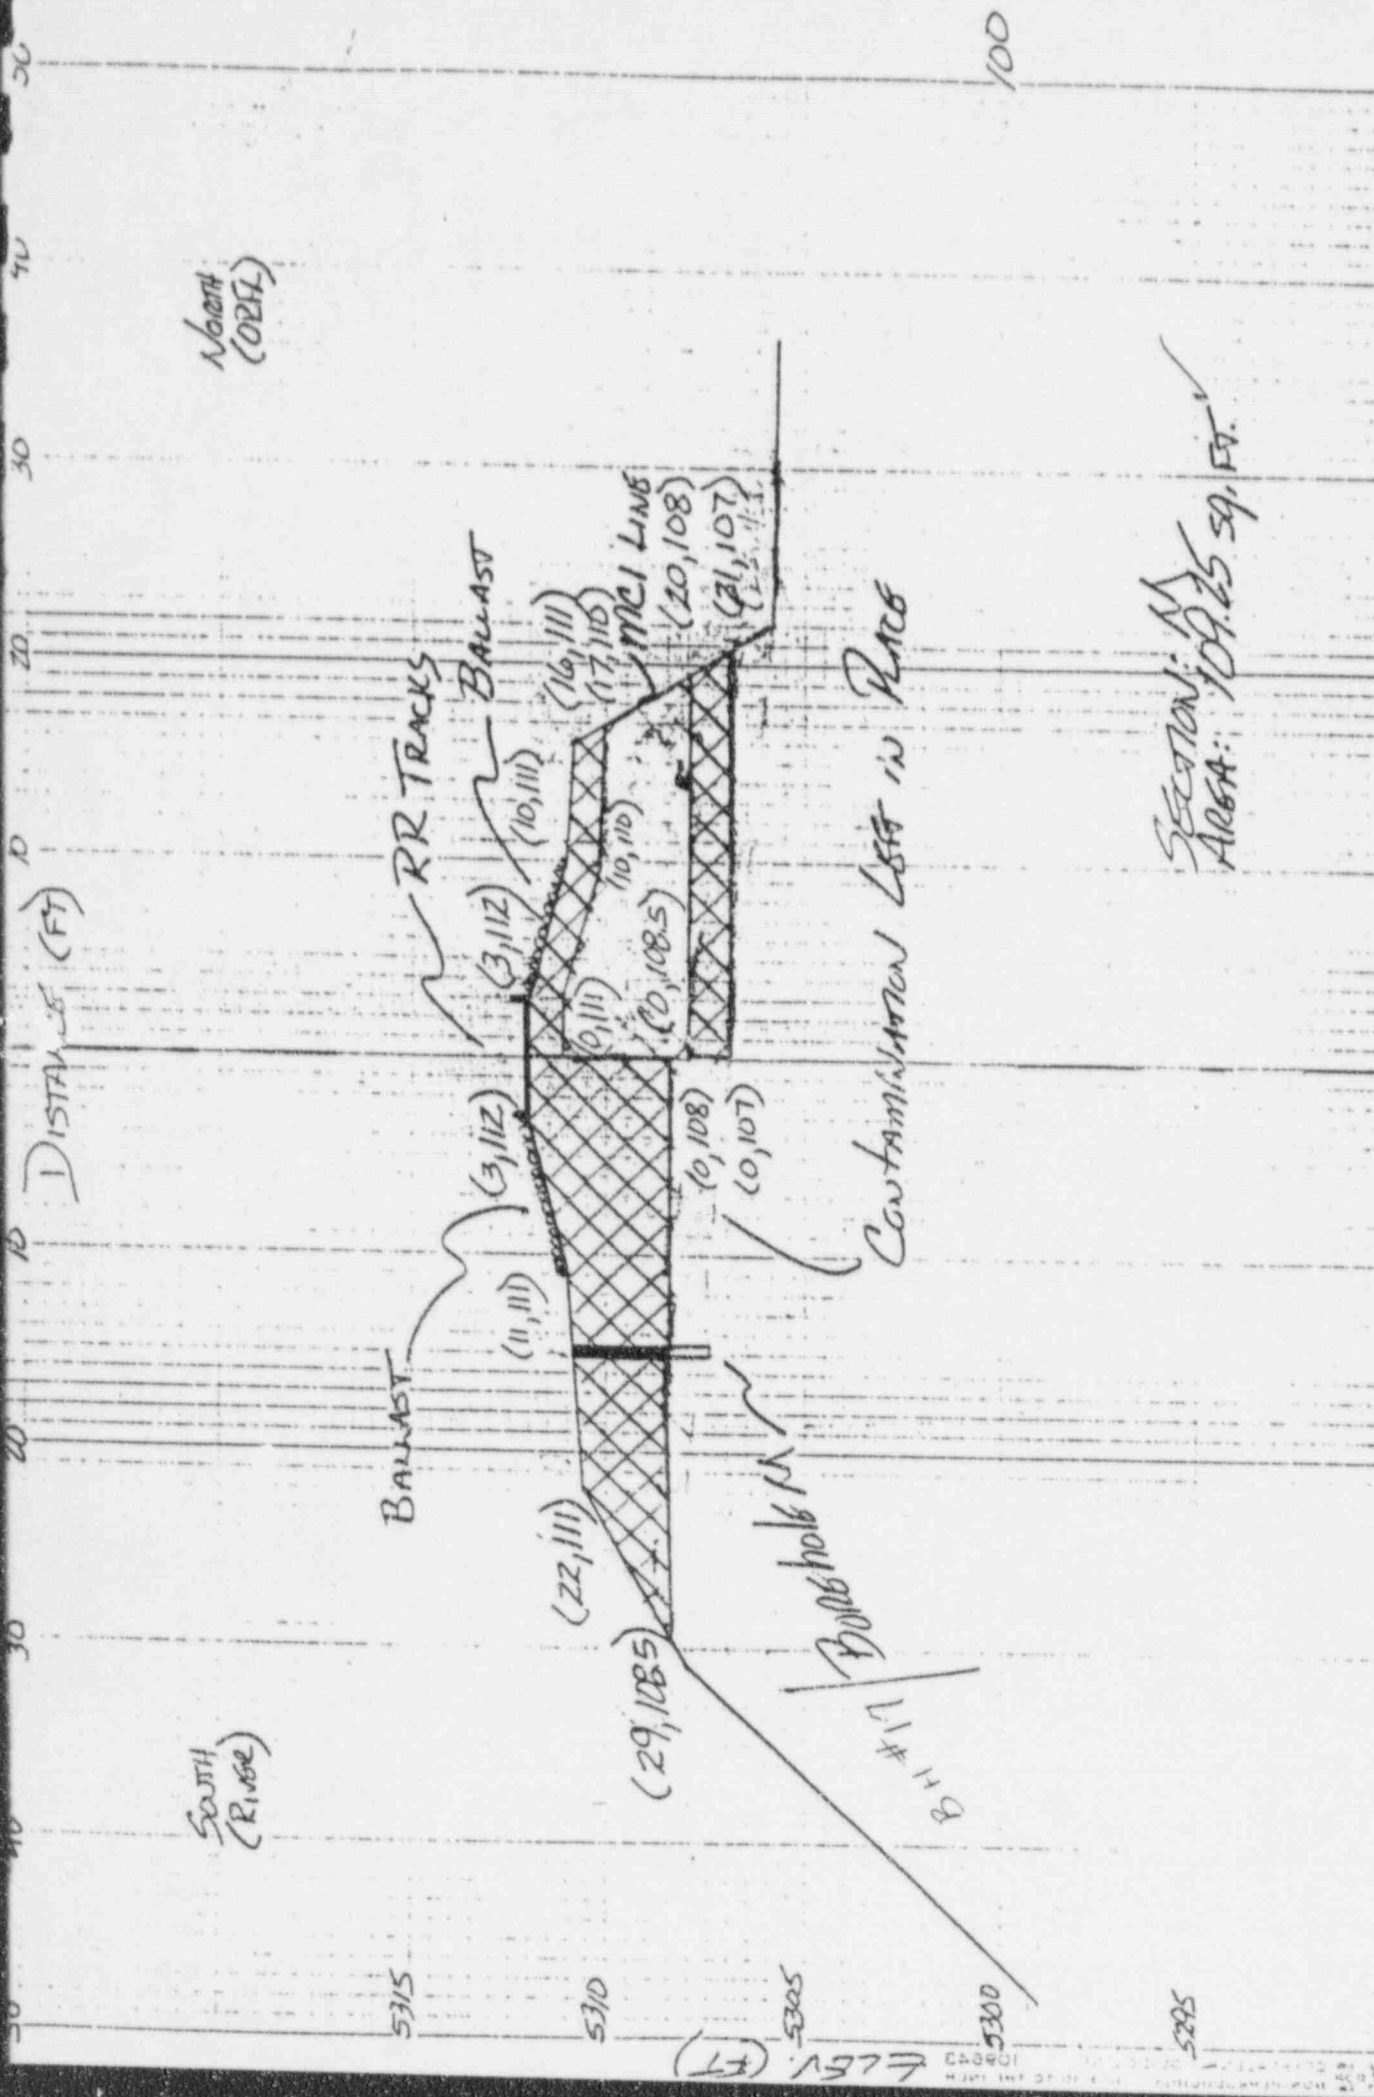

North
(ORF)

South
(Rise)

DISTANCE (FT)

ELEV (FT)

BALLAST

RR TRACKS

BALLAST

MCI LINE

Bolt hole M

Contamination Left in Place

SECTION: M
AREA: 109.25 sq. Ft. ✓

OLD RISE - RAILROAD RIGHT OF WAY - RF-480

SUPPLEMENTAR STANDARDS

100

5315

5310

5305

5300


5295

10843
10842
DISTANCE (FT)

NORTH
(OPR.)

SOUTH
(RNGR.)

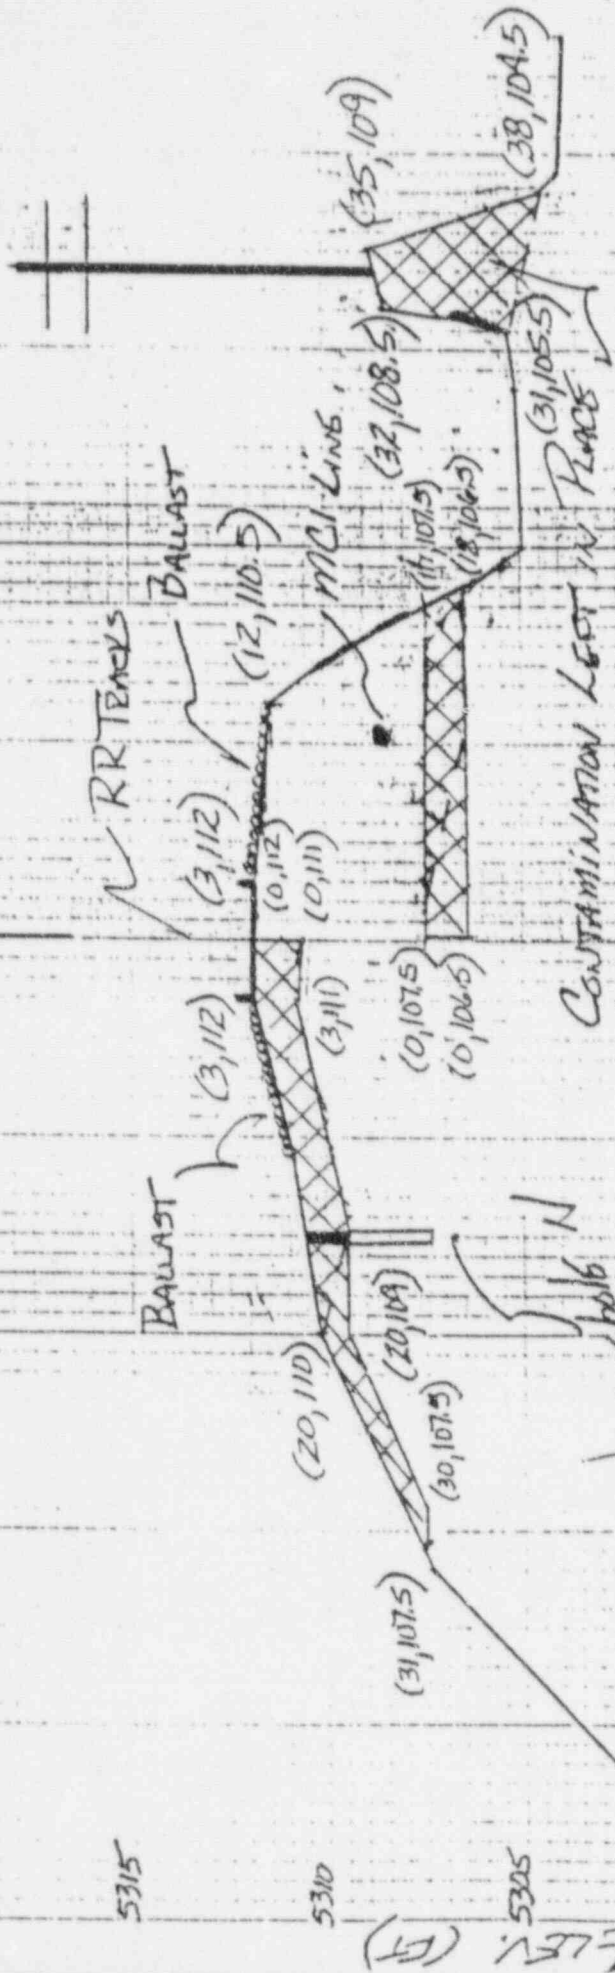


CONTAMINATION LEFT IN PLACE

SECTION: N
 AREA: 43.75 SQ. FT.
 L.H.: 211. Feet
 AREA: 18.50 SQ. FT.

SUPPLEMENTAL STANDARDS

Old Rifle - RAILROAD RIGHT OF WAY - RF 480

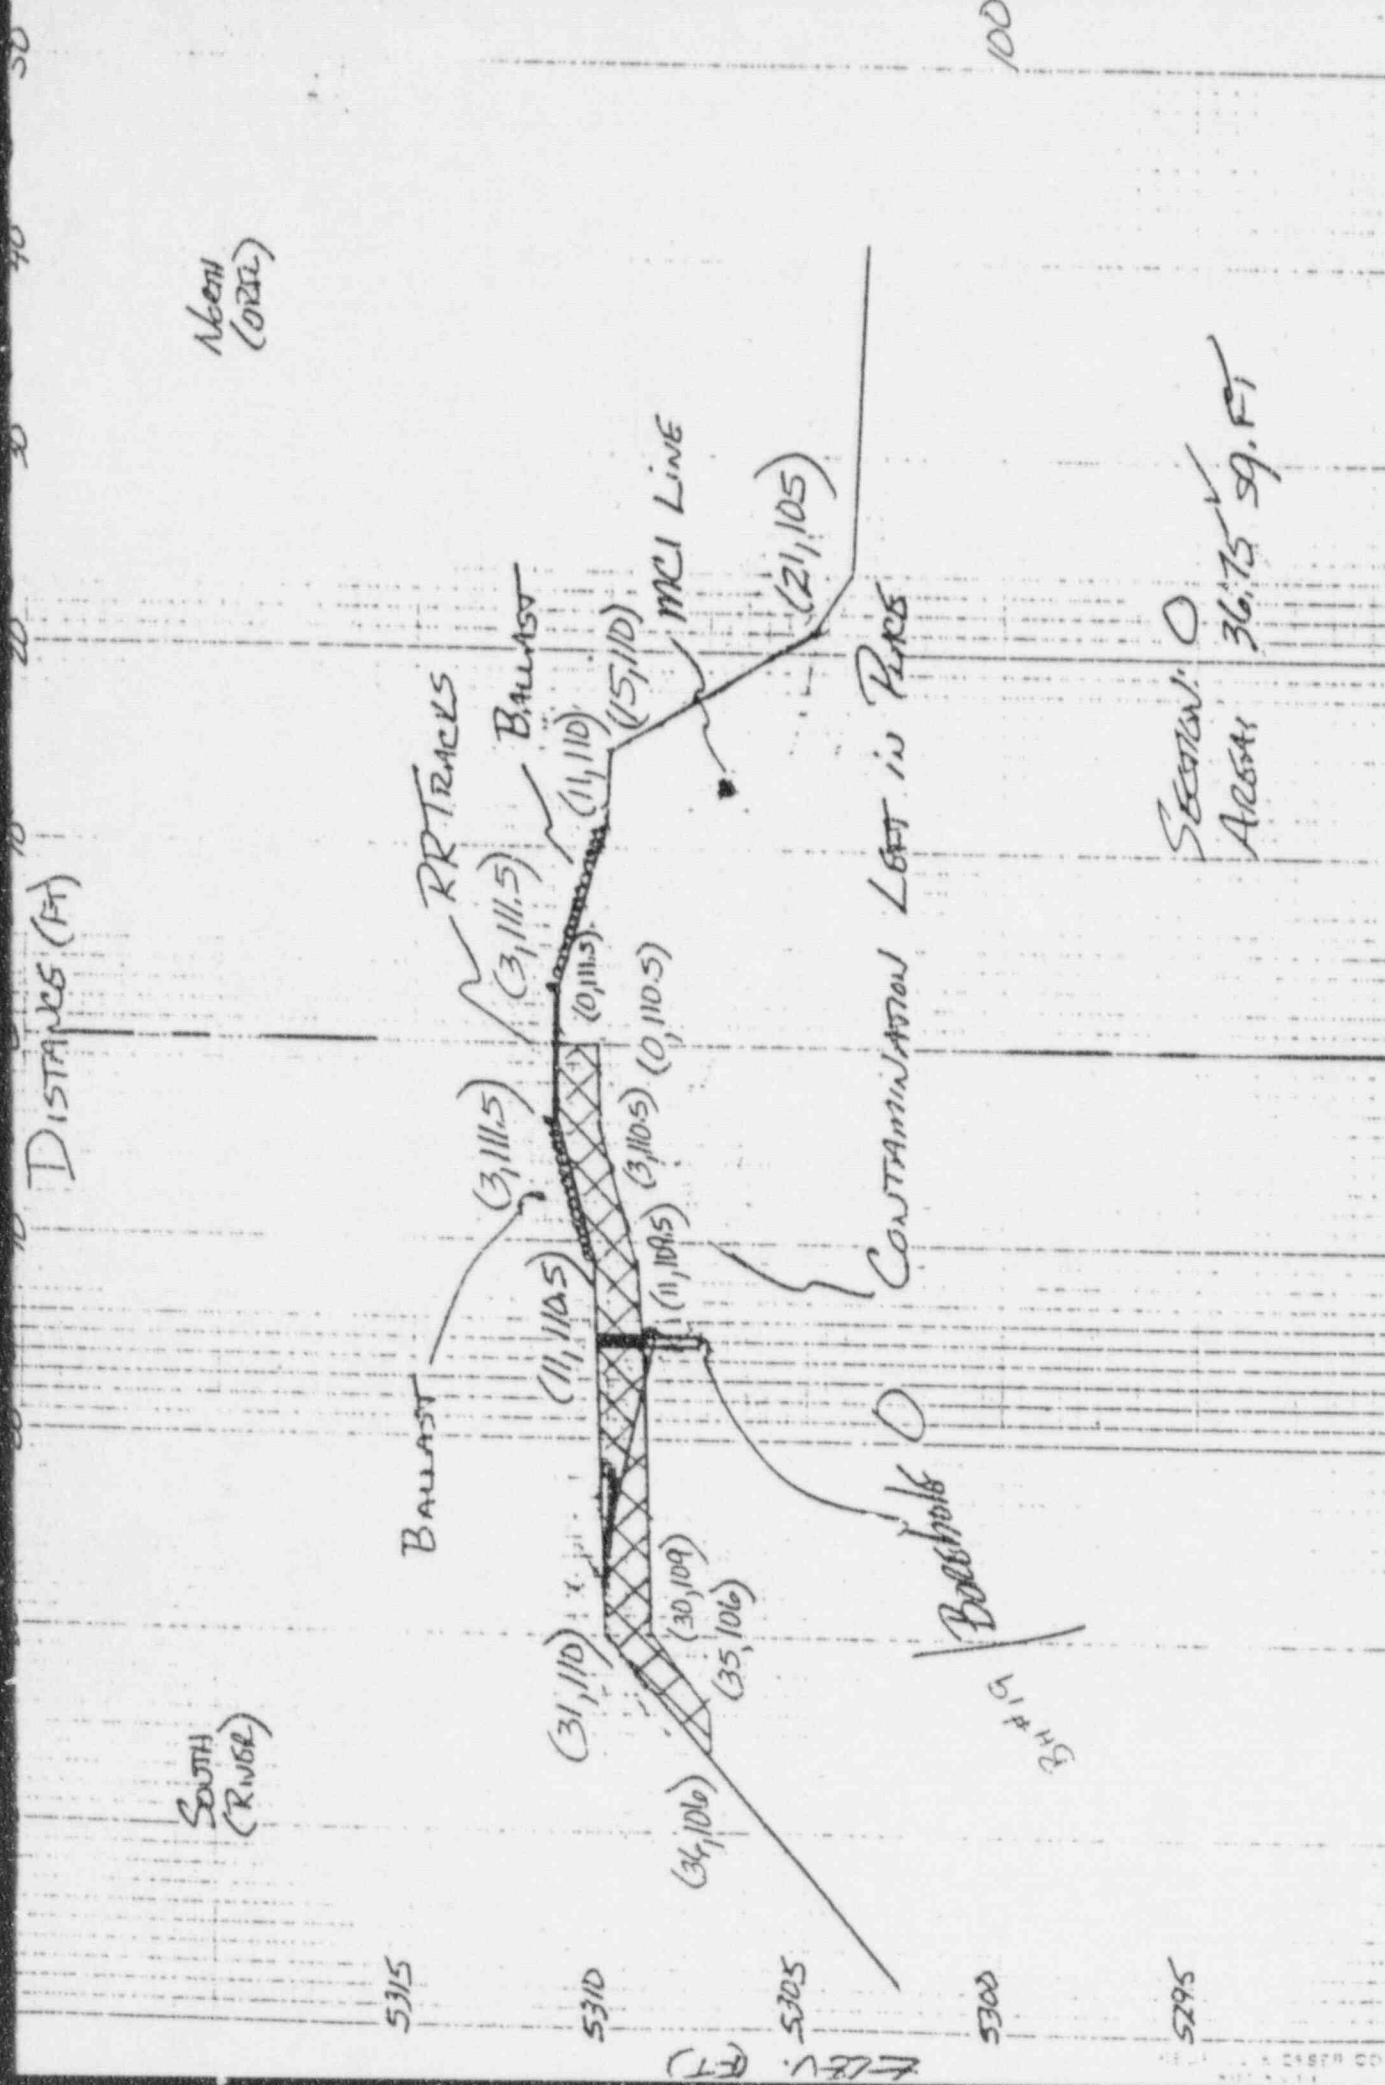

Old Ridge - Railroad Right of Way - RF-480

SUPPLEMENTAL STANDARDS

SECTION: O

100

NORTH
(ORSE)

SOUTH
(RWSE)

DISTANCES (FT)

ELEV. (FT)

5315

5310

5305

5300

5295

34# 19
BORESHOLE


BALLAST

RR TRACKS

BALLAST

MCI LINE


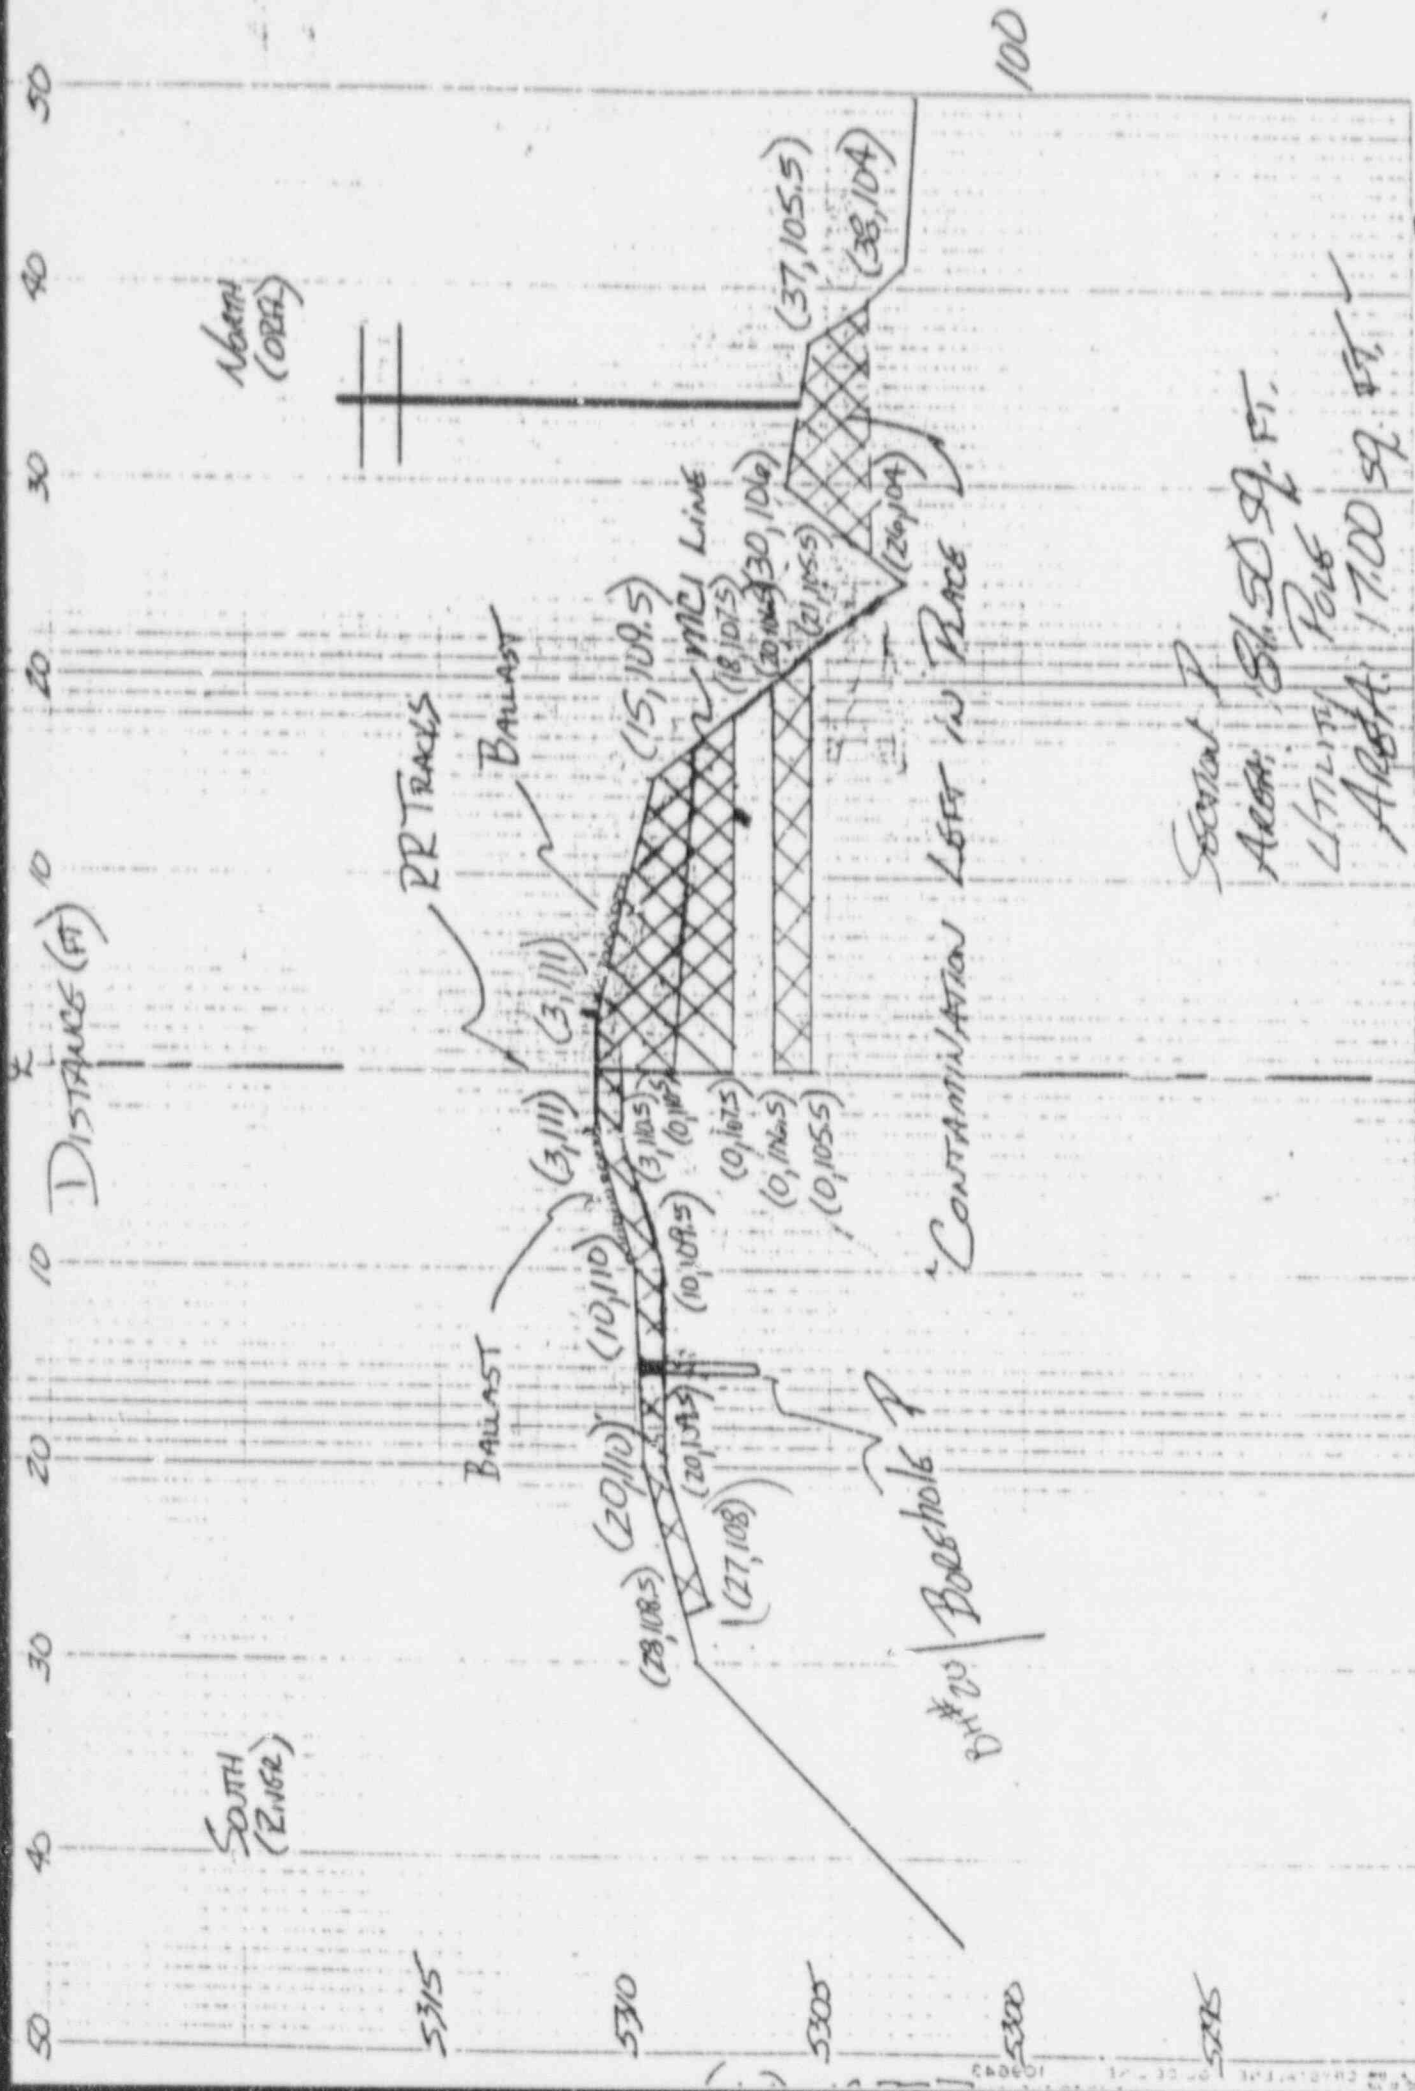

Section P
 AREA: 84.50 SQ. FT.
 UTILITY POLE
 AREA: 17.00 SQ. FT.

CONTAMINATION LEFT IN PLACE

Old Rifle - Railroad Right of Way - RF480

SUPPLEMENTAL STANDARDS

100

North
(ORCA)

South
(ENR2)

5315

5310

5305

5300

5295

DISTANCE (FT)

50

40

30

20

10

0

10

20

30

40

50

RR TRACKS

BALLAST

BALLAST

MCI LINE

Borehole #20

CONTAMINATION LEFT IN PLACE






















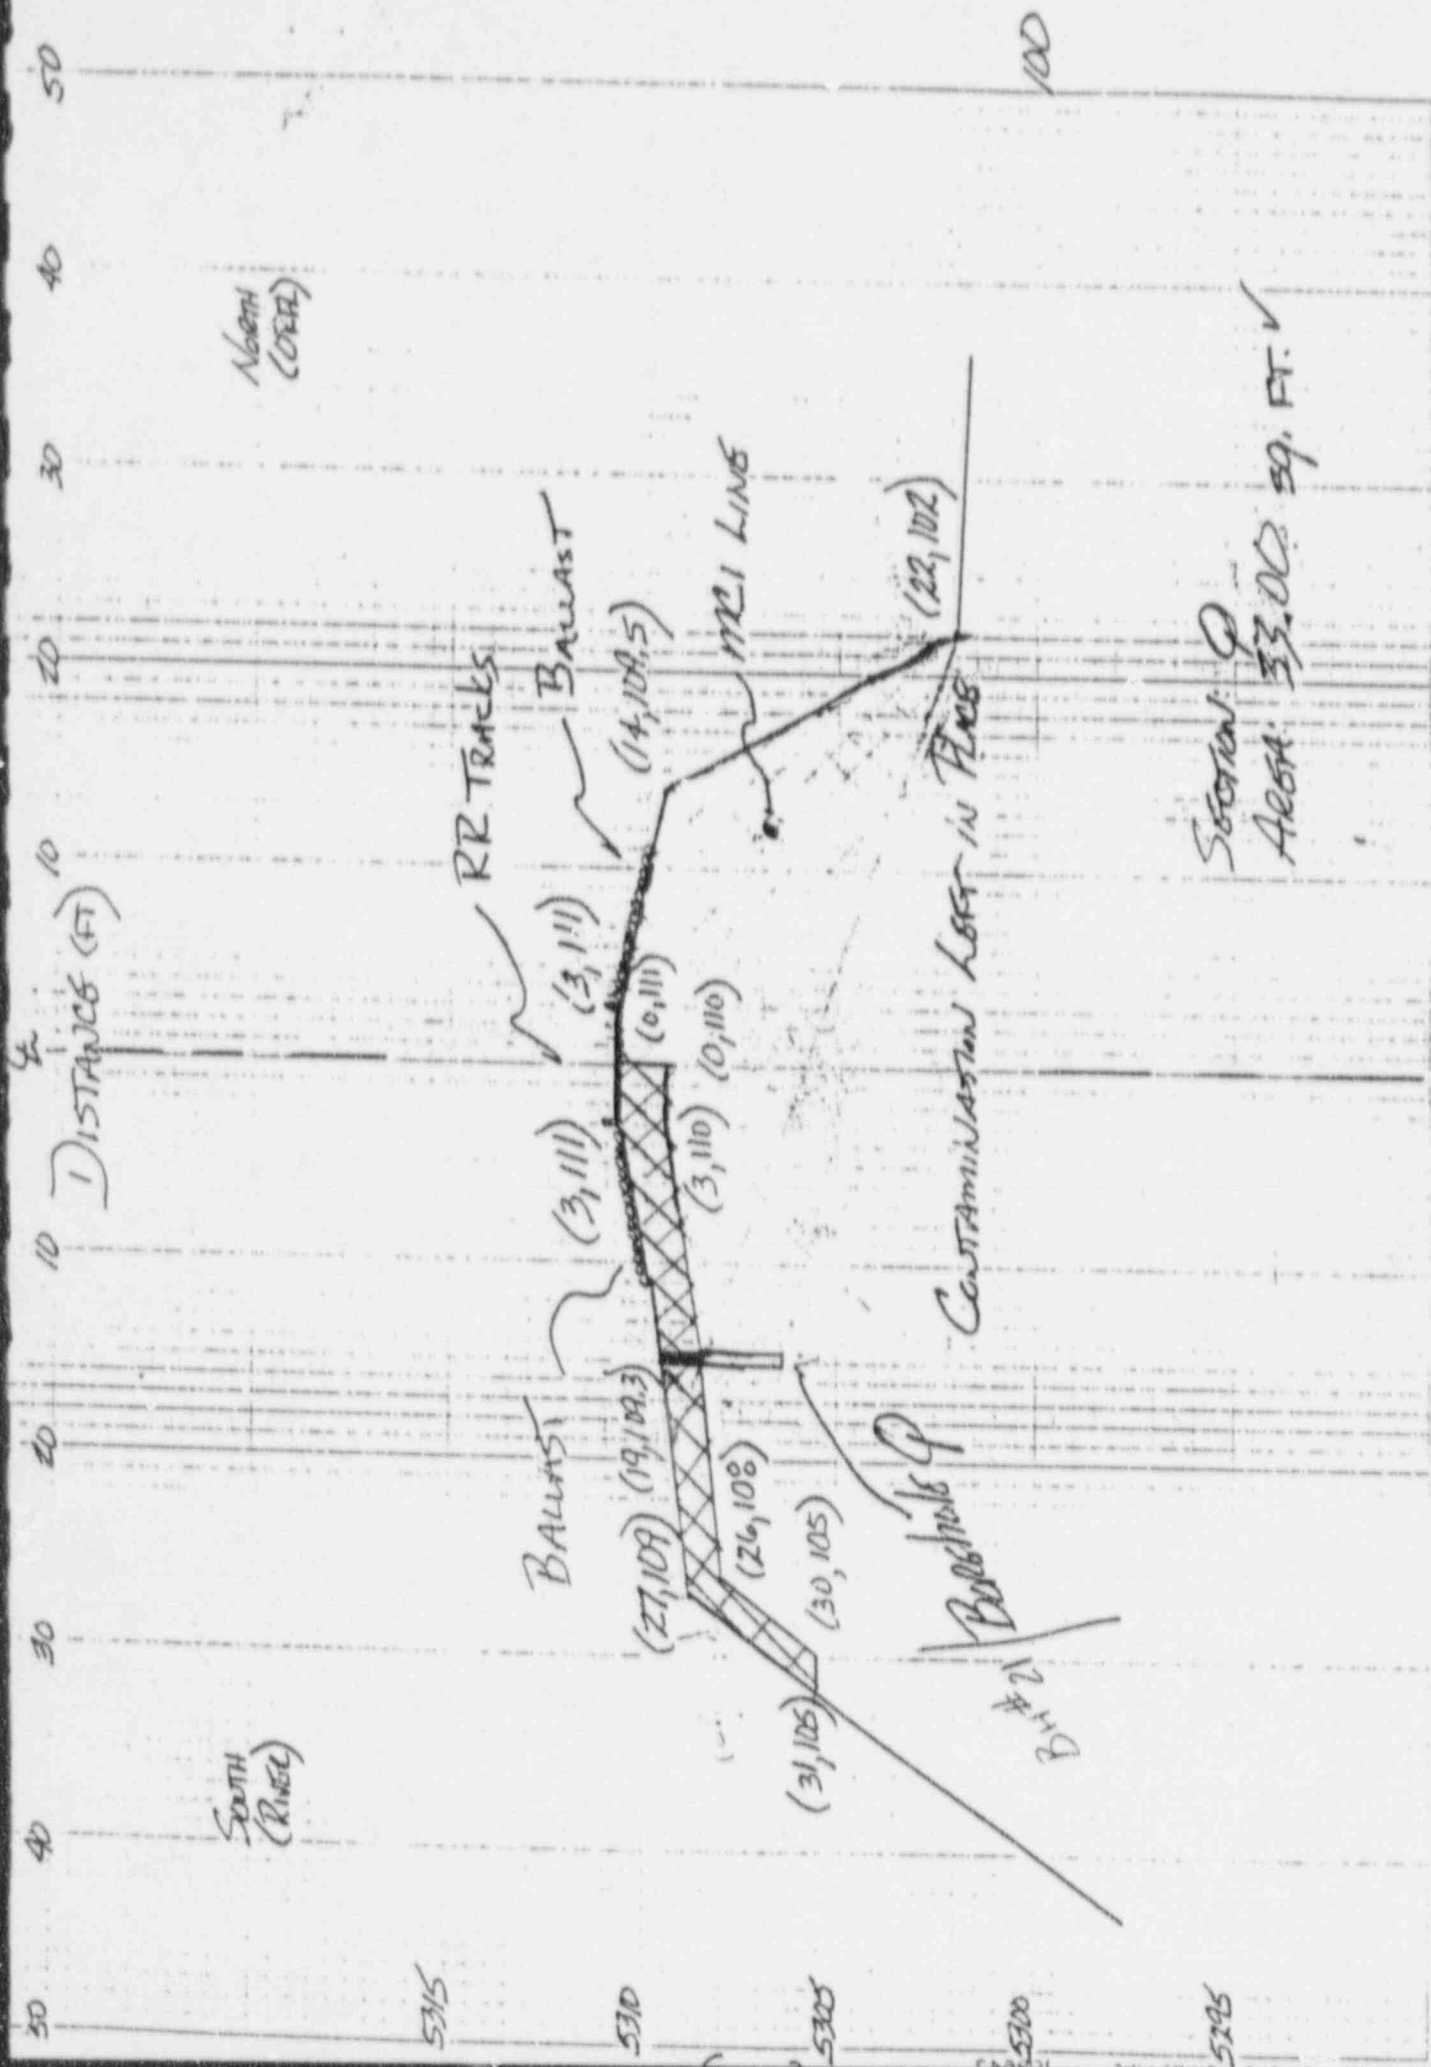

North
(OFF)

South
(RIVER)

RR TRACKS

BALLAST

MCI LINE

BALLAST


CONTAMINATION LEFT IN PLACE

SECTION Q
AREA: 33.00 sq. FT. ✓

OND R: FLE - RAILROAD RIGHT OF WAY - RF 49D

SUPPLEMENTAL STANDARDS

100

5315


5310

5305

5300


5295

B# 21

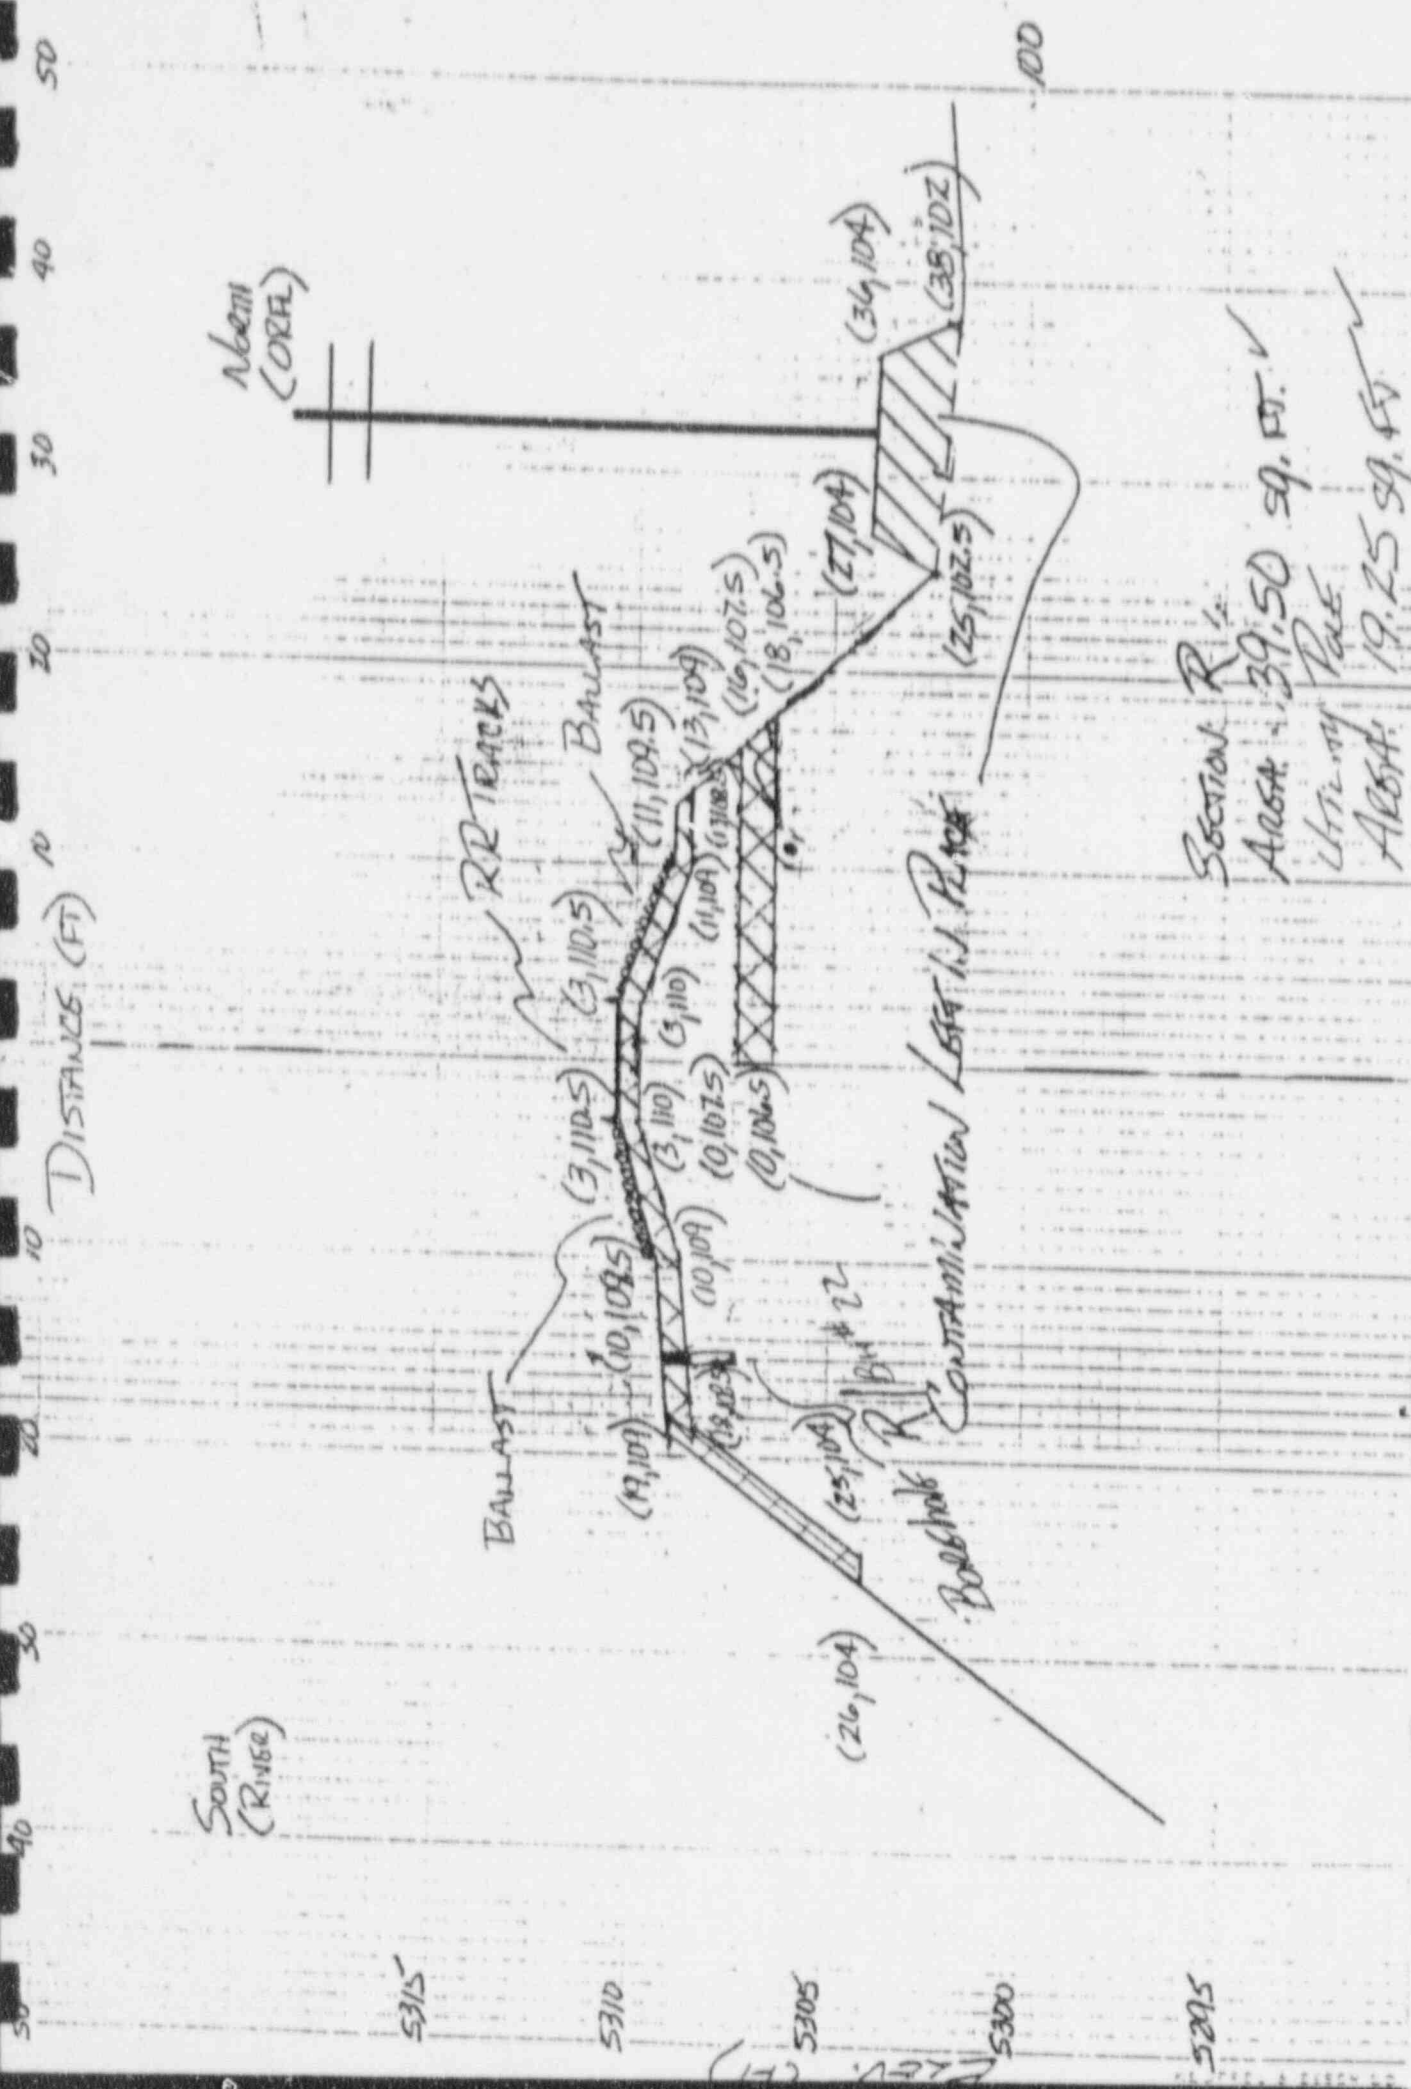

Old Rifle - Railroad Right of Way - RF 480


SUPPLEMENTAL STANDARDS

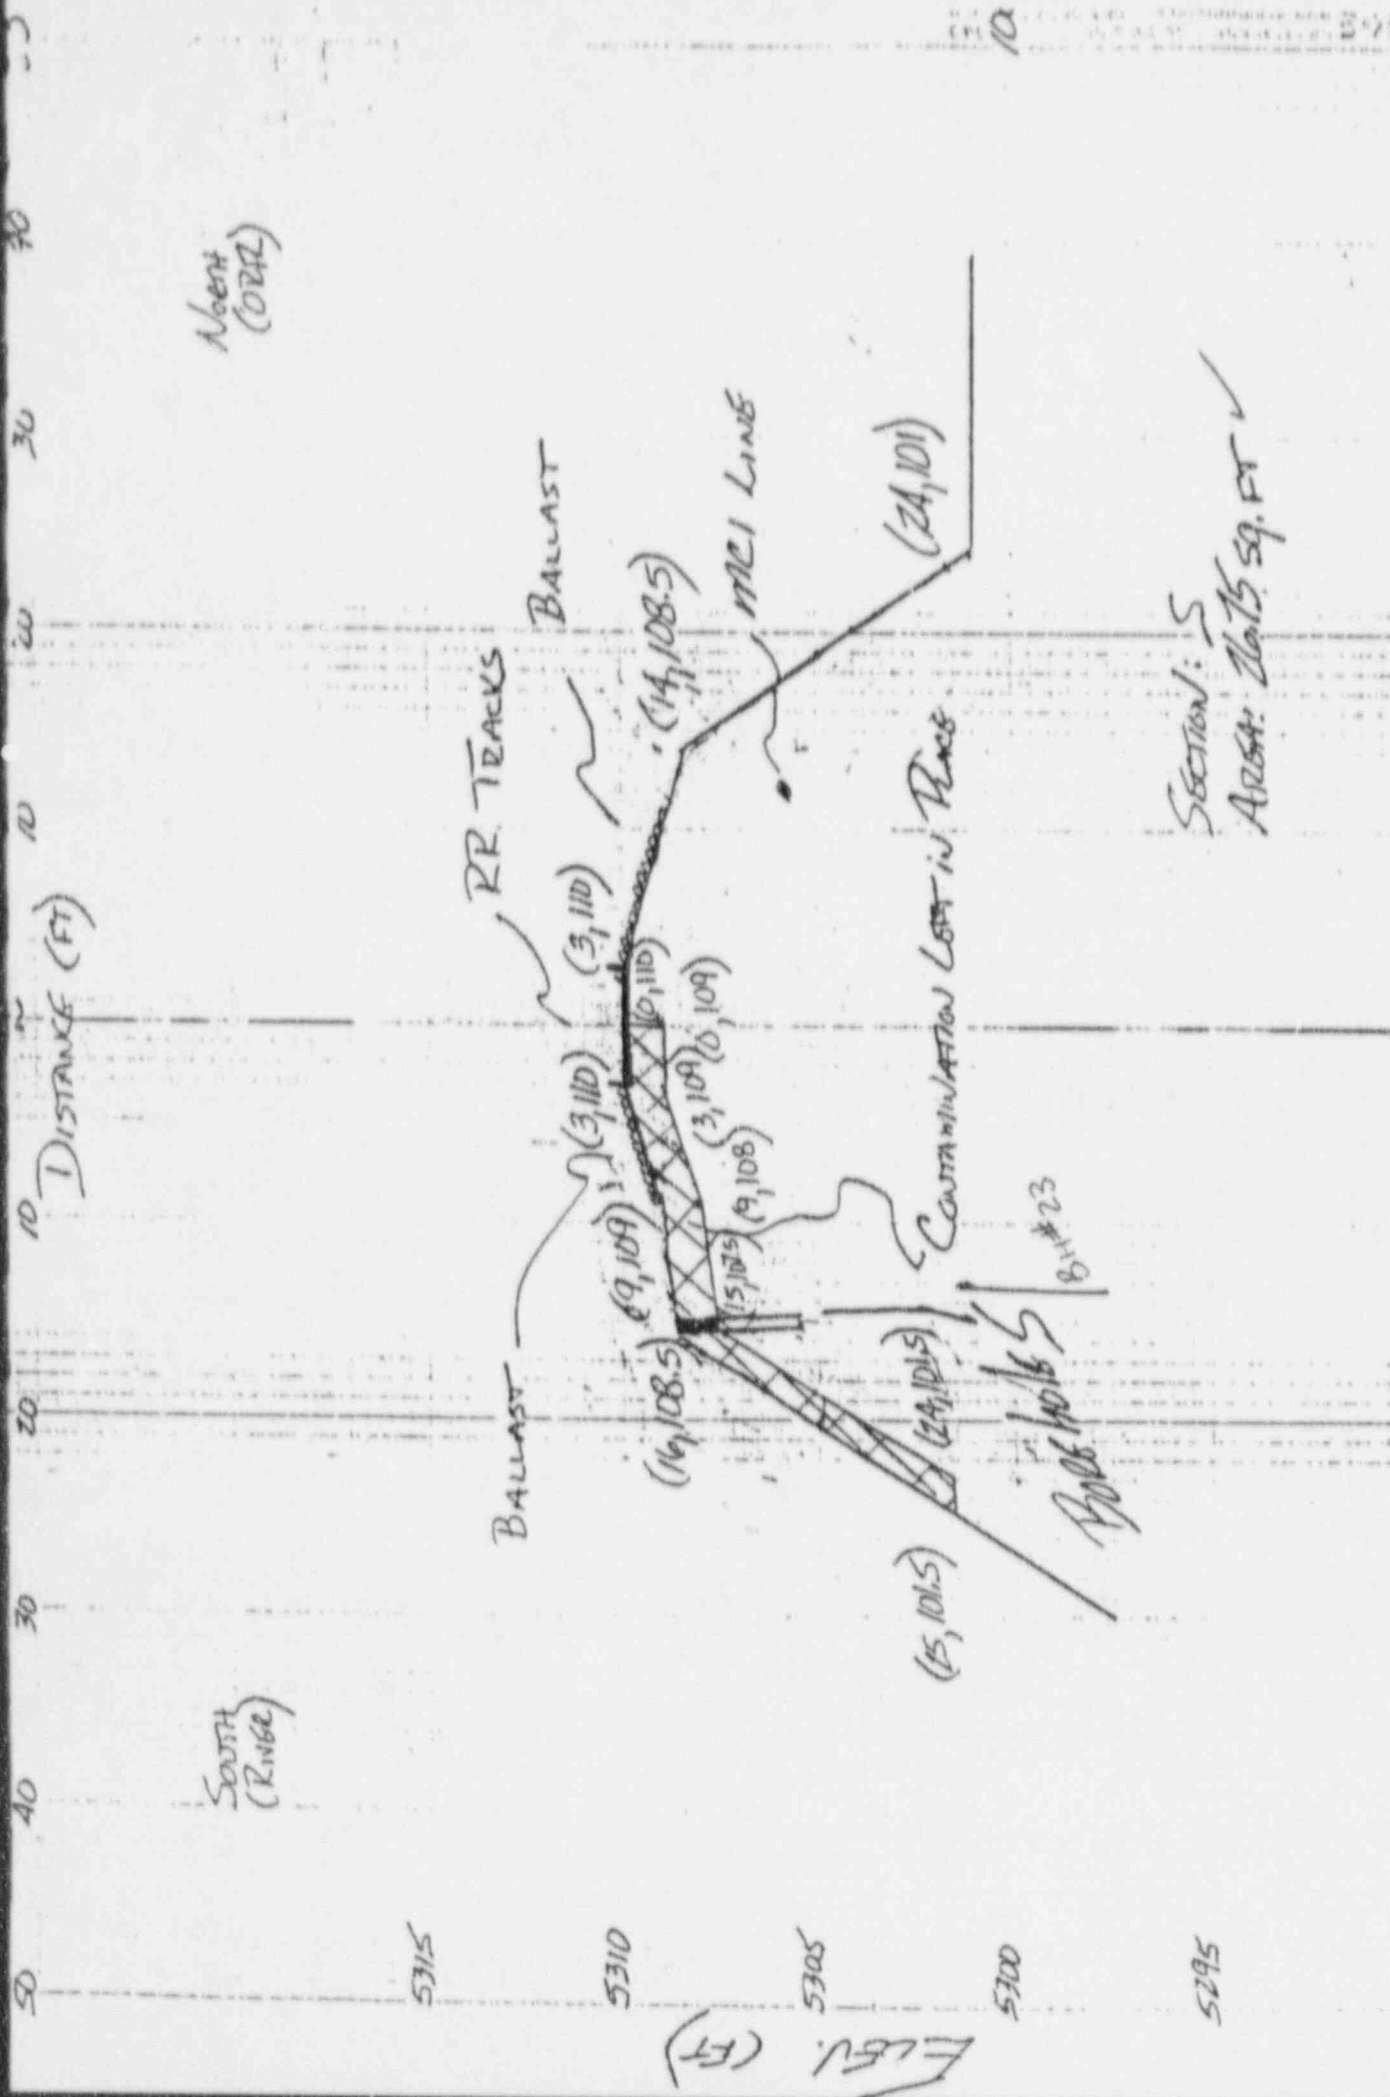


SECTION: S
 AREA: 2015 SQ. FT ✓

OLD RIFLE - RAILROAD RIGHT OF WAY - RF 480


SUPPLEMENTAL STANDARDS

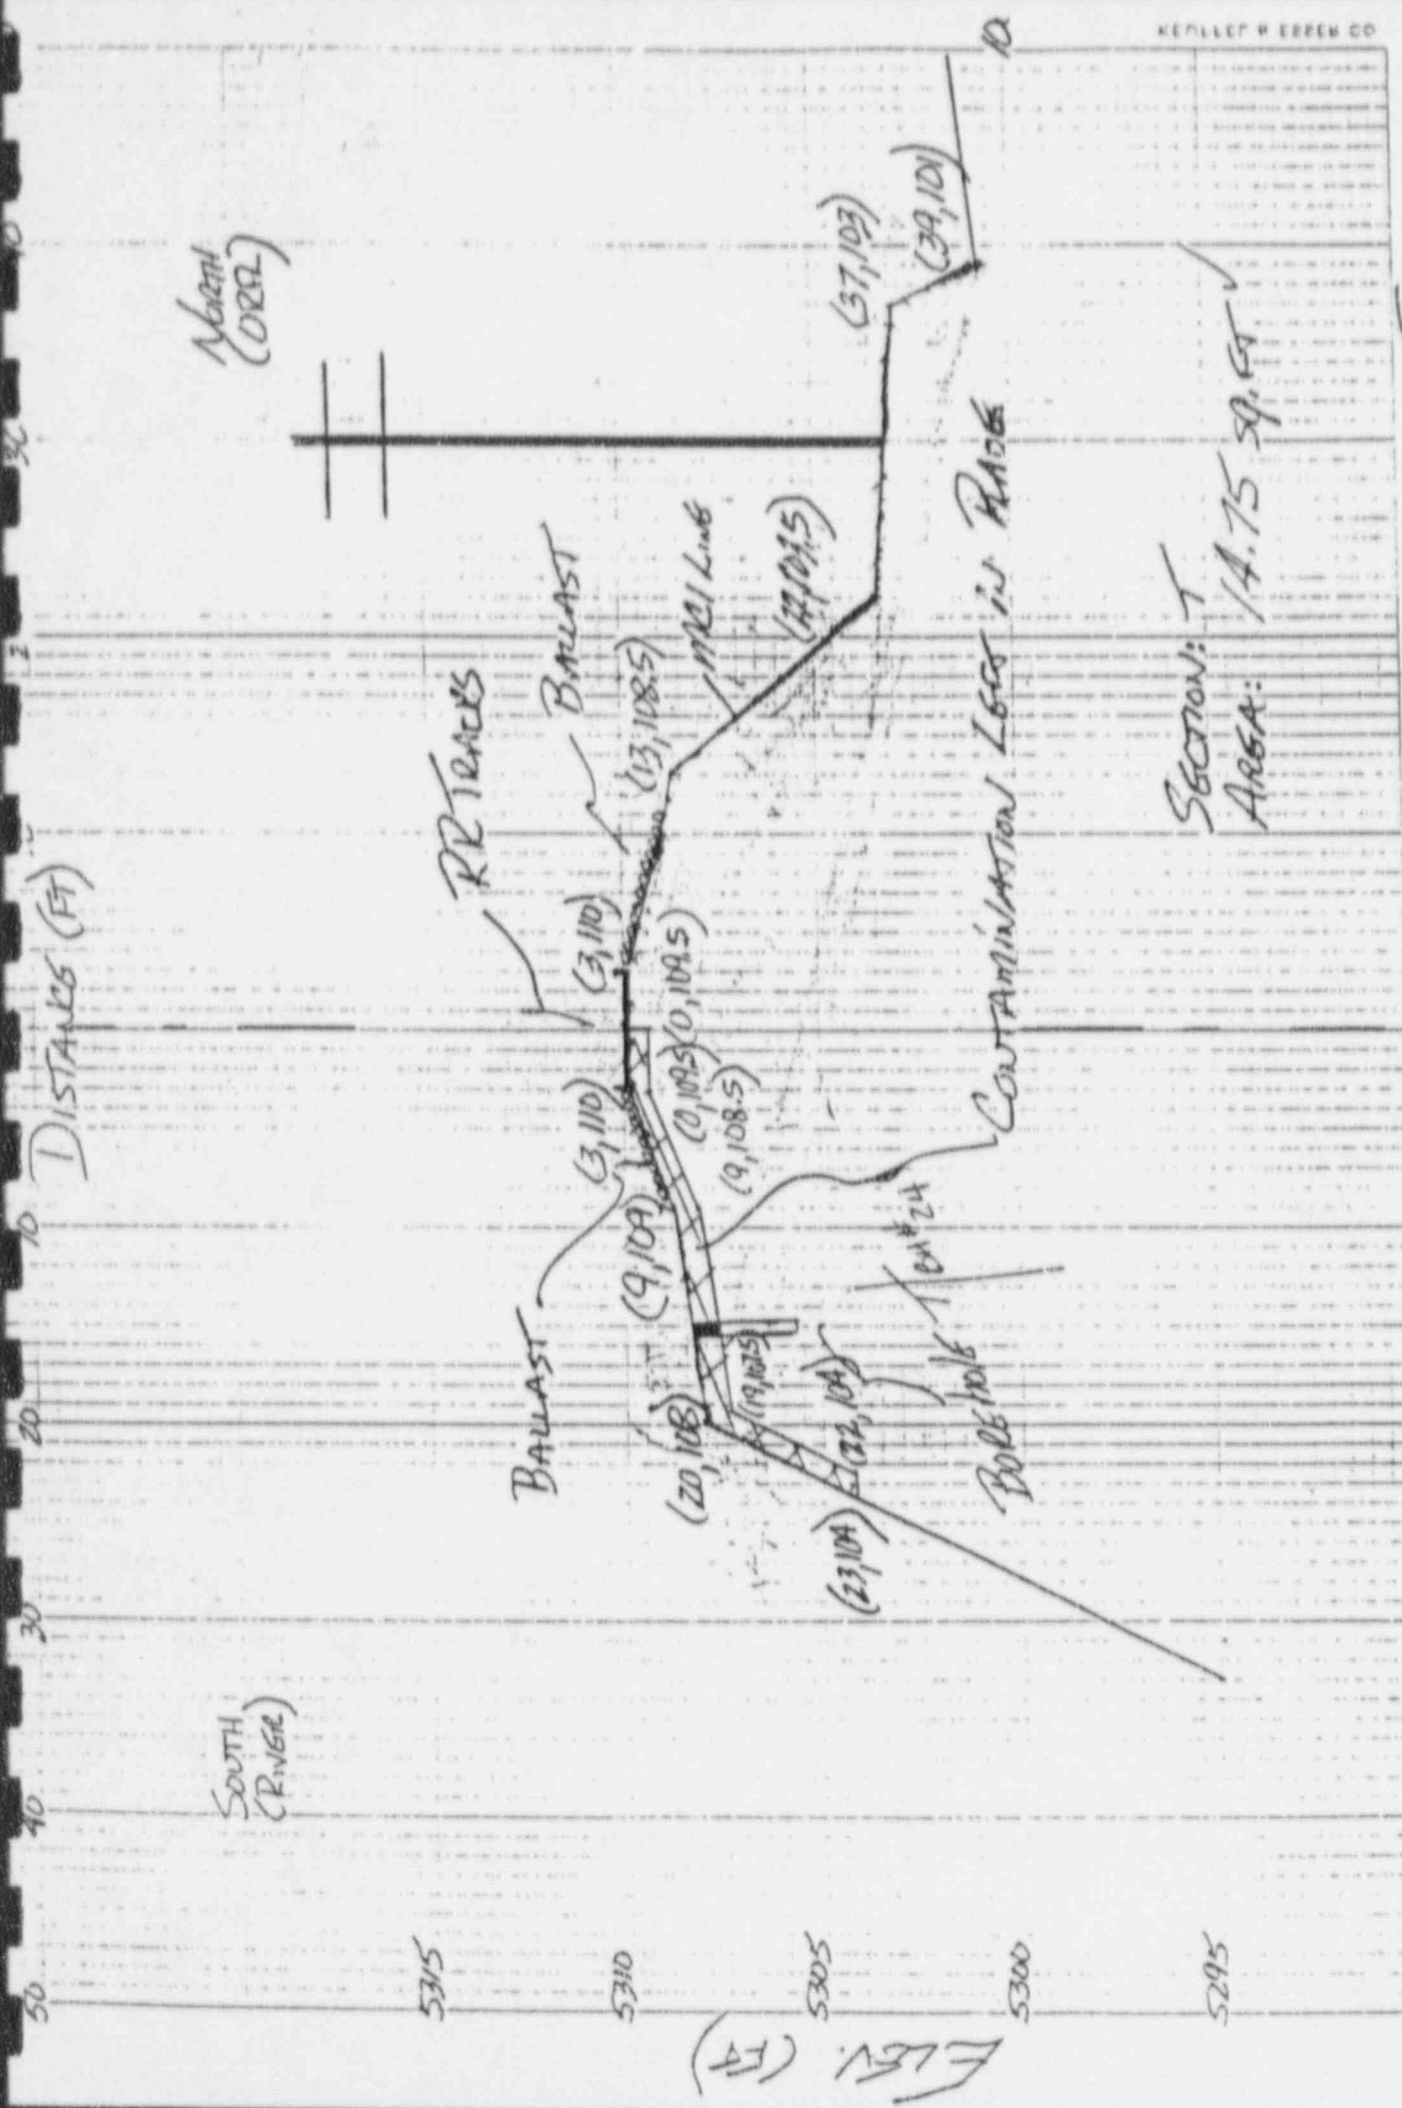

OLD RIDGE - RAILROAD RIGHT OF WAY - RF 480 SUPPLEMENTAL STANDARDS

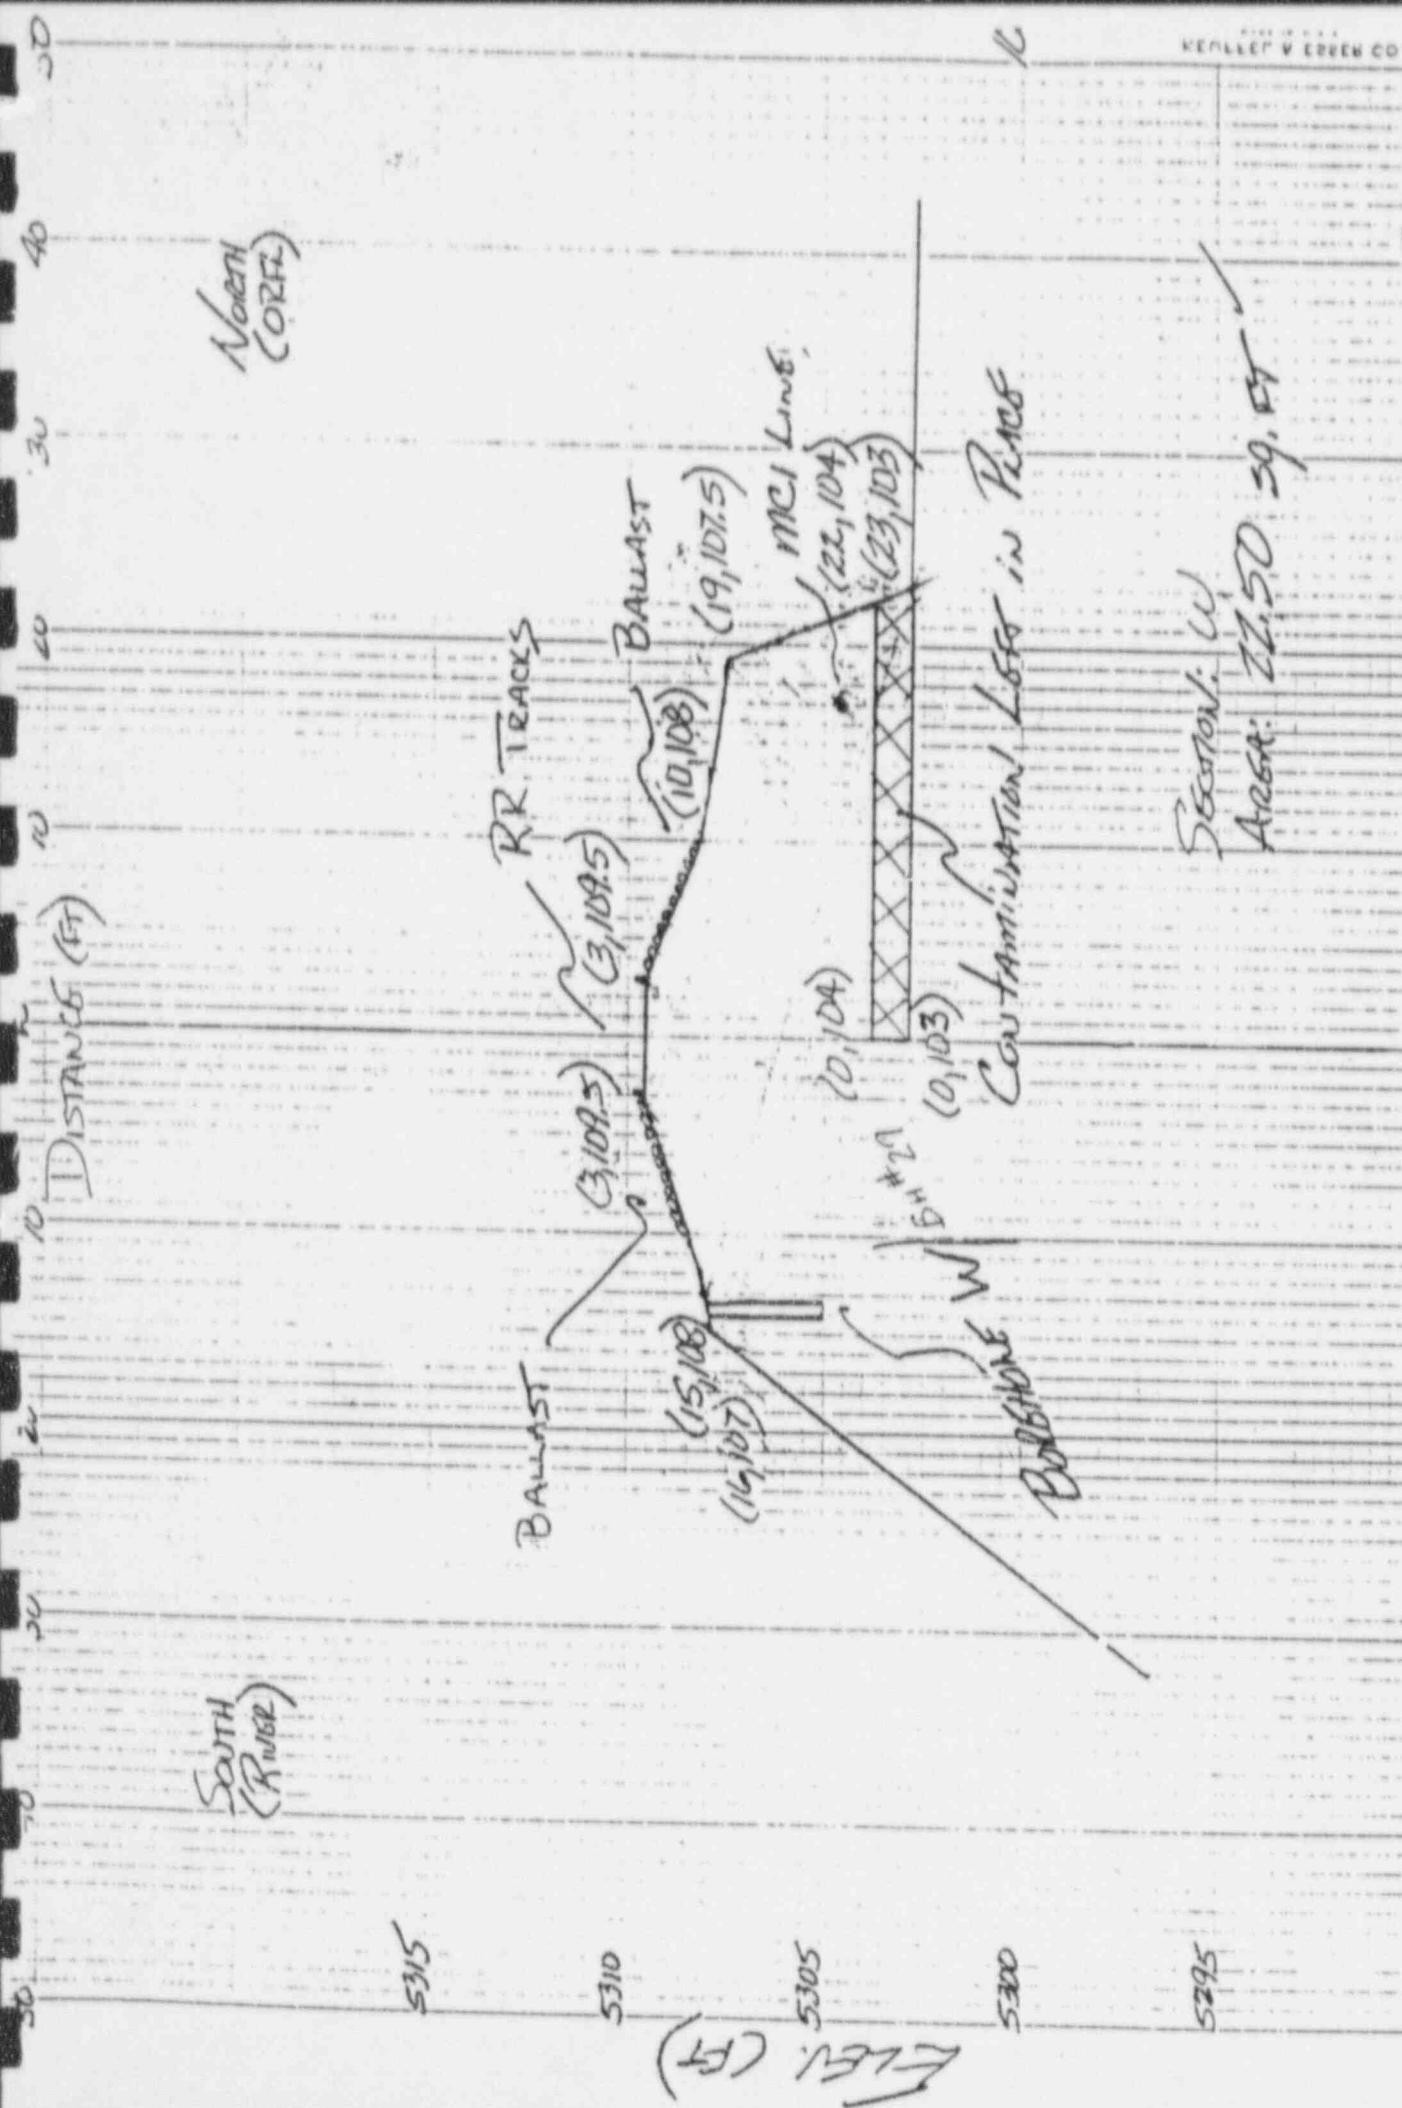


OLD RIFLE - RAILROAD RIGHT OF WAY - RF 480 SUPPLEMENTAL STANDARDS

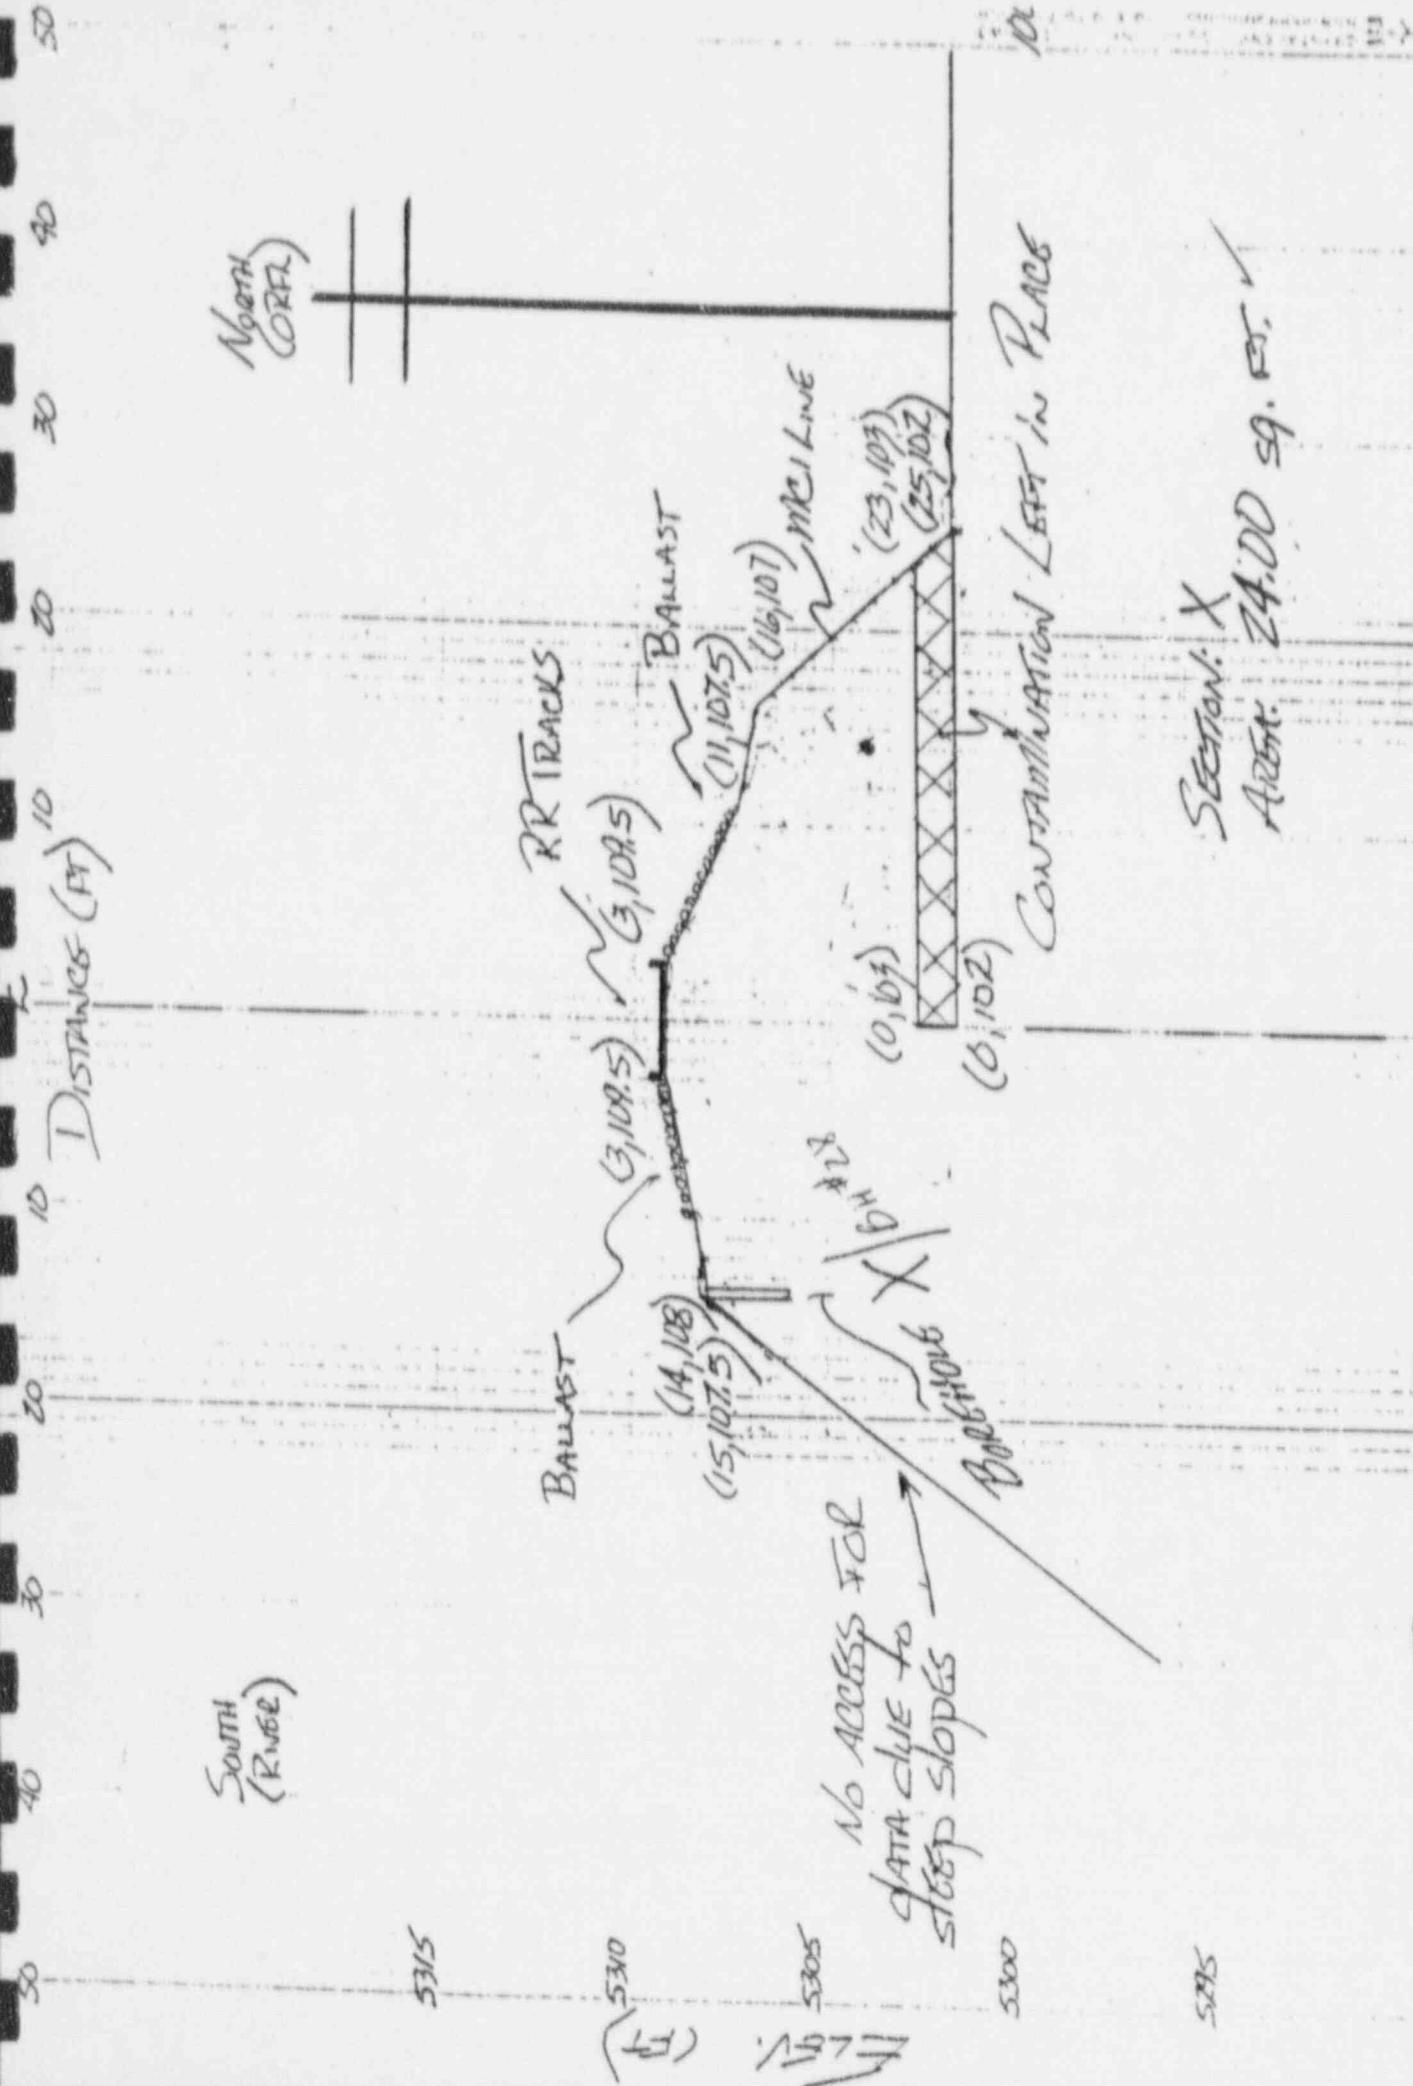


SECTION: X
 AREA: 24.00 SQ. FT. ✓

OLD RIFLE - RAILROAD RIGHT OF WAY - RF 480 SUPPLEMENTAL STANDARDS

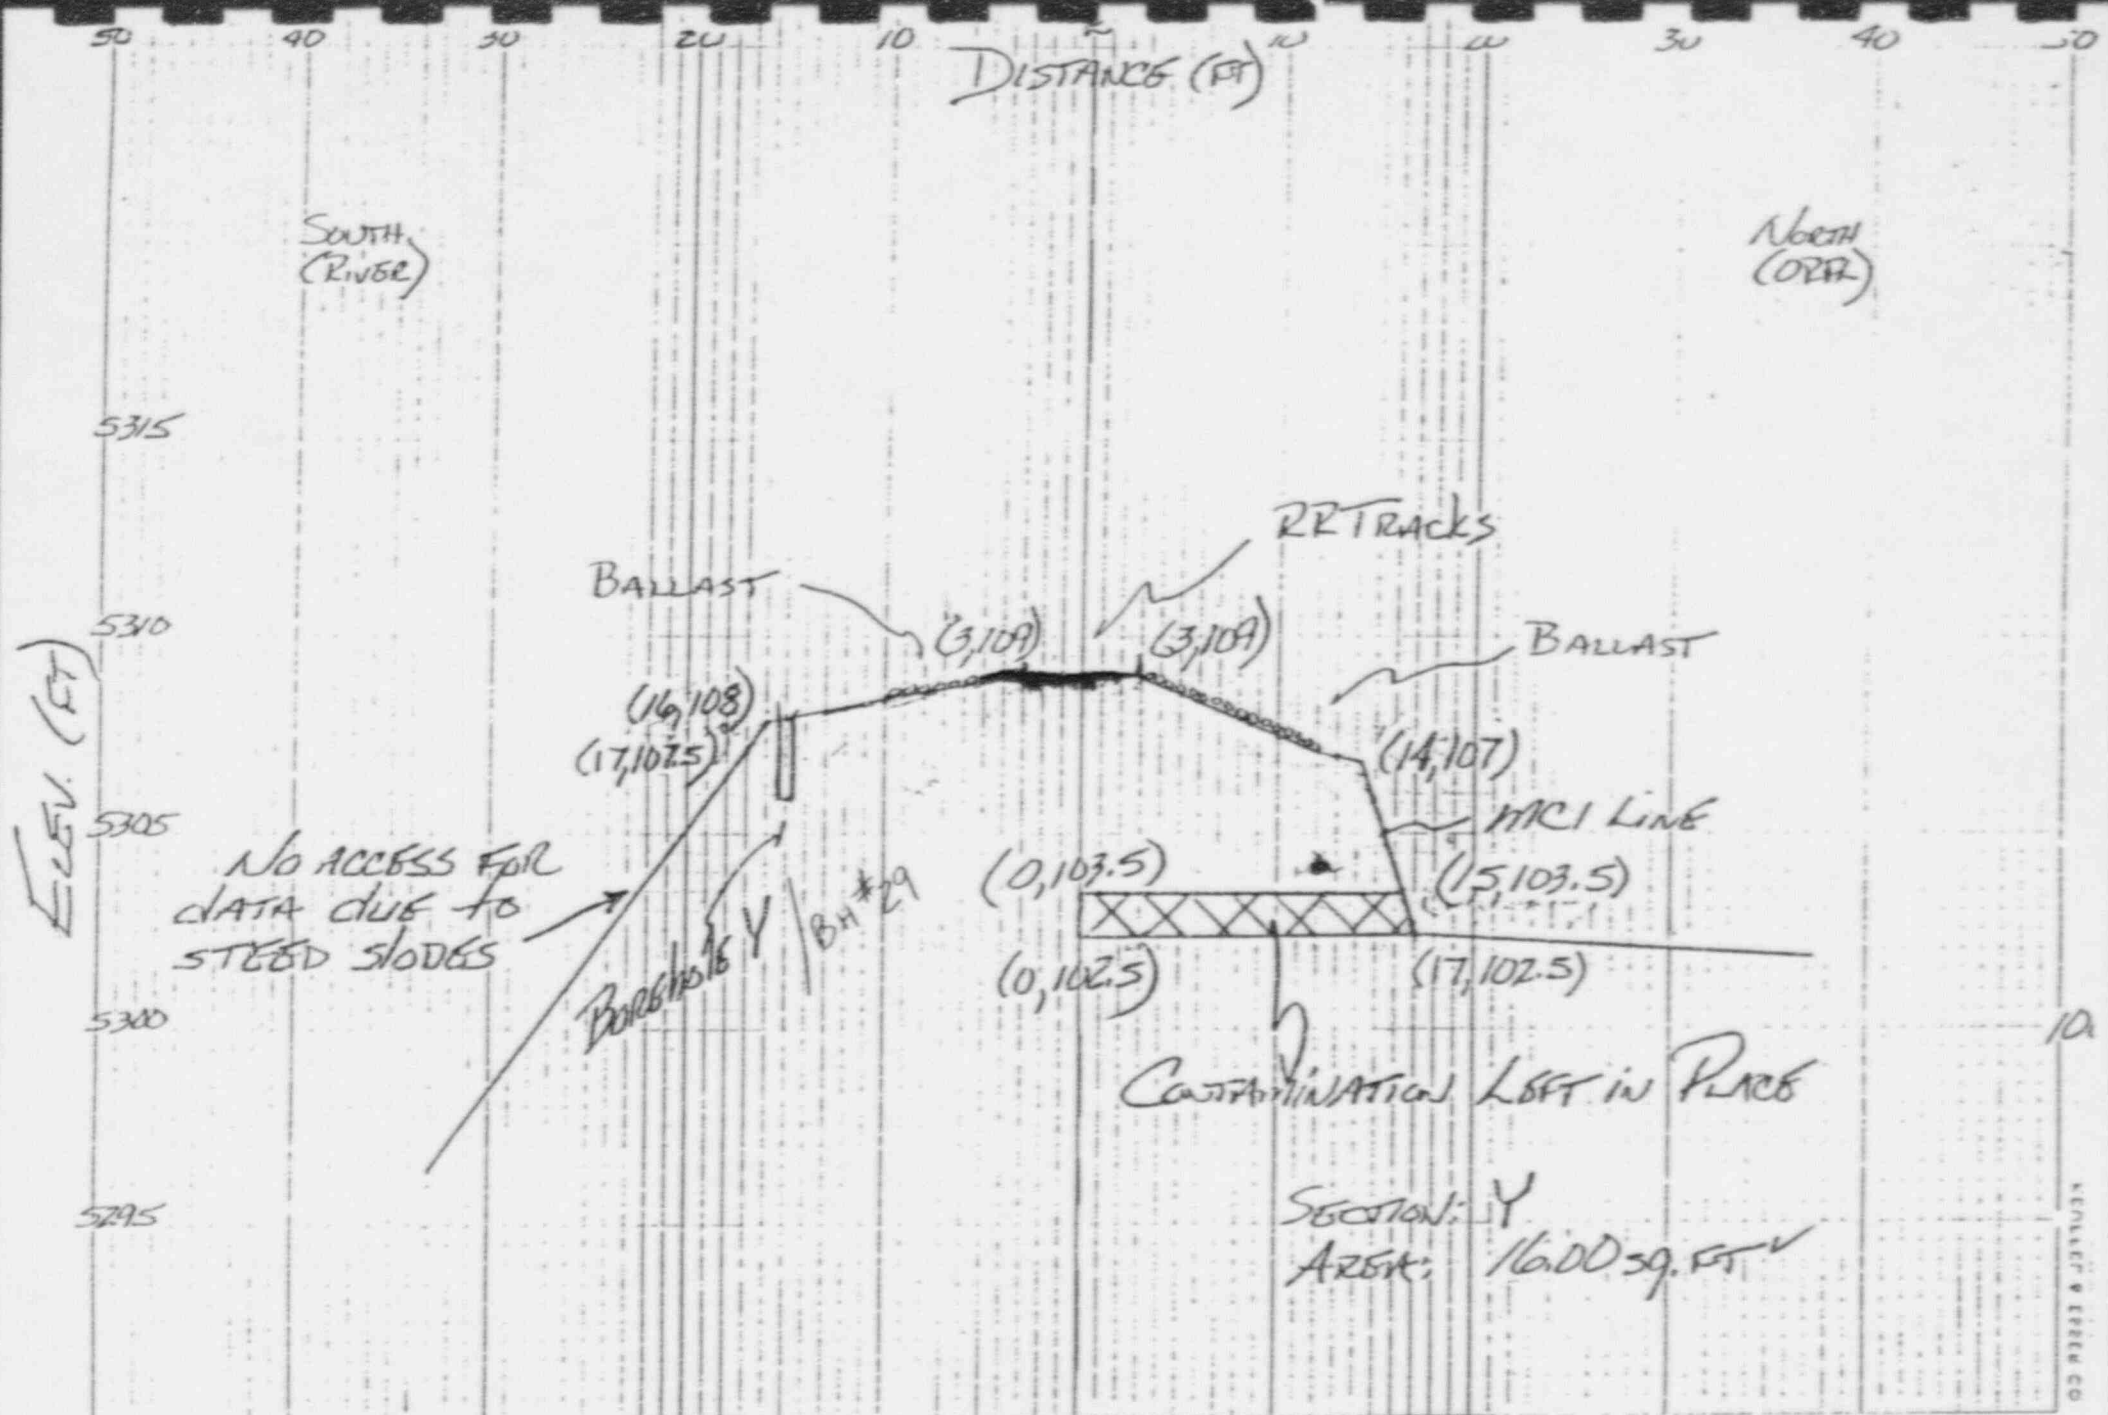

OLD RIFLE - RAILROAD RIGHT OF WAY - RF 480

SUPPLEMENTAL STANDARDS

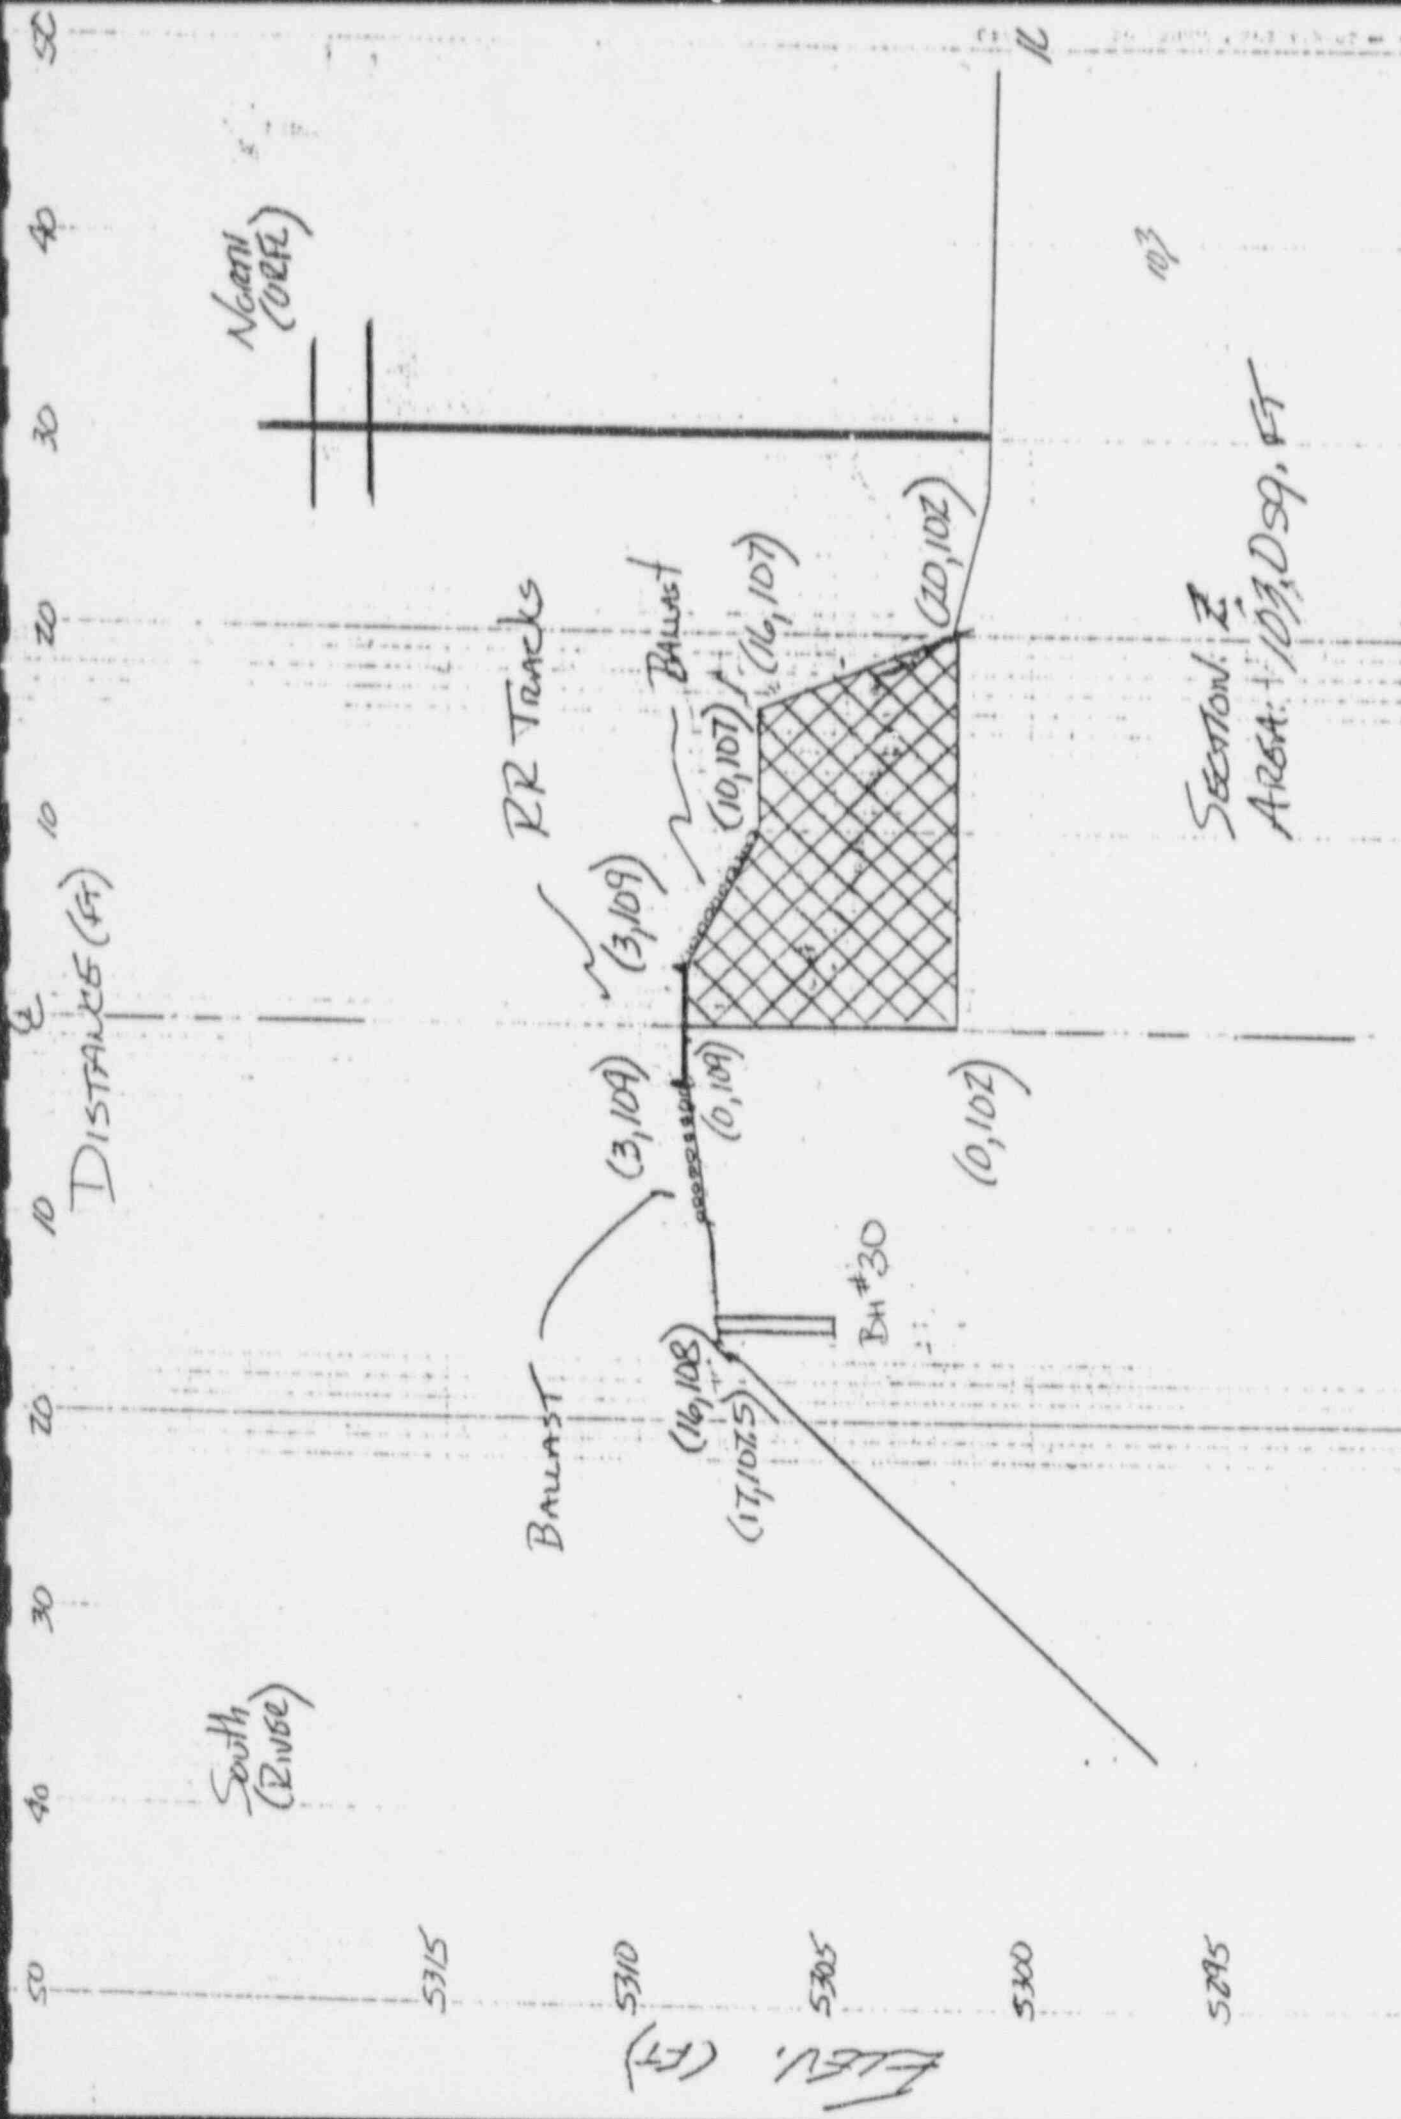

SECTION: Z

SUPPLEMENTAL STANDARDS

OLD RIFLE - RAILROAD RIGHT OF WAY - RF 480

SOUTH
(RIDGE)

NORTH
(OFF)

5315

5310

5305

5300

5295

AREA EXCHANGED
162,660

RR TRACKS

BALLAST

MCI LINE

CONTAMINATION LEFT IN PLACE

SECTION: BB

AREA: 141.45 SQ FT

UTILITY POLE


AREA: 44.80 SQ FT

THIS
AND

Box # 32

Old Right - RAILROAD RIGHT OF WAY - RF 480

SUPPLEMENTAL STANDARDS

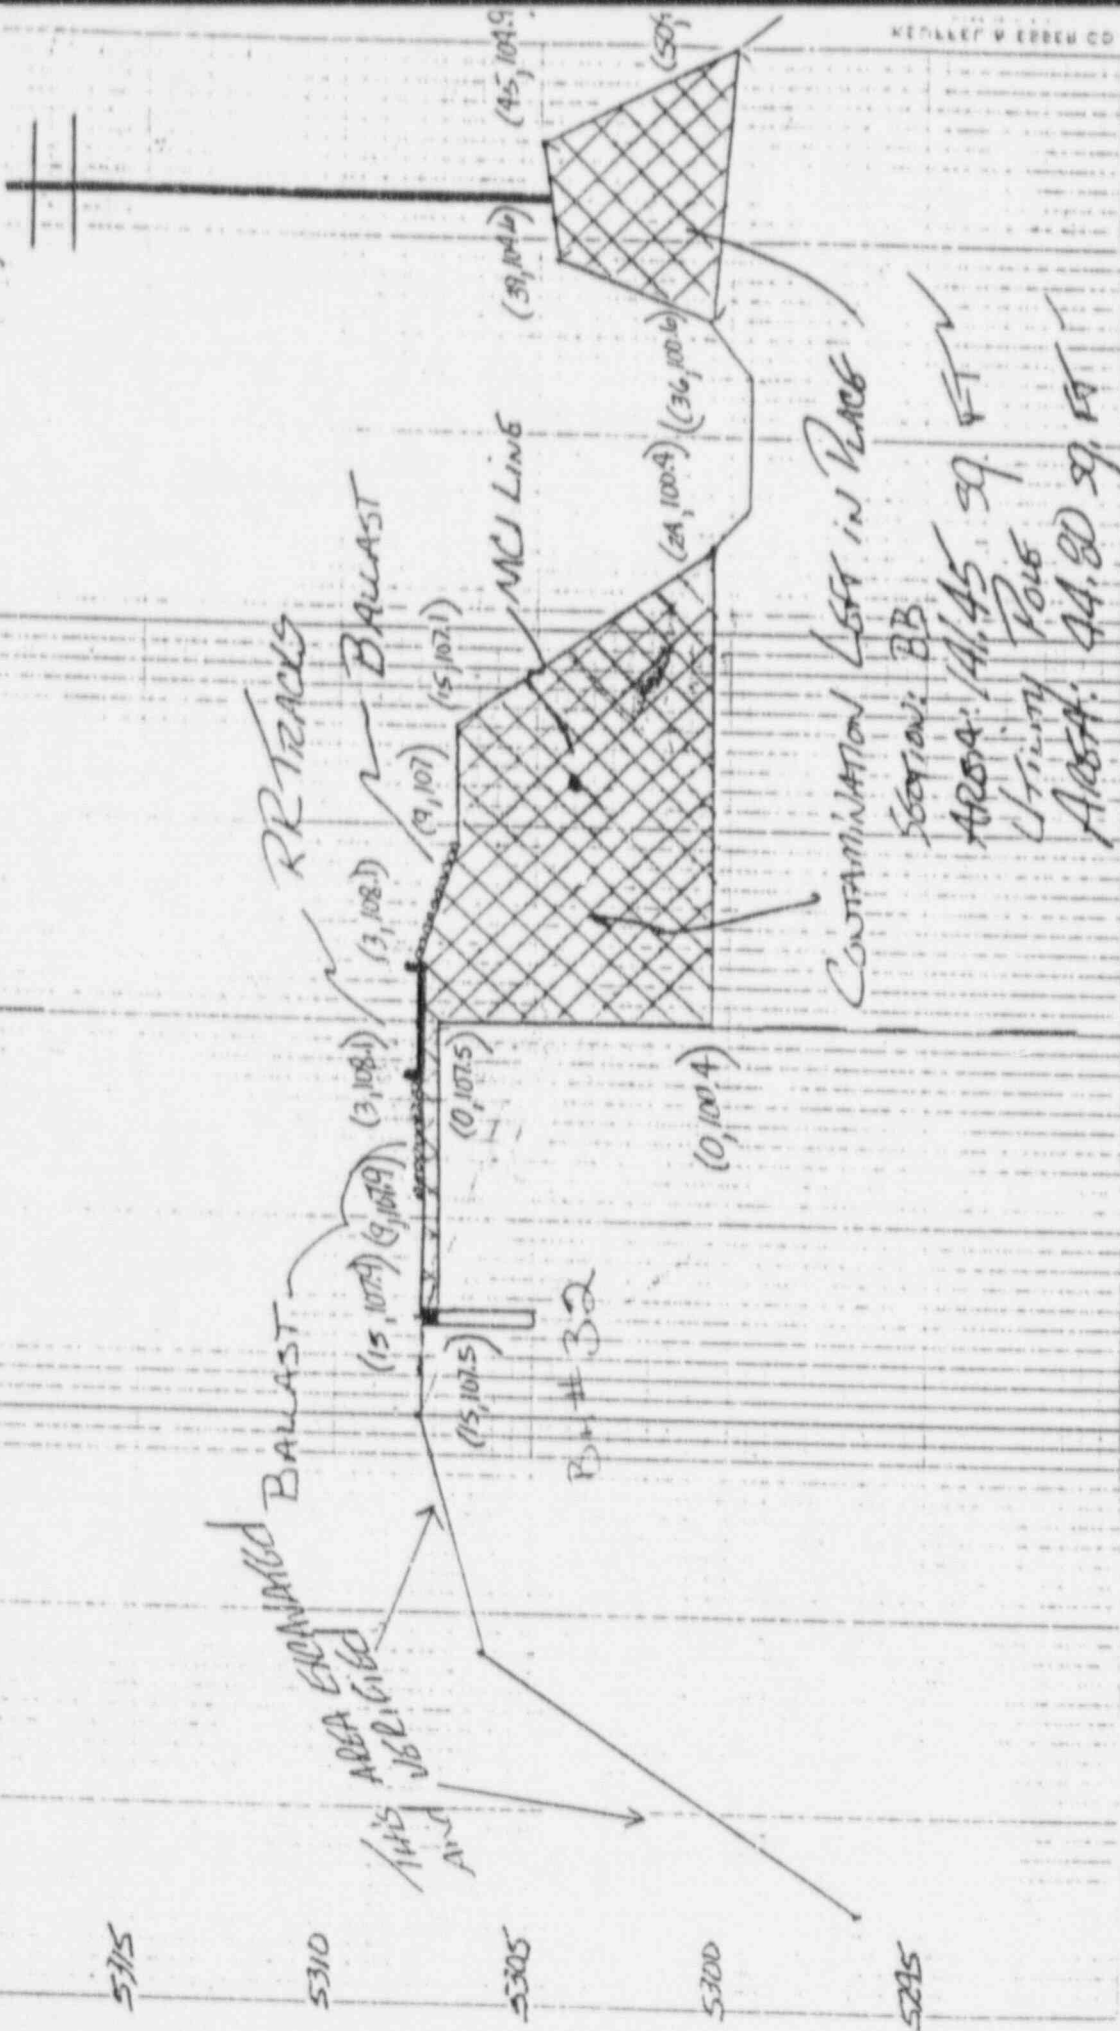

50 40 30 20 10 10 20 30 40 50

South (Ridge)

North (ORFL)

5315

5310 THIS AREA EXCAVATED BALLAST AND VERIFIED

RR TRACKS

BALLAST

5305

BH #33

5300

CONTAMINATION LEFT IN PLACE

MCI LINE

(27, 100.5)

(3, 108.1)

(10, 107.0)

(17, 106.7)

(9, 107.3)

(15, 107)

(2, 107.5)


5295

SECTION: CC

AREA: 8.10 SQ. FT ✓

Old Rifle - RAILROAD RIGHT OF WAY - RF480

SUPPLEMENTAL STANDARDS

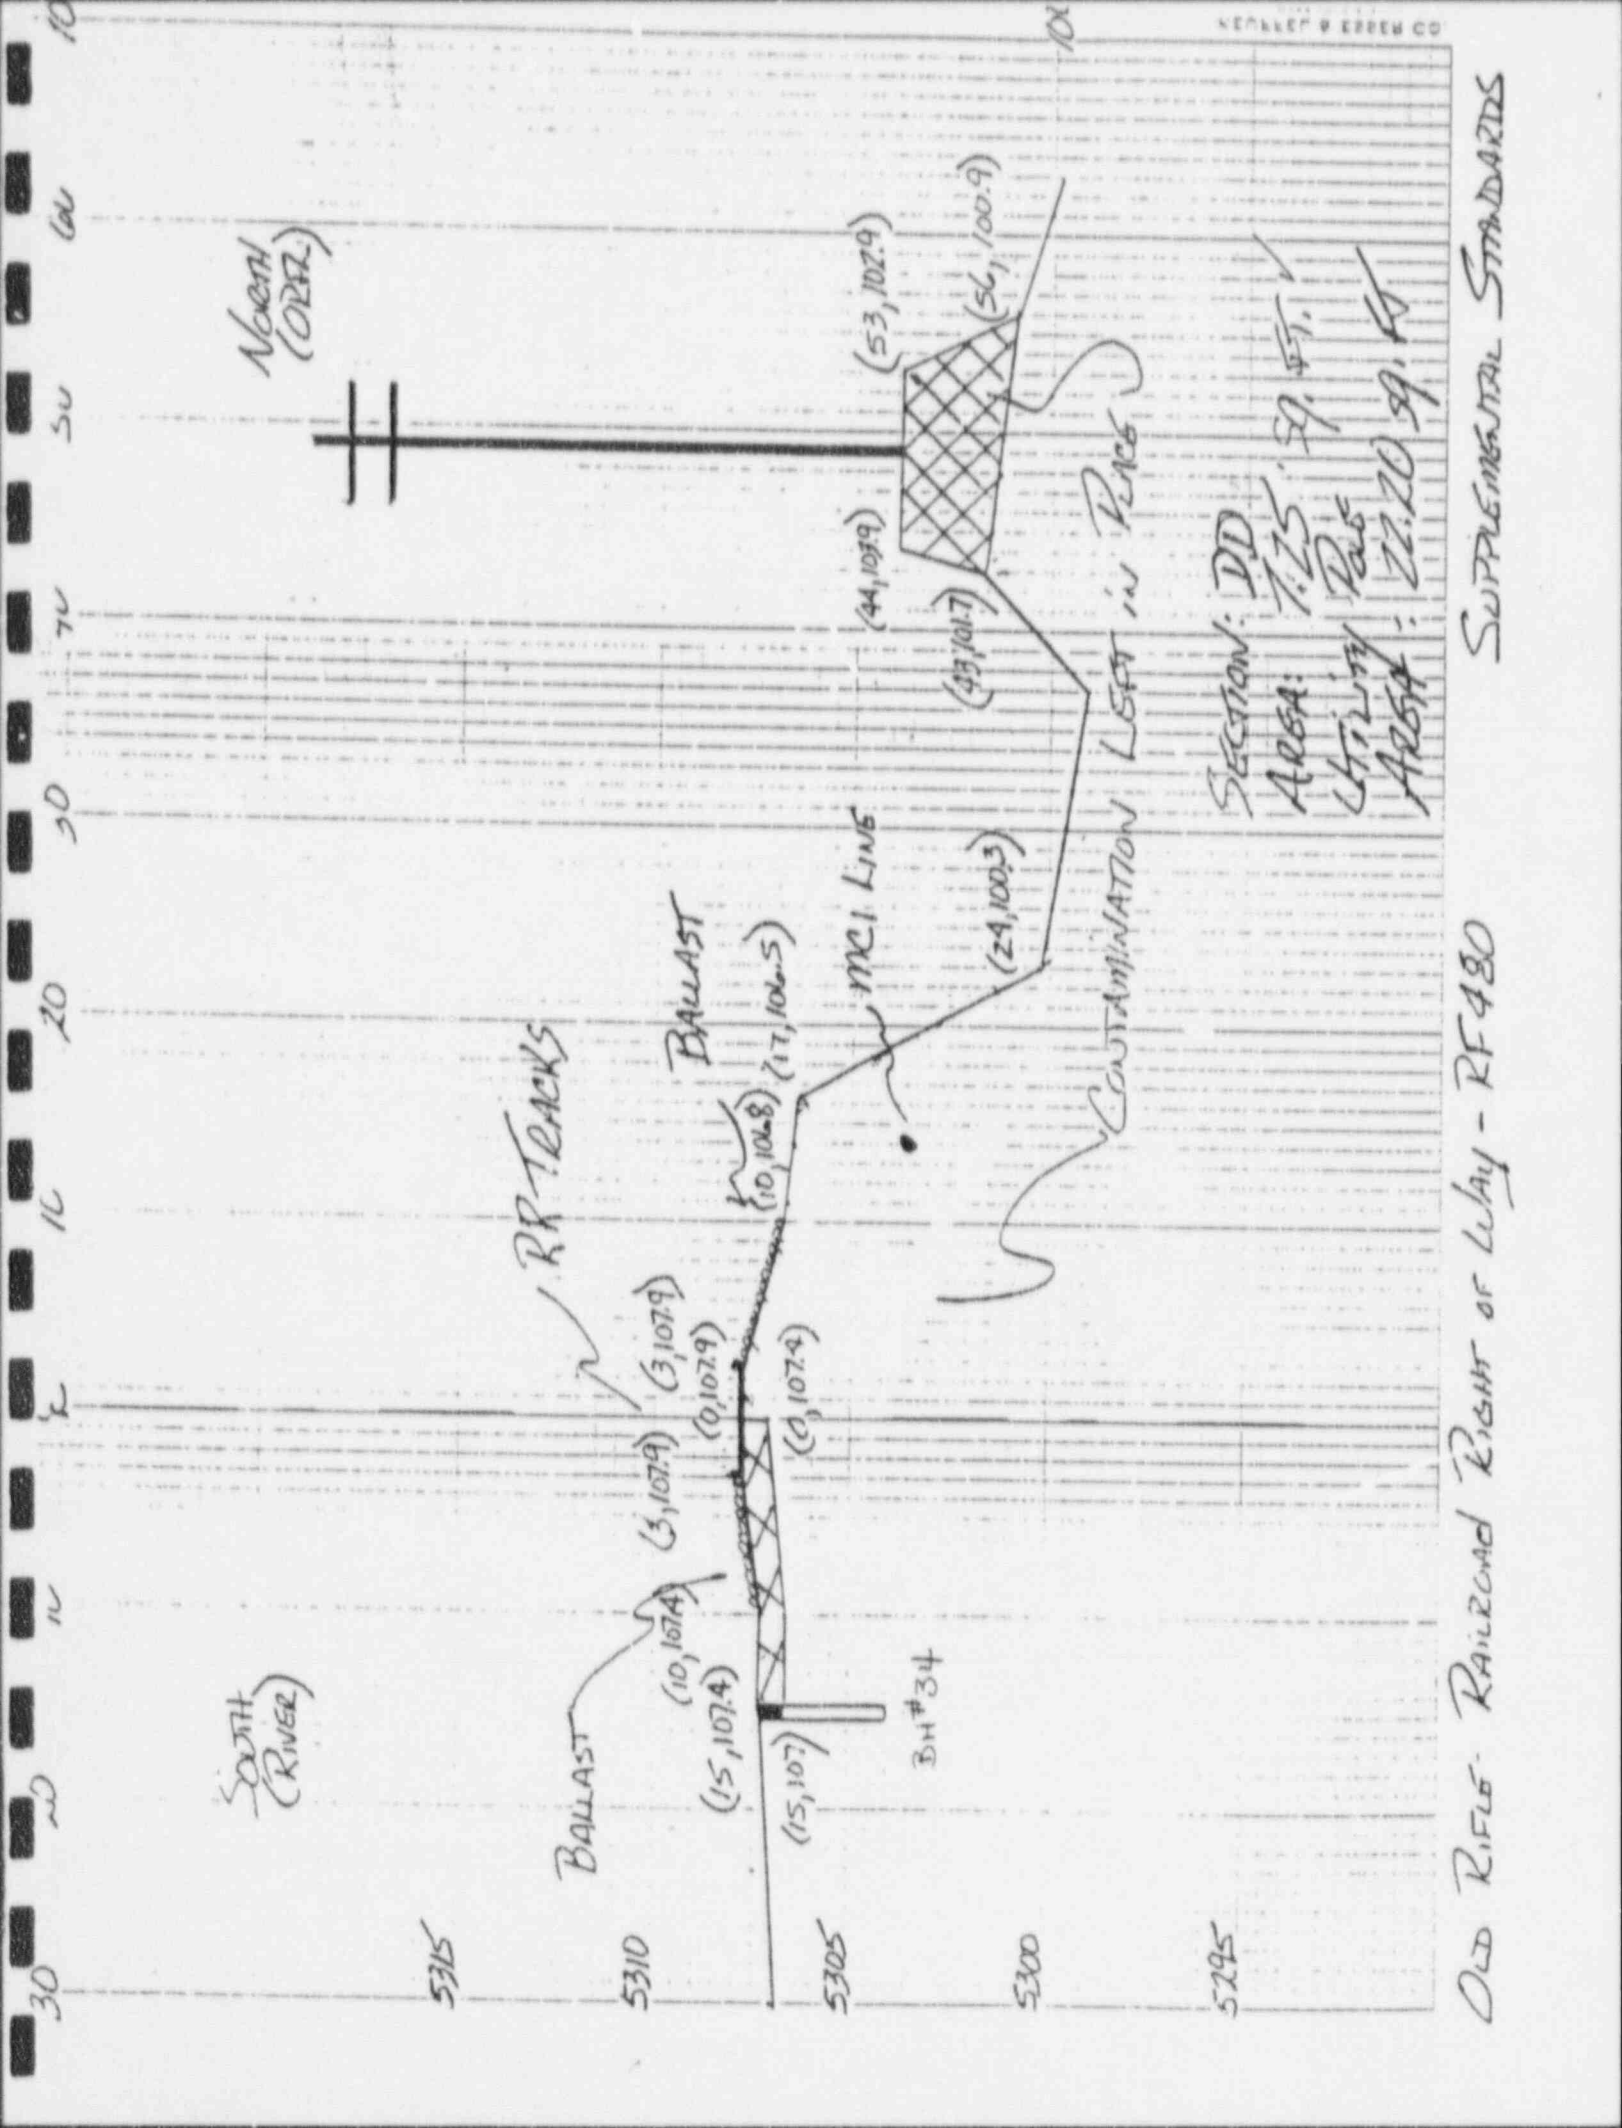

Old Rifle - Railroad Right of Way - RF480

SUPPLEMENTAL STANDARDS

50 40 30 20 10 0 10 20 30 40 50

SOUTH
(RIVER)

NORTH
(ORFL)

5315

5310

5305

5300

5295

THIS AREA EXCAVATED
AND VERIFIED

(15,107) (11,1073) (3,1080) (3,1080) (9,1080) (9,1071) (17,1066)

(15,1065)

BH #35

MCI Line

CONTAMINATION LEFT IN PLACE

(27, 98.9)

SECTION: EE

AREA: 7.30 SQ FT ✓

BOREHOLE LOG

LOGGING CREW: ⁴⁻²⁶⁻⁹⁶ ~~J.R.~~ R. Whigley

SHEET _____ OF _____ PAGE _____

DATE: 4-26-96

INSTRUMENT ID NO. ESP1 2592
SPA-3 406467.22

PROPERTY ID: RF-570 RF-480

AREA: Supplemental standards
(Area 3-1 from RF-510)

NOTES: 1. ALL HOLES ARE 4" DIA. UNLESS OTHERWISE NOTED.
 2. RECORD UNUSUAL CONDITIONS, SUCH AS THE PRESENCE OF WATER IN BOREHOLES AND DEPTH, CASING TYPE AND THICKNESS IF USED, CONCRETE CORES AND THICKNESS, OBSTRUCTIONS, UTILITIES, ETC., IN THE REMARKS SECTION.

| HOLE ID: <u>1A</u> | | HOLE ID: <u>2A</u> | | HOLE ID: <u>3A</u> | | HOLE ID: _____ | |
|--------------------------|--------------------|--------------------------|------------------|--------------------------|------------------|---------------------|-------------|
| TIME DRILLED: <u>N/A</u> | | TIME DRILLED: <u>N/A</u> | | TIME DRILLED: <u>N/A</u> | | TIME DRILLED: _____ | |
| TIME LOGGED: <u>N/A</u> | | TIME LOGGED: <u>N/A</u> | | TIME LOGGED: <u>N/A</u> | | TIME LOGGED: _____ | |
| SOIL TYPE: <u>N/A</u> | | SOIL TYPE: <u>N/A</u> | | SOIL TYPE: <u>N/A</u> | | SOIL TYPE: _____ | |
| DEPTH | COUNTS/1MIN | DEPTH | COUNTS/1MIN | DEPTH | COUNTS/1MIN | DEPTH | COUNTS/1MIN |
| SURFACE | <u>Excavated</u> | SURFACE | <u>Excavated</u> | SURFACE | <u>Excavated</u> | SURFACE | |
| 0" | <u>30 inches</u> | 0" | <u>6 inches</u> | 0" | <u>6 inches</u> | 0" | |
| 6" | <u>before</u> | 6" | <u>1540</u> | 6" | <u>1590</u> | 6" | |
| 12" | <u>drilling</u> | 12" | <u>1800</u> | 12" | <u>1700</u> | 12" | |
| 18" | | 18" | <u>2490</u> | 18" | <u>2120</u> | 18" | |
| 24" | | 24" | <u>2640</u> | 24" | <u>2350</u> | 24" | <u>N/A</u> |
| 30" | <u>4350</u> | 30" | <u>2640</u> | 30" | <u>2510</u> | 30" | |
| 36" | <u>6790</u> | 36" | <u>2660</u> | 36" | <u>2560</u> | 36" | |
| 42" | <u>12,700</u> | 42" | <u>2780</u> | 42" | <u>2590</u> | 42" | |
| 48" | <u>24,700</u> | 48" | <u>AR</u> | 48" | <u>2530</u> | 48" | |
| 54" | <u>48,600</u> | 54" | | 54" | <u>AR</u> | 54" | |
| 60" | <u>66,000</u> | 60" | | 60" | | 60" | |
| 66" | <u>Alarm @ 106</u> | 66" | | 66" | | 66" | |
| 72" | <u>AR</u> | 72" | | 72" | | 72" | |
| 78" | | 78" | | 78" | | 78" | |
| 84" | | 84" | | 84" | | 84" | |
| 90" | | 90" | | 90" | | 90" | |
| 96" | | 96" | | 96" | | 96" | |

REMARKS: # 1A N25348, E59198 30" below grade prior to drilling
2A N25348, E59206 6" below grade prior to drilling
3A N25348, E59186 6" below grade prior to drilling

OCS SAMPLE LOG

RFS10 S.S. Sol. sluff.

SITE NAME

RIFLE, Co

| COUNT DATE INITIAL 20 DAY | SAMPLE ID & LOCATION | DATE SAMPLED | DATE SEALED | OCS # | BI-214 | TI-208 | MASS (grams) | Pa-226 | Th-232 | DEPTH | TECH | COMMENTS |
|---------------------------------|-----------------------|--------------|-------------|-------|-------------------|--------------------------|--------------|--------------------------|----------------------------------|-------|------|-------------------------------------------------------|
| | | | | | INITIAL 20 DAY | pCi INITIAL 20 DAY | | pCi INITIAL 20 DAY | pCi/g INITIAL/CORR. 20 DAY | | | |
| 3-26-95 | RFL-SS-7506 | 3-24-95 | | 5000 | 490.2 | 877.1 | 482 | 1.0 | 1.8 | ✓ | WDW | TH-230 C/F |
| | M-9-07 | | | | | | | | | | | |
| 3-26-95 | RFL-SS-7507 | 3-24-95 | | 494 | 1117 | 891.3 | 523 | 2.1 | 1.7 | ✓ | WDW | TH-230 |
| | M-9-08 | | | | | | | | | | | |
| 3-26-95 | RFL-SS-7508 | 3-24-95 | | 5002 | 1022 | 1109 | 479 | 2.1 | 2.3 | ✓ | WDW | TH-230 |
| | M-9-13 | | | | | | | | | | | |
| 3-26-95 | RFL-SS-7509 | 3-24-95 | | 496 | 737.2 | 769.0 | 457 | 1.6 | 1.7 | ✓ | WDW | TH-230 |
| | M-9-18 | | | | | | | | | | | |
| 3-26-95 | RFL-SS-7510 | 3-24-95 | | 498 | 521.1 | 629.2 | 465 | 1.1 | 1.4 | ✓ | WDW | TH-230 |
| | M-16-03 | | | | | | | | | | | |
| 3-26-95 | RFL-SS-7511 | 3-24-95 | | 5004 | 664.7 | 914.6 | 535 | 1.2 | 1.8 | ✓ | WDW | TH-230 |
| | M-9-23 | | | | | | | | | | | |
| 3-26-95 | RFL-SS-7512 | 3-24-95 | | 4000 | 617.2 | 1057 | 591 | 1.0 | 1.8 | ✓ | WDW | TH-230 |
| | M-16-08 | | | | | | | | | | | |
| 3-27-95 | RFL-SS-7513 | 3-27-95 | | 462 | 1866.0 | 6015.4 | 5051 | 5031 | 162 | ✓ | B | VPS10 @ 51"-60" SS sluff VP 470 N 25348 E 59198 |
| | | | | | | Est. = | | 9056.0 | | | | |
| 3-29-95 | RFL-SS-7514 | 3-28-95 | | 516 | 332430 | 157810 | 457 | 727.4 | 33.2 | | KRC | N 58075 E 53000 ELEV. 6105 |
| | CELL EMANATION #11 | | | | | | | | | | | |
| 3-29-95 | RFL-SS-7515 | 3-28-95 | | 518 | 353030 | 18622 | 523 | 732.4 | 25.4 | | KRC | N 52915 E 52250 ELEV. 6103 |
| | CELL EMANATION #10 | | | | | | | | | | | |

Site Correction Factor = 1.8

VP Correction Factor (if applicable) = 1.8

Count Time = 500 SEC. unless otherwise noted


REVIEWED BY:

RF

Site HP Manager

FOR INFORMATION ONLY

F5 IN-001-1, Rev.1

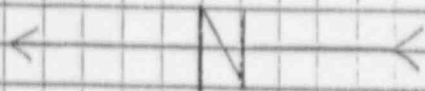

15' from centerline of Railroad Tracks Boundary

Edge of excavation and top of river bank

Grid # 1

N25358.5
E59207

Edge of excavation and top of river bank

#2A

E59206

-W25344
E59207

E5920

#1A

E59198

N25357.5
E59192

N25341
E59192

centerline of Railroad Tracks

#2A

E59196

Grid # 2

15'

N25348

APPENDIX B
SUPPLEMENTAL STANDARDS RECOMMENDATION

APPENDIX B

RECOMMENDATION FOR APPLICATION OF SUPPLEMENTAL STANDARDS

TABLE OF CONTENTS

B.1 APPLICABLE EPA CRITERIA

B.2 INTRODUCTION

 B.2.1 Common Location and Legal Description

 B.2.2 Major Physical Features

 B.2.3 Land Use

 B.2.4 Owner's Input

B.3 RADIOLOGICAL DATA

 B.3.1 Health Risk Analysis

B.4 REMEDIATION ALTERNATIVES

 B.4.1 Alternative 1 - Complete Remediation (All Contaminated Material Removed)

 B.4.1.1 Work Description

 B.4.1.2 Health Risk Analysis

 B.4.1.3 Construction Parameters

 B.4.1.4 Engineering Data

 B.4.2 Alternative 2 - Partial Remediation (Supplemental Standards Application)

 B.4.2.1 Work Description

 B.4.2.2 Health Risk Analysis

 B.4.2.3 Construction Parameters

 B.4.2.4 Engineering Data

 B.4.3 Alternative 3 - No Remediation (Supplemental Standards Application)

 B.4.3.1 Work Description

 B.4.3.2 Health Risk Analysis

 B.4.3.3 Construction Parameters

 B.4.3.4 Engineering Data

B.5 SUMMARY

B.6 RECOMMENDATIONS

TABLES

B.T1 Health Risk Analysis
B.T2 Cost Estimate For Alternative 1 Complete Remediation

DRAWINGS

Supplemental Standards Survey Data: RF-480-030 through 031

ATTACHMENTS

Vicinity Property No. RF-480 Remedial Action Agreement; Appendix B, Remedial Action Plan

EXHIBITS

Letter to Mike Kenyon, Regional Engineer, D&RGR, from MK-Ferguson; Proposed Agreement for Remediation of Vicinity Properties

Letter to MK-Ferguson from Kathleen M. Snead, D&RGR; Remedial Action Agreements

Letter to MK-Ferguson from the State of Colorado; Location 27966 - RF-480

Letter to MK-Ferguson from the Department of Energy

Telecon/Meeting Log with Robert Gutierrez, Road Master, Southern Pacific Railroad

Inter-office Correspondence from D. Charlton to VP file; RF-479, RF-480 Supplemental Standards

B.1 Applicable EPA Criteria

Supplemental Standards Recommendation is in accordance with the regulations set by the Environmental Protection Agency (EPA) in 40 CFR 192. The potential and applicable criteria as stated in 40 CFR 192.21 are as follows:

- a) Remedial action would pose a clear and present risk of injury to workers or to members of the public
- b) Remedial action would directly cause excessive environmental harm
- c) The cost of remedial action at the vicinity site is unreasonably high relative to long-term benefits
- d) The cost of remedial action for cleanup of a building is unreasonably high relative to benefits
- e) There is no known remedial action
- f) Radionuclides other than Radium-226 and its decay products are present

An "X" indicates the appropriate subsection(s) for this recommendation.

B.2 Introduction

This property is a portion of the Denver and Rio Grande Western Railroad south of and adjacent to the Old Rifle Uranium Mill site and north of the Colorado River. The property includes a section of the railroad mainline between Denver and Salt Lake City. This Supplemental Standards Recommendation pertains to areas south of the tracks, the railroad bed, around the bases of eleven utility poles which support railroad operations, and around critical areas of a buried MCI fiber optics line north of the tracks. The north side of this property was partially remediated with the Old Rifle site. An area of contamination south of the tracks was remediated with vicinity property RF-510. Drawings RF-480-030 and RF-480-031 depict the deposits of tailings in the areas for which supplemental standards have been applied. The contaminated area totals approximately 8267 cubic yards covering 2.3 acres.

B.2.1 Common Location and Legal Description

The supplemental standards application area is the Denver and Rio Grande Western Railroad bed south of and adjacent to the Old Rifle Uranium Mill site. The Colorado river abuts the property on the south side. Property RF-510 adjoins RF-480 in the southwest corner. The contaminated material encompasses a total area of 8267 cubic yards.

Legal Description

A legal description for this property is not available.

B.2.2 Major Physical Features

There are no structures on this property. A section of the Denver & Rio Grande Western Railroad mainline, between Denver and Salt Lake City, runs east to west on the property. The property is bordered by the Old Rifle Uranium Mill Site to the north and the Colorado River to the south. On the north side of the railroad tracks is an overhead telegraph line and a buried fiber optic telephone line owned by MCI.

B.2.3 Land Use

The land contains the railroad mainline between Denver and Salt Lake City, and an MCI telephone trunk line. It is used for rail transportation of goods/persons and MCI communication services. The property is not likely to be used for any other purpose in the future.

B.2.4 Owner's Input

Prior to remedial action, the owners of the D&RGW Railroad proposed conditions and requirements for remediation of properties adjacent to and including the railroad. These conditions, including the application of supplemental standards, were pre-approved by the State, the DOE, and the NRC via their concurrence with the Remedial Action Plan for the Rifle Site. MK-Ferguson proceeded with remedial action according to the approved RAP and in accordance with the owner's wishes. No remediation was performed within 15 feet of the centerline of the main tracks and railroad track and ties were not replaced. Refer to the Remedial Action Agreement for specific agreements between the D&RGW Railroad, MK-Ferguson, the State, and the DOE.

B.3 Radiological Data

Appendix A contains the radiological data that is relevant to this Supplemental Standards Recommendation. Appendix A consists of a soil verification data, post-backfill dose rate survey, borehole logs, OCS logs, field notes, and cross-sectional drawings of the supplemental standards area.

The radiological conditions within the Supplemental Standards Recommendation areas are summarized as follows:

- a. Exposure rate range in contaminated area(s) - 9 to 200 $\mu\text{R/hr}$
- b. Average exposure rate over the contaminated area(s) - 28 $\mu\text{R/hr}$

- c. Range for Radium concentration in contaminated area(s) - 0.7 to 90[±] γ pCi/g

Background for the Rifle locale is 13 μ R/h and 1.2 pCi/g Ra-226.

B.3.1 Health Risk Analysis

The analysis of health risks is presented in Table B.T1. Exposure potentials are compared with two criteria as follows:

- a. Long-term exposures are examined based on an allowable exposure rate of 100 mrem per year above background (hereinafter referred to as 100 mrem dose).
- b. Short-term unusual exposures are examined based on an allowable exposure rate of 500 mrem per year above background (hereinafter referred to as 500 mrem dose).

The maximum gamma dose rate at waist level recommended by the International Commission on Radiological Protection (ICRP 1977, 1978) in DOE Order 5400.5 (March, 1990) is 100 mrem. This is the dose limit for an individual member of the general public. Doses which exceed 100 mrem are acceptable when the higher exposures do not persist for long periods and when the average annual dose over an individual's lifetime is expected to be less than 100 mrem. The ICRP and the DOE suggest that dose rates be reduced to "as low as reasonably achievable", but also state that no annual dose shall exceed 500 mrem. The health risk analysis presented in this Recommendation for Supplemental Standards has compared the dose rates measured at waist level with the recommendations of the ICRP and DOE regarding waist level exposures.

The long-term exposure analysis considers three scenarios showing the following:

- a. The required number of hours of continuous exposure to obtain the 100 mrem dose. This scenario is intended to model the exposure received by an individual residing on the site in the extreme case where no time away from the site is considered.
- b. The hours per day of exposure during a continuous one year period required to receive the 100 mrem dose. This scenario is intended to represent a maximum allowable daily exposure by an individual who occupies the point where the high gamma reading occurs.
- c. The hours per day of exposure during a one year period, utilizing week days only (260 days), required to receive the 100 mrem dose. This scenario models the potential exposure that could be received by an individual working in the area the indicated number of hours daily for one year.

The short-term unusual exposure analysis also considers three potential scenarios as follow:

- a. The required number of hours of continuous exposure to obtain the 500 mrem dose. The intent of this scenario is to allow examination of the estimated time of continuous exposure required to receive the allowable dose.
- b. The number of 48-hour temporary occupancy periods in one year necessary to receive a 500 mrem dose. This scenario represents the case where an individual occupies the site for repair work or other short-term purposes.
- c. The number of 24-hour periods of exposure in one year necessary to receive a 500 mrem dose. This scenario considers emergency operations to perform repair work at the site.

The worst case scenario in the health risk analysis is based on minimum background and maximum dose rates recorded at waist level without consideration of the relative physical location of each. In every case, the scenarios presented above can be described as unlikely, but possible. The scenarios do not create a model of likely situations, but present data that can be used to evaluate the potential for a health hazard if this supplemental standards recommendation is approved.

The maximum known gamma exposure rate, 200 μ R/h, occurring along the northeastern portion of the supplemental standards area is equal to the worst case scenario. The worst case scenario depicts occupation of a site for an average of 1.4 hours per day during a one year period (500 hours total) to receive the 100 mrem dose. Due to the remote location of this exposure rate, it is highly unlikely that an individual would occupy the site for 500 hours in a given year and reach this "long-term" dose.

The most likely situation where individuals would be exposed to the contaminated material is the future occupational scenario. Future maintenance and repair of railroad tracks and utilities will cause the contaminated material to be disturbed and workers to be exposed to elevated exposure rates. The nature of this work makes the "short-term, unusual" exposure analysis more appropriate than a long-term exposure analysis. Under the 200 μ R/h worst case scenario, a worker would need to be in the proximity of the contaminated material for approximately 2,500 hours during a one-year period to receive a 500 mrem dose. This equates to approximately fifty-two (52) 48-hour repair scenarios. It is unlikely that an individual would spend this amount of time in the high gamma contaminated area in any given year.

B.4 Remediation Alternatives

Three alternatives are available for all properties. Each alternative may have several options. The evaluation of an alternative action in any area of tailings contamination logically includes consideration of the cost and health risk associated with the available choice. Three alternatives - Complete Remediation, Partial Remediation (Application of Supplemental Standards), or No Remediation (Application of Supplemental Standards) - are considered.

B.4.1 Alternative 1 - Complete Remediation (All Contaminated Material Remediated)

B.4.1.1 Work Description

The work required for this alternative is to excavate south of the railroad tracks, the railroad bed, around eleven utility poles, and around the buried MCI cable to the depth of contamination, verify, and backfill. A coffer dam would be constructed to prevent flooding during excavation. Shutting down the railroad would be required to reduce the risk of injury to workers and derailment of a train. Approximately 2320 feet of railroad track would be removed and replaced, along with the associated ballast. Excavation around the utility poles would require the removal and replacement of poles and associated telegraph/power lines.

This would require a substantial amount of work and monies comparable to the amount of benefits received from remediation. Damage to the stability of the railroad tracks in this area could further endanger railroad employees and passengers.

B.4.1.2 Health Risk Analysis

Health risks in the supplemental standards application area, due to tailings contamination, would be reduced to within the EPA standards.

B.4.1.3 Construction Parameters

Construction of this alternative consists of building a coffer dam to divert the river, shutting down the railroad line, and excavating the railroad bed and south of the tracks. Tracks found to have contamination under them would be removed. Hand excavation would be required around the buried fiber optics line. Telegraph/power lines and poles would be removed for excavation of contaminated material around the poles. Once verification is complete, restoration would include replacement of ballast, railroad bed, tracks, utility lines and poles, and removal of coffer dam to restore river bank. The property is restored to its original condition.

B.4.1.4 Engineering Data

No areas of contamination which exceed the EPA standards will remain in place. The estimated Subcontractor cost of remedial action work required for this alternative is estimated to be \$748,740.00. This cost estimate does not include the loss of revenue D & RGW Railroad may incur. Given the nature and expense of fiber optics, excavation around the fiber optics line poses inherent risks that could cause costs to escalate above current estimates.

B.4.2 Alternative 2 - Partial Remediation (Supplemental Standards Application)

B.4.2.1 Work Description

The work involved in this alternative was performed and is described in the Completion Report for RF-480. Contaminated material was excavated to within 2 feet of the edge of ballast maintaining a 2 to 1 slope on the north side of the railroad. One area of contamination was excavated on the south side of the railroad. The railroad utility poles were excavated 2 feet in depth and 8 feet in diameter. If contamination levels were still above EPA Standards, supplemental standards were applied. Soil supporting eleven utility poles is still contaminated.

B.4.2.2 Health Risk Analysis

Health risks associated with the railroad bed and utility poles due to tailings contamination is summarized in Table B.T1. Contamination remains in place in the railroad embankment, around eleven utility poles, and around the buried fiber optic telephone cable north of the tracks.

B.4.2.3 Construction Parameters

The Construction Parameters were to excavate contaminated material north of the railroad tracks on a slope of 2 to 1 from a point 2 feet from the edge of ballast down to the depth of contamination and continue excavating north to the edge of the property.

B.4.2.4 Engineering Data

No areas of contamination which exceed the EPA standards remain in place beyond the north slope of the railroad bed. The amount of contamination exceeding EPA standards remaining in place is approximately 8295 cubic yards. The actual Subcontractor cost of remedial action work required for this alternative is \$129,196.00.

B.4.3 Alternative 3 - No Remediation (Supplemental Standards Application)

B.4.3.1 Work Description

No work is required for this alternative.

B.4.3.2 Health Risk Analysis

The health risks associated with this alternative is not required since Alternative 2 was performed.

B.4.3.3 Construction Parameters

Construction is not required for this alternative.

B.4.3.4 Engineering Data

No cost is associated with this alternative. All areas of contamination which exceed the EPA standards will remain in place.

B.5 Summary

Partial Remediation with the application of supplemental standards was performed. A person would have to occupy the point of high gamma exposure for a continuous period of 500 hours to receive a 100 mrem dose. It is highly unlikely that an individual would be exposed for the amount of time necessary to exceed the recommended annual maximum dose of 100 mrem due both to the length of time required and the location of the exposure rates. A railroad work crew would have to spend 50 ten hour work days to exceed 100 mrem in one year.

Each alternative examined by this Recommendation can be summarized as follows:

Alternative I - Complete Remediation (All Contaminated Material Remediated)

Health Risk - Reduced to within EPA standards

Estimated Additional Construction Cost - \$748,740.00

Approximate Volume of Contaminated Materials Removed - 24,915 cy

Approximate Volume of Contaminated Materials Remaining - 0 cy

Alternative 2 - Partial Remediation (Supplemental Standards Application)

Health Risk - See Table B.T1. Contamination remains in the railroad bed, south of the railroad tracks, around eleven utility poles, and around a buried MCI fiber optic cable.

Actual Construction Cost - \$129,196.00

Approximate Volume of Contaminated Materials Removed - 16,678 cy

Approximate Volume of Contaminated Materials Remaining - 8,295 cy

Alternative 3 - No remediation (Supplemental Standards Application)

Not applicable since Alternative 2 has been performed.

B.6 Recommendations

Supplemental Standards (Partial Remediation) should be applied in accordance with 40 CFR 192.21, Criteria A and C (see Section B.1).


TABLE B.T1
HEALTH RISK ANALYSIS
PROPERTY RF-480

| SCENARIO | RESULTS |
|---|-------------------|
| 100 mrem Dose | |
| A. Required number of hours of continuous exposure to obtain the 100 mrem dose. | 500 hours |
| B. The hours per day of exposure during a continuous one year period required to receive the 100 mrem dose. | 1.4 hours per day |
| C. The hours per day of exposure during a one year period utilizing week days only (260 days) required to receive the 100 mrem dose. | 1.9 hours per day |
| 500 mrem Dose | |
| A. The required number of hours of continuous exposure to obtain the 500 mrem dose. | 2,500 hours |
| B. The number of 48-hour temporary occupancy periods in one year necessary to receive a 500 mrem dose. | 52 |
| C. The number of 24-hour periods of exposure in one year necessary to receive a 500 mrem dose. | 104 |

The results are figured from using the point of the highest gamma. A person would have to stand at the point continuously to achieve the dose given.


TABLE B.T2
 COST ESTIMATE FOR ALTERNATIVE 1
 COMPLETE REMEDIATION
 PROPERTY RF-480

| Activity No. | Activity | Unit Price | Quantity | Estimated Cost |
|--------------------------------|-----------------------------------------------|------------|-----------|-------------------|
| 1.0 | Machine Excavation | 15.04 | 8273.5 cy | 124,433.00 |
| 1.1 | Hand Excavation | 80.54 | 21.5 cy | 1,732.00 |
| 2.0 | Common Fill | 21.54 | 21.5 cy | 463.00 |
| 3.0 | Structural Backfill | 24.03 | 8273.5 cy | 198,812.00 |
| 480.1 | Remove/Replace RR | 40.20 | 2320.0 lf | 93,264.00 |
| 480.2 | Construct & Remove Cofferdam (Common Fill) | 26.25 | 5442.0 cy | 142,853.00 |
| 480.3 | Rip Rap | 36.04 | 773.0 cy | 27,859.00 |
| 480.4 | Remove/Replace Utility Poles & Wires | 9,579.00 | ls | 9,579.00 |
| Subtotal | | | | \$ 598,995.00 |
| 5% Subcontractor's Contingency | | | | 29,950.00 |
| 20% Overhead & Profit | | | | <u>119,799.00</u> |
| Total (Rounded) | | | | \$ 748,740.00 |

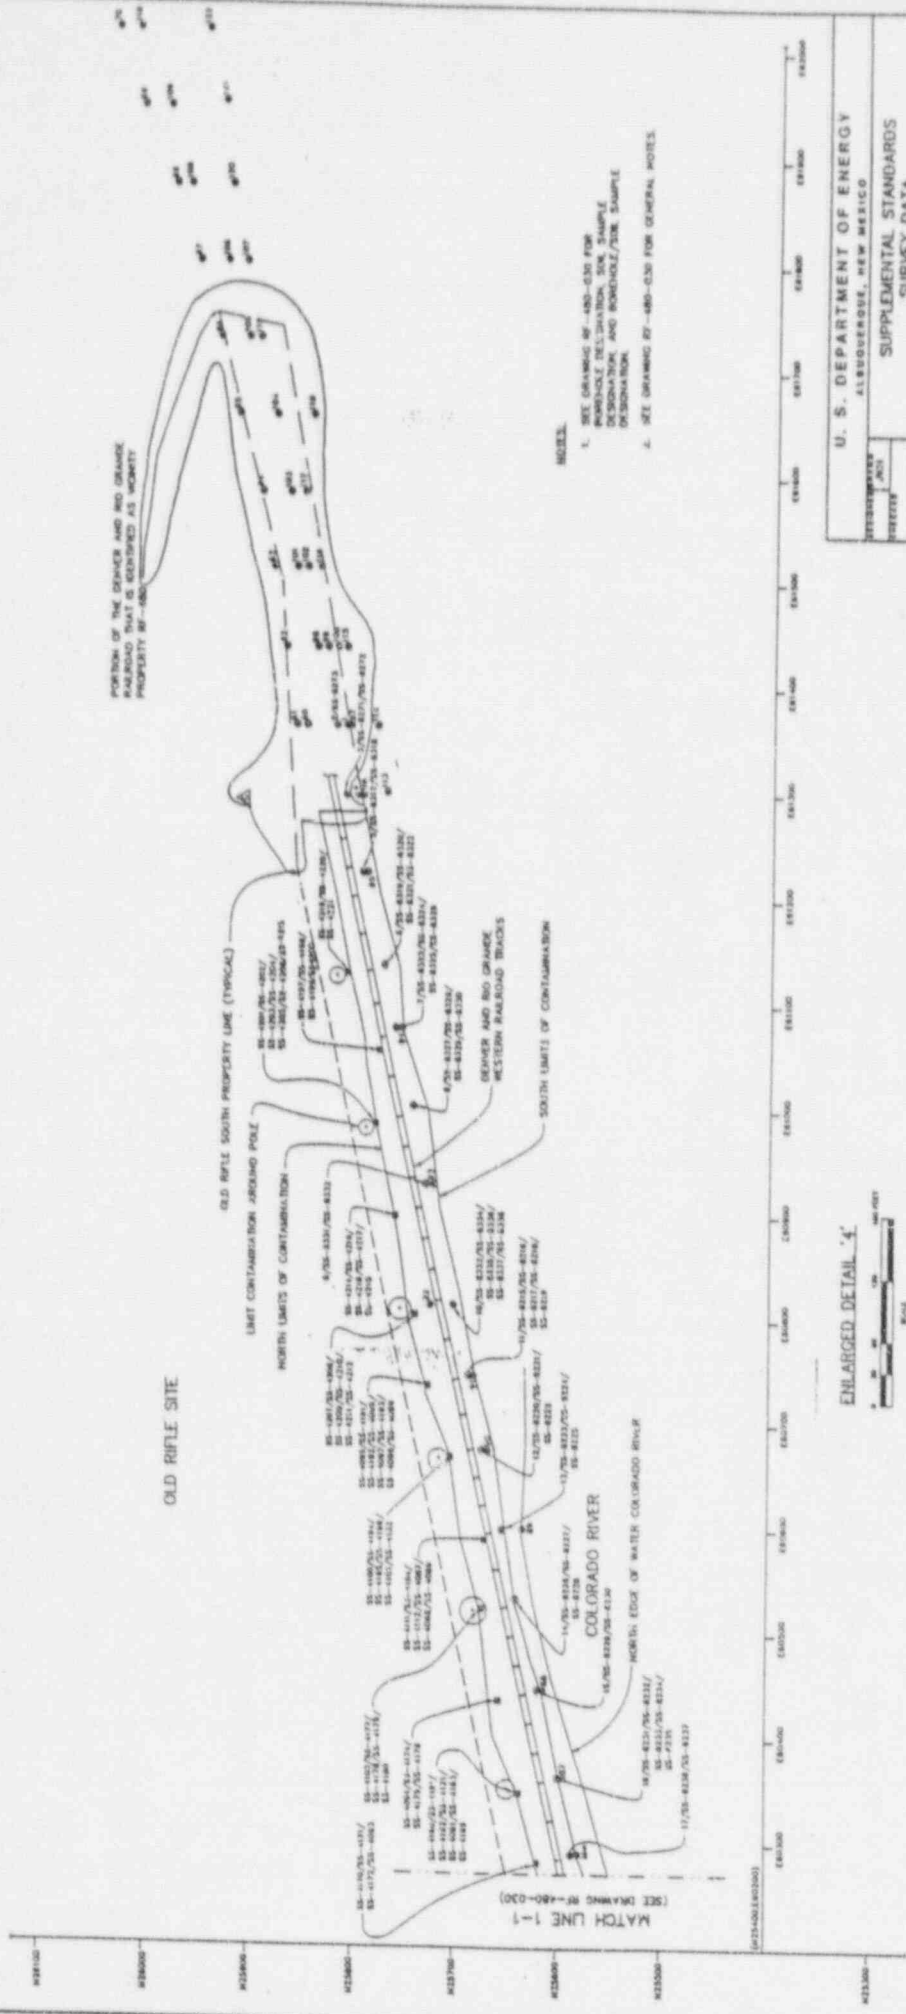

PORTION OF THE DENVER AND RIO GRANDE RAILROAD THAT IS IDENTIFIED AS WORKING PROPERTY RF-480

- NOTES
 - SEE DRAWING RF-480-030 FOR GENERAL NOTES.

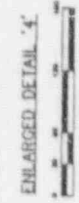

U. S. DEPARTMENT OF ENERGY
ALBUQUERQUE, NEW MEXICO

SUPPLEMENTAL STANDARDS
SURVEY DATA
RF-480

PROJECT NR
MORRISON KHUUSEN
DE-AC04-83AL1879A
REVISED NR-480-031



MATCH LINE 1-1
(SEE DRAWING RF-480-030)

Vicinity Property No. RF-480

ATTACHMENTS

ORIGINAL

Vicinity Property No. RF-480
DOE Agreement No. DE-R004-94AL97407

APPENDIX B
VICINITY PROPERTY
REMEDIAL ACTION PLAN

PROPERTY: ADDRESS South of Old Rifle Site
Rifle, Colorado 81650

OWNER: NAME The Denver and Rio Grande Western
Railroad Company
P.O Box 5482
Denver, CO 80217

ORIGINAL

Vicinity Property No. RF-480
DOE Agreement No. DE-R004-94AL97407

Surveys have shown that low-level radioactive contamination exists on this property. In order to meet criteria established for contaminated properties associated with the RIFLE Site, it will be necessary to remove contaminated soil and materials and, as may be required, such plantings and property improvements on the affected areas as shown in Appendix A. (NOTE: These are estimates based upon preliminary radiological surveys, and the exact amounts of property affected and the scope of work will be determined at the time of excavation).

Following removal of contaminated material and restoration of the property, the Department of Energy (DOE) will certify that the property meets applicable radiological criteria. Every effort will be made to restore the property as nearly as reasonably practical to its original condition. Efforts will be made to minimize disruptions and inconvenience to occupants.

On this property it is anticipated that the following improvements will be affected:

1. Native Growth
2. Fencing

The following sequence of operations is anticipated for Remedial Action on this property:

- A. The railroad shall be given 30 days notice prior to the start of remediation.
- B. The railroad shall provide a flagman while remediation is being performed.
- C. Installation of safety/security fence, as needed, for protection of the public during the cleanup.
- D. Removal of fence, as required, for excavation.
- E. Installation and removal, by the railroad, of a temporary crossing to access contaminated material on the south side of the tracks. This crossing to remain in place for the duration of the material removal only.
- E. Radiological measurements to mark contamination limits and guide the excavation, determining whether sufficient material has been removed.
- F. Dust control measures, as needed, during excavation and loading to minimize airborne contamination.
- G. Excavation of contaminated material shall be performed in accordance with the Drawings found in Appendix A.

ORIGINAL

Vicinity Property No. RF-480
DOE Agreement No. DE-R004-94AL97407

- H. Trucks will transport the contaminated materials from the vicinity property to the designated disposal site.
- I. Vehicles and equipment will cross the railroad tracks only at designated crossings.
- J. Remediation shall not be performed within 15 feet of the centerline on the track(s). Supplemental standards, in accordance with 40 CFR 192, shall be applied to this area.
- K. Backfill and restoration of the excavated areas to their original conditions.
- L. Replacement of fence to its original location, or replacement with new fencing if the original cannot be salvaged.
- M. Removal of safety/security fence, as needed, at completion of work.

Vicinity Property No. RF-480

EXHIBITS

ENGINEERS
AND
CONSTRUCTORS



HEADQUARTERS OFFICE
ONE ERIEVIEW PLAZA
CLEVELAND, OHIO U.S.A. 44114
PHONE: (216) 523-5600/TELEX: 985542

REPLY TO: MK-FERGUSON COMPANY
REMEDIAL ACTIONS
CONTRACTOR-UMTRA PROJECT
P.O. BOX 9138
ALBUQUERQUE, NEW MEXICO U.S.A. 87119

September 1, 1992

Mr. Mike Kenyon
Regional Engineer
Denver and Rio Grande Railroad
P.O. Box 5482
Denver, Colorado 80217

SUBJECT: UMTRA - Rifle, Co.
Proposed Agreement for Remediation of Vicinity Properties

Dear Mr. Kenyon:

Per our meeting on August 6, 1992, the following items are proposed conditions and requirements for the remediation of properties adjacent to the Denver and Rio Grande Railroad in Rifle, Colorado.

General Conditions:

- 1) The railroad will provide a flagman while remediation is being performed on all properties, except Vicinity Property (VP) No. RF-489 north of U.S. Hwy 50. The flagman and/or railroad representative will identify where all clean track and ties removed, if any, are to be placed.
- 2) The railroad requests that they be given 30 days notice prior to the start of remediation on any of these properties.

Vicinity Property RF-103 (Switching Yard):

- 1) Any remediation performed within 15 feet of centerline on the main track(s) will be done so at the discretion of MK-F Site Engineer and railroad's representative.
- 2) Remediation near the two main spur lines may include ballast areas up to the edge of the ties. The depth of excavation shall be limited so as to not damage the structural integrity of the tracks or ties.
- 3) On all secondary spur lines, MK-F subcontractor will remove track and ties in contaminated areas. If track or ties are found to be uncontaminated, they will be placed in a pre-designated area specified by railroad representative.
- 4) A temporary crossing will be installed at VP No. RF-103 to remove stockpiled contaminated material on the south side of the main tracks. This crossing is to remain in place only for the duration of material removal. The railroad will install

0502KZ

RF-103
FILE

MK-FERGUSON COMPANY
Mr. MIKE Kenyon
Page 2
September 1, 1992

and remove the temporary crossing (strictly at cost) at MK-F's expense. MK-F will receive a cost estimate prior to the crossing installation.

East (Old) Rifle Site:

- 1) No remediation will be performed within 15 feet of centerline on the main track(s).
- 2) The subcontractor will clean and stockpile contaminated material on the south side of the main tracks. Temporary crossings will be installed on the southwest and southeast sides of the Old Rifle Site to remove stockpiled material from the south side of the main tracks. These crossings are to remain in place for the duration of material removal. The railroad will install and remove the temporary crossings (strictly at cost) at MK-F's expense. MK-F will receive a cost estimate prior to the crossings' installation.

West (New) Rifle Site:

- 1) No remediation will be performed within 15 feet of centerline on the main track(s).

Vicinity Property RF-489 (North of U.S. Hwy. 50):


- 1) MK-F's subcontractor will remove track and ties in contaminated areas only. If track or ties are found to be uncontaminated, they will be taken and placed at the pre-designated area at RF-103 specified by a railroad representative.

On all properties, railroad track and ties will not be replaced. Areas remediated will be backfilled with common fill to match existing elevations.

If you have any questions, or would like to discuss any of these issues, please contact the undersigned at 1-800-443-4379.

Sincerely,

MK-FERGUSON COMPANY


R. A. Pommerening
Vicinity Property Manager

RAP/rd

Enclosures:

cc: w/o enclosures:
P. Mann, DOE/UMTRA
S. Arp, DOE/UMTRA

bcc: w/enclosures:
R. S. Withee, Rifle
R. A. Pommerening
bcc: w/o enclosures:
C. R. Spencer
R. E. Cooney
D. A. Charlton
R. D'Arezzo
File
File-EDT

J. Hams, CDH

0502KZ



Southern Pacific Lines

THE DENVER AND RIO GRAND WESTERN RAIL ROAD COMPANY
Law Department
P.O. Box 5482 • Denver, Colorado 80217
(303) 505-2336 • Fax (303) 505-2318

James P. Gattin
General Attorney

March 30, 1994

Direct Dial
505-2337

VIA FEDERAL EXPRESS

David A. Charlton
Vicinity Property Manager
MK-Ferguson Company
P.O. Box 9136
Albuquerque, New Mexico 87119

Re: Rifle, Colorado Site
Remedial Action Agreements

Dear Mr. Charlton:

Enclosed in reference to the Rifle, Colorado site are the following Agreements:

Remedial Action Agreement (RAA) DE-R004-93AL74848, RF-103
Remedial Action Agreement (RAA) DE-R004-94AL97406, RF-477
Remedial Action Agreement (RAA) DE-R004-94AL97407, RF-480
Remedial Action Agreement (RAA) DE-R004-93AL94846, RF-489

These have already been signed by Mr. Glenn Michael, who is the Vice President of Operations of Southern Pacific, here in Denver. Please pass them on to the correct channels.

Thank you for your attention to this matter. If you have any questions, please feel free to call me.

Very truly yours,

Kathleen M. Snead

KMS/skd

Enclosures

STATE OF COLORADO

COLORADO DEPARTMENT OF HEALTH

Dedicated to protecting and improving the health and environment of the people of Colorado

Grand Junction Regional Office
222 S. 6th Street, Rm. 232
Grand Junction, CO 81501-2768
FAX: (303) 248-7198



Roy Romer
Governor
Patricia A. Nolan, MD, MPH
Executive Director

MK-FERGUSON CO.
ALBUQUERQUE

APR 26 1994

RECEIVED

April 19, 1994

Mr. David A. Charlton
MK-Ferguson Company
Remedial Actions
Contractor-UMTRA Project
P. O. Box 9136
Albuquerque, NM 87119

RE: Location 27966 - RF-480
South of Old Rifle Site, Rifle, CO 81650

Dear Mr. Charlton:

A review of the Vicinity Property Remedial Action Agreement for the noted location has been completed. Based upon the information provided, the basic design for remedial action is acceptable.

Should you require additional information regarding our review please contact Jim Hams in our Grand Junction office.

Sincerely,

G. A. Franz, III
Hazardous Materials and
Waste Management Division

GAF:ae

cc: Woody Woodworth, DOE-AL
Location File



Department of Energy
Albuquerque Operations Office
P. O. Box 5400
Albuquerque, New Mexico 87185-5400

MK-FERGUSON CO
ALBUQUERQUE

MAY 03 1994

APR 30 1994

RECEIVED

Mr. David A. Charlton
UMTRA Project Vicinity Property Manager
MK-Ferguson Company
P.O. Box 9136
Albuquerque, NM 87119

Dear Mr. Charlton:

Enclosed are the signed and executed copies of Remedial Action Agreements RF-103 (DE-R004-93AL74848), RF-477 (DE-R004-94AL97406), and RF-480 (DE-R004-94AL97407), and RF-489 (DE-R004-93AL74846) for remediation of vicinity properties located at Rifle, Colorado under DOE Contract DE-AC04-83AL18796. Please ensure that our office is on distribution to receive a copy of these executed agreements.

If you have any questions, please call me at 845-6960.

Sincerely,

Melanie J. Thomas

Melanie J. Thomas
Contracting Officer
Programs and R&D Branch
Contracts and Procurement Division

Enclosure

cc w/o enclosure:
W. Woodworth, UMTRA
S. Arp, UMTRA
K. Landolt, OCC

TELECON/MEETING

PERSON CONTACTED: ROBERT GUTIERREZ (ROAD MASTER) DATE: 4/6/95

AFFILIATION: SOUTHERN PACIFIC RAILROAD

SUBJECT: BOREHOUGING BETWEEN RAILS

TELEPHONE: (303) 379-1370

INCOMING _____

OUTGOING 3:30 pm

SUMMARY OF DISCUSSION:

I CONTACTED MR. ROBERT GUTIERREZ TO DISCUSS BOREHOUGING BETWEEN
THE RAILS ON THE MAIN LINE TO CHARACTERIZE THE
CONTAMINATION BEING LEFT FOR SUPPLEMENTAL STANDARDS.
ROBERT ADVISED THAT THIS BOREHOUGING WAS NOT PERMISSIBLE
DUE TO SAFETY HAZARDS TO DRIVING PERSONNEL AND
POSSIBLE DAMAGE TO THE RAIL LINE.

- DISTRIBUTION:
- | | |
|-------------------------|----------|
| 1. <u>FILE - RF-103</u> | 4. _____ |
| 2. <u>D. CHARLTON</u> | 5. _____ |
| 3. <u>BOB FEWELL</u> | 6. _____ |

SIGNATURE: Scott B Zw

Art ac

Jim _____

Ken KPC



MK-FERGUSON COMPANY
A MORRISON KNUDSEN COMPANY

INTER-OFFICE CORRESPONDENCE

TO: Note to File
LOCATION: Albuquerque
SUBJECT: RF-479, RF-480 Supplemental Standards

DATE: January 4, 1995
FROM: D. Charlton *DAC*
LOCATION: Albuquerque

First and foremost, all concurring parties, (DOE, CDPHE, NRC), have consented via the Old Rifle Site drawings and the RAP to the application of Supplemental Standards on RF-479 and RF-480. However, an inspection of the subject VPs was made by representatives of DOE (Sharon Arp), CDPHE (Bud Franz and Jim Hams), and MK-Ferguson Company/RUST (Dave Charlton, Bob Fencil, Nick Abraumiuk, Randy Withee, Scott Bunney, plus several other RUST and MK-F people), and MKES (Grant Cherrington) to assess the extent of remedial actions performed to date and to discuss whether additional excavation was necessary prior to the application of Supplemental Standards.

On RF-479, the south side of the property abutting the site had been remediated to the "angle of repose" and/or to the extent deemed safe, i.e., the roadway would collapse if additional material was removed from the slope. One notes that the final depth of excavation had not been reached in all of the eastern half of the Old Rifle Site. All persons attending the meeting agreed that when the depth of excavation was reached and given the planned restoration (backfill, etc.), Supplemental standards were applicable via 40 CFR 192.21.a and 192.21.c, i.e., public safety and "semi-permanent" location. One notes the same rationale will be used on the north side of the roadway when excavation is performed there.

On RF-480 two items of interest were looked at and discussed. The first, material left under the tracks, was pretty straightforward. MK-F had caused excavation on the north side of the tracks to be performed to the extent deemed safe. I believe everyone agreed. The second item was material left around the poles supporting the railroad's power and communication lines. MK-F had caused excavation to the extent that the poles would remain erect and suggested the remaining material be left in place. It was stated that the railroad had a rig that ran on the tracks that would support the poles while the contaminated material was being removed. However, the railroad is reluctant to shut down this main East-West set of tracks for the length of time necessary to remove the material from around the poles and backfill. MK-F also stated the amount of material around the poles was small when compared to the material under the tracks, is contiguous to the deposit under the tracks, and would not significantly contribute to general public exposure.

It is my opinion that DOE agrees with MK-F's assessment of the necessary recommendation of Supplemental Standards, the work performed to date, additional excavation to be performed, restoration plans, and the application of Supplemental Standards. I also believe CDPHE (Bud Franz) agrees, both personally and

professionally, but he said a formal presentation is required before he will make a final judgment. He was reminded that the State had already agreed to Supplemental Standards as described above. He had no additional comment. At any rate, a recommendation for the application of Supplemental Standards will be made for both properties in accordance with the guidance found in the VPMIM when the supporting field data is available.

Although not in the original agenda, DOE, MK-F, and MKES personnel also took a look at RF-479/493 areas for which MK-F will recommend the application of Supplemental Standards. It consists of the vertical and very steep slopes along the Hwy ROW and adjacent VP on the north side of US 6/24. MK-F has removed contaminated material from the upper, non-vertical portions face of the slope, whether on RF-493 or RF-479 (the ROW) to the extent deemed safe (slope stability). MK-F does not anticipate removing any material from the vertical portions of the face. And finally, MK-F will cause excavation on the lower portions to be performed to the extent that slope stability or road bed stability (as on the south side of the highway) is not endangered. Mr. Cherrington suggested that radiological data from the vertical portion was necessary before Supplemental Standards could be addressed. I reminded everyone that several precedents had been set on DU-544/545 and DU-059 under very similar circumstances, i.e., no data was collected from the near-vertical and vertical portions of those VPs because of the risk to RUST employees, it was intuitively obvious that the environmental damage clause of 40 CFR 192 was applicable, and that the risk to the general public from an unstable slope was much greater than any health risk from the contamination. One notes Jim Hams of CDPHE suggested a 'vacuum-cleaner' rig could be used to remove most of the tailings from the upper, non-vertical slope. The idea will have to be more fully considered, but MK-F's opinion is that since most of the tailings there are entwined with the native growth, removal of the tailings would cause the plant life to die, and, ergo, slope stability degenerates. So Supplemental Standards are applicable.

Action Items:

1) Excavation of the roadway and Site is to be completed and restoration performed. At that time, the radiological data supporting a recommendation for Supplemental Standards will be collected and transmitted to the APO for incorporation into a formal recommendation.

2) Grant Cherrington (MKES) will investigate and report on slope stability questions north of the roadway and Supplemental Standards options

cc: S. Arp, DOE/UMTRA S. Bunney, RFL D. Charlton
G. Cherrington, MKES R. Cooney R. Fencil, RFL
B. Franz, CDPHE J. Hams, CDPHE R. Hindman
J. Pape, DOE/UMTRA C. Spencer M. Thomson
R. Withee, RFL File - VP

APPENDIX C
LEGAL DESCRIPTION

LEGAL DESCRIPTION

The property which is the subject of this Completion Report, the address of which is South of the Old Rifle Site, Rifle, Colorado, is more particularly described in the Garfield County Recorder's Office, as follows:

No legal description is available for the railroad right-of-way.



MK-FERGUSON COMPANY

A MORRISON KNUDSEN COMPANY

UMTRA PROJECT OFFICE

P.O. BOX 9136

ALBUQUERQUE, NEW MEXICO 87119