

17"


11"

8.5"

8.5"

11"

17"

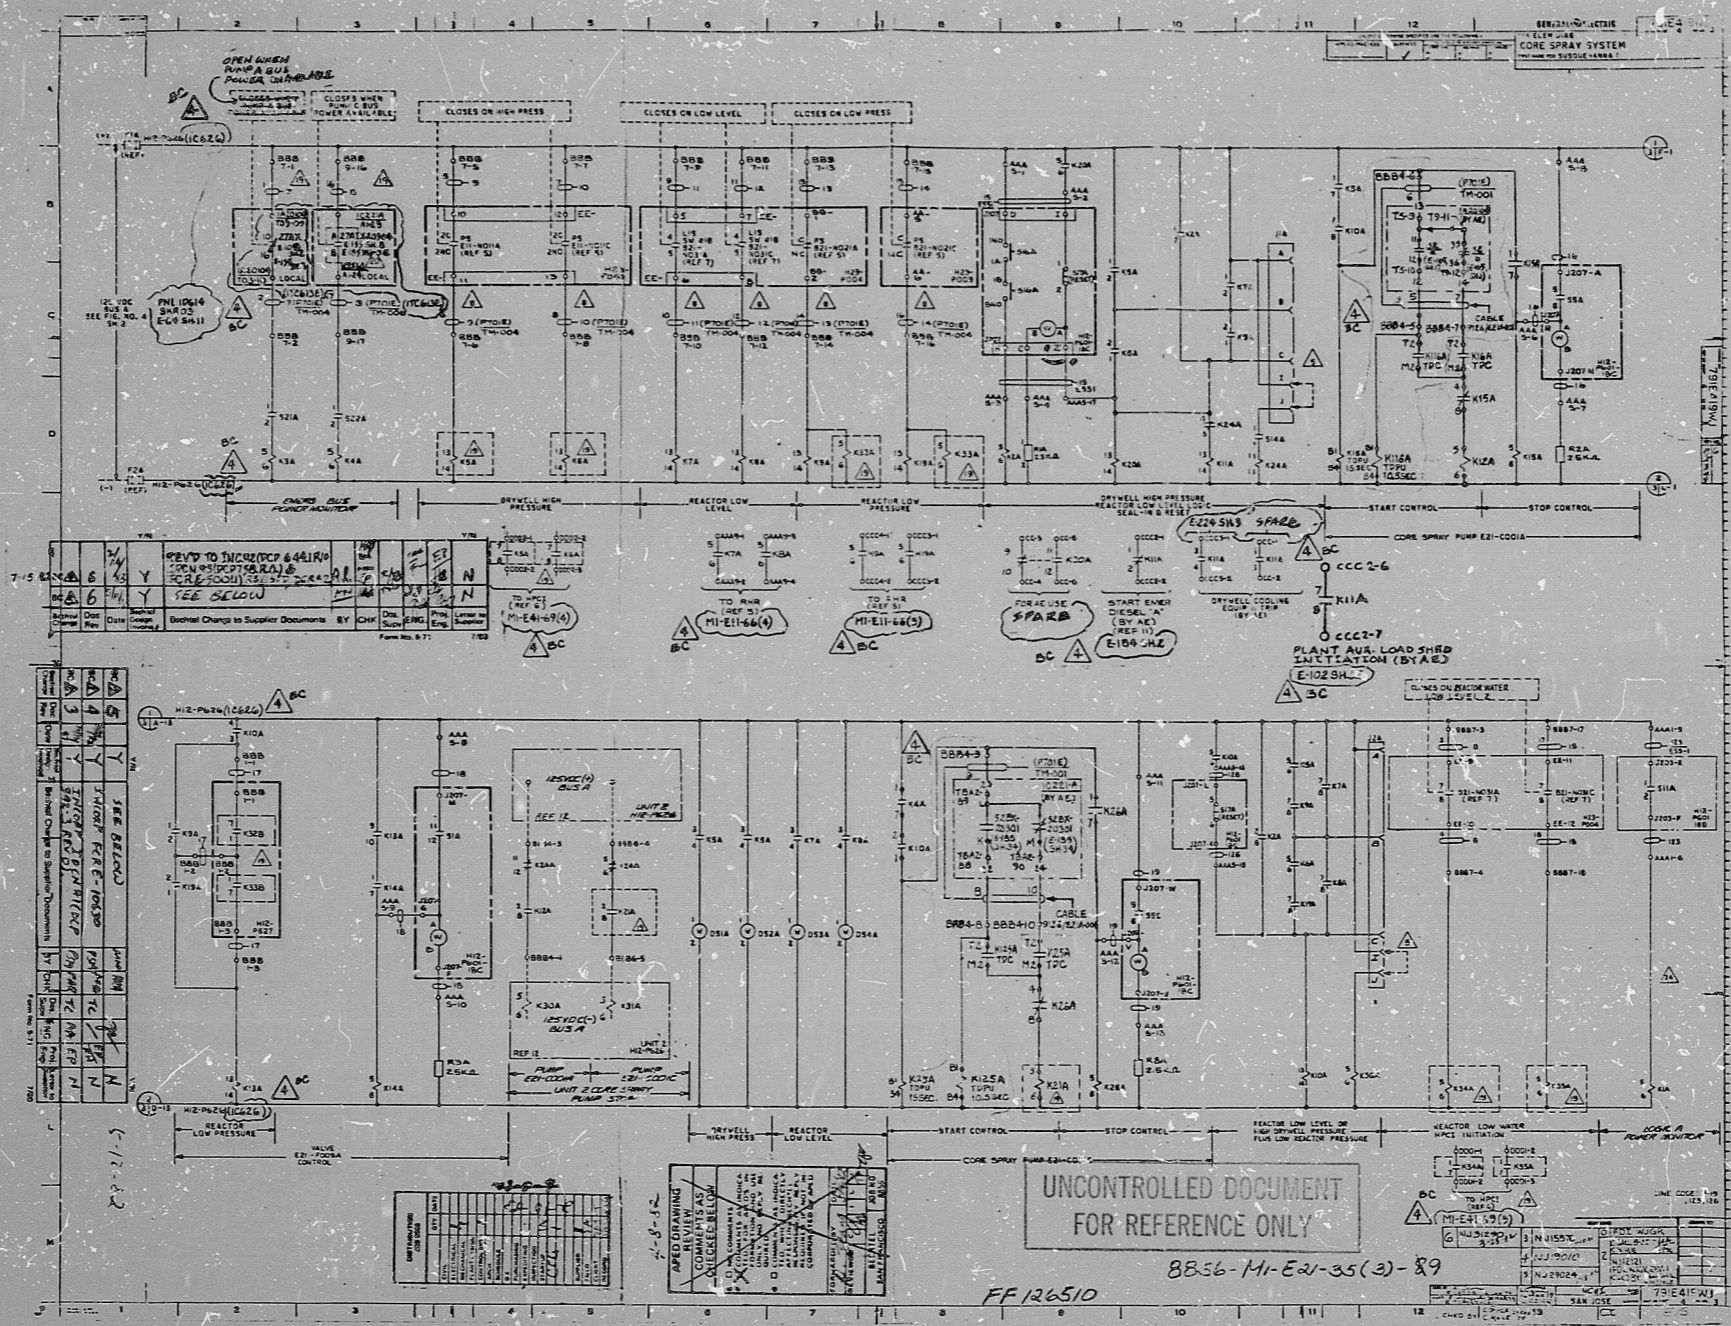

24X

PRC APERTURE CARD



**RIDS**

8305250036

