



This drawing and the design it covers is the property of the utilities which are participating in the SNUPPS Project. It is loaned to the borrower's express agreement that it will not be reproduced, copied, loaned, exhibited, or used except in the limited way and within the limits permitted by written consent given by the SNUPPS Utilities to the borrower.

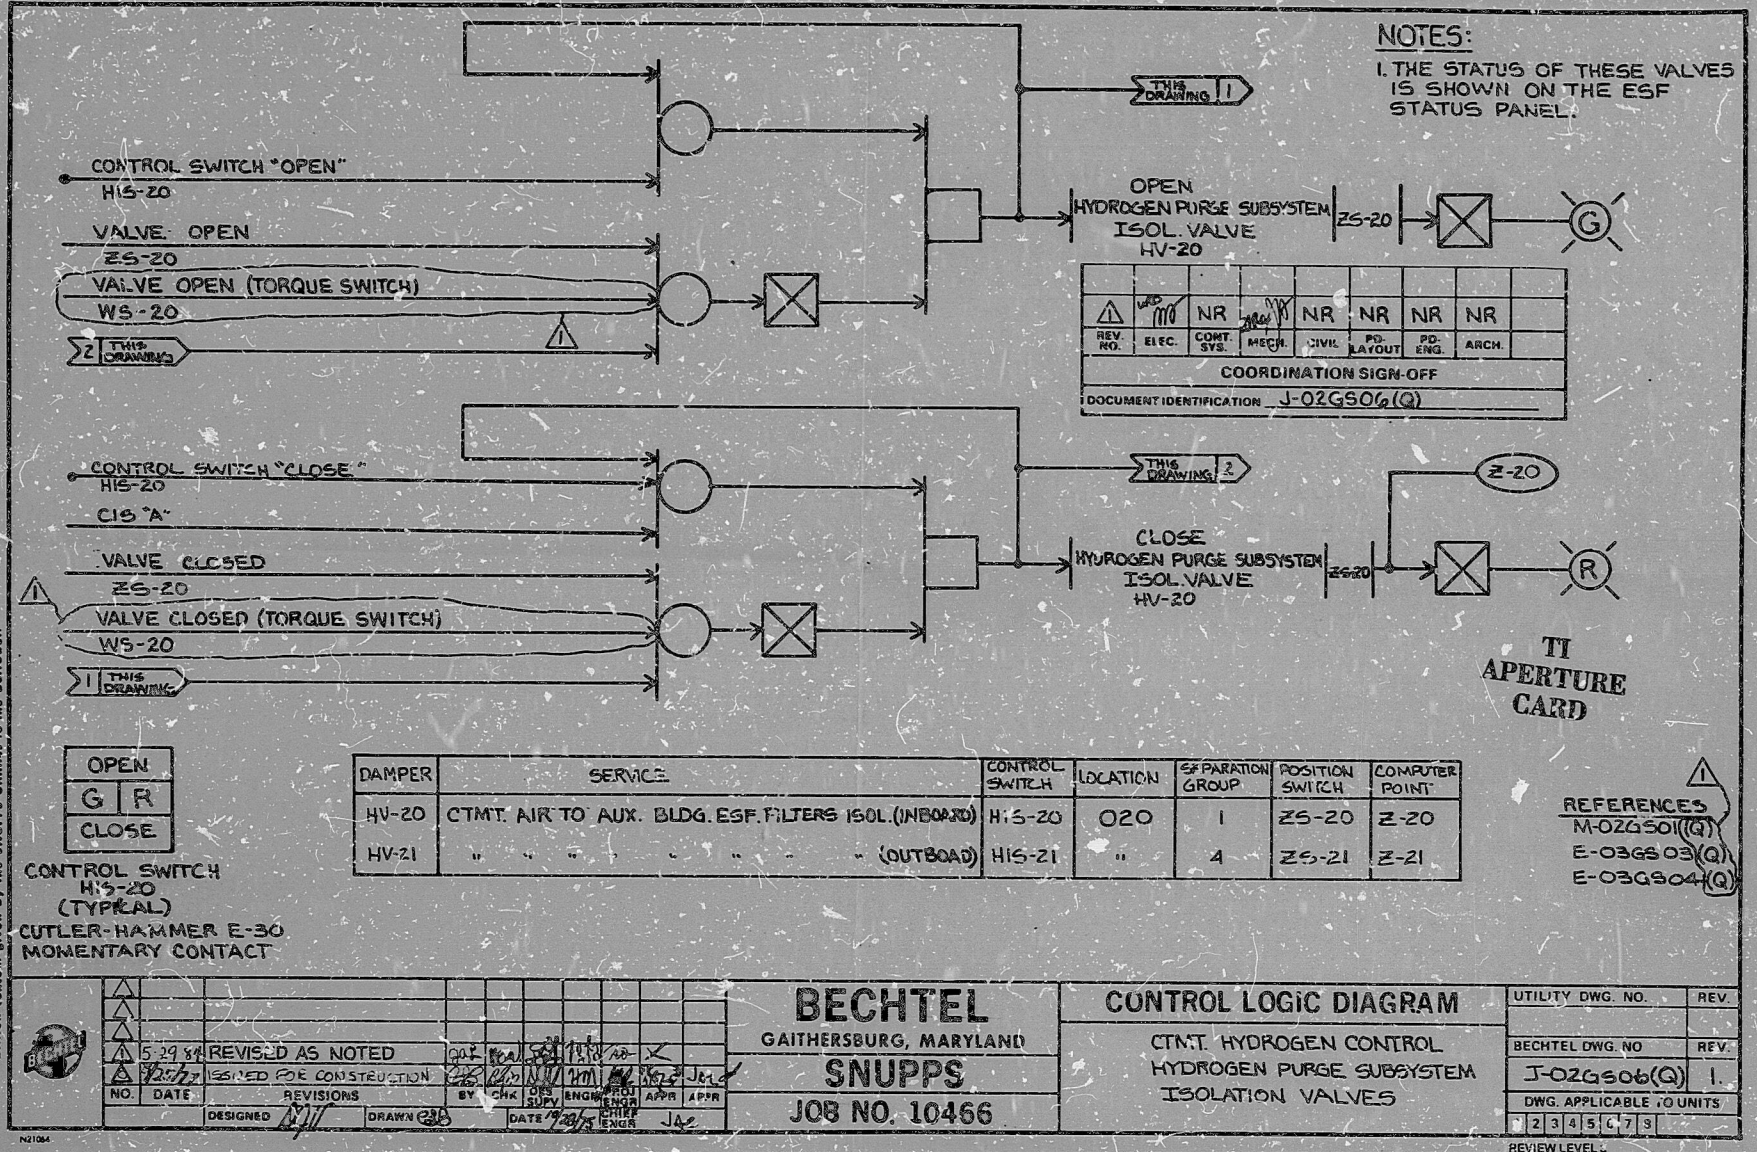

I certify that the image contained on this frame was made in the normal and regular course of business, on the date stated below and that it is an accurate reproduction of the document(s) submitted to Micrographics.
 DATE 6-7-84 OPERATOR *Doris Ponce*

 

PDR RIDS

8410030596

