


11

11

8.5"

11"

17"

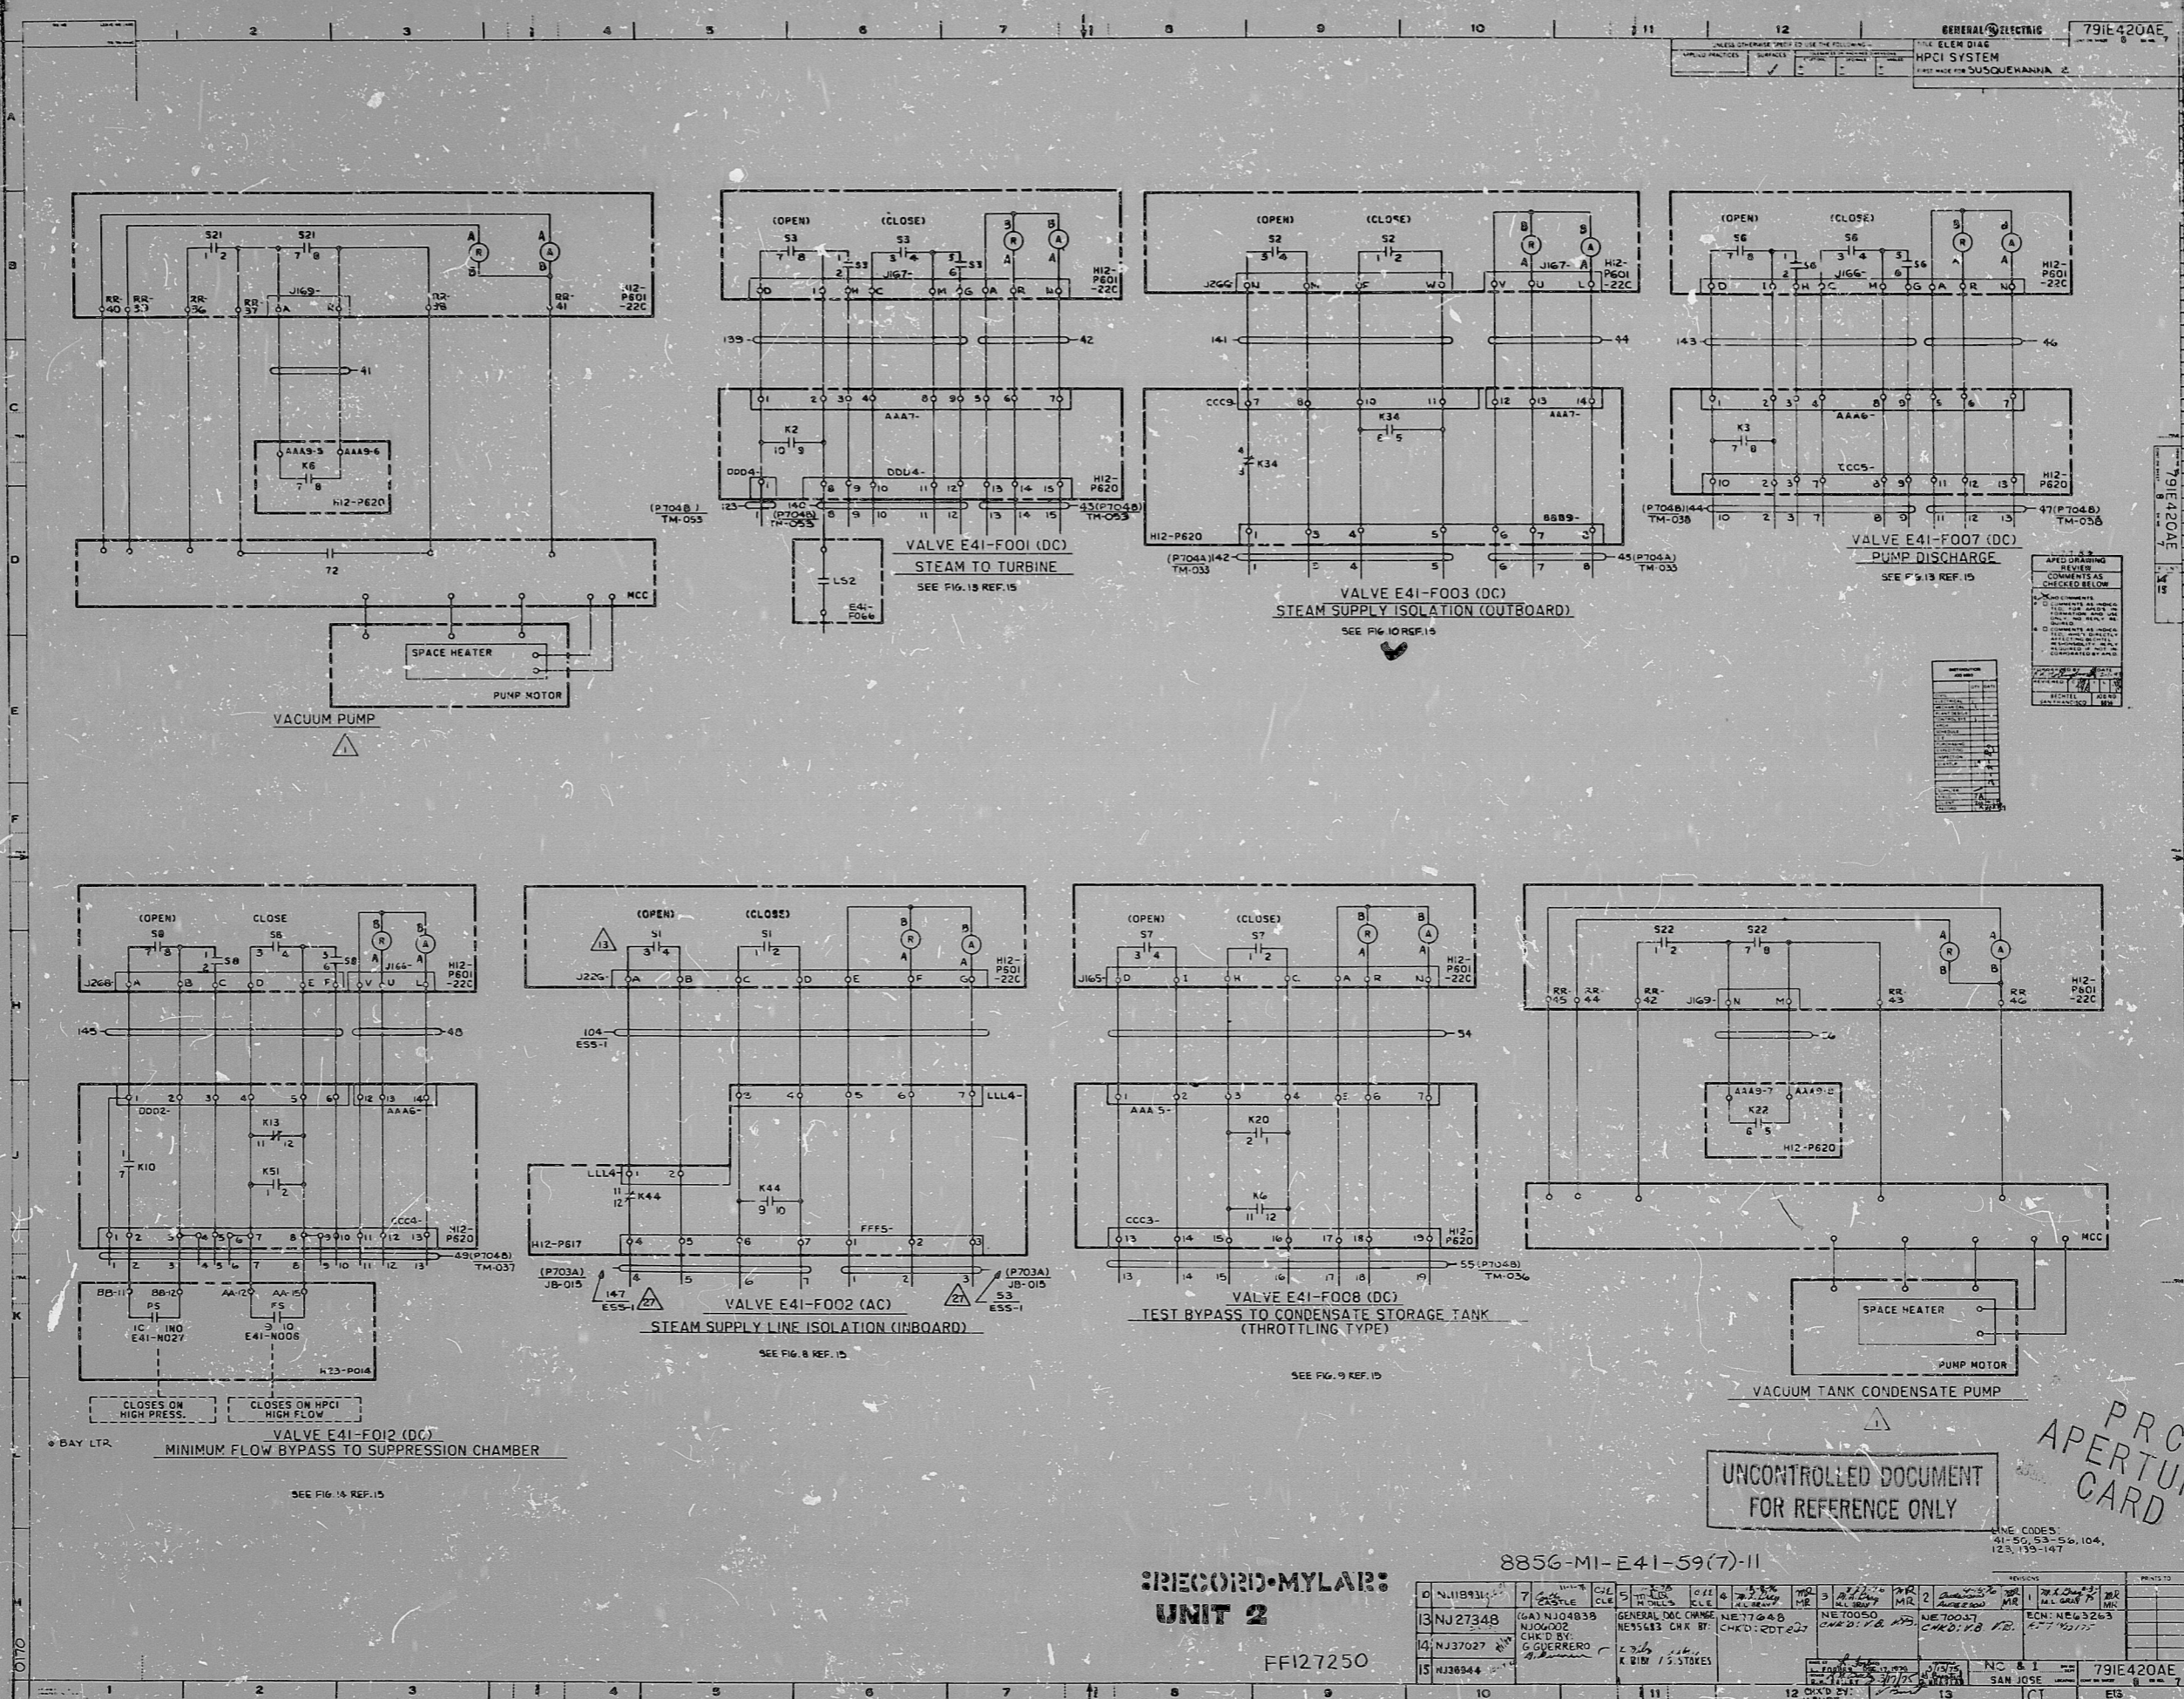

GENERAL ELECTRIC 791E420AE  
 FILE ELEM DIAG  
 HPCI SYSTEM  

APPROVED FOR  
 REVIEW  
 COMMENTS AS  
 CHECKED BELOW

NO.	DATE	BY	REVISION
1			
2			
UNCONTROLLED DOCUMENT  
 FOR REFERENCE ONLY

PRO APERTURE  
 CARD

RECORD-MYLAR  
 UNIT 2

8856-MI-E41-59(7)-II

FFI27250

NO.	DATE	BY	REVISION
0			
1			
30 X

DAHNY 1-19-83

RIDS

8305250050

