

22"

22"

17"

17"

11"

11"

9.5"

9.5"

8.5"

8.5"

11"


11"

17"

17"

22"

22"









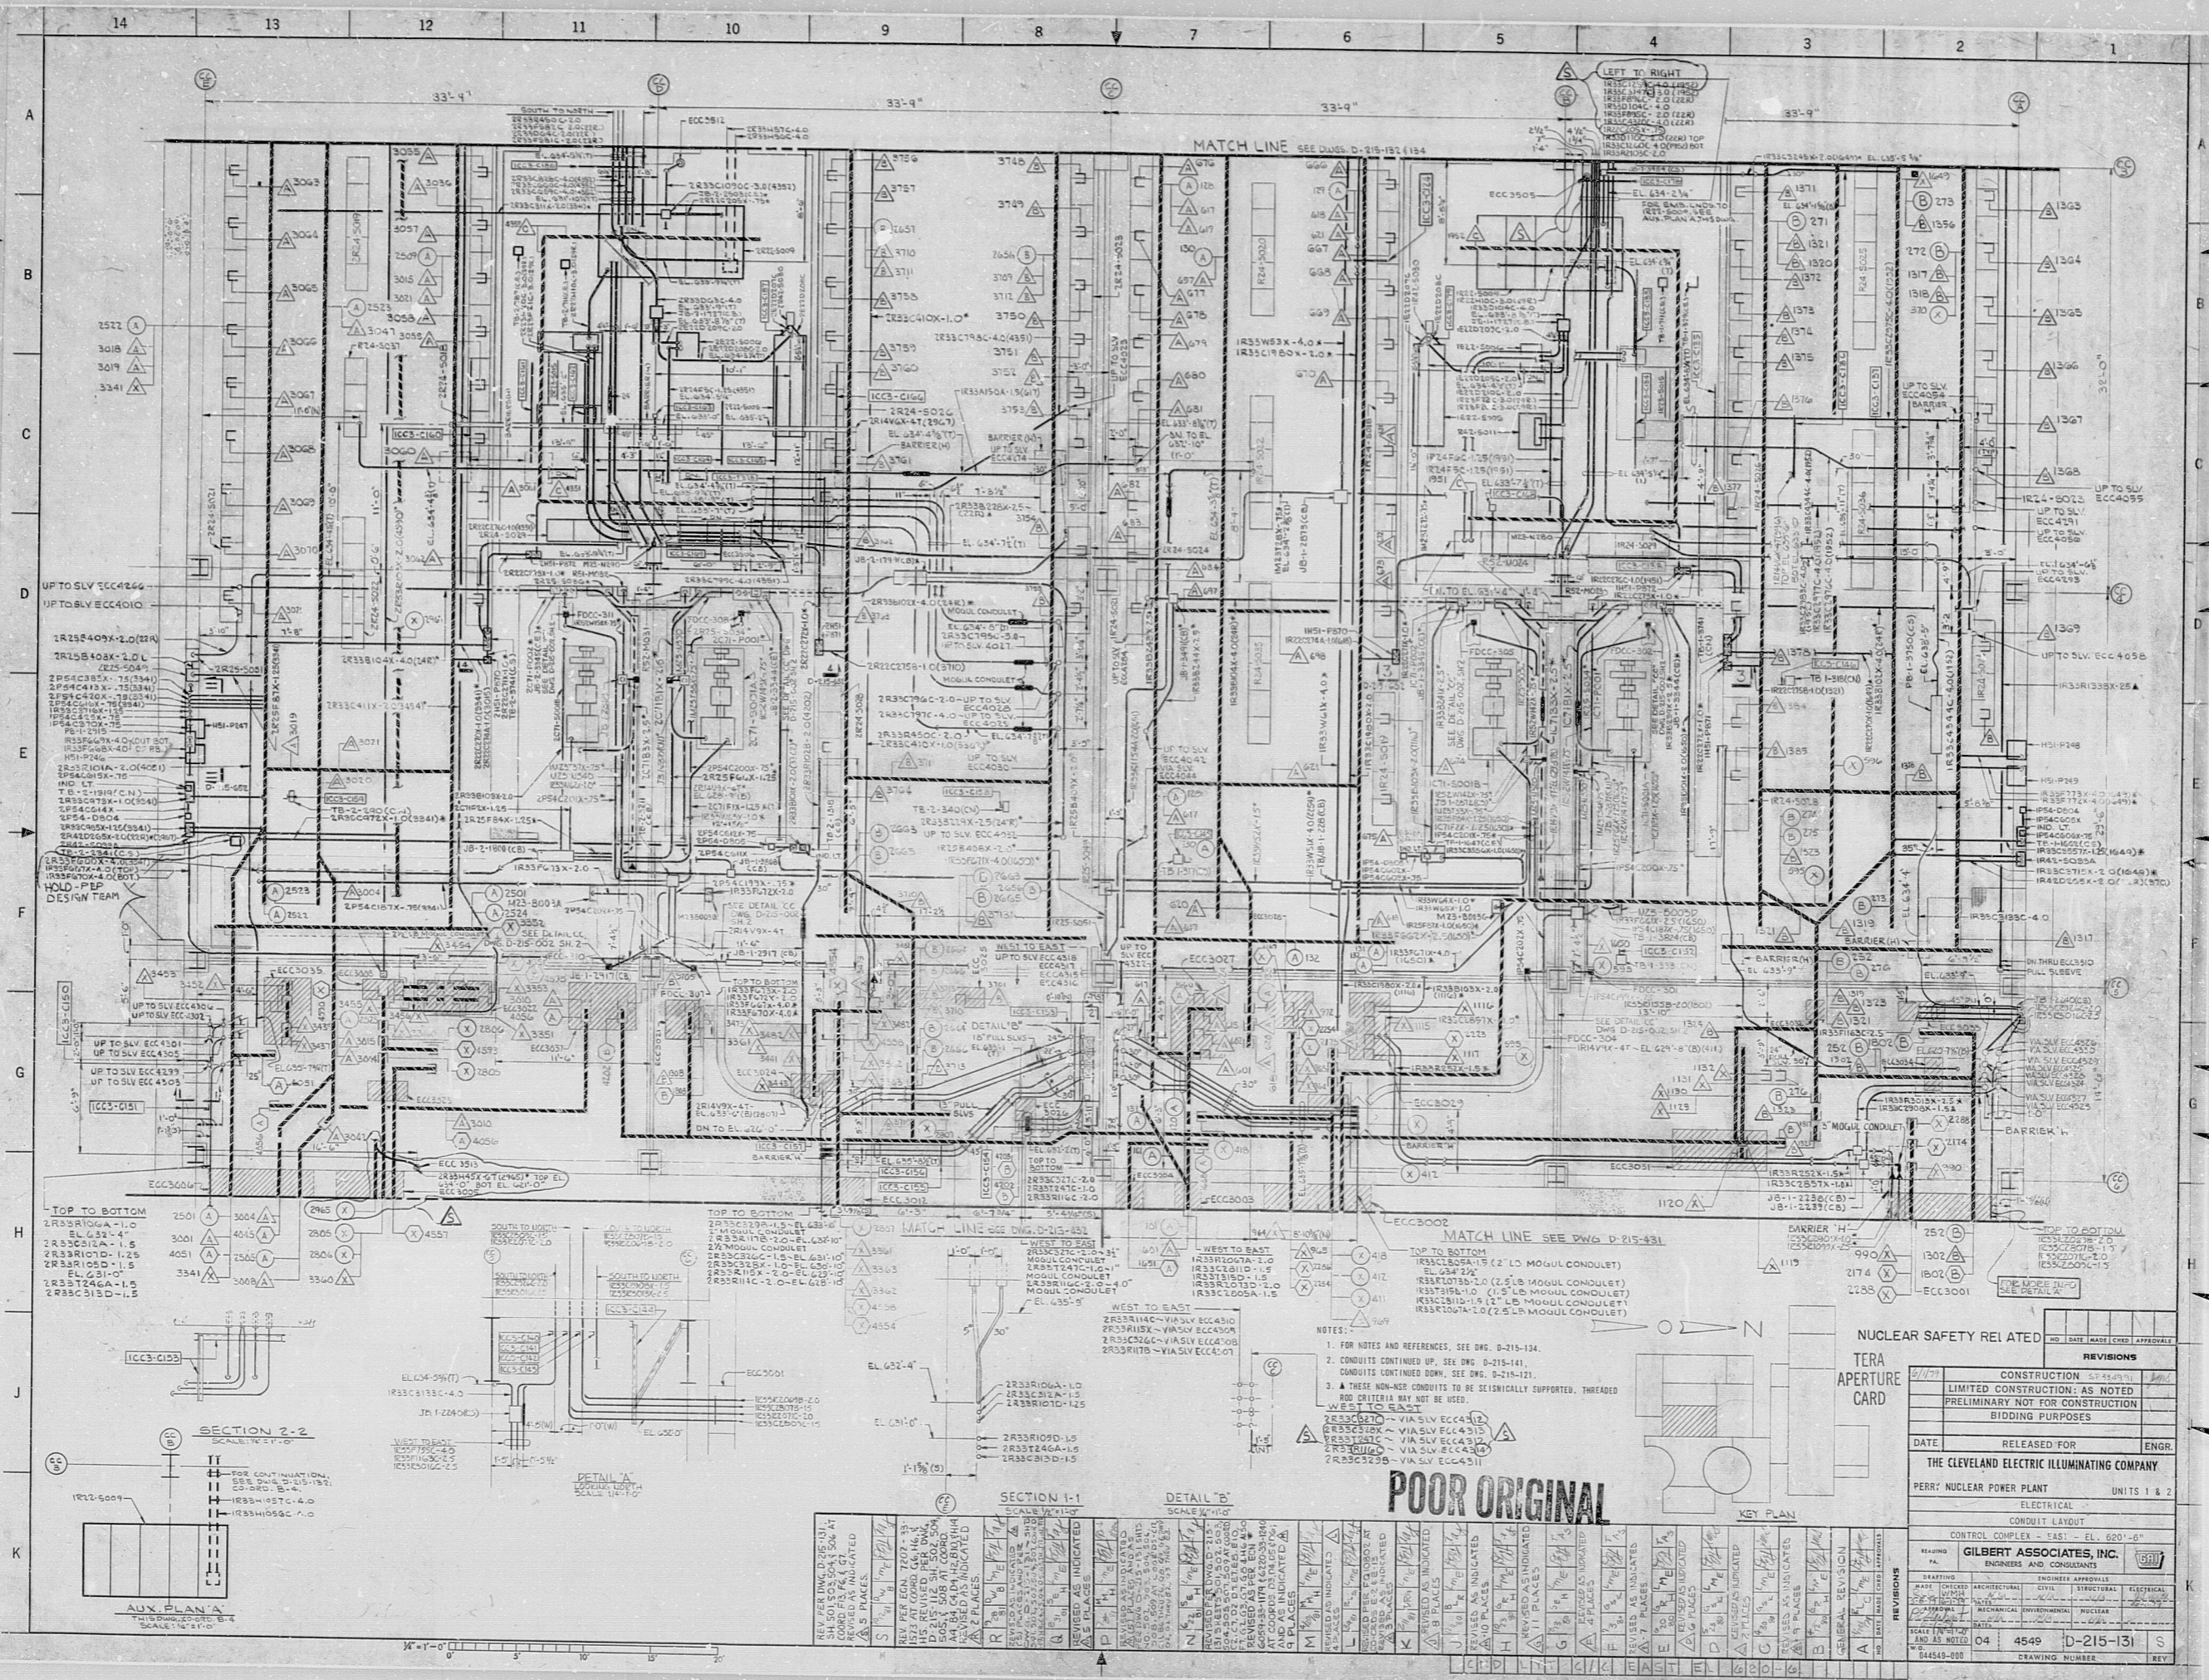


NOTES

- FOR NOTES AND REFERENCES, SEE DWG. D-215-134.
- CONDUITS CONTINUED UP, SEE DWG. D-215-141.
- CONDUITS CONTINUED DOWN, SEE DWG. D-215-121.
- THESE NON-NEE CONDUITS TO BE SEISMICALLY SUPPORTED, THREADED ROD CRITERIA MAY NOT BE USED.

NUCLEAR SAFETY RELATED		REVISIONS	
DATE	RELEASED FOR	ENGR.	
<p>THE CLEVELAND ELECTRIC ILLUMINATING COMPANY</p> <p>PERRY NUCLEAR POWER PLANT UNITS 1 & 2</p> <p>ELECTRICAL</p> <p>CONDUIT LAYOUT</p> <p>CONTROL COMPLEX - EAST - EL. 620'-0"</p> <p>GILBERT ASSOCIATES, INC.</p> <p>ENGINEERS AND CONSULTANTS</p>			
DATE	RELEASED FOR	ENGR.	
<p>CONSTRUCTION: AS NOTED</p> <p>PRELIMINARY NOT FOR CONSTRUCTION</p> <p>BIDDING PURPOSES</p>			
DATE	RELEASED FOR	ENGR.	
<p>SCALE: 1/8" = 1'-0"</p> <p>DRAWING NUMBER: 04 4549 D-215-131 S</p> <p>DRAWING NUMBER: 04549-200</p>			

POOR ORIGINAL

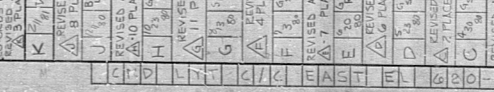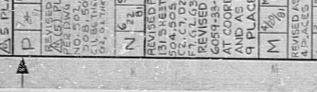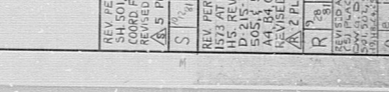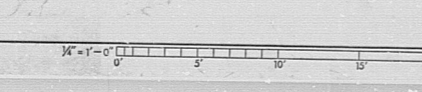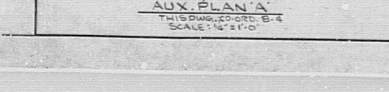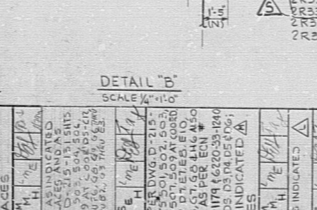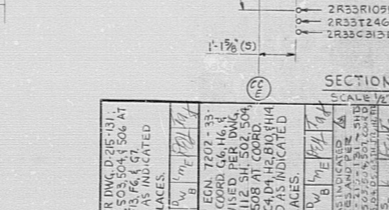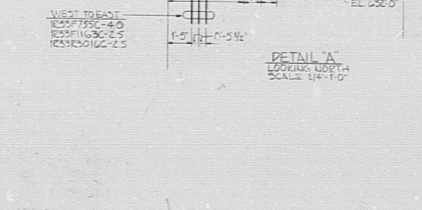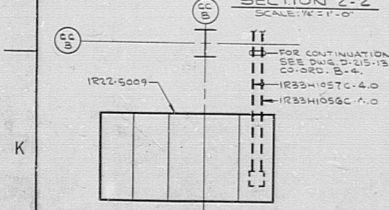

REV.	DATE	BY	DESCRIPTION
1			
2			
RIDS

8112030353

