

17"


11"

8.5"

8.5"

11"

17"

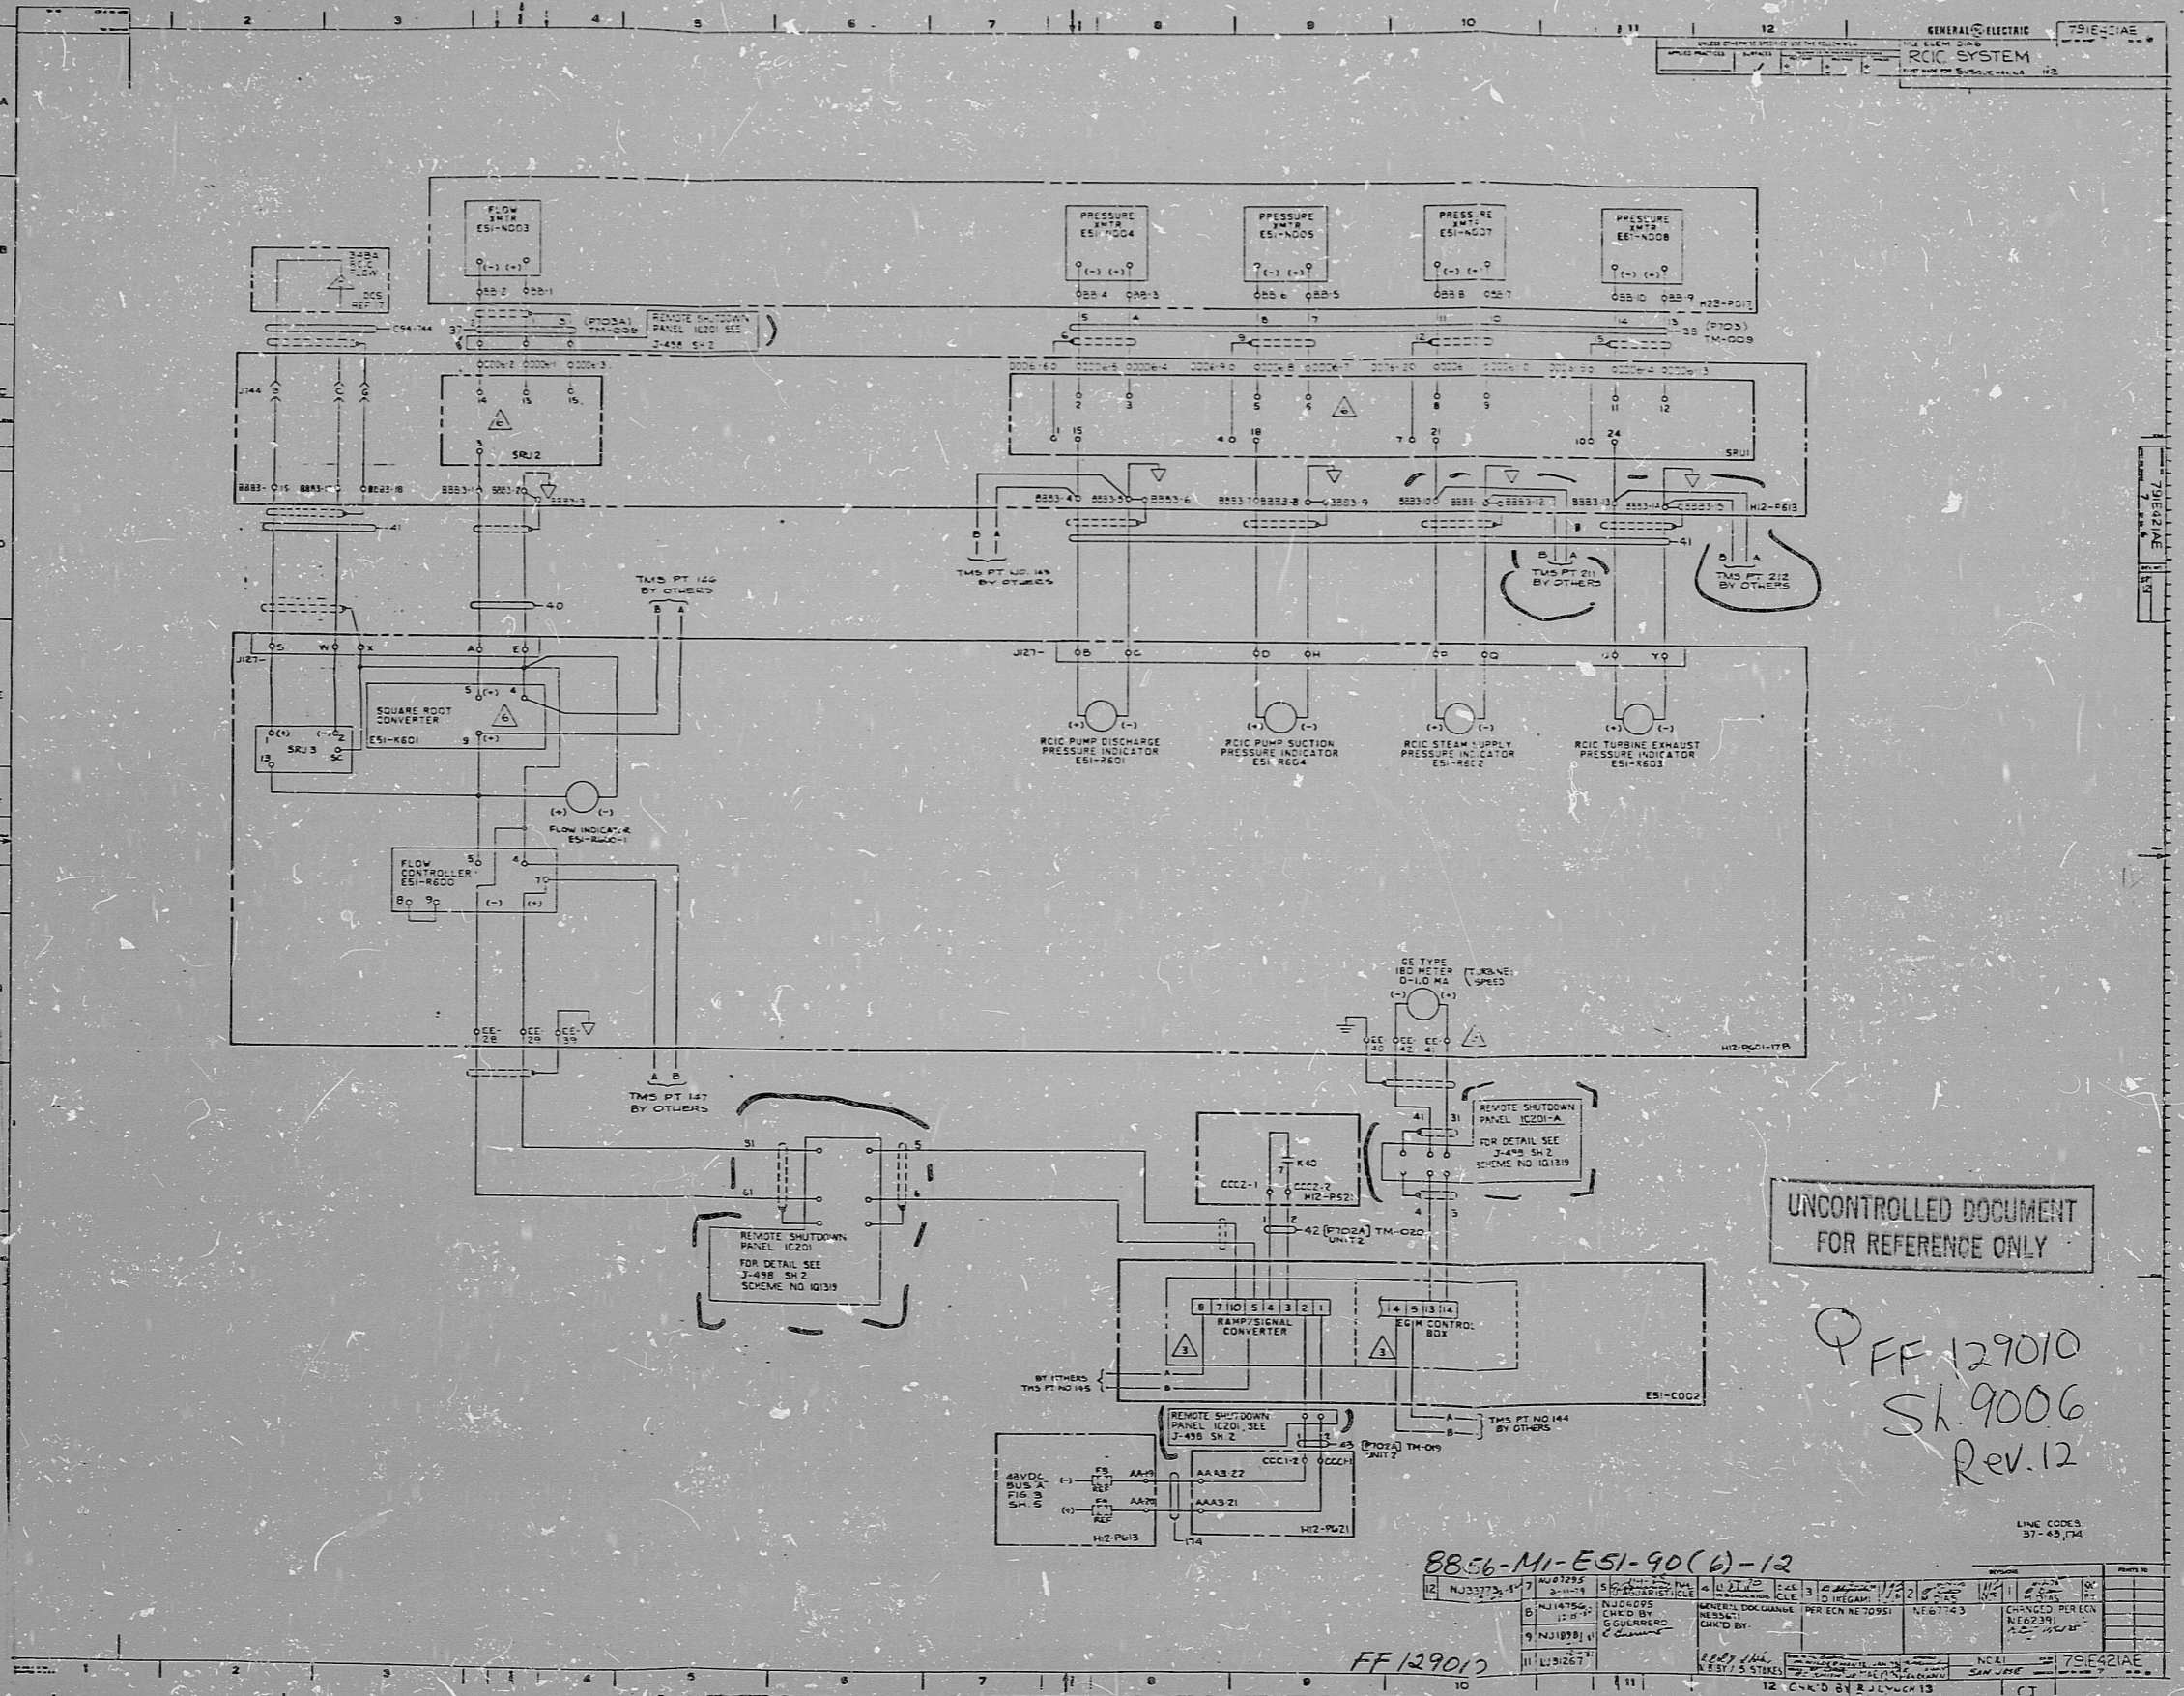

UNCONTROLLED DOCUMENT FOR REFERENCE ONLY

FF 129010
Sk. 9006
Rev. 12

88-56-MI-ESI-90(6)-12

FF 129010

APERTURE CARD

RIDS

8305250083

