
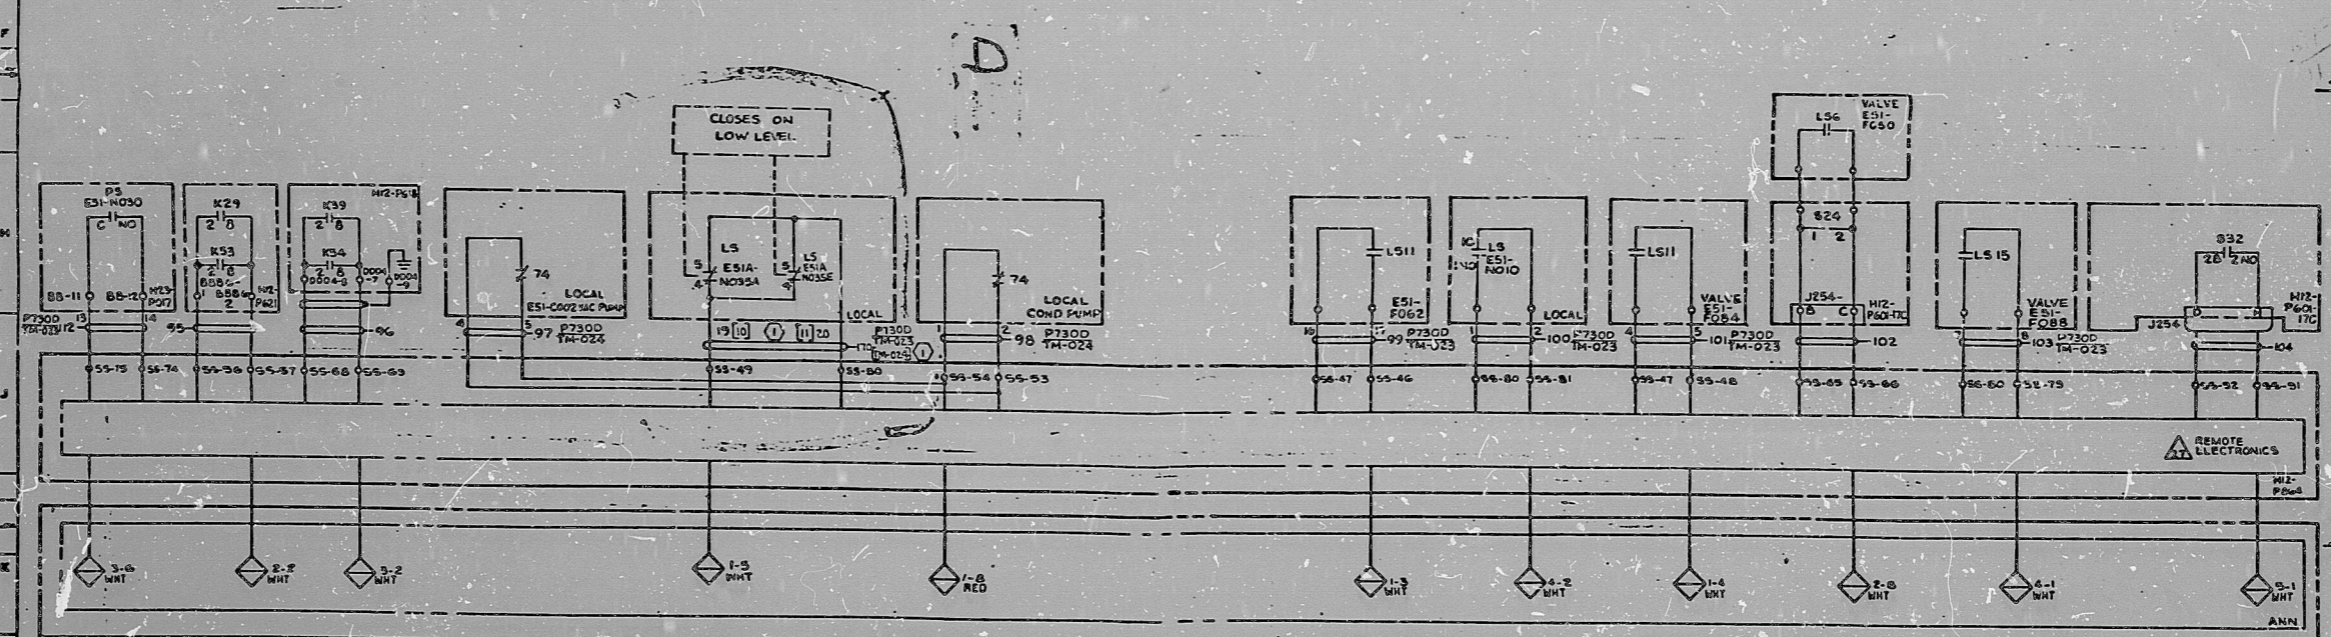


UNCONTROLLED DOCUMENT
 FOR REFERENCE ONLY

ALL PCC SUPPLIED CABLES ON THIS SM ARE
 FOR INFORMATION UNLESS OTHERWISE SPECIFIED.
 INFORMATION IN BRACKETS USE FOR UNIT 2.

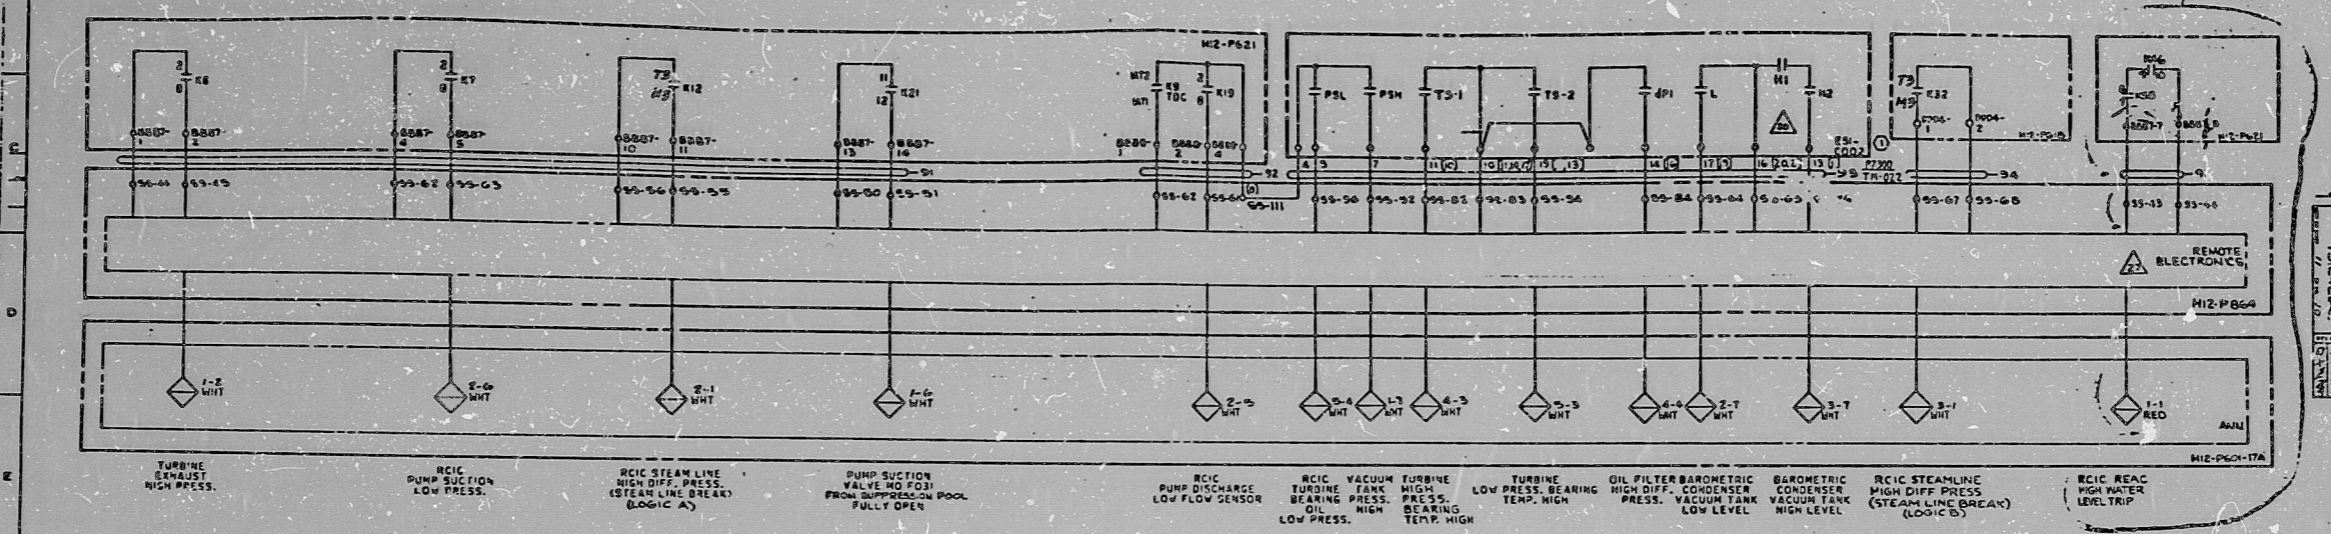

UNCONTROLLED DOCUMENT FOR REFERENCE ONLY

RECEIVED
 JAN 4 1982
 NUCLEAR REC. SYS.

FF129010
 Sh. 9010
 Rev. 11

8856-MI-ES1-90(10)-11

1	2	
---	---	---	---	---	---	---	---	---	----	----	-----

15X

I CERTIFY THAT THE IMAGE CONTAINED ON THIS FRAME WAS MADE IN THE NORMAL AND REGULAR COURSE OF BUSINESS, ON THE DATE STATED BELOW, AND THAT IT IS AN ACCURATE REPRODUCTION OF THE DOCUMENT SUBMITTED TO MICROGRAPHICS.

PRO
 APERTURE
 CARD

RIDS

8305250090

