


46 18

48

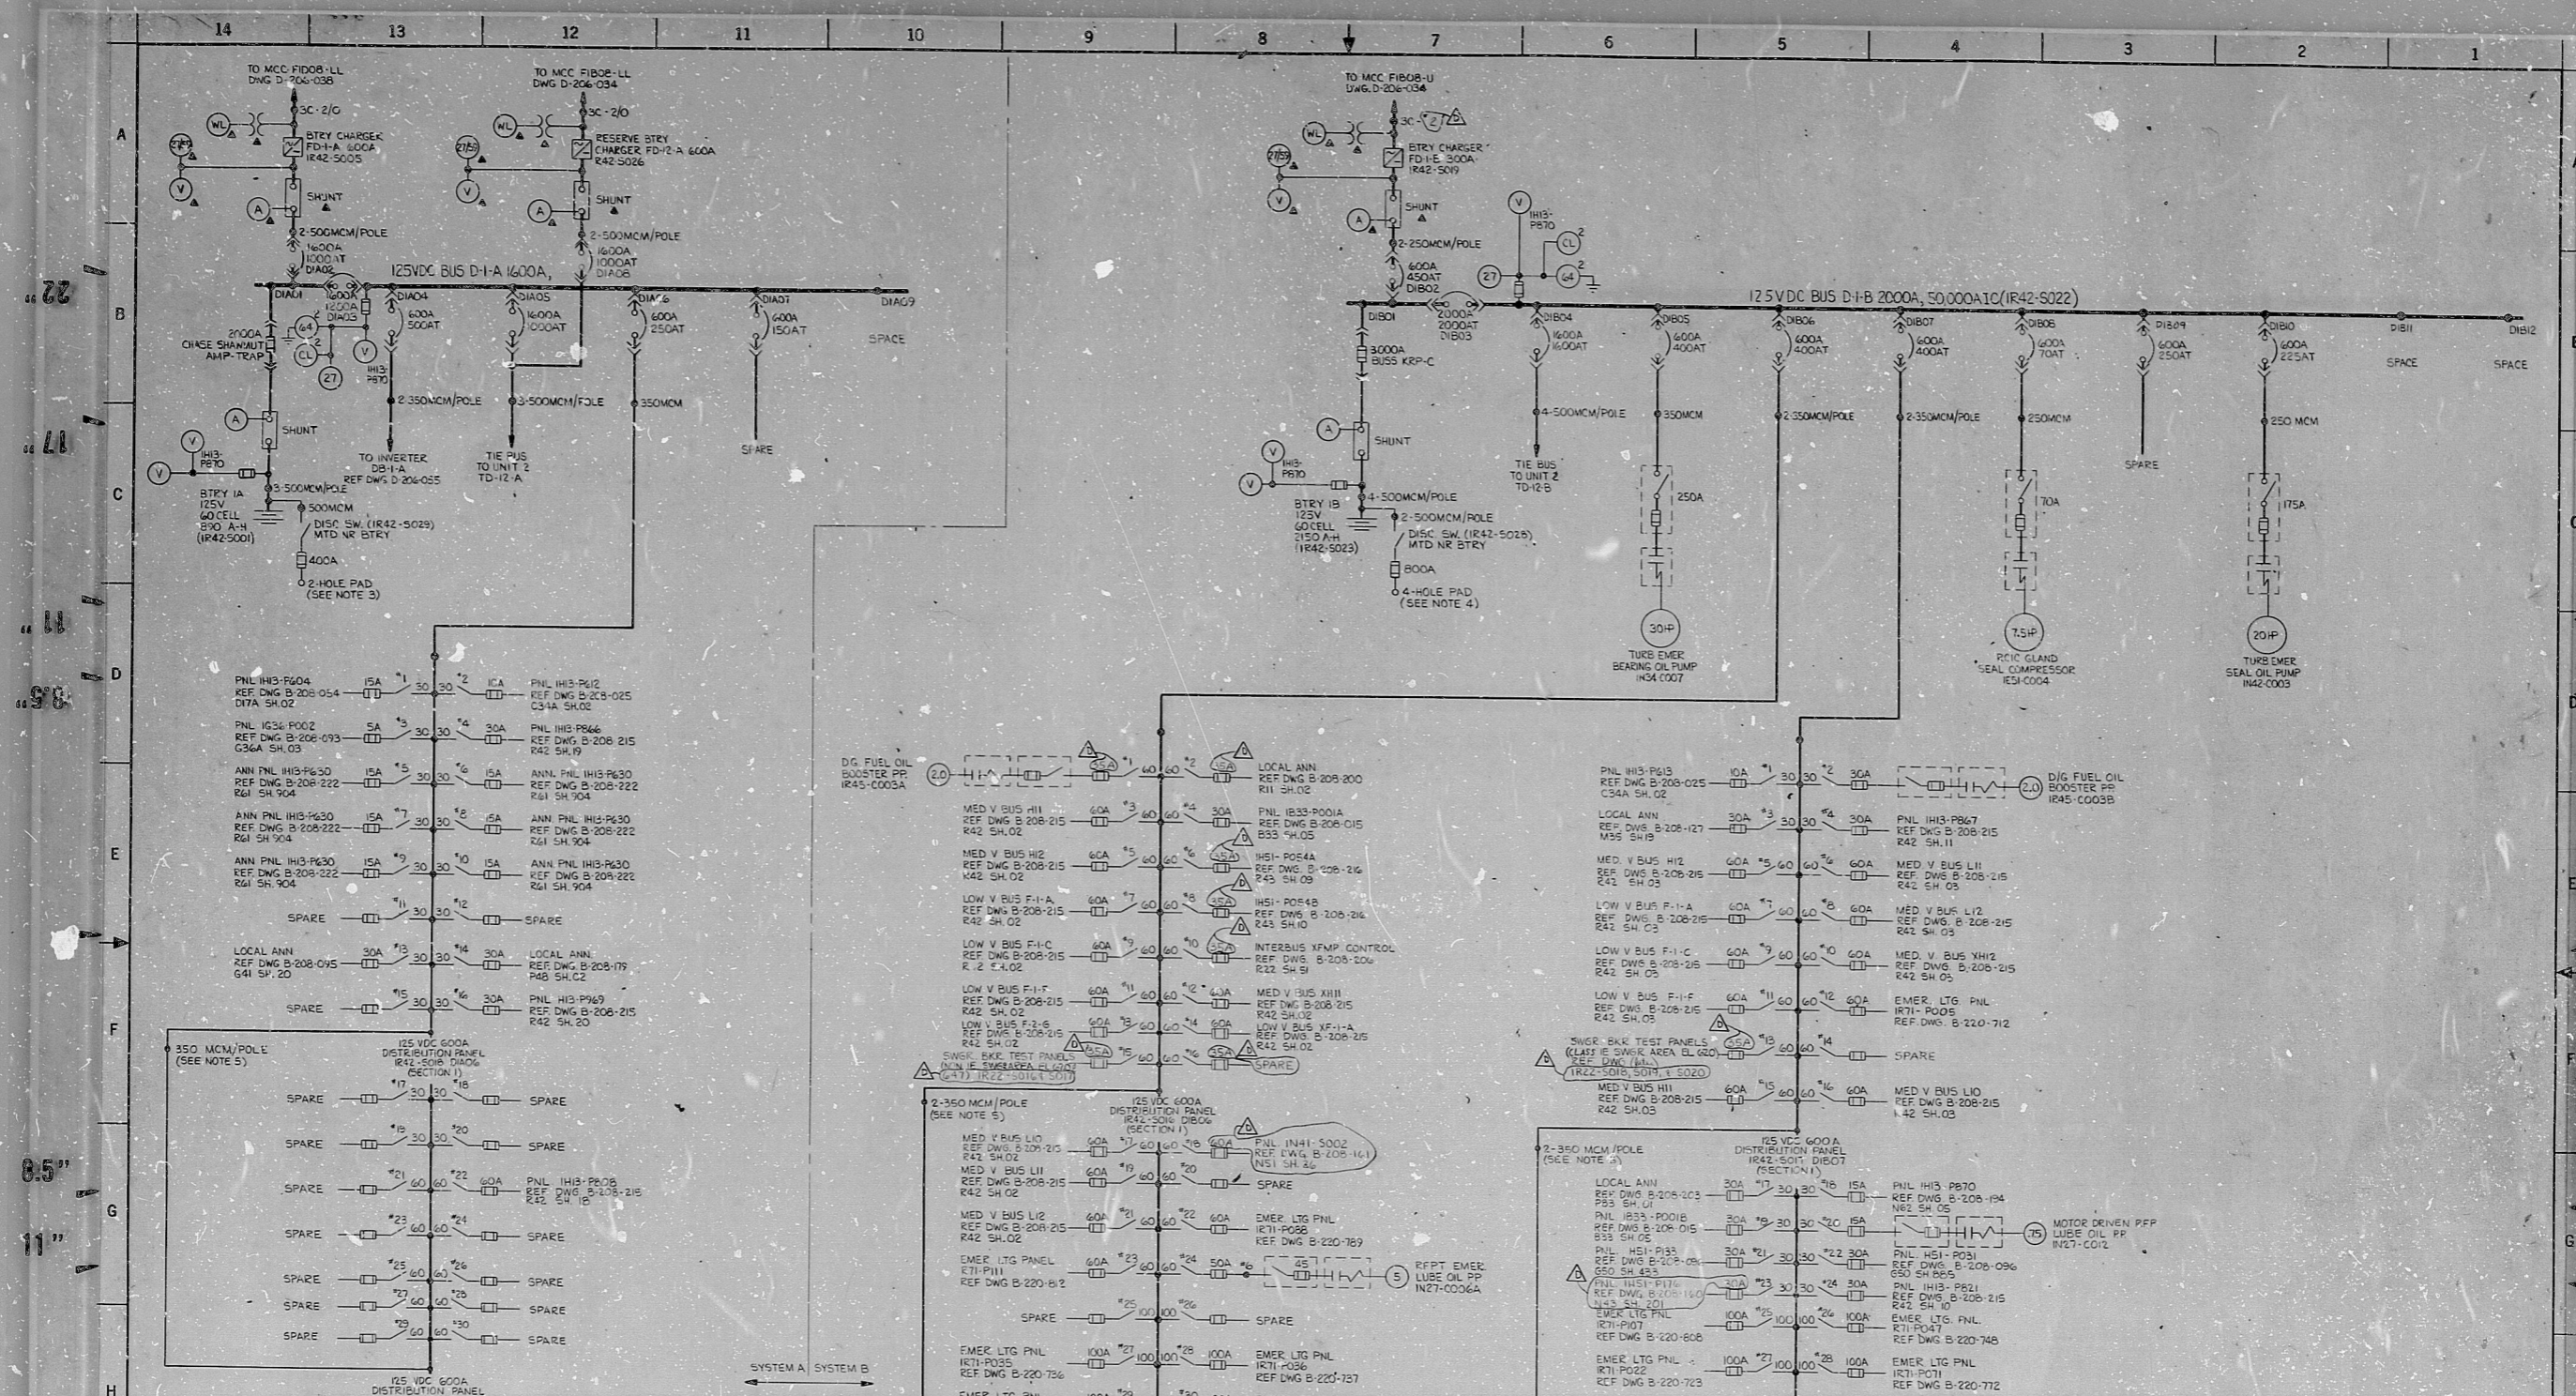

48 22

50













- NOTES:
1. FOR LEGEND AND ABBREVIATIONS, SEE DWG D-206-012.
  2. DEVICES LOCATED IN SWGR UNLESS OTHERWISE INDICATED.
  3. REQUIRED FOR CONNECTION OF 500MCM CABLE FROM PORTABLE BATTERY CAPACITY TEST RIG.
  4. REQUIRED FOR CONNECTION OF 2-500MCM CABLES FROM PORTABLE BATTERY CAPACITY TEST RIG.
  5. SECTIONS 1 AND 2 OF EACH DISTRIBUTION PANEL ARE INSTALLED SIDE BY SIDE. FEED-THRU CABLE CONNECTS THE BOTTOM OF THE MAIN BUS IN EACH SECTION.

REV. A CLIENT: D. R. GREEN 8-9-78  
 APPROVAL: [Signature] DATE: [Blank]


REVISIONS	
NO.	DATE
1	8-9-78



TERA APERTURE CARD


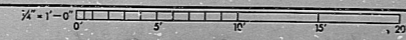

48 22

50



R:DS

8112030588

