

SCHEMATIC (C) UNKCO-3

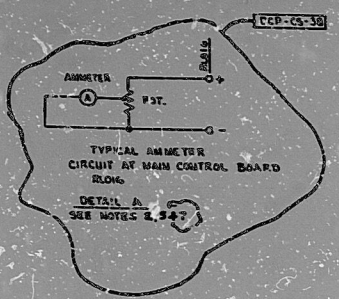


TABLE D: COMPUTER POINTS

DESCRIPTION	DIST. SHED UNDER VOLT	HP. SYSTEM GROUND	BATTERY MONITOR	SW3-D BUS UNDER VOLT	CHGR. DC OVER VOLT	CHGR. DC UNDER VOLT	CHGR. AC UNDER VOLT	CHGR. FAILURE	CHGR. AC BKR. OPEN	CHGR. DC BKR. OPEN

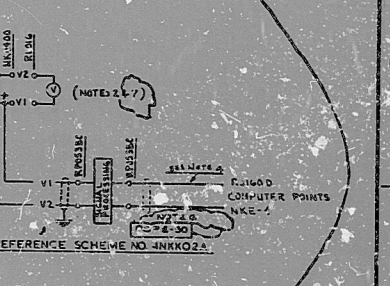
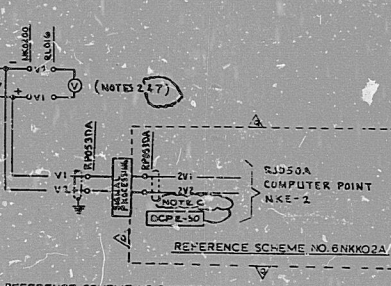
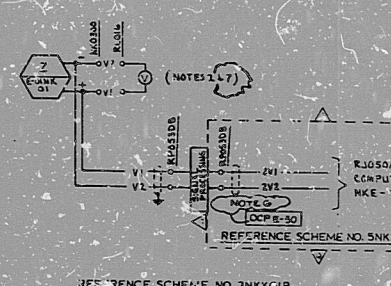
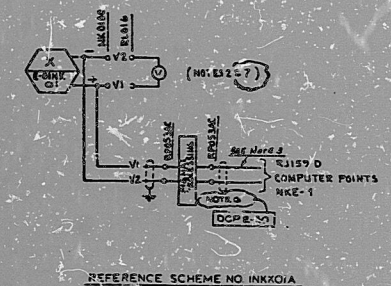
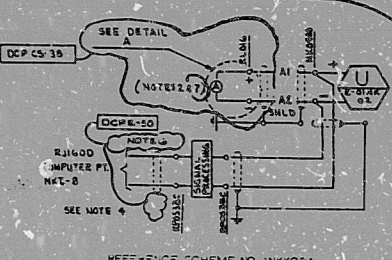
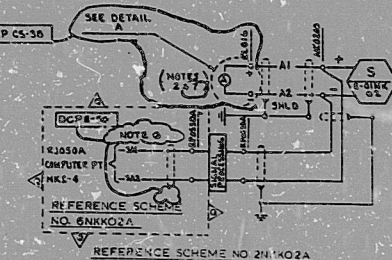
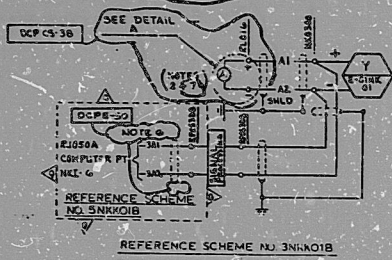
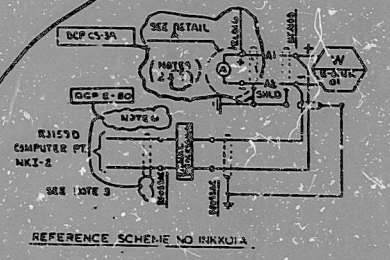


TABLE E

EQUIPMENT NUMBER	INSTRUMENT NUMBER		
	VOLTMETER	AMMETER	POT.
BATTERY - NK01	N/A	NK11-2	NK11-3
DC BUS - NK01	NK11-1	N/A	N/A
BATTERY - NK02	N/A	NK11-6	NK11-7
DC BUS - NK02	NK11-2	N/A	N/A
BATTERY - NK03	N/A	NK11-6	NK11-7
DC BUS - NK03	NK11-3	N/A	N/A
BATTERY - NK04	N/A	NK11-6	NK11-7
DC BUS - NK04	NK11-4	N/A	N/A
BATTERY CHARGER - NK21	N/A	NK11-1	NK11-5
BATTERY CHARGER - NK22	N/A	NK11-2	NK11-5
BATTERY CHARGER - NK23	N/A	NK11-3	NK11-5
BATTERY CHARGER - NK24	N/A	NK11-7	NK11-7

NOTICE: ALTERATION OF THIS DOCUMENT BY ANY PERSON OTHER THAN A LICENSED PROFESSIONAL ENGINEER OR A PERSON ACTING UNDER HIS OR HER DIRECT SUPERVISION IS PROHIBITED.

TI  
A P E R T U R E  
C A R D

DCP-E-10

- NOTES:
- FOR CABLE SHELVES SEE DRAWING E-03NK11(Q) E-03NK02.
  - FOR MANUFACTURER TYPE AND STYLE NUMBER OF ALL METERS ON MAIN CONTROL BOARD (R104) SEE DWG. 10966-J-04016.
  - FOR SCHEMATIC WIRE NO. SEE DWG. No. E-03R007.
  - FOR SCHEMATIC WIRE NO. SEE DWG. No. E-03R008.
  - ADJUST POT. TO COMPENSATE FOR THE VOLTAGE DROP IN THE INSTRUMENT CABLES.
  - SHIELDS GROUNDED AT COMPUTER.
  - FOR INSTRUMENT NO. SEE TABLE E.

3	4	5	6	7	8	9	10	11	12	13	14	15	16	17	18	19	20	21	22	23	24	25	26	27	28	29	30

BECHTEL  
CORPORATION  
SAN FRANCISCO, CALIF.

BECHTEL  
CORPORATION  
SAN FRANCISCO, CALIF.

REVISIONS

NO.	DATE	BY	REVISION
1			ISSUED

JOB NO. 10466 E-03NK11(Q) 5


10411E

8410040184

PDR RIDS

