



- REFERENCE DWG.**
- 10466-E-01PA01
 - 10466-E-03PA01
 - 10466-E-03PA02
 - 10466-E-03PA03
 - 10466-E-03PA04
 - 10466-E-03BB27

- NOTES:**
1. THE AREA ENCLOSED BY THE DOTTED LINE IS THE SAME AS THE AREA ENCLOSED BY THE DOTTED LINE ASSOCIATED WITH BREAKER 252PA0107 EXCEPT FOR TEST SWITCH UNITS WHICH ARE THE LAST 3 DIGITS OF SWITCH NUMBER AND ARE NUMBERED IN SEQUENCE FOR EACH CUBICLE.
 2. THE AREA ENCLOSED BY THE DOTTED LINE IS THE SAME AS THE AREA ENCLOSED BY THE DOTTED LINE ASSOCIATED WITH CT CUBICLE PA03 EXCEPT FOR RESPECTIVE DEVICE NUMBERS. (401-1, 227-2/31 & 281-2/31, 107-10A, 107-22/3)
 3. FOR DETAILS SEE DWG. 10466-E-03BB27
 4. JUMPERS AT RELAYS 250-231/F (250-231/F FOR NGIC ONLY) JUMPERS TO BE INSTALLED INSIDE RELAY CASE.

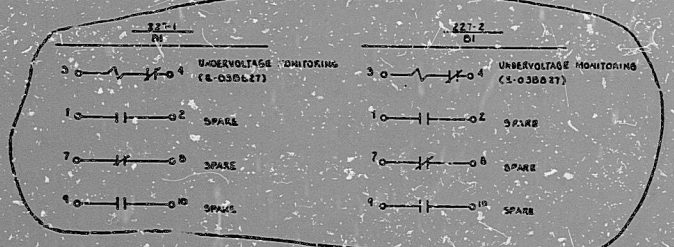

TI APERTURE CARD




T. J. VAN DER BRUG

COORDINATION SUMMARY


BECHTEL


SNUPPS

HIGHER MEDIUM VOLTAGE SYSTEM

13.8 KV THREE LINE

METER AND RELAY DIAGRAM

DATE: 10/19/66

SCALE: 1/8" = 1'-0"

10466 E-03PA02(O) 12

SHEET 6 OF 6

37502

8410040214

PDR RIDS

