

50-F-9588

SIZE E

17

17

11

11

8.5

8.5

8.5


8.5

11

11

17

17

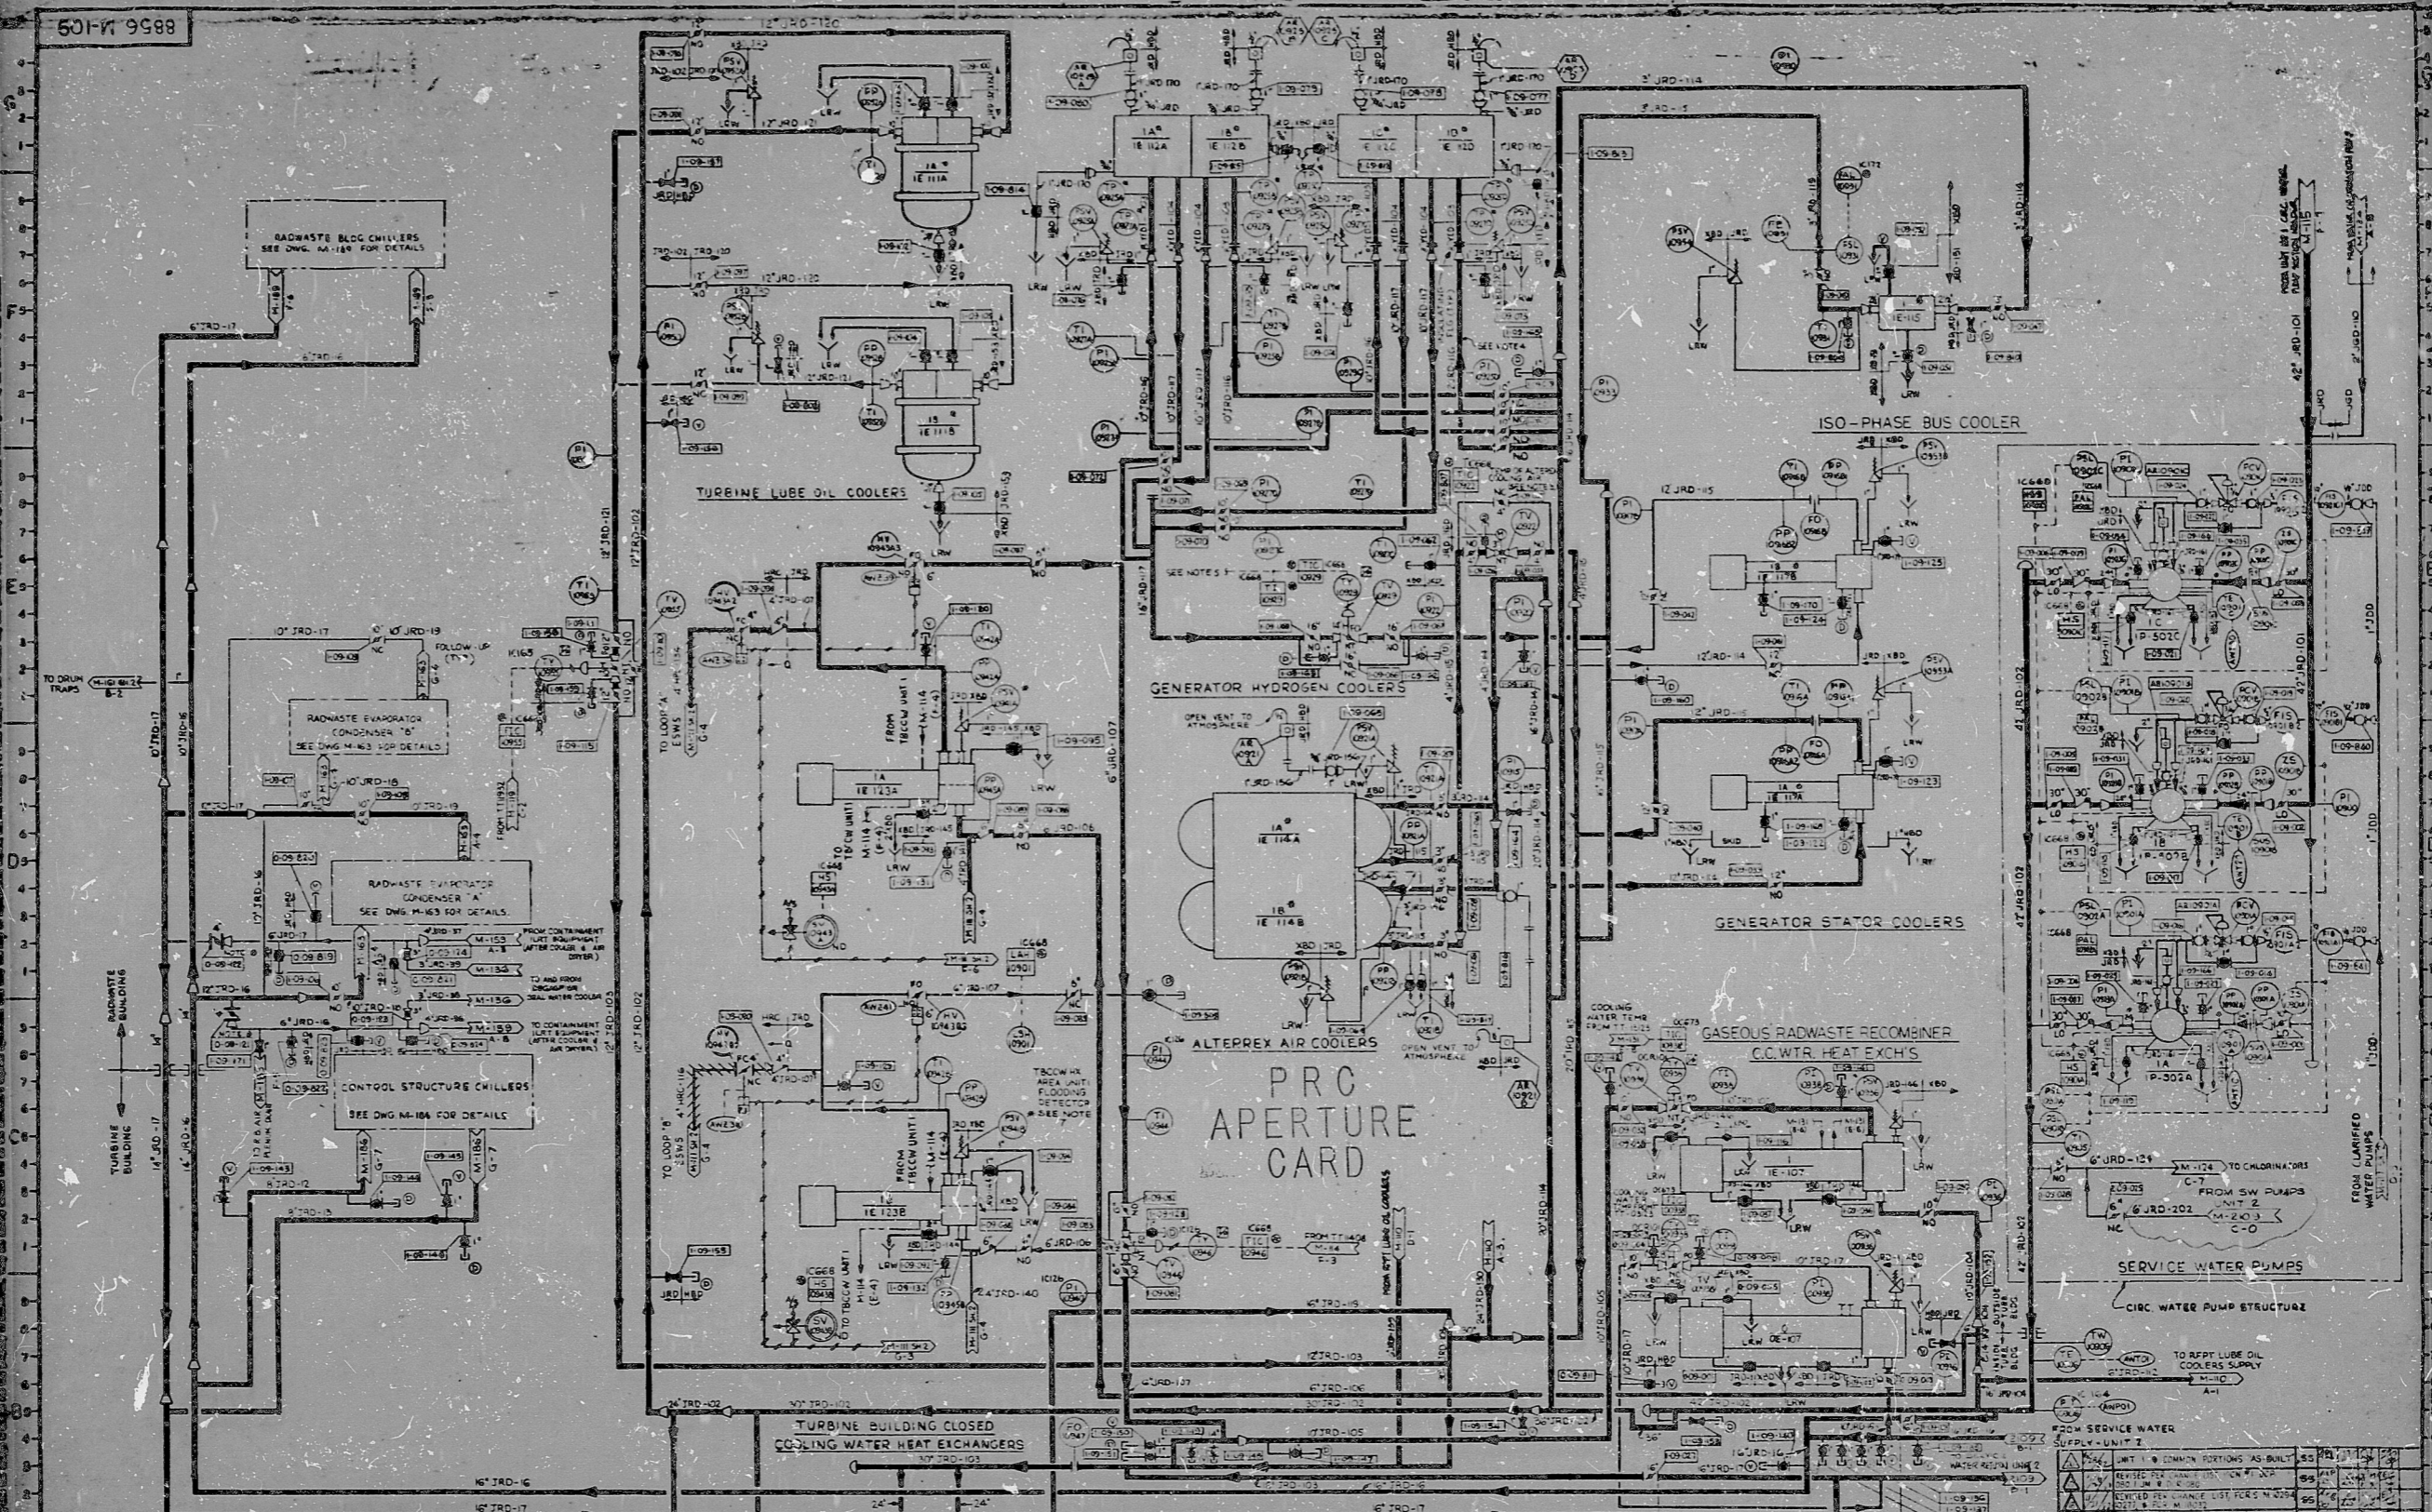


UNCONTROLLED DOCUMENT FOR REFERENCE ONLY

REFERENCE DWGS.

BECHTEL NO.	PL. NO.
M-110	E-106215
M-111	E-106216
M-112	E-106217
M-200	E-106305

NOTES:

- REFER TO M-110 FOR OTHER HEAT EXCHANGERS IN THE SW SYSTEM.
- STATOR COOLING WATER PUMPS (AUGA 4 PUMPS) AND ASSOCIATED CONTROLS SHOWN ON SHEET P-221-100 AND ASS. SHEET P-221-101 (4 X 11.5).
- TEMP. TEST AND DRAIN LINES ARE 1/2" OD 304L SS 3/4" DIA. MAN DRAIN LINES ARE 1/2" OD 304L SS.
- TEMP. TEST AND DRAIN LINES ARE 1/2" OD 304L SS 3/4" DIA. MAN DRAIN LINES ARE 1/2" OD 304L SS.
- MISCELLANEOUS VALVES USED ON THIS SHEET ARE NUMBERED 1-01 TO 171, 203, 204, 212 TO 217. DELETED VALVES 1-01 TO 171, 203, 204, 212, 213, 214,1000.
- ALL FLOODING DETECTOR LEVEL SWITCHES ARE SEISMICALLY QUALIFIED.
- B7HS REDUCER SHALL BE LOCATED AS CLOSE AS POSSIBLE TO THE VALVE.

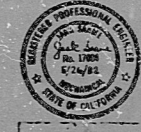

PENNSYLVANIA POWER & LIGHT COMPANY

P&ID UNIT 1
 SERVICE WATER

REV. NO.	DATE	BY
8856	M-109	22

Q 000 E-106214

RIDS

8305250/91

