


UNCONTROLLED DOCUMENT
FOR REFERENCE ONLY

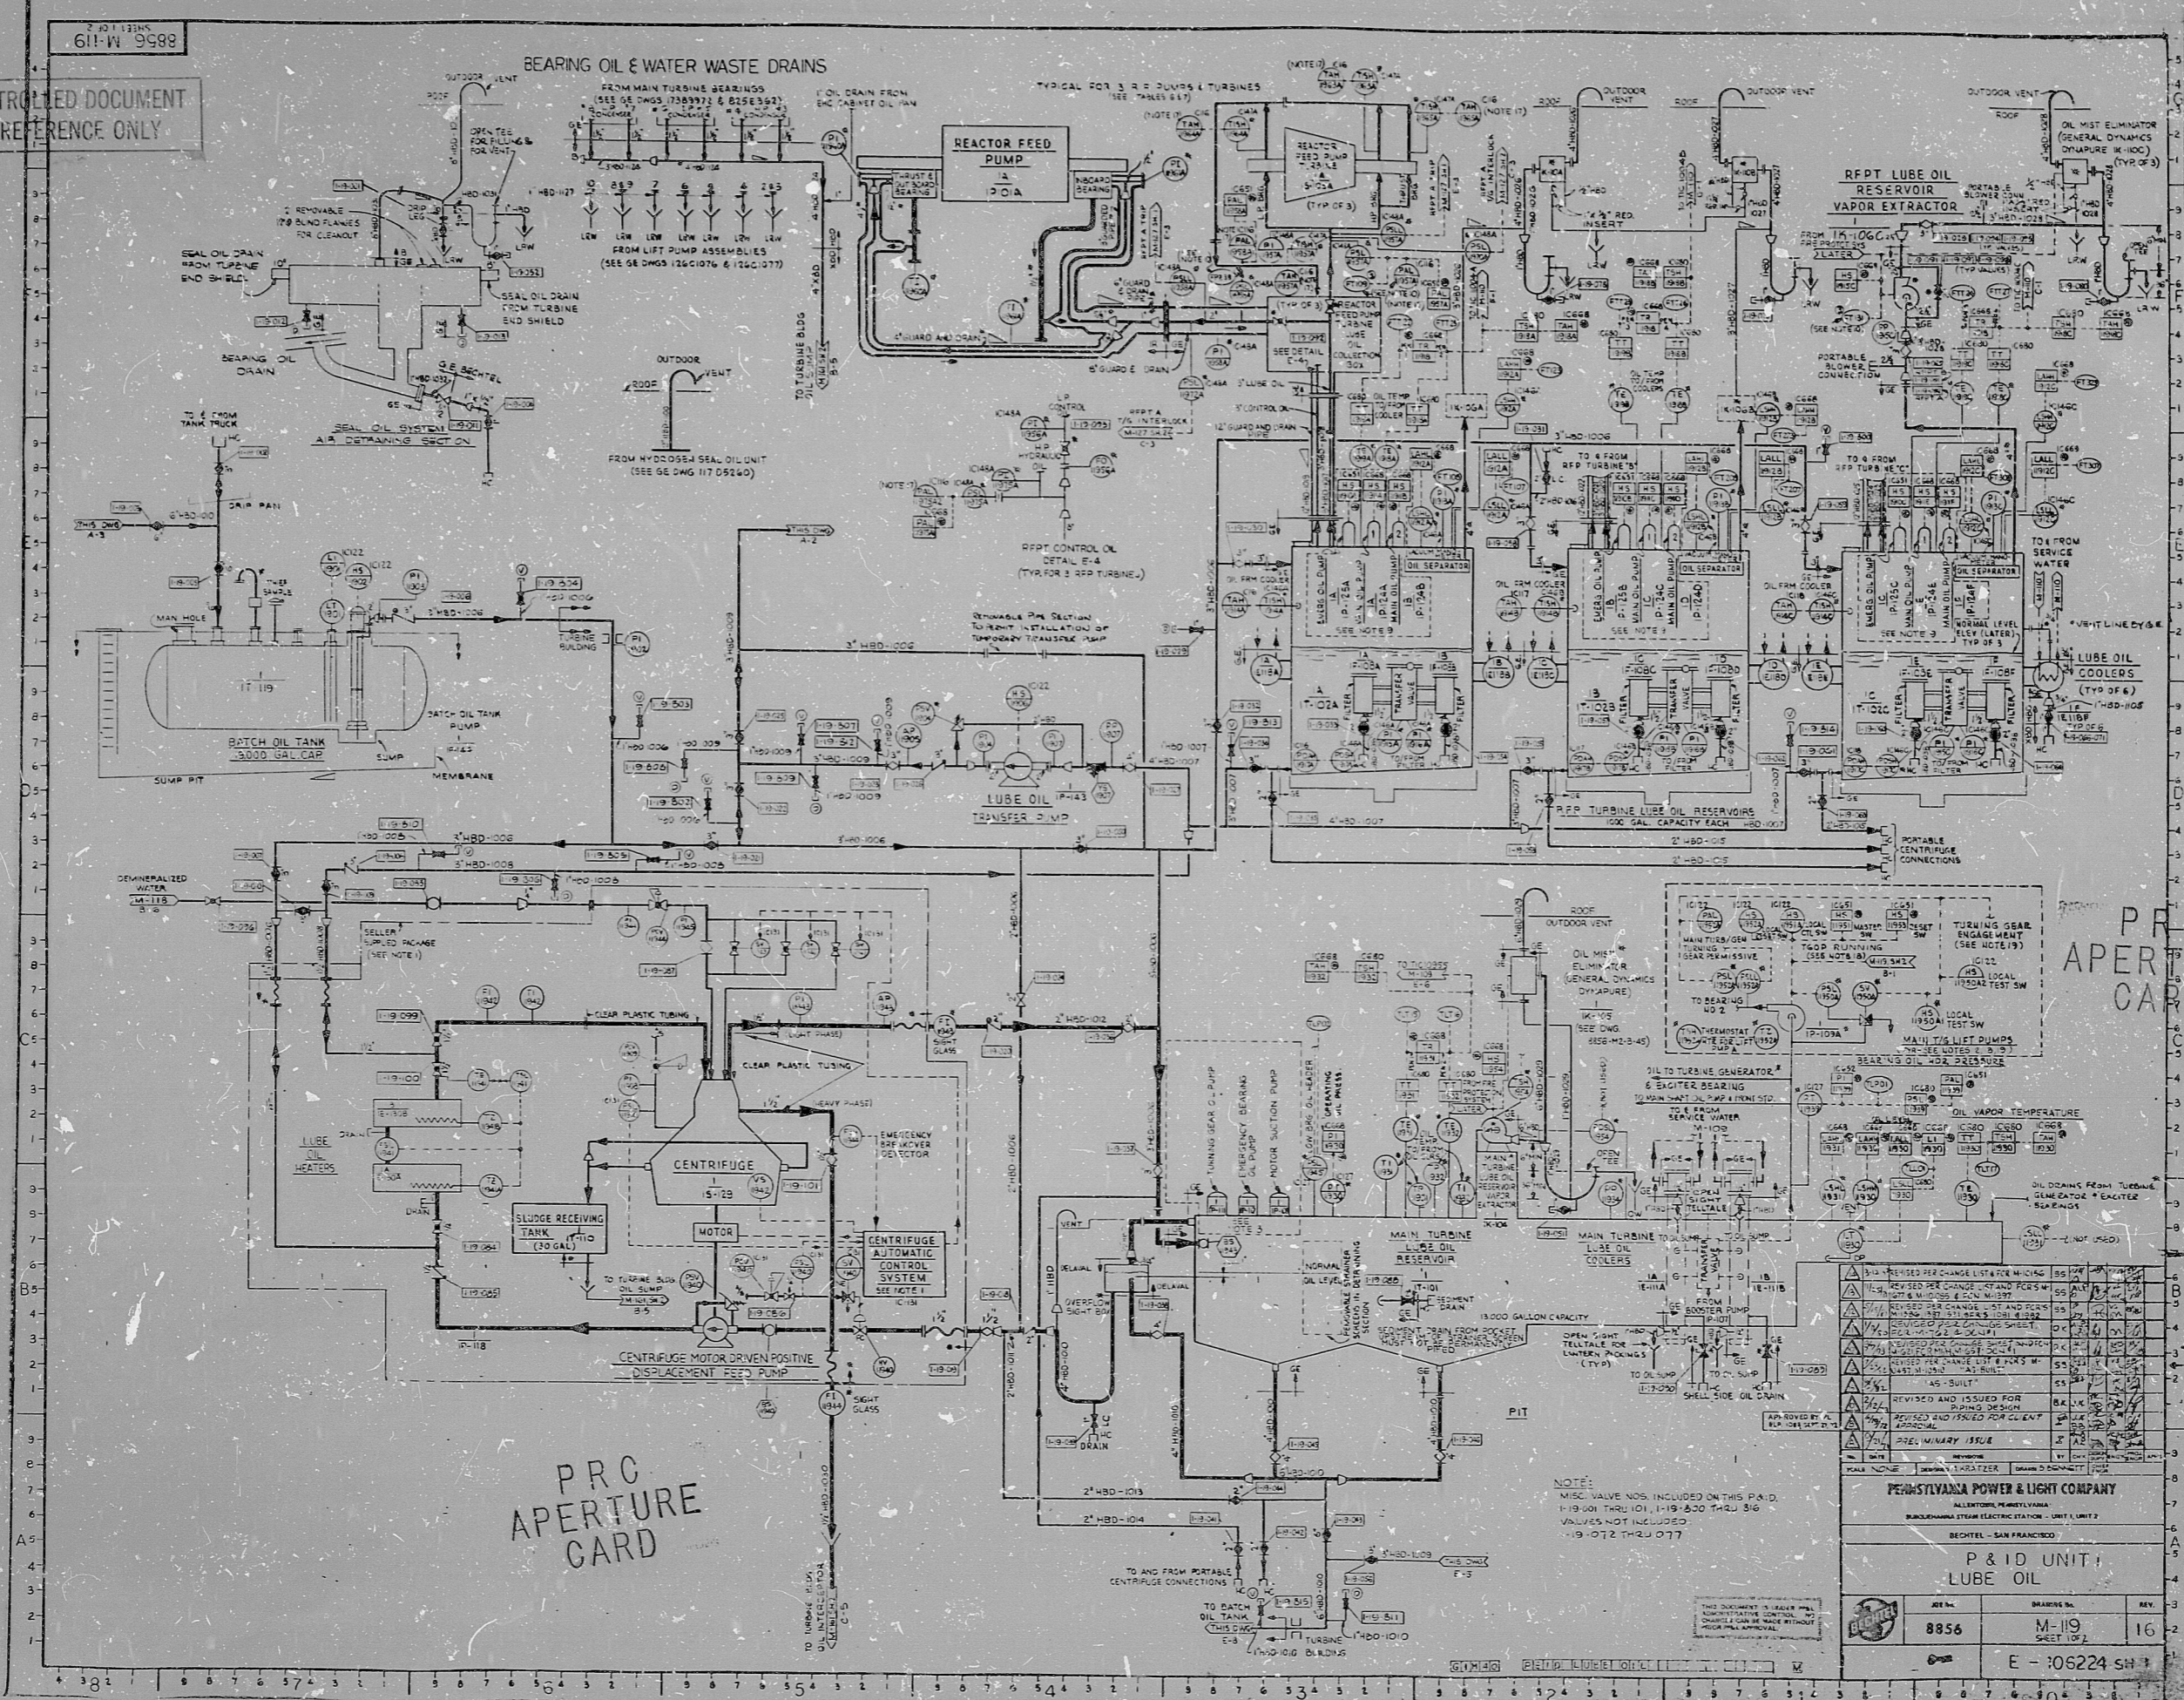

PRC
APERTURE
CARD

PRC
APERTURE
CARD

1	REVISED PER CHANGE LIST FOR MISC	85	11
2	REVISED PER CHANGE LIST FOR MISC	85	11
NOTE:
MISC. VALVE NOS. INCLUDED ON THIS P&ID
1-19-001 THRU 101, 1-19-000 THRU 310
VALVES NOT INCLUDED
1-19-072 THRU 077

P & ID UNIT: LUBE OIL		
REV. NO.	DATE	REV.
8856	M-119 SHEET 1 OF 2	16
E - 106224 SH 1		

RIDS

8305250217

