


17"

8.5"

8.5"

11"

17"

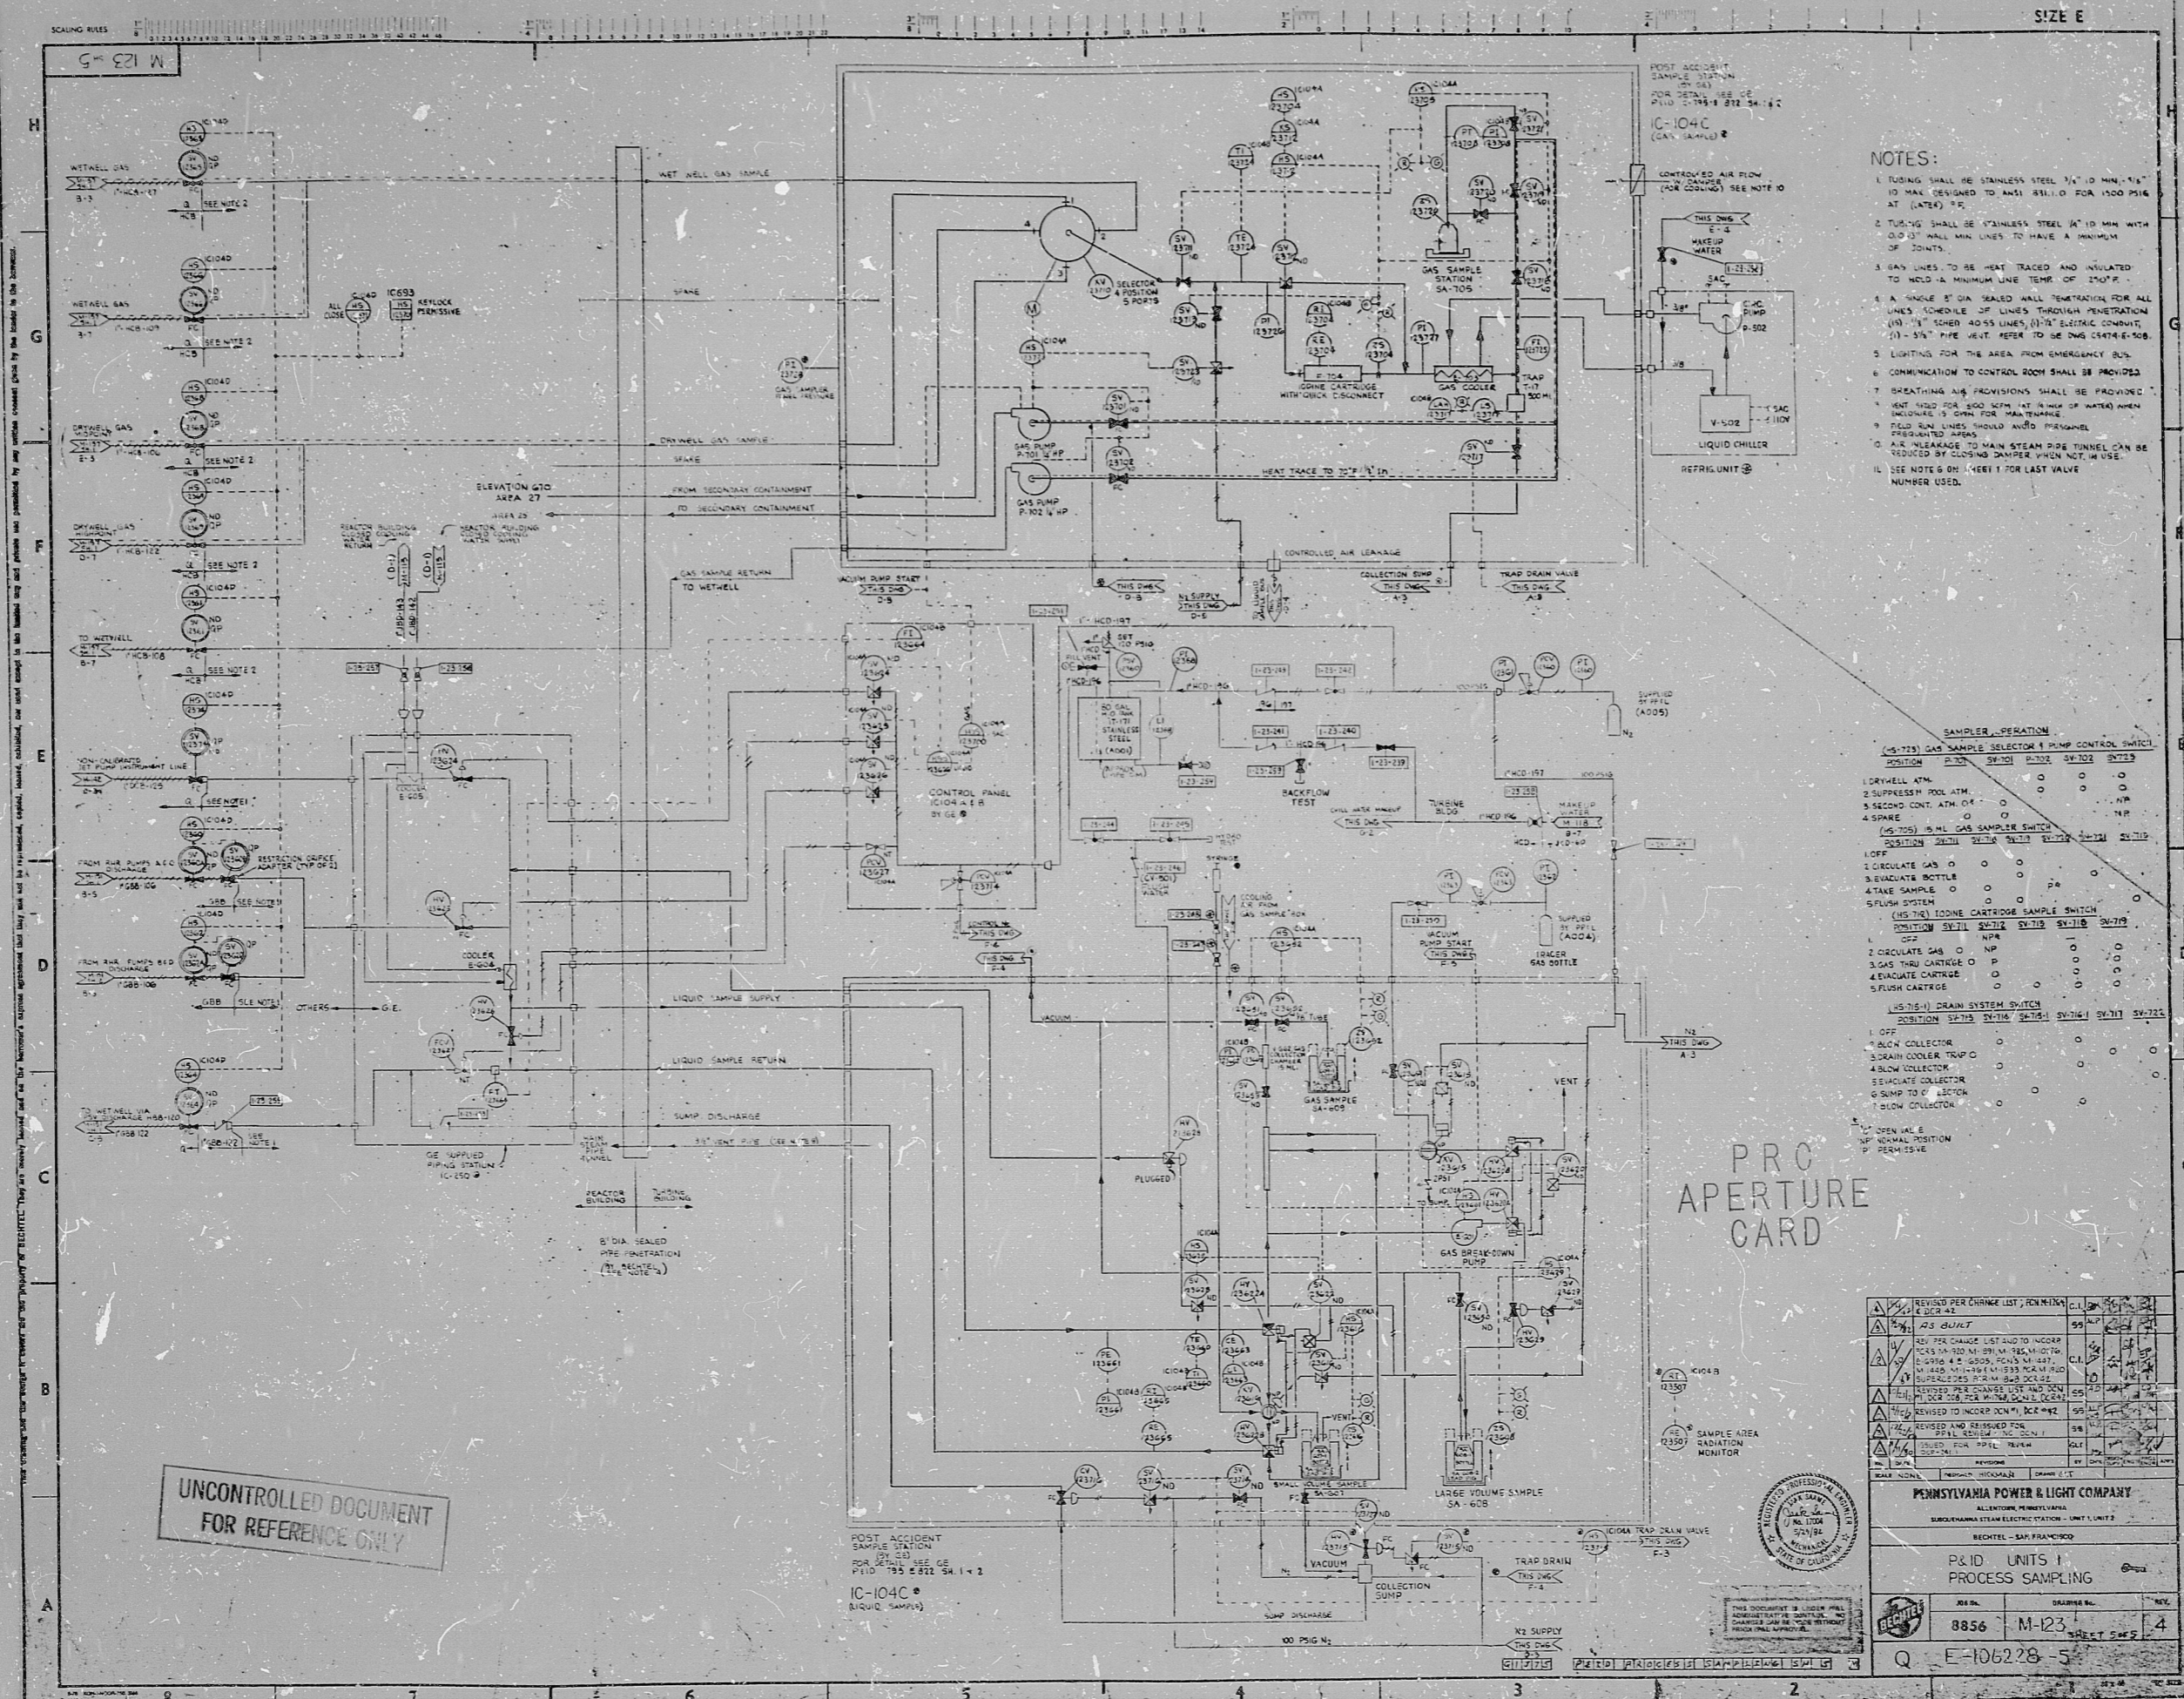

SIZE E

NOTES:

1. TUBING SHALL BE STAINLESS STEEL 1/4" ID MIN. 1/4" ID MAX. DESIGNED TO ANSI B31.10 FOR 1500 PSIG AT (LATE) P.P.
2. TUBING SHALL BE STAINLESS STEEL 1/4" ID MIN. WITH 0.003" WALL MIN. LINES TO HAVE A MINIMUM OF JOINTS.
3. GAS LINES TO BE HEAT TRACED AND INSULATED TO HOLD A MINIMUM LINE TEMP. OF 250°F.
5. LIGHTING FOR THE AREA FROM EMERGENCY BUS.
6. COMMUNICATION TO CONTROL ROOM SHALL BE PROVIDED.
7. BREATHING AIR PROVISIONS SHALL BE PROVIDED.
8. VENT FOR 600 CFM AT 1/2" DIA. OF WATER WHEN INCLUDING 1/2" DIA. FOR MAINTENANCE.
9. FLOOD RELIEF LINES SHOULD AVOID PERSONNEL PRESENTED AREAS.
10. AIR LEAKAGE TO MAIN STEAM PIPE TUNNEL CAN BE REDUCED BY CLOSING DAMPER WHEN NOT IN USE.
11. SEE NOTE ON 1. KEY 1 FOR LAST VALUE NUMBER USED.

SAMPLER OPERATION

(S-725) GAS SAMPLE SELECTOR 4 PUMP CONTROL SWITCH




(S-725) LIQUID CARTRIDGE SAMPLE SWITCH

| | | | | | | | | |
|------------------------|-------|-------|-------|-------|-------|-------|-------|-------|
| 1. OFF | | | | | | | | |
| 2. CIRCULATE GAS | | | | | | | | |
| 3. GAS THIS CARTRIDGE | | | | | | | | |
| 4. SERVICATE CARTRIDGE | | | | | | | | |
| 5. FLUSH CARTRIDGE | | | | | | | | |

(S-725) DRAIN SYSTEM SWITCH

| | | | | | | | |
|------------------------|-------|-------|-------|-------|-------|-------|-------|
| 1. OFF | | | | | | | |
| 2. EACH COLLECTOR | | | | | | | |
| 3. DRAIN COOLER TRAP | | | | | | | |
| 4. SLOW COLLECTOR | | | | | | | |
| 5. SERVICATE COLLECTOR | | | | | | | |
| 6. SUMP TO COLLECTOR | | | | | | | |
| 7. SLOW COLLECTOR | | | | | | | |

KEY:
 * OPEN VALVE
 ○ NORMAL POSITION
 ○ PERMISSIVE

PRO APERTURE CARD

| | | | | |
|--|----------|----------|----------|----------|

PENNSYLVANIA POWER & LIGHT COMPANY

ALLENTOWN, PENNSYLVANIA




P&ID UNITS 1 PROCESS SAMPLING

8856 M-123 SHEET 5 OF 4

Q E-106228-5

UNCONTROLLED DOCUMENT FOR REFERENCE ONLY

POST ACCIDENT SAMPLE STATION FOR DETAIL SEE GE P110 755 E 22 54.1 x 2 IC-104C LIQUID SAMPLER

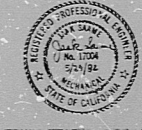

Verify that the microfilm loop contained on this microfilm is made in accordance with the requirements of the American National Standard for Microfilm Documentation. This is a true and correct copy of the original document as approved by the controlling group at source.

RIDS

4805250262

