

22

22

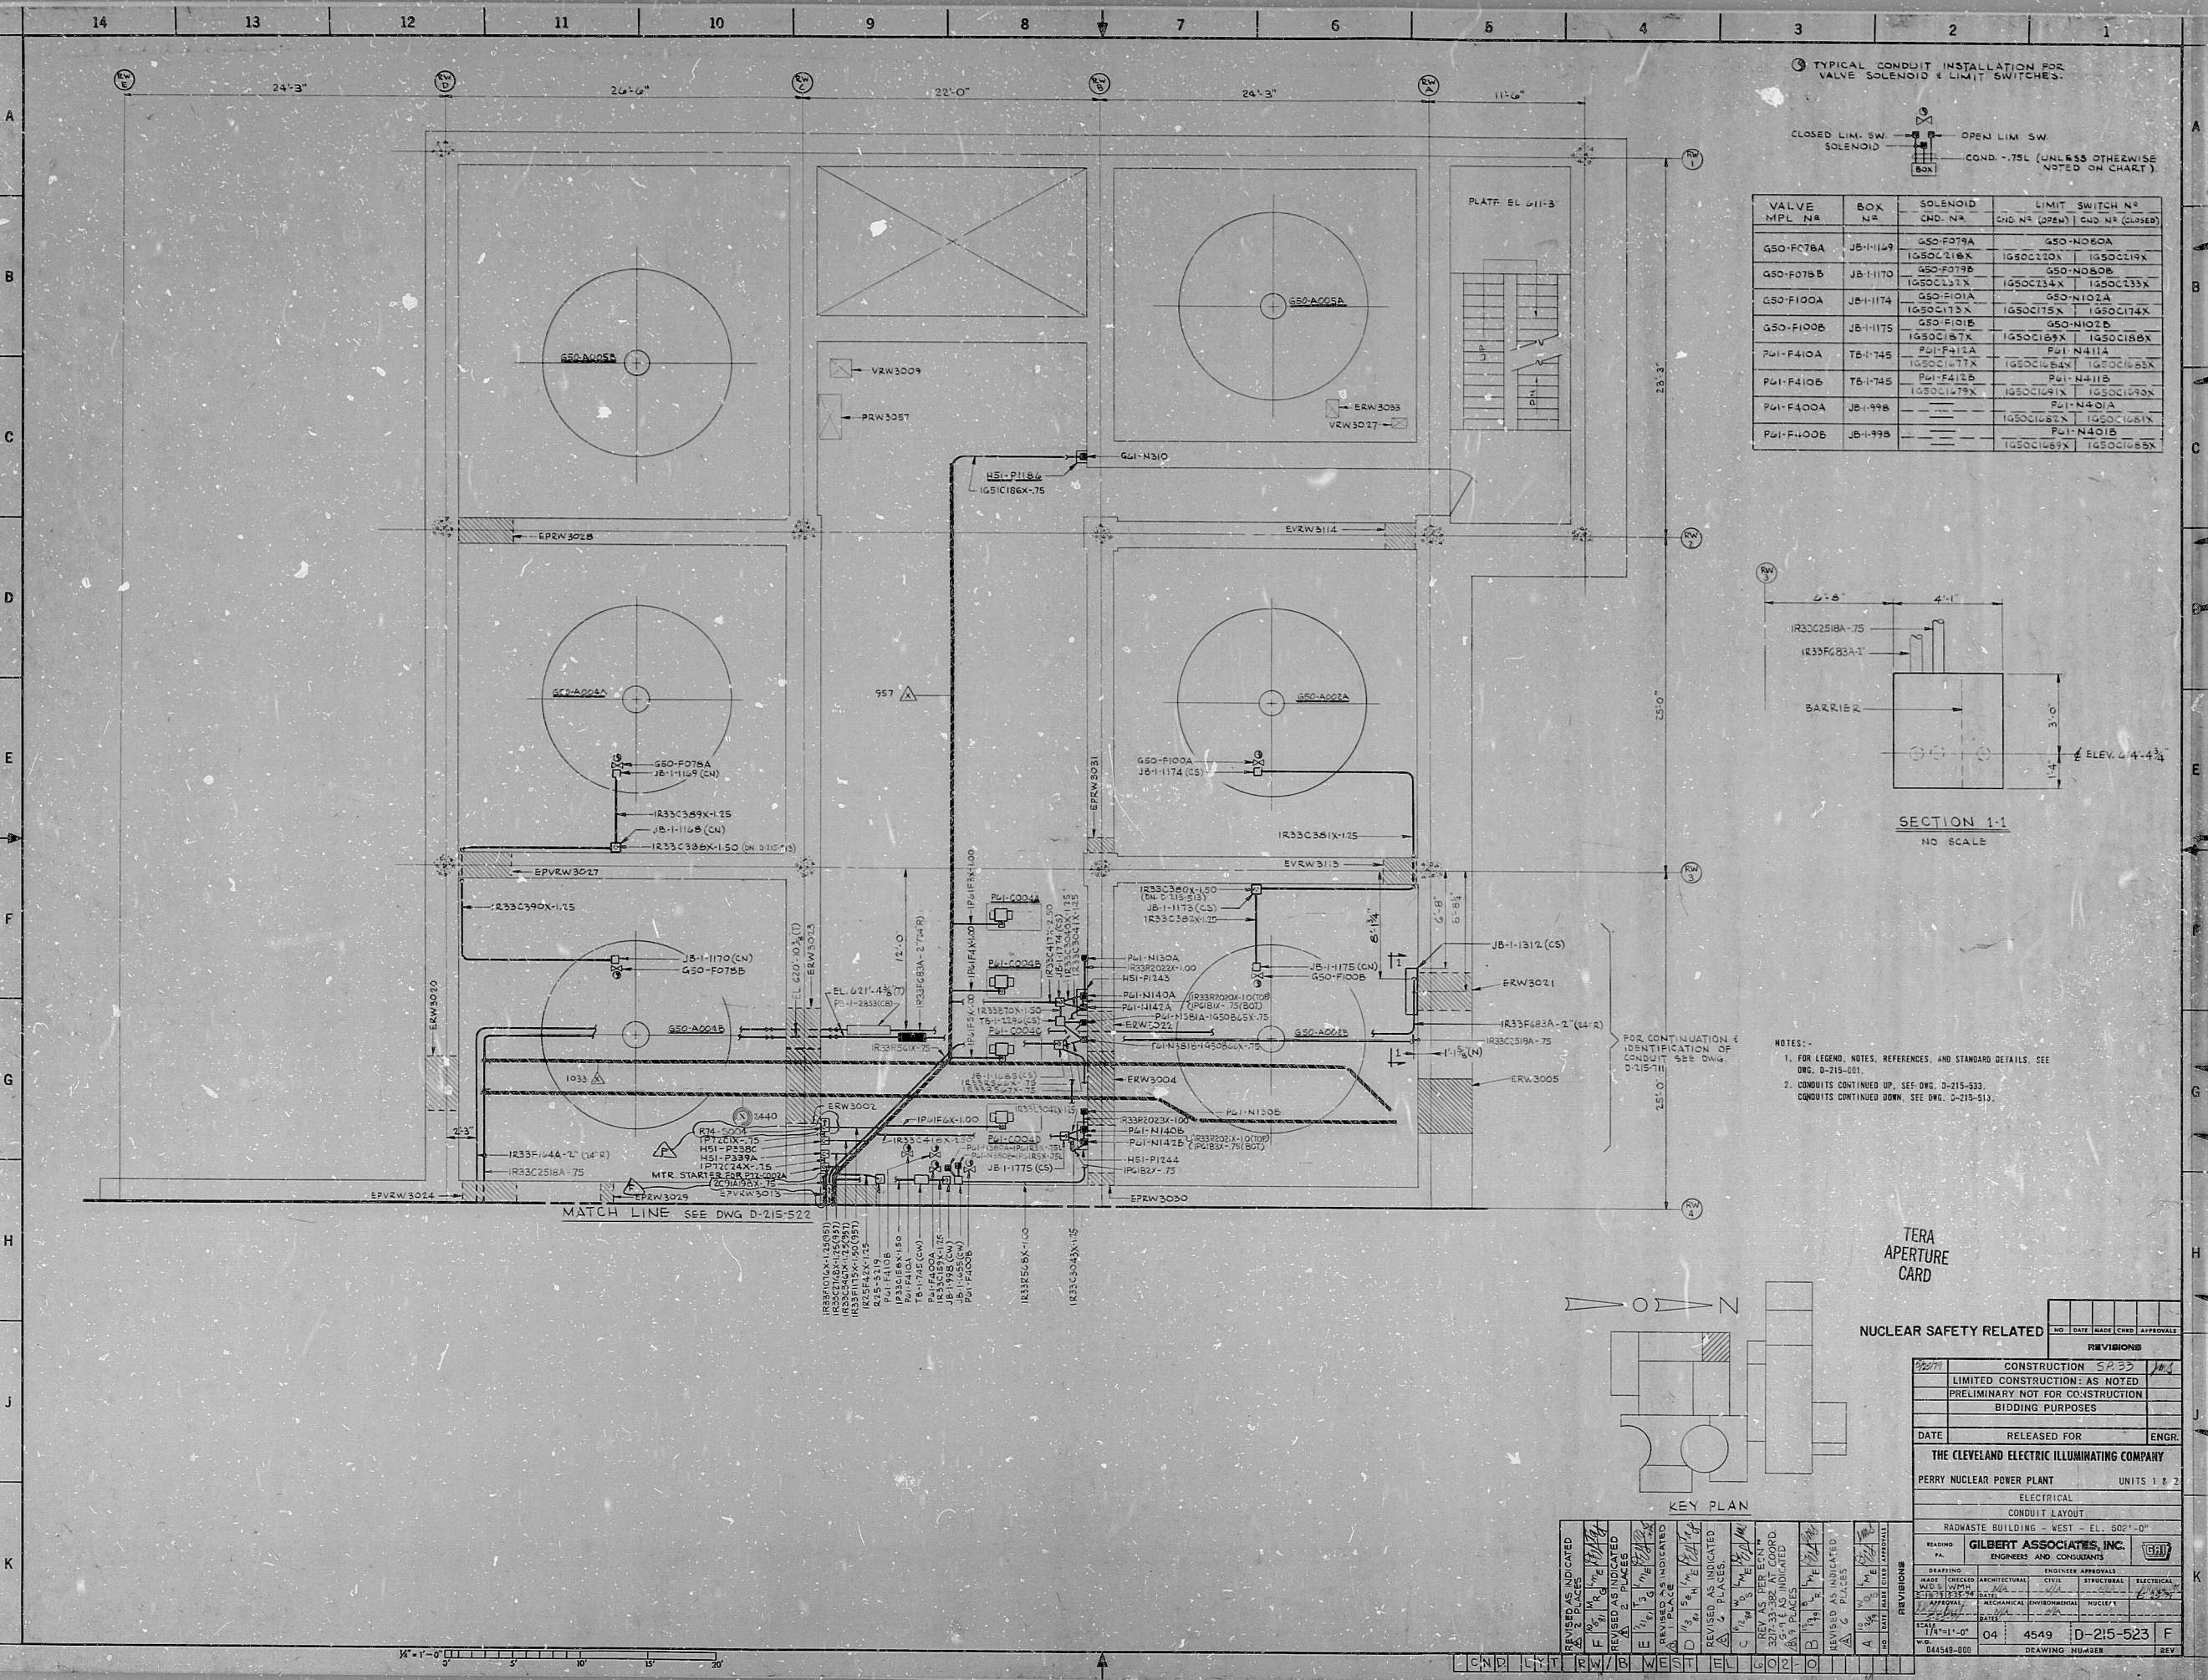

3 TYPICAL CONDUIT INSTALLATION FOR VALVE SOLENOID & LIMIT SWITCHES.

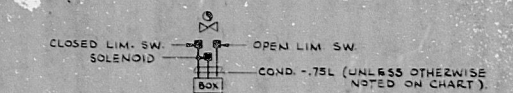

VALVE MPL N°	BOX N°	SOLENOID CHD. N°	LIMIT SWITCH N°

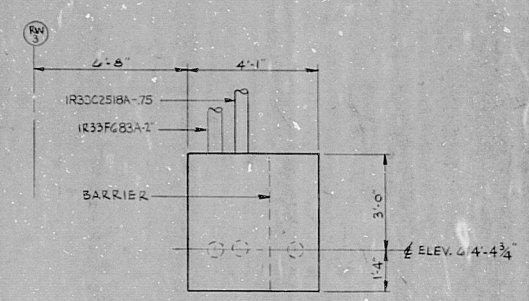

SECTION 1-1 NO SCALE

- NOTES:

TERA APERTURE CARD

NUCLEAR SAFETY RELATED

DATE	RELEASED FOR	ENGR.


GILBERT ASSOCIATES, INC.

ENGINEERS AND CONSULTANTS

DRAWING

DATE

ENGINEER APPROVALS

DESIGNED

ARCHITECTURAL

CIVIL

STRUCTURAL

ELECTRICAL

MADE CHECKED

DATE







































KEY PLAN

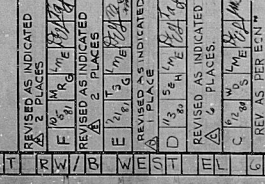

34

34

RIDS

8112040136

