

11


11

8.5"

8.5"

11"

17"

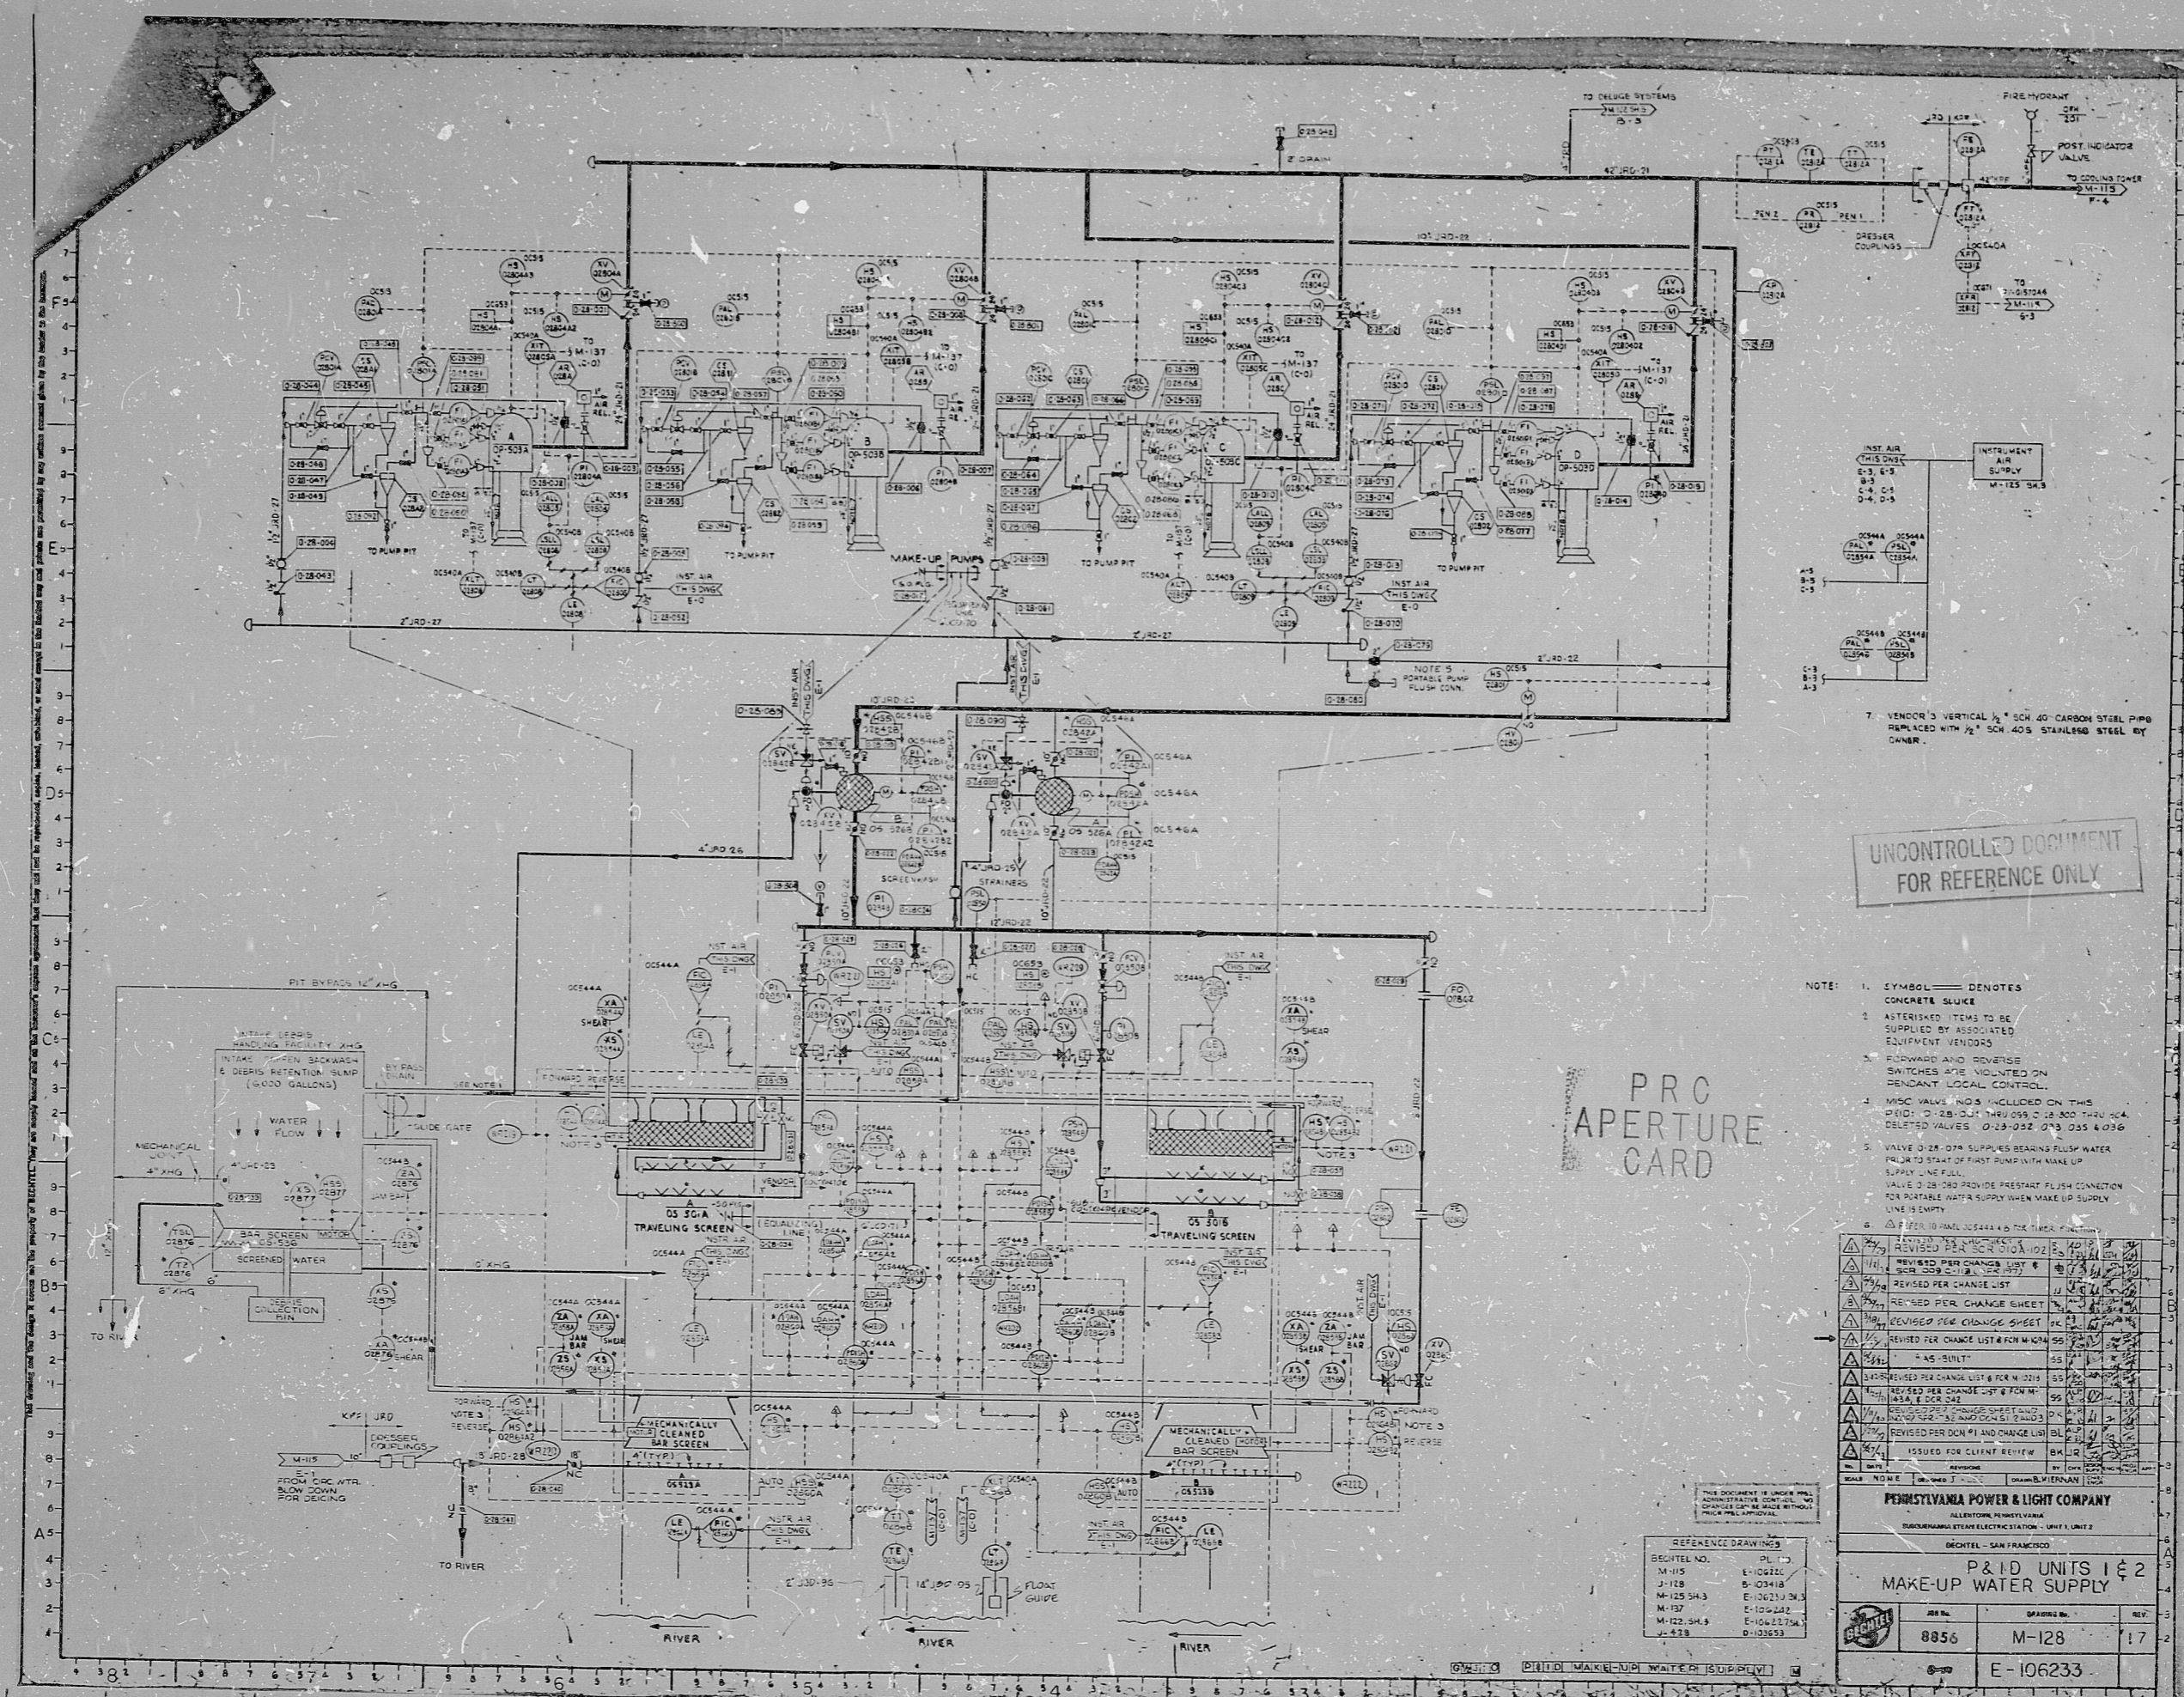

UNCONTROLLED DOCUMENT  
FOR REFERENCE ONLY

- NOTE:
1. SYMBOL DENOTES CONCRETE SLUICE
  2. ASTERISKED ITEMS TO BE SUPPLIED BY ASSOCIATED EQUIPMENT VENDORS
  3. FORWARD AND REVERSE SWITCHES ARE MOUNTED ON PENDANT LOCAL CONTROL
  4. MISC VALVES (NO. 3) INCLUDED ON THIS P&ID: O-28-021 THRU 029, O-28-020 THRU 024, DELETED VALVES: O-28-052, O-28-055 & O-28-056
  5. VALVE O-28-079 SUPPLIES BEARING FLUSH WATER PRIOR TO START OF FIRST PUMP WITH MAKE UP SUPPLY LINE FULL. VALVE O-28-080 PROVIDE PRESTART FLUSH CONNECTION FOR PORTABLE WATER SUPPLY WHEN MAKE UP SUPPLY LINE IS EMPTY
  6. FILTER IS PANEL 025444 & FOR TIMER FUNCTION

PRC  
APERTURE  
CARD

NO.	REVISION	DATE	BY	CHKD.

REFERENCE DRAWINGS

BECHTEL NO.	PL. NO.
M-115	E-106222
J-118	B-03418
M-125-543	E-106231-24.1
M-137	E-106242
M-122-543	E-106227-24.1
J-423	D-103253

THIS DOCUMENT IS UNDER P&L ADMINISTRATIVE CONTROL. NO CHANGES CAN BE MADE WITHOUT P&L APPROVAL.

DECHTEL - SAN FRANCISCO

P&ID UNITS 1 & 2  
MAKE-UP WATER SUPPLY

JOB NO.	DRAWING NO.	REV.
8856	M-128	17
E-106233		

30X

RIDS

8305250322

