

8856-M-146


- NOTES:
1. THE SYMBOLS IN THIS SYSTEM IS C-2.
  2. CHECK FOR VALVES WITH CAP ON DISCHARGE SIDE AT ALL SYSTEM HIGH POINTS.
  3. PROVIDE ORANGE VALVES WITH CAP ON DISCHARGE SIDE AT ALL SYSTEM HIGH POINTS.
  7. P&ID REPRESENTS A CHECK VALVE WITH ORIFICE.
  8. VALVE POSITIONS SUPPLIED WITH VALVE.
  9. CONTROL STATION SHALL BE LOCATED WITHIN SIGHT OF CONTROLLED PRESSURE INDICATORS.
  10. SPRING LOADED PISTON ACTUATED VALVE HELD OPEN BY AIR PRESSURE DURING NORMAL OPERATION.
  11. ALL PIPING SHALL BE PITCHED CONTINUOUSLY FROM HIGH POINTS TO LOW POINTS WITH A MINIMUM SLOPE OF 1/8 INCH PER FOOT UNLESS OTHERWISE NOTED IN G.E.P. ALL HIGH POINTS SHALL BE LOCATED OUTSIDE THE PRIMARY CONTAINMENT.
  12. SAMPLE NOZZLES PROVIDED BY BESCHTEL, BUT INSTALLED BY SUB CONTRACTOR.
  13. MISCELLANEOUS VALVE NUMBERS USED ARE: 1-40-001 THRU 1-40-002 AND 1-40-003 THRU 1-40-004.

DRIVE WATER PUMP "A" ORANGE VALVE SYSTEM (TYP. OF PUMP "A")

NUCLEAR BOILER VESSEL INSTRUMENTATION REACTOR PRESSURE ABOVE COREPLATE

DRIVE WATER PUMP "A" MOTOR WINDING 4 SELECTS TEMPERATURE (TYP. FOR PUMP "A")

WINDINGS

SELECT HOTTEST TEMP

BEARINGS

INSTALLED IN MOTOR BEARING BUT NOT CONNECTED

FROM MAKE UP REJECT LINE

WATER FROM CONDENSATE HEADER


TO CONDENSATE STORAGE TANK





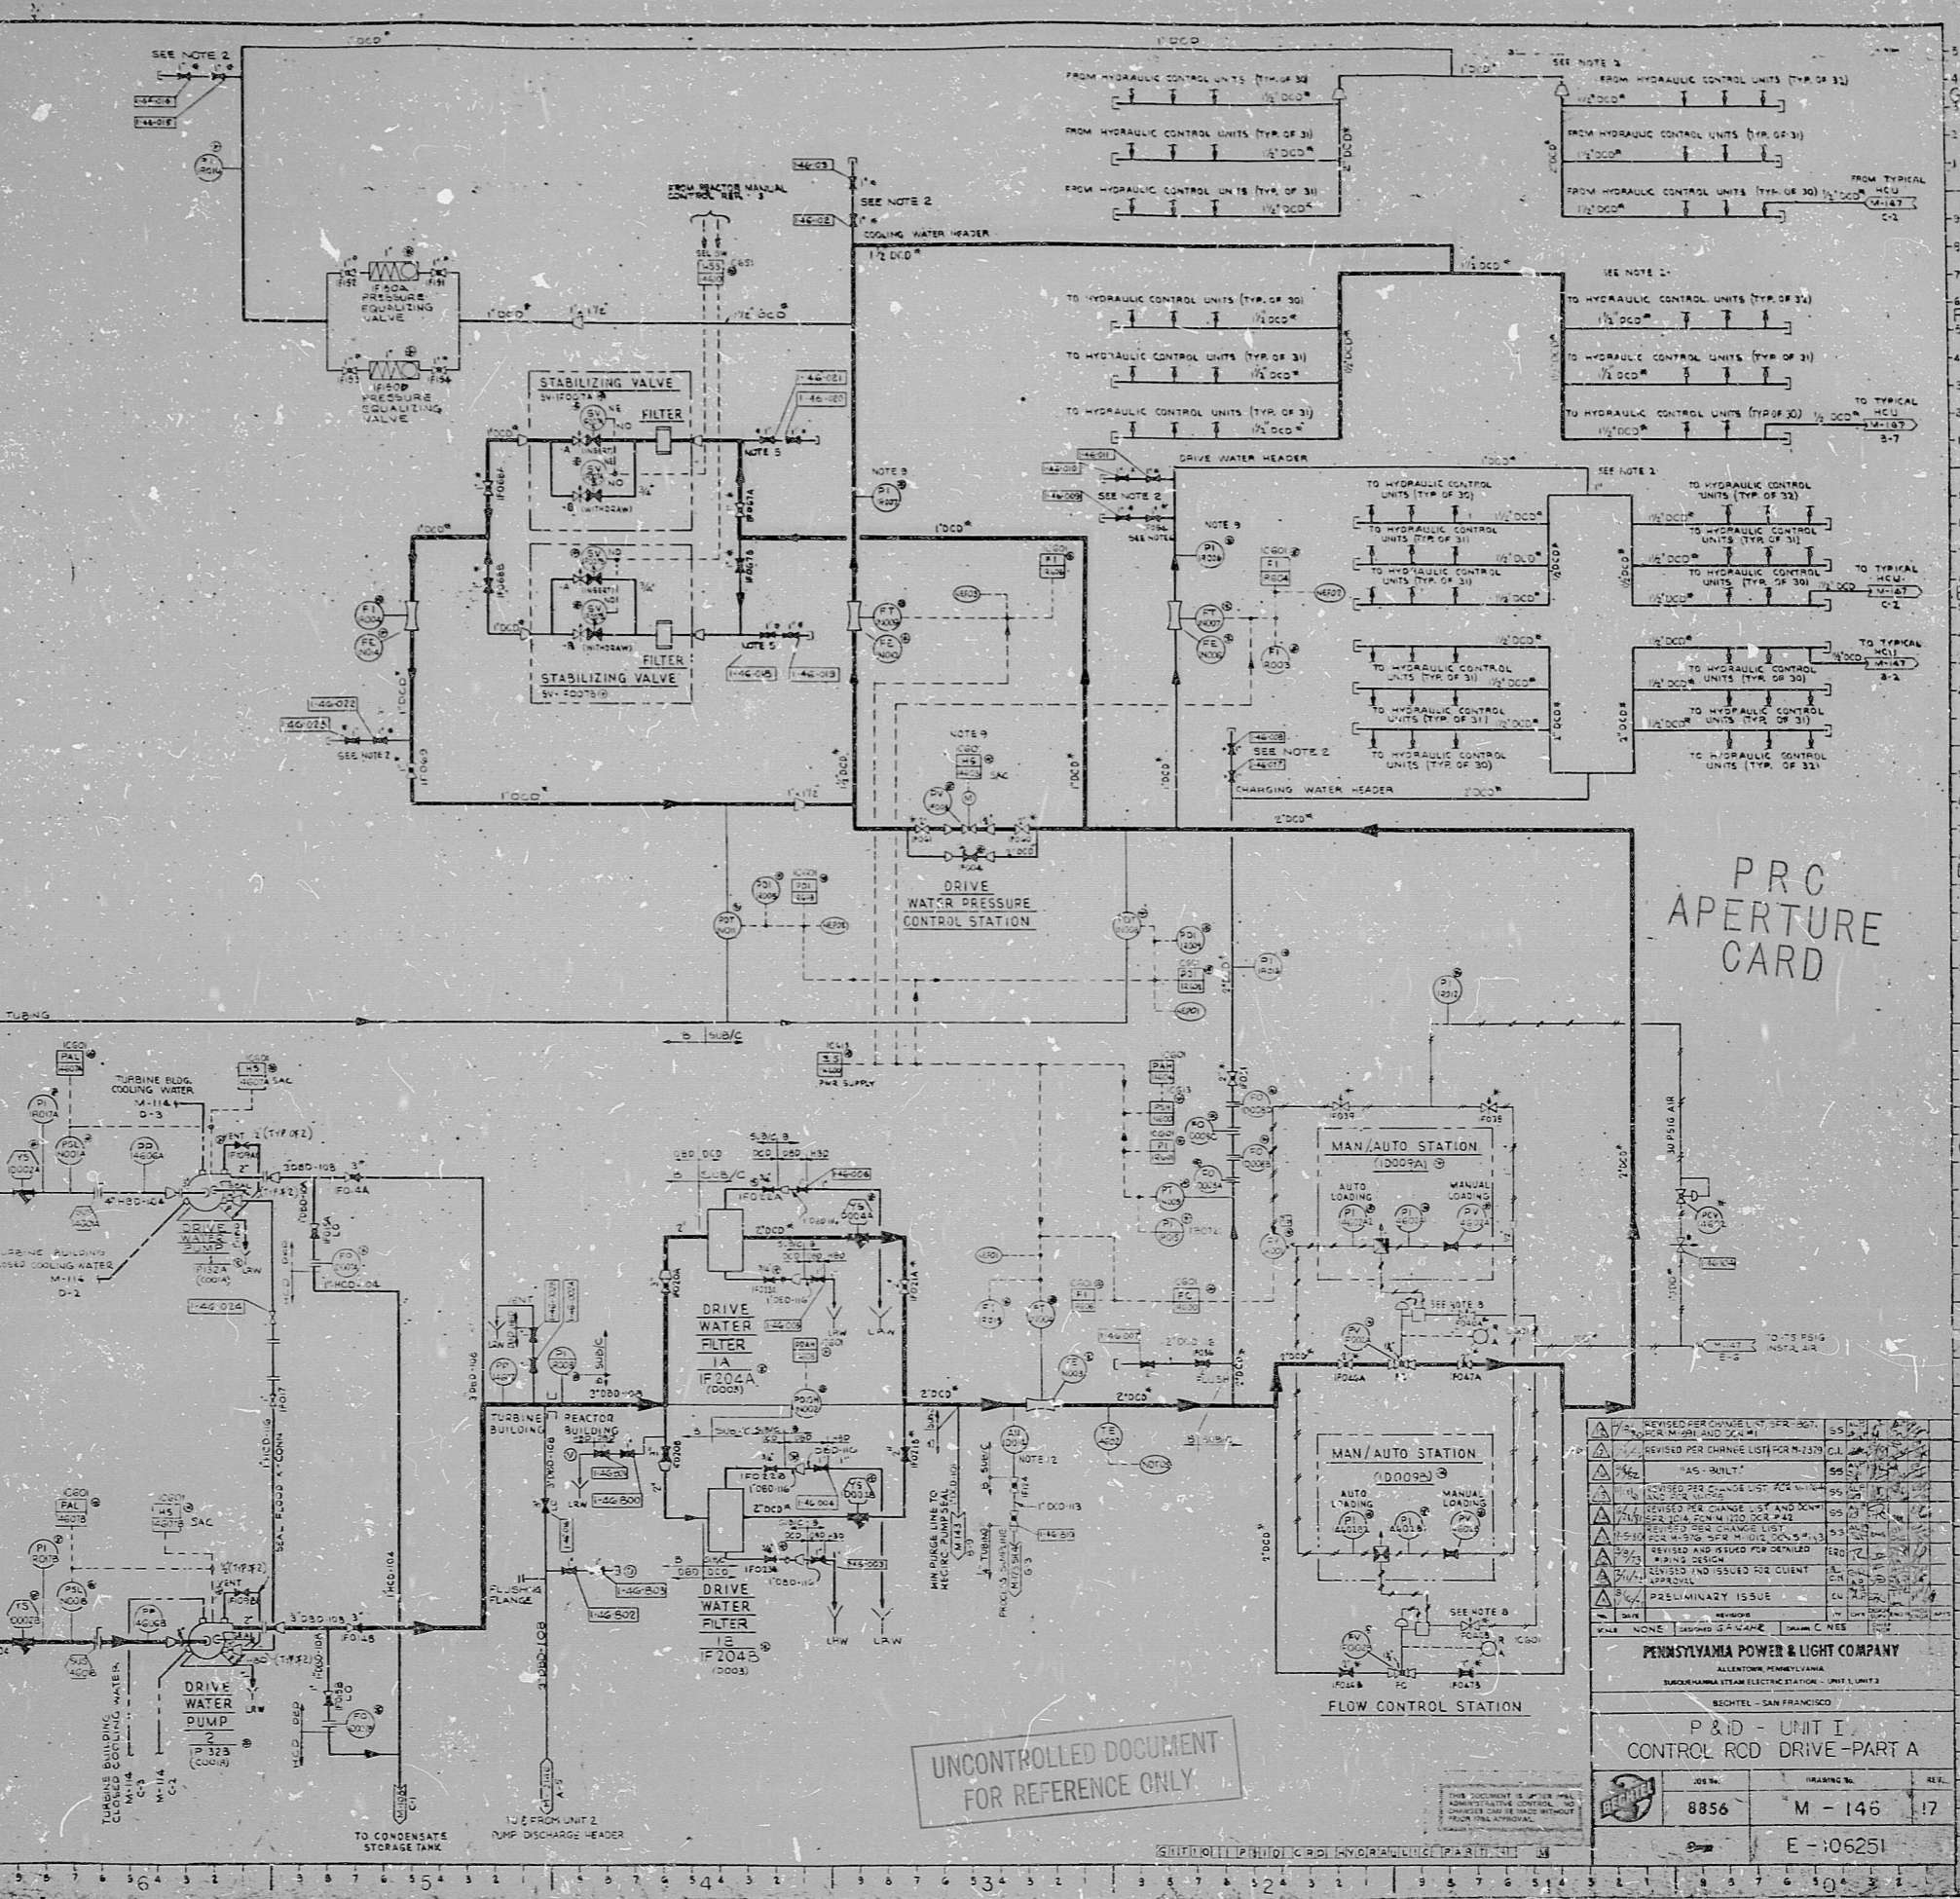

PRC APERTURE CARD

UNCONTROLLED DOCUMENT FOR REFERENCE ONLY

 REACTOR BUILDING  
 P & ID - UNIT I  
 CONTROL ROD DRIVE - PART A  
 JOB NO. 8856 DRAWING NO. M-146 REV. 17  
 E-106251


RIDS

8305250347

