



SECTION 1-1
 DWG. D-25-146-02-000, CONTROL CENTER 1 & 2, UNIT 1
 SCALE: 1/2"=1'-0"

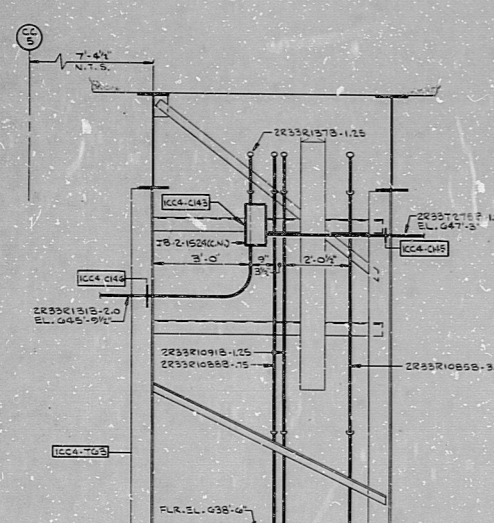

SECTION 2-2
 DWG. D-25-146-02-000, CONTROL CENTER 1 & 2, UNIT 1
 SCALE: 1/2"=1'-0"

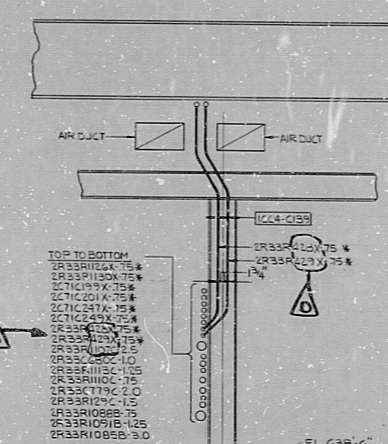

SECTION 3-3
 DWG. D-25-146-02-000, CONTROL CENTER 1 & 2, UNIT 1
 SCALE: 1/2"=1'-0"

34"
 22"
 17"
 11"
 8.5"
 22"
 17"
 11"
 8.5"
 22"
 34"

34"
 22"
 17"
 11"
 8.5"
 22"
 17"
 11"
 8.5"
 22"
 34"

TERA APERTURE CARD

NUCLEAR SAFETY RELATED

REVISIONS	
NO. DATE	BY
1 04/15/62	JRK
2 04/15/62	JRK
CONSTRUCTION	
DATE	RELEASED FOR
04/15/62	ENGR.
THE CLEVELAND ELECTRIC ILLUMINATING COMPANY	
PERRY NUCLEAR POWER PLANT	
UNITS 1 & 2	
ELECTRICAL	
CONDUIT LAYOUT	
CONTROL CENTER - SECTIONS AND DETAILS	
DRAWING NO. GILBERT ASSOCIATES, INC.	
ENGINEERS AND CONSULTANTS	
DRAFTING	
ARCHITECTURAL CIVIL STRUCTURAL ELECTRICAL	
MECHANICAL ENVIRONMENTAL NUCLEAR	
SCALE	
AS NOTED	
04	4549 D-215-662 E
04549-000	DRAWING NUMBER

REVISIONS	
NO. DATE	BY
1 04/15/62	JRK
2 04/15/62	JRK
CND LYTH CONTROL CMLPX SECS & DETS

RIDS

8/1204073

