


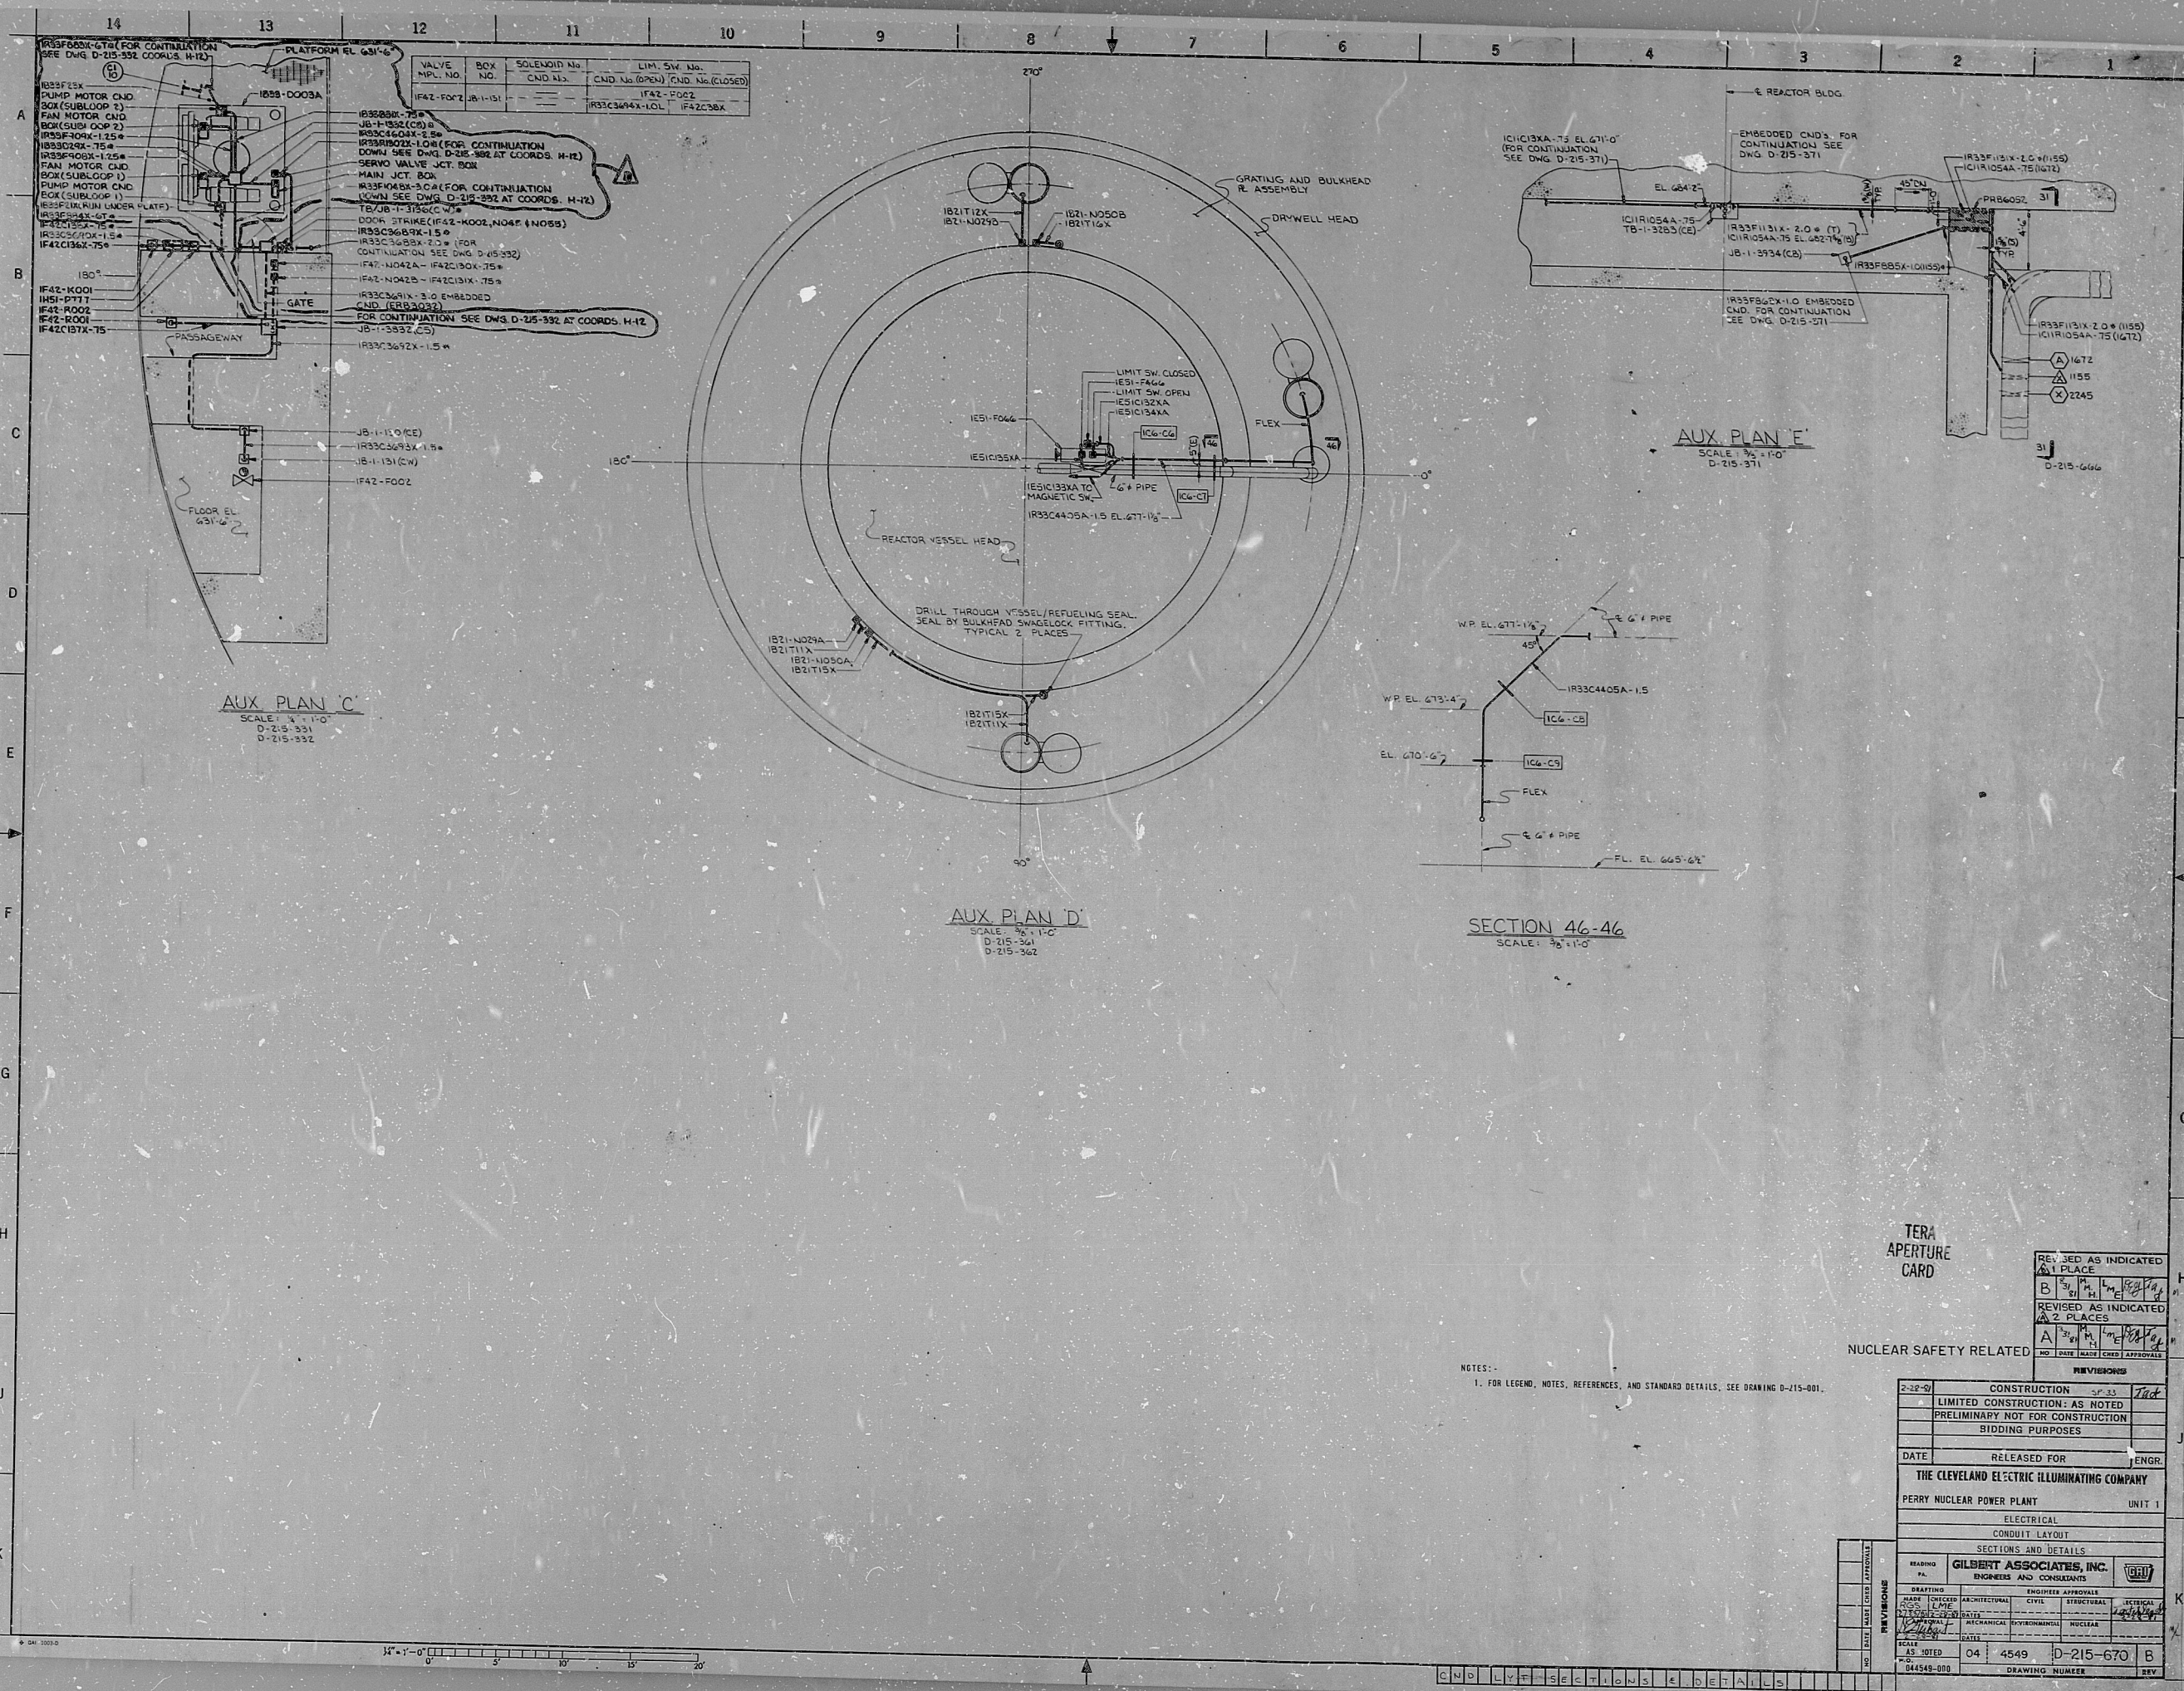

RIDS

8112040192

