


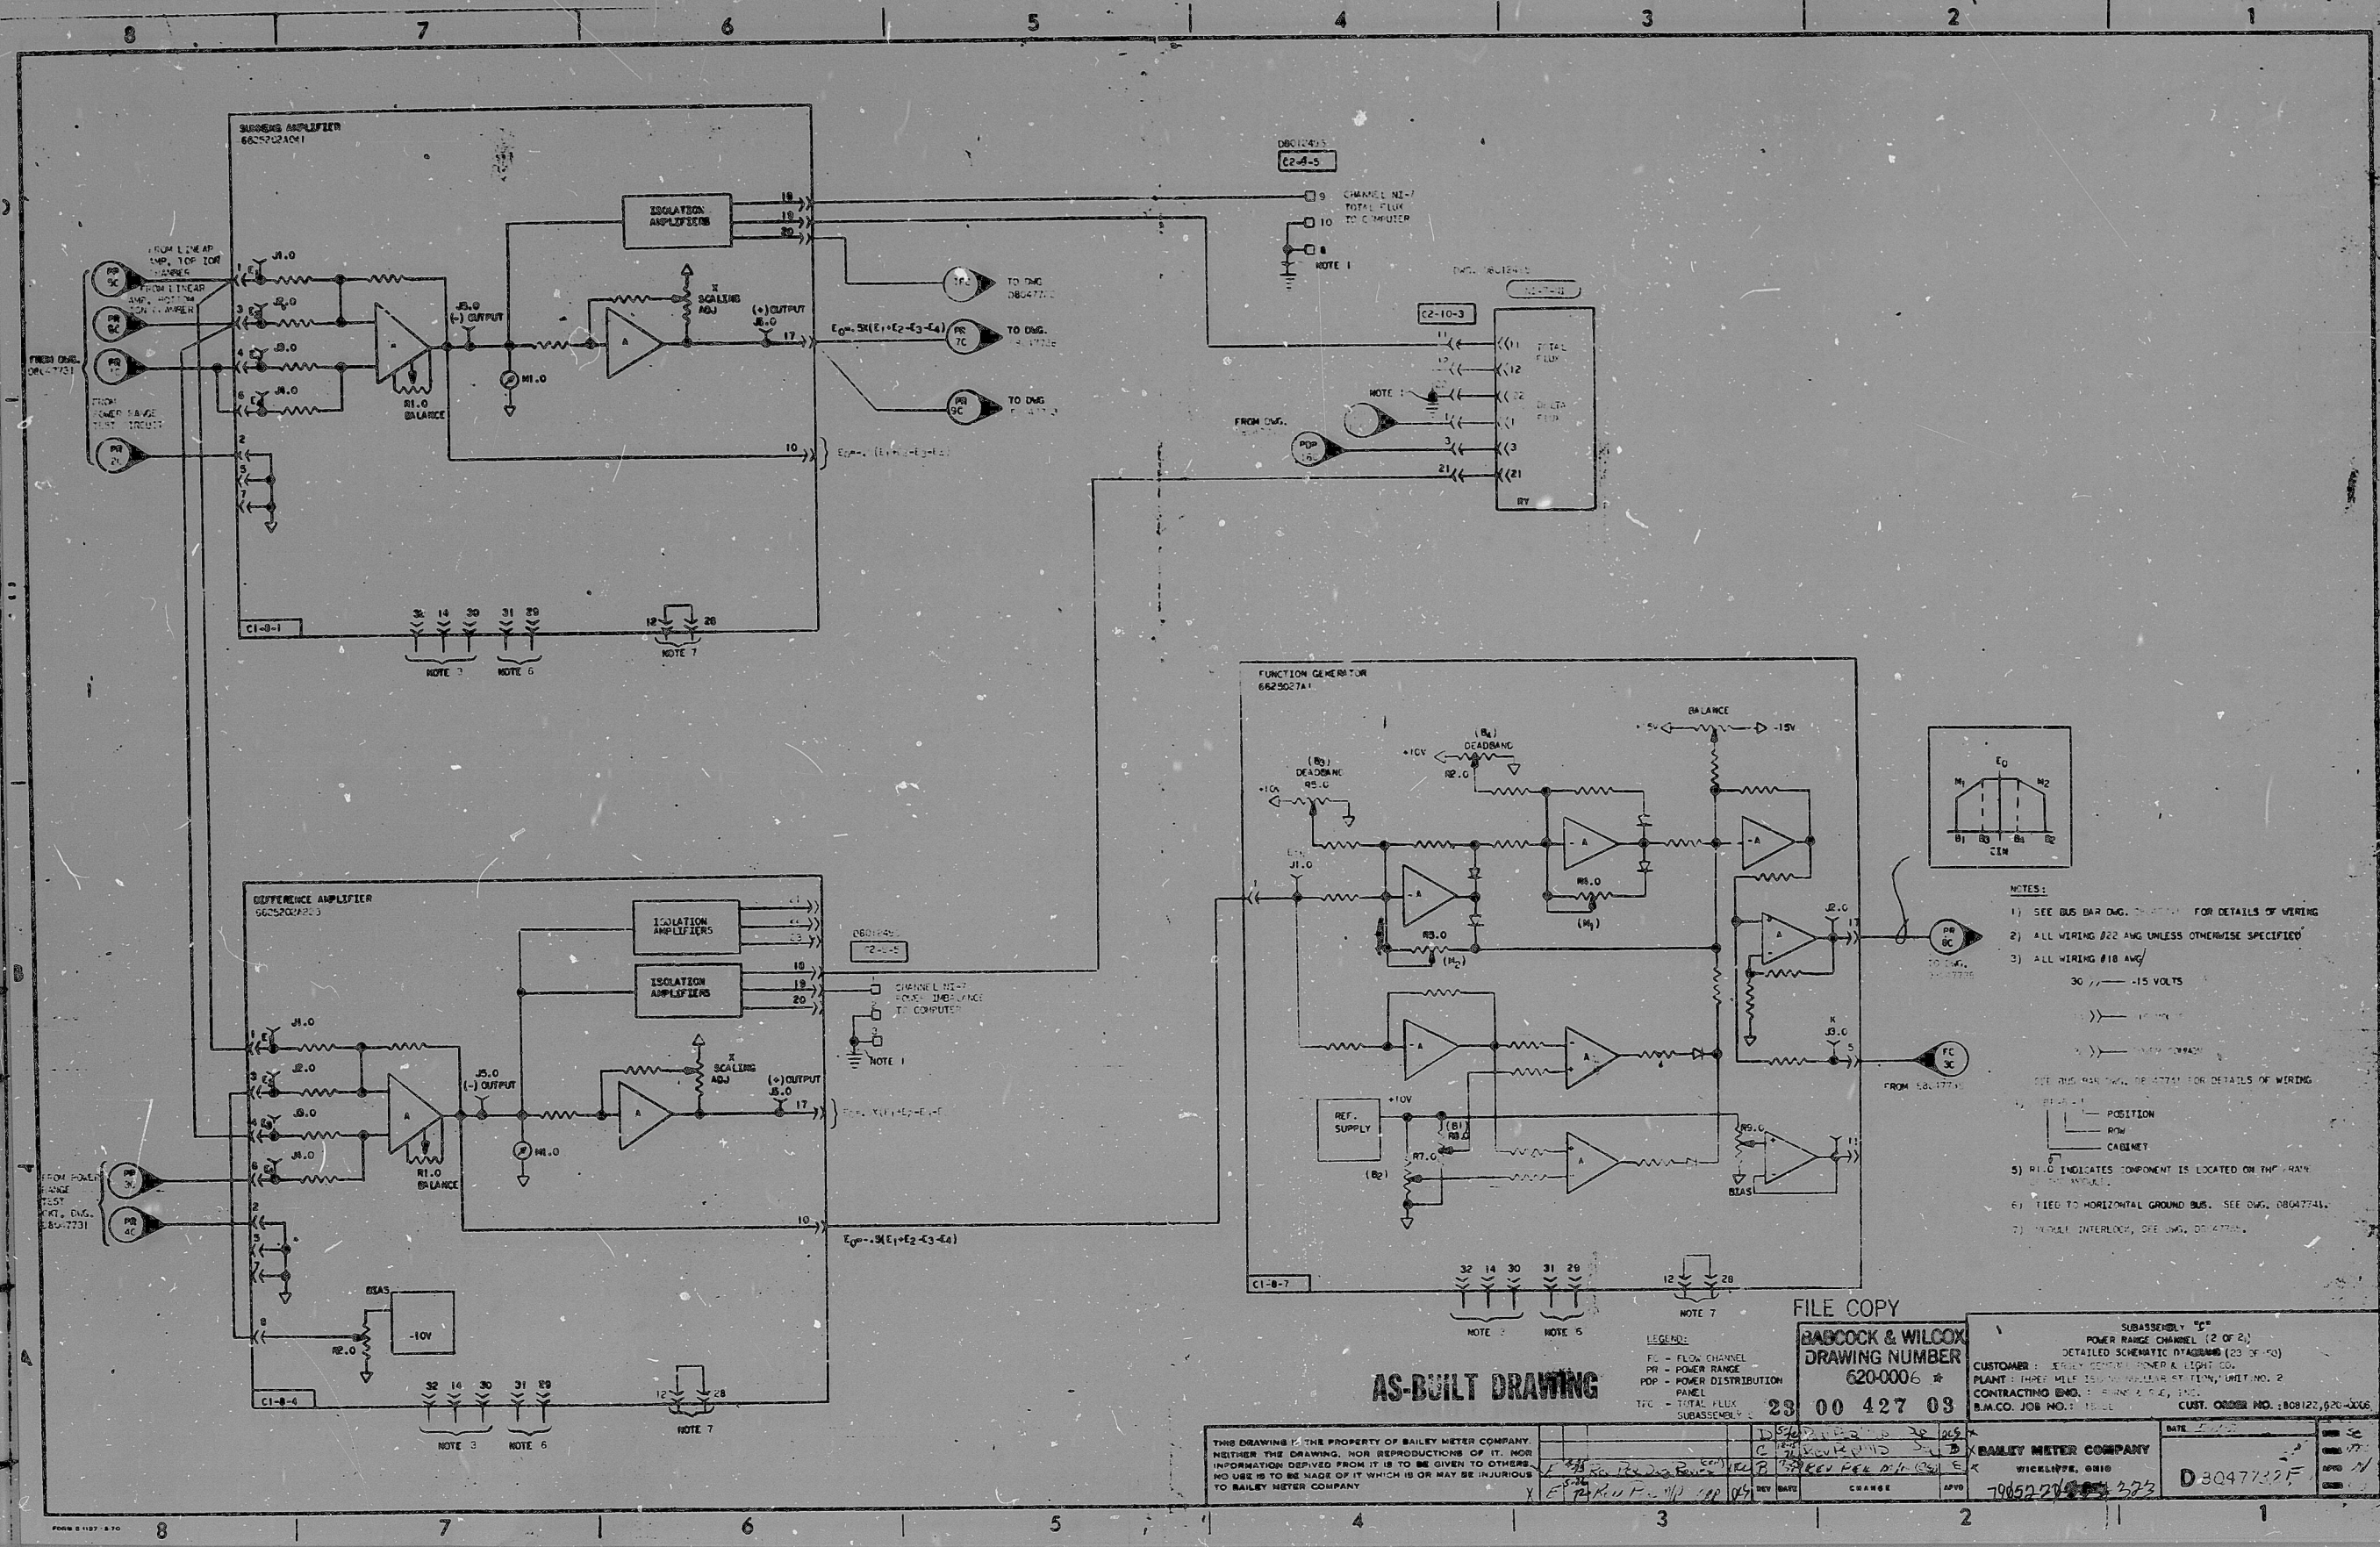

THIS DRAWING IS THE PROPERTY OF BAILEY METER COMPANY. NEITHER THE DRAWING, NOR REPRODUCTIONS OF IT, NOR INFORMATION DERIVED FROM IT IS TO BE GIVEN TO OTHERS. NO USE IS TO BE MADE OF IT WHICH IS OR MAY BE INJURIOUS TO BAILEY METER COMPANY.

LEGEND:
FC - FLOW CHANNEL
PR - POWER RANGE
PD - POWER DISTRIBUTION
TFC - TOTAL FLOW SUBASSEMBLY

FILE COPY
BAIRCOCK & WILCOX
DRAWING NUMBER
620-0006
23 00 427 03

SUBASSEMBLY "C"
POWER RANGE CHANNEL (2 OF 2)
DETAILED SCHEMATIC DIAGRAM (23 OF 40)
B.M.C. JOB NO. 1-1111
CUST. ORDER NO. 1808127, 920-0006

BY: [Signature]
CHECKED: [Signature]
APPROVED: [Signature]

BAILEY METER COMPANY
79052-274

7905220323

