


SECTION A-A
(D-226-511)

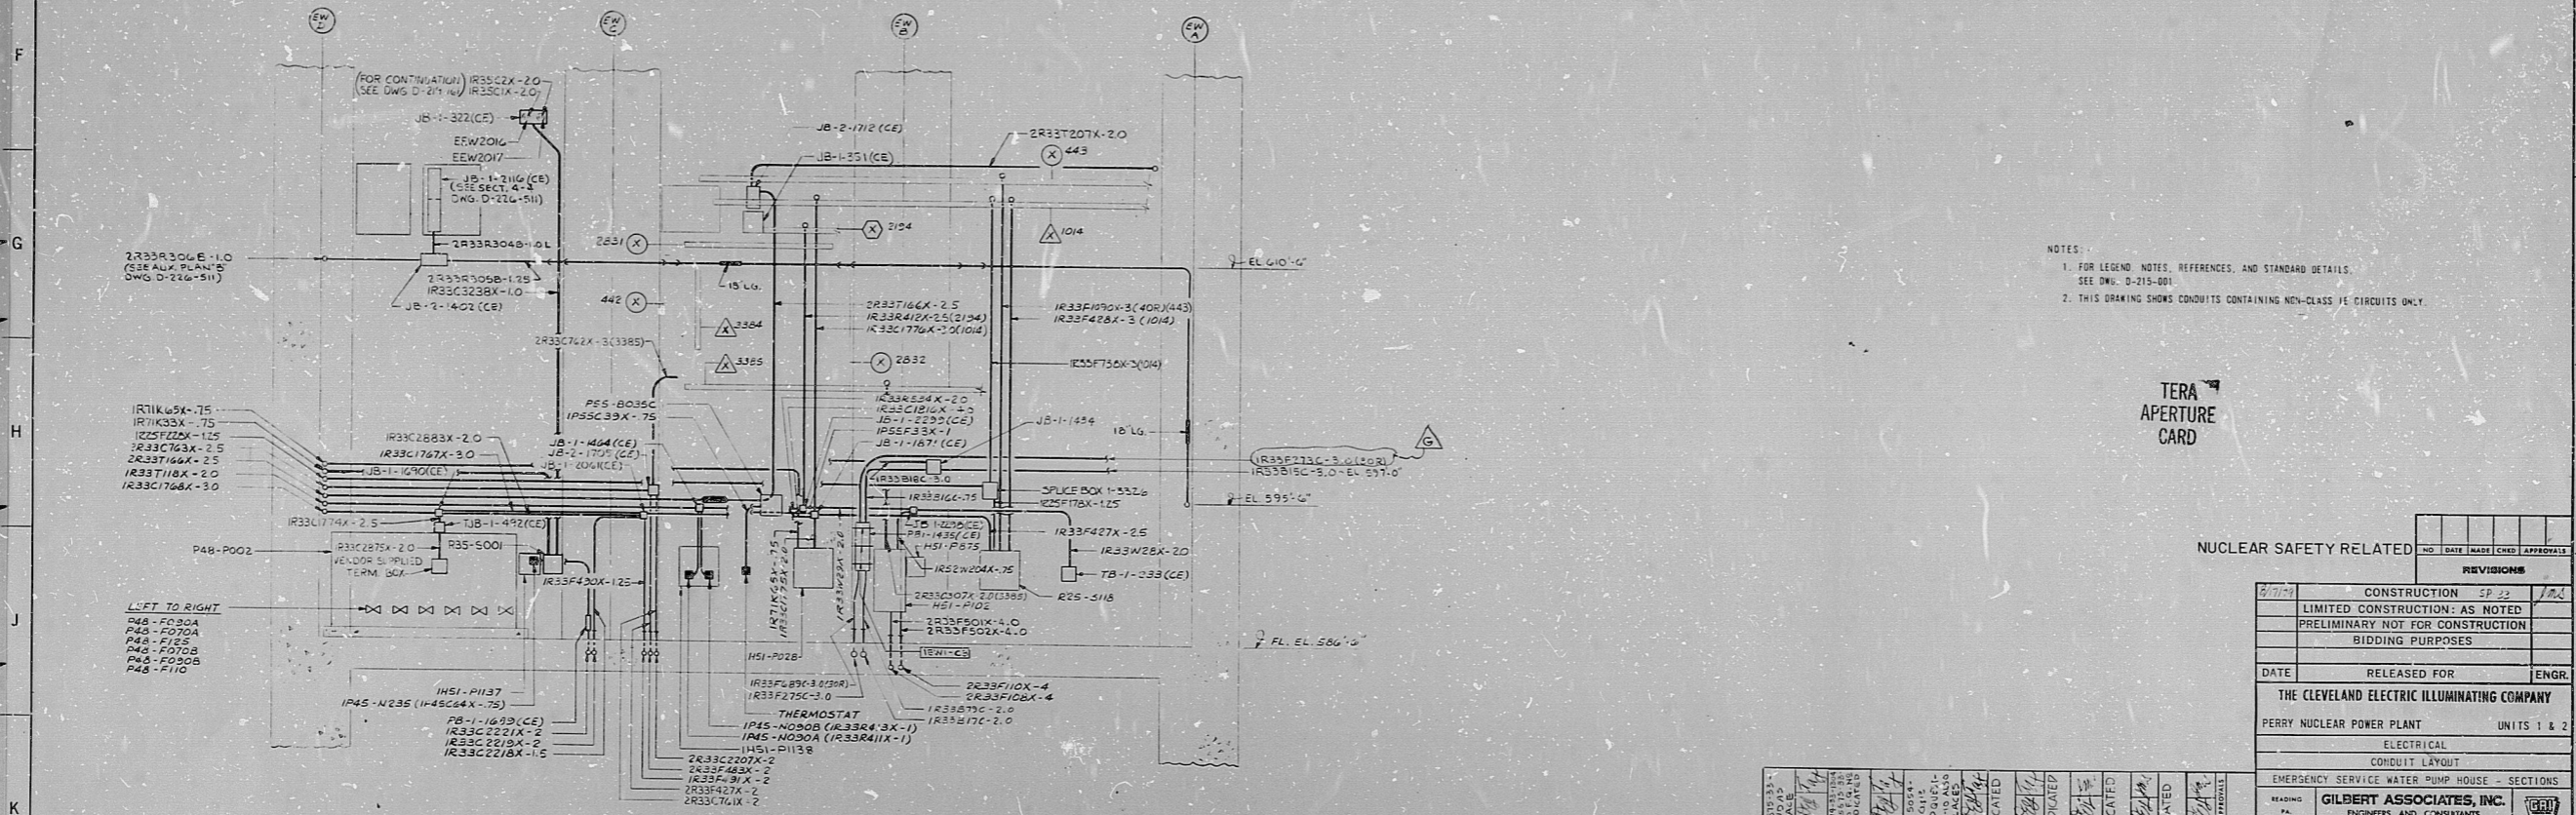

SECTION B-B
(D-226-511)

NOTES:
1. FOR LEGEND, NOTES, REFERENCES, AND STANDARD DETAILS, SEE DWG. D-215-001.
2. THIS DRAWING SHOWS CONDUITS CONTAINING NON-CLASS IFC CIRCUITS ONLY.

TERA
APERTURE
CARD

NUCLEAR SAFETY RELATED

REVISIONS	
NO.	DESCRIPTION
1	CONSTRUCTION
2	LIMITED CONSTRUCTION: AS NOTED
3	PRELIMINARY NOT FOR CONSTRUCTION
4	BIDDING PURPOSES

DATE	RELEASED FOR	ENGR.
	THE CLEVELAND ELECTRIC ILLUMINATING COMPANY	
PERRY NUCLEAR POWER PLANT		UNITS 1 & 2
ELECTRICAL		
CONDUIT LAYOUT		
EMERGENCY SERVICE WATER PUMP HOUSE - SECTIONS		
DESIGNED BY	GILBERT ASSOCIATES, INC.	
CHECKED BY	ENGINEERS AND CONSULTANTS	
SCALE	1/8"=1'-0"	DRAWING NUMBER
PROJECT NO.	04549-000	REV

R:DS

8112040218

