


191-W-9938

SIZE R

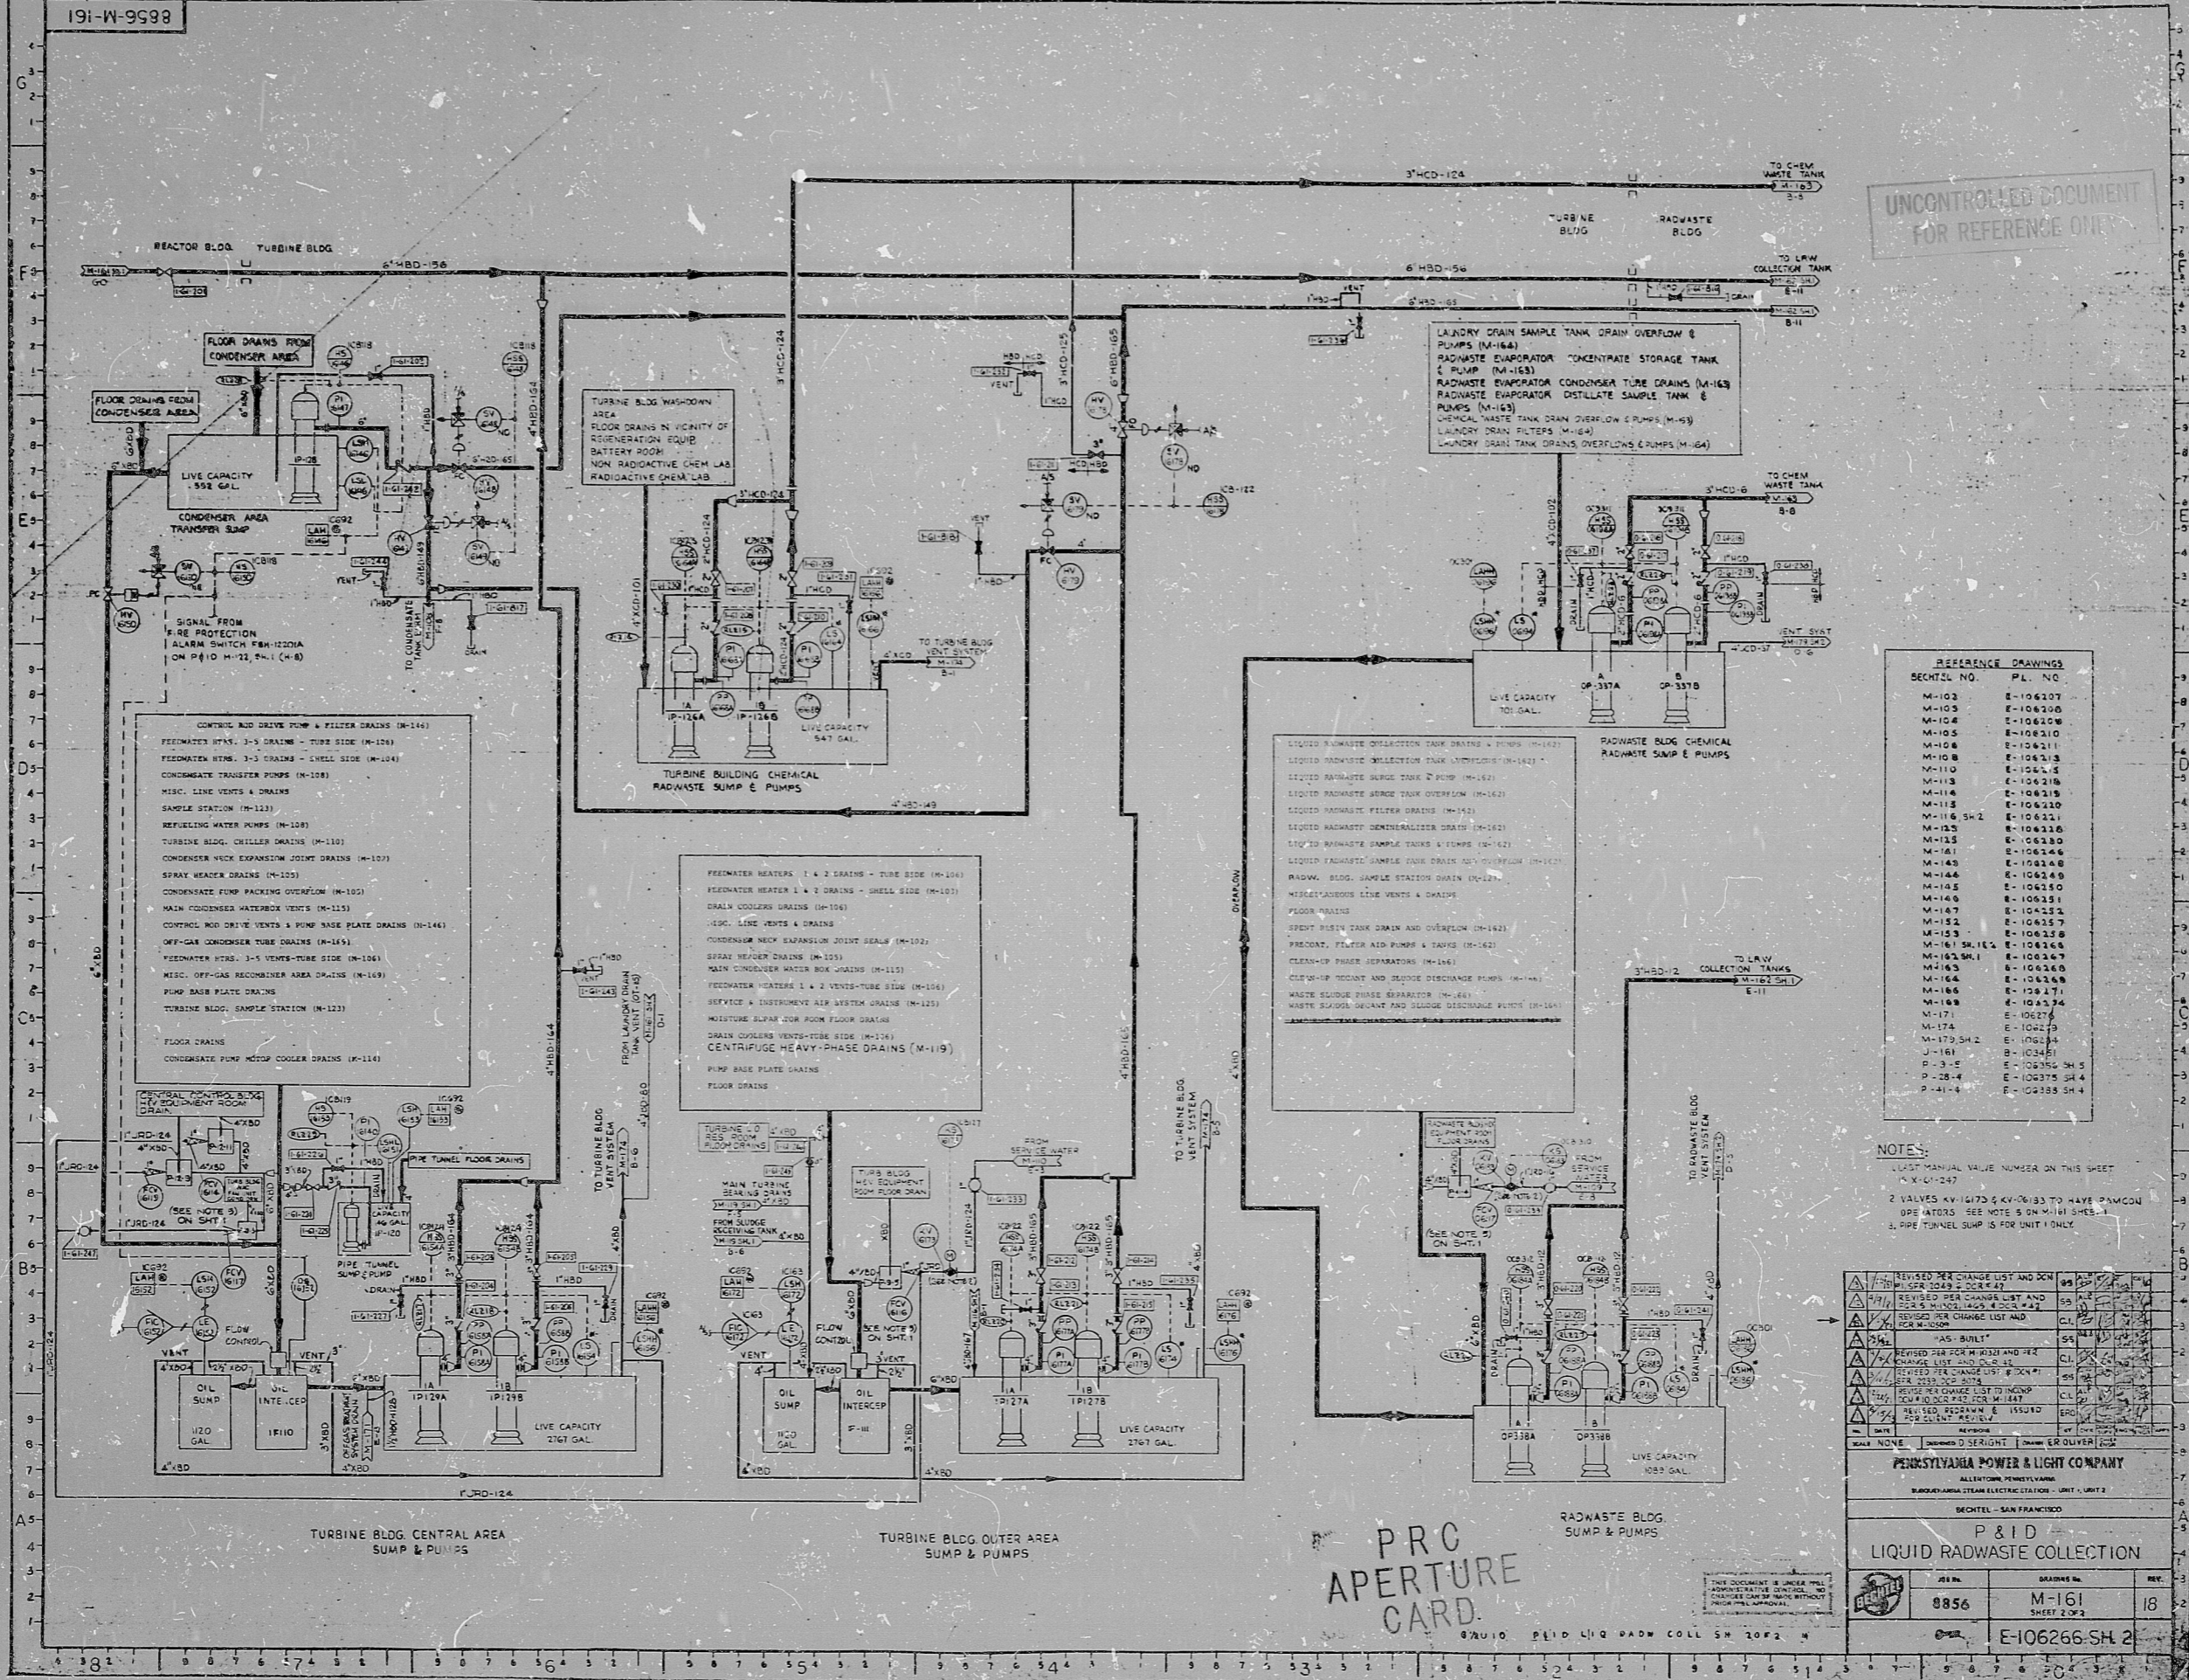

UNCONTROLLED DOCUMENT FOR REFERENCE ONLY

REFERENCE DRAWINGS

SECTION NO.	PL. NO.
M-103	E-106207
M-105	E-106208

NOTES:

LIST MANUAL VALUE NUMBERS ON THIS SHEET
 X-10-247

2 VALVES KV-1273 & KV-0633 TO HAVE RAMCOU OPERATORS SEE NOTE 5 ON M-161 SHEET

3. PIPE TUNNEL SUPP IS FOR UNIT 1 ONLY

REV.	DESCRIPTION	DATE	BY	CHKD.
1	REVISED PER CHANGE LIST AND DCN	10/24/74
2	REVISED PER CHANGE LIST AND DCN	10/24/74
PENNSYLVANIA POWER & LIGHT COMPANY



SECTION - SAN FRANCISCO

P & ID

LIQUID RADWASTE COLLECTION

8856 M-161 18

E-106266-SH 2

PRC APERTURE CARD

30X11


RIDS

805250392

