

POOR ORIGINAL

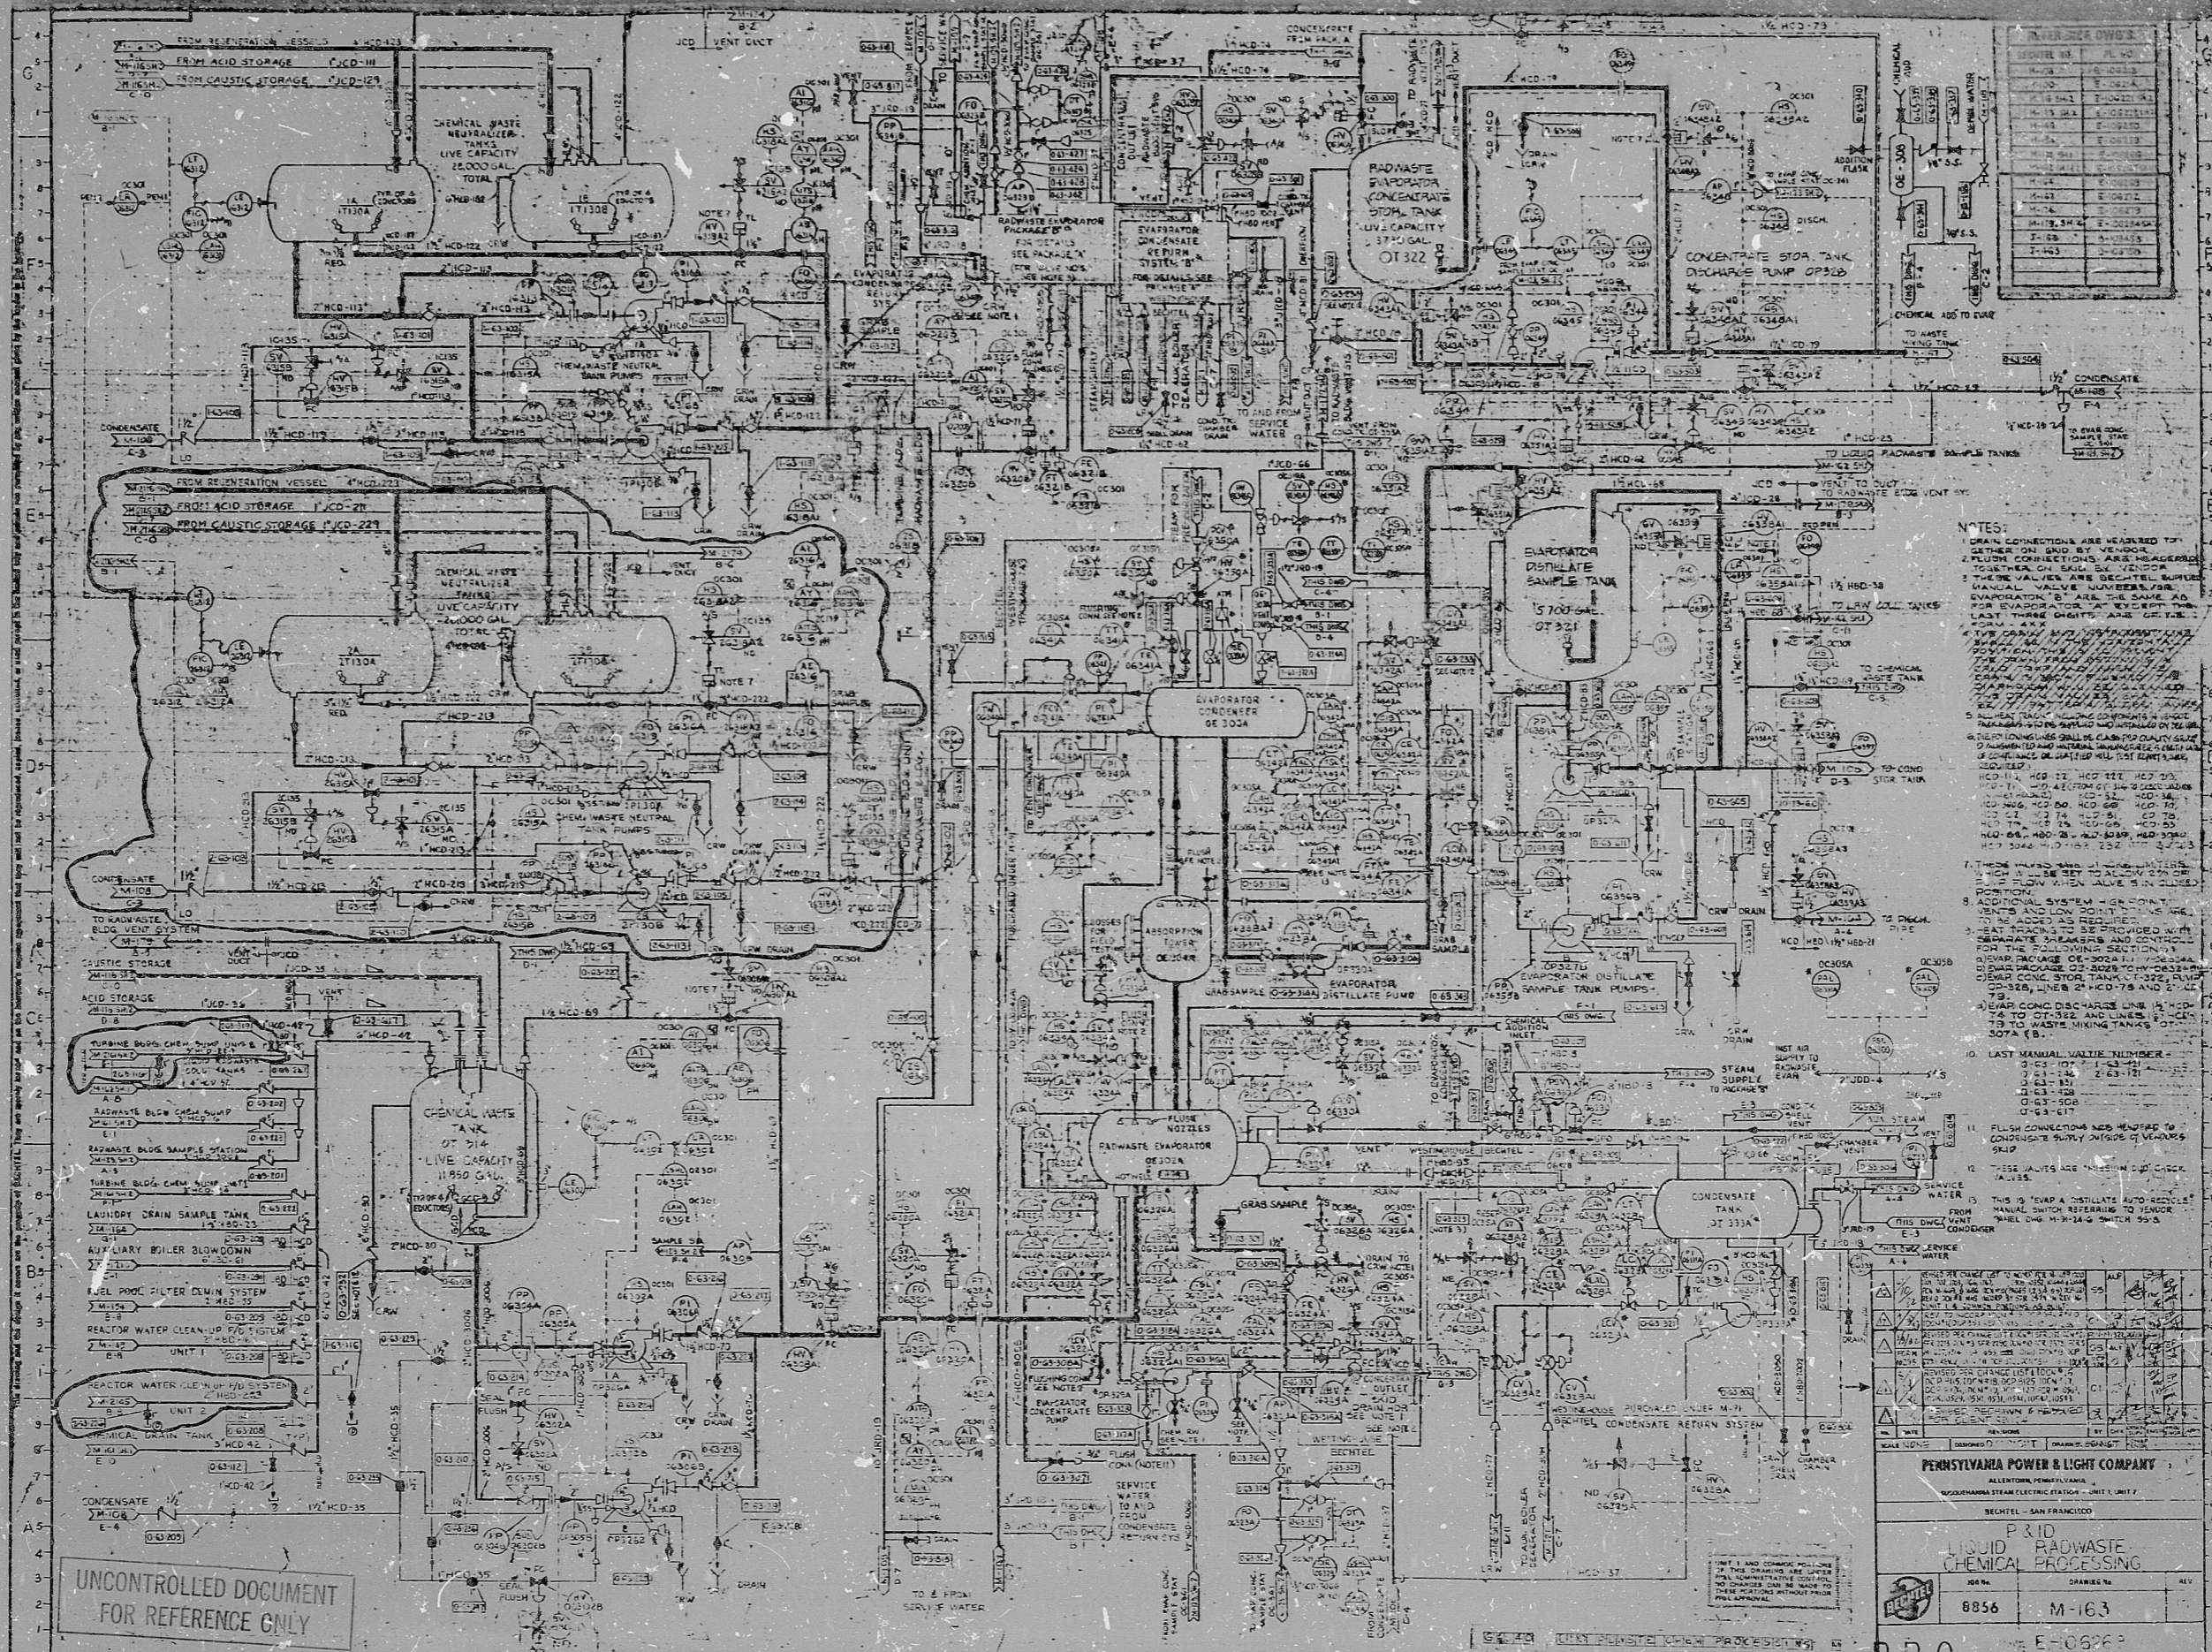





UNCONTROLLED DOCUMENT FOR REFERENCE ONLY


17 8.5 11 17

8.5 11 17

3011

For only that the uncontrolled image contained on this microform was made in the normal and proper course of business. There is no liability for copyright infringement...

APERTURE CARD

RIDS

8305250410

