

14

13

12

11

10

9

8

7

6


5

4

3

2

1

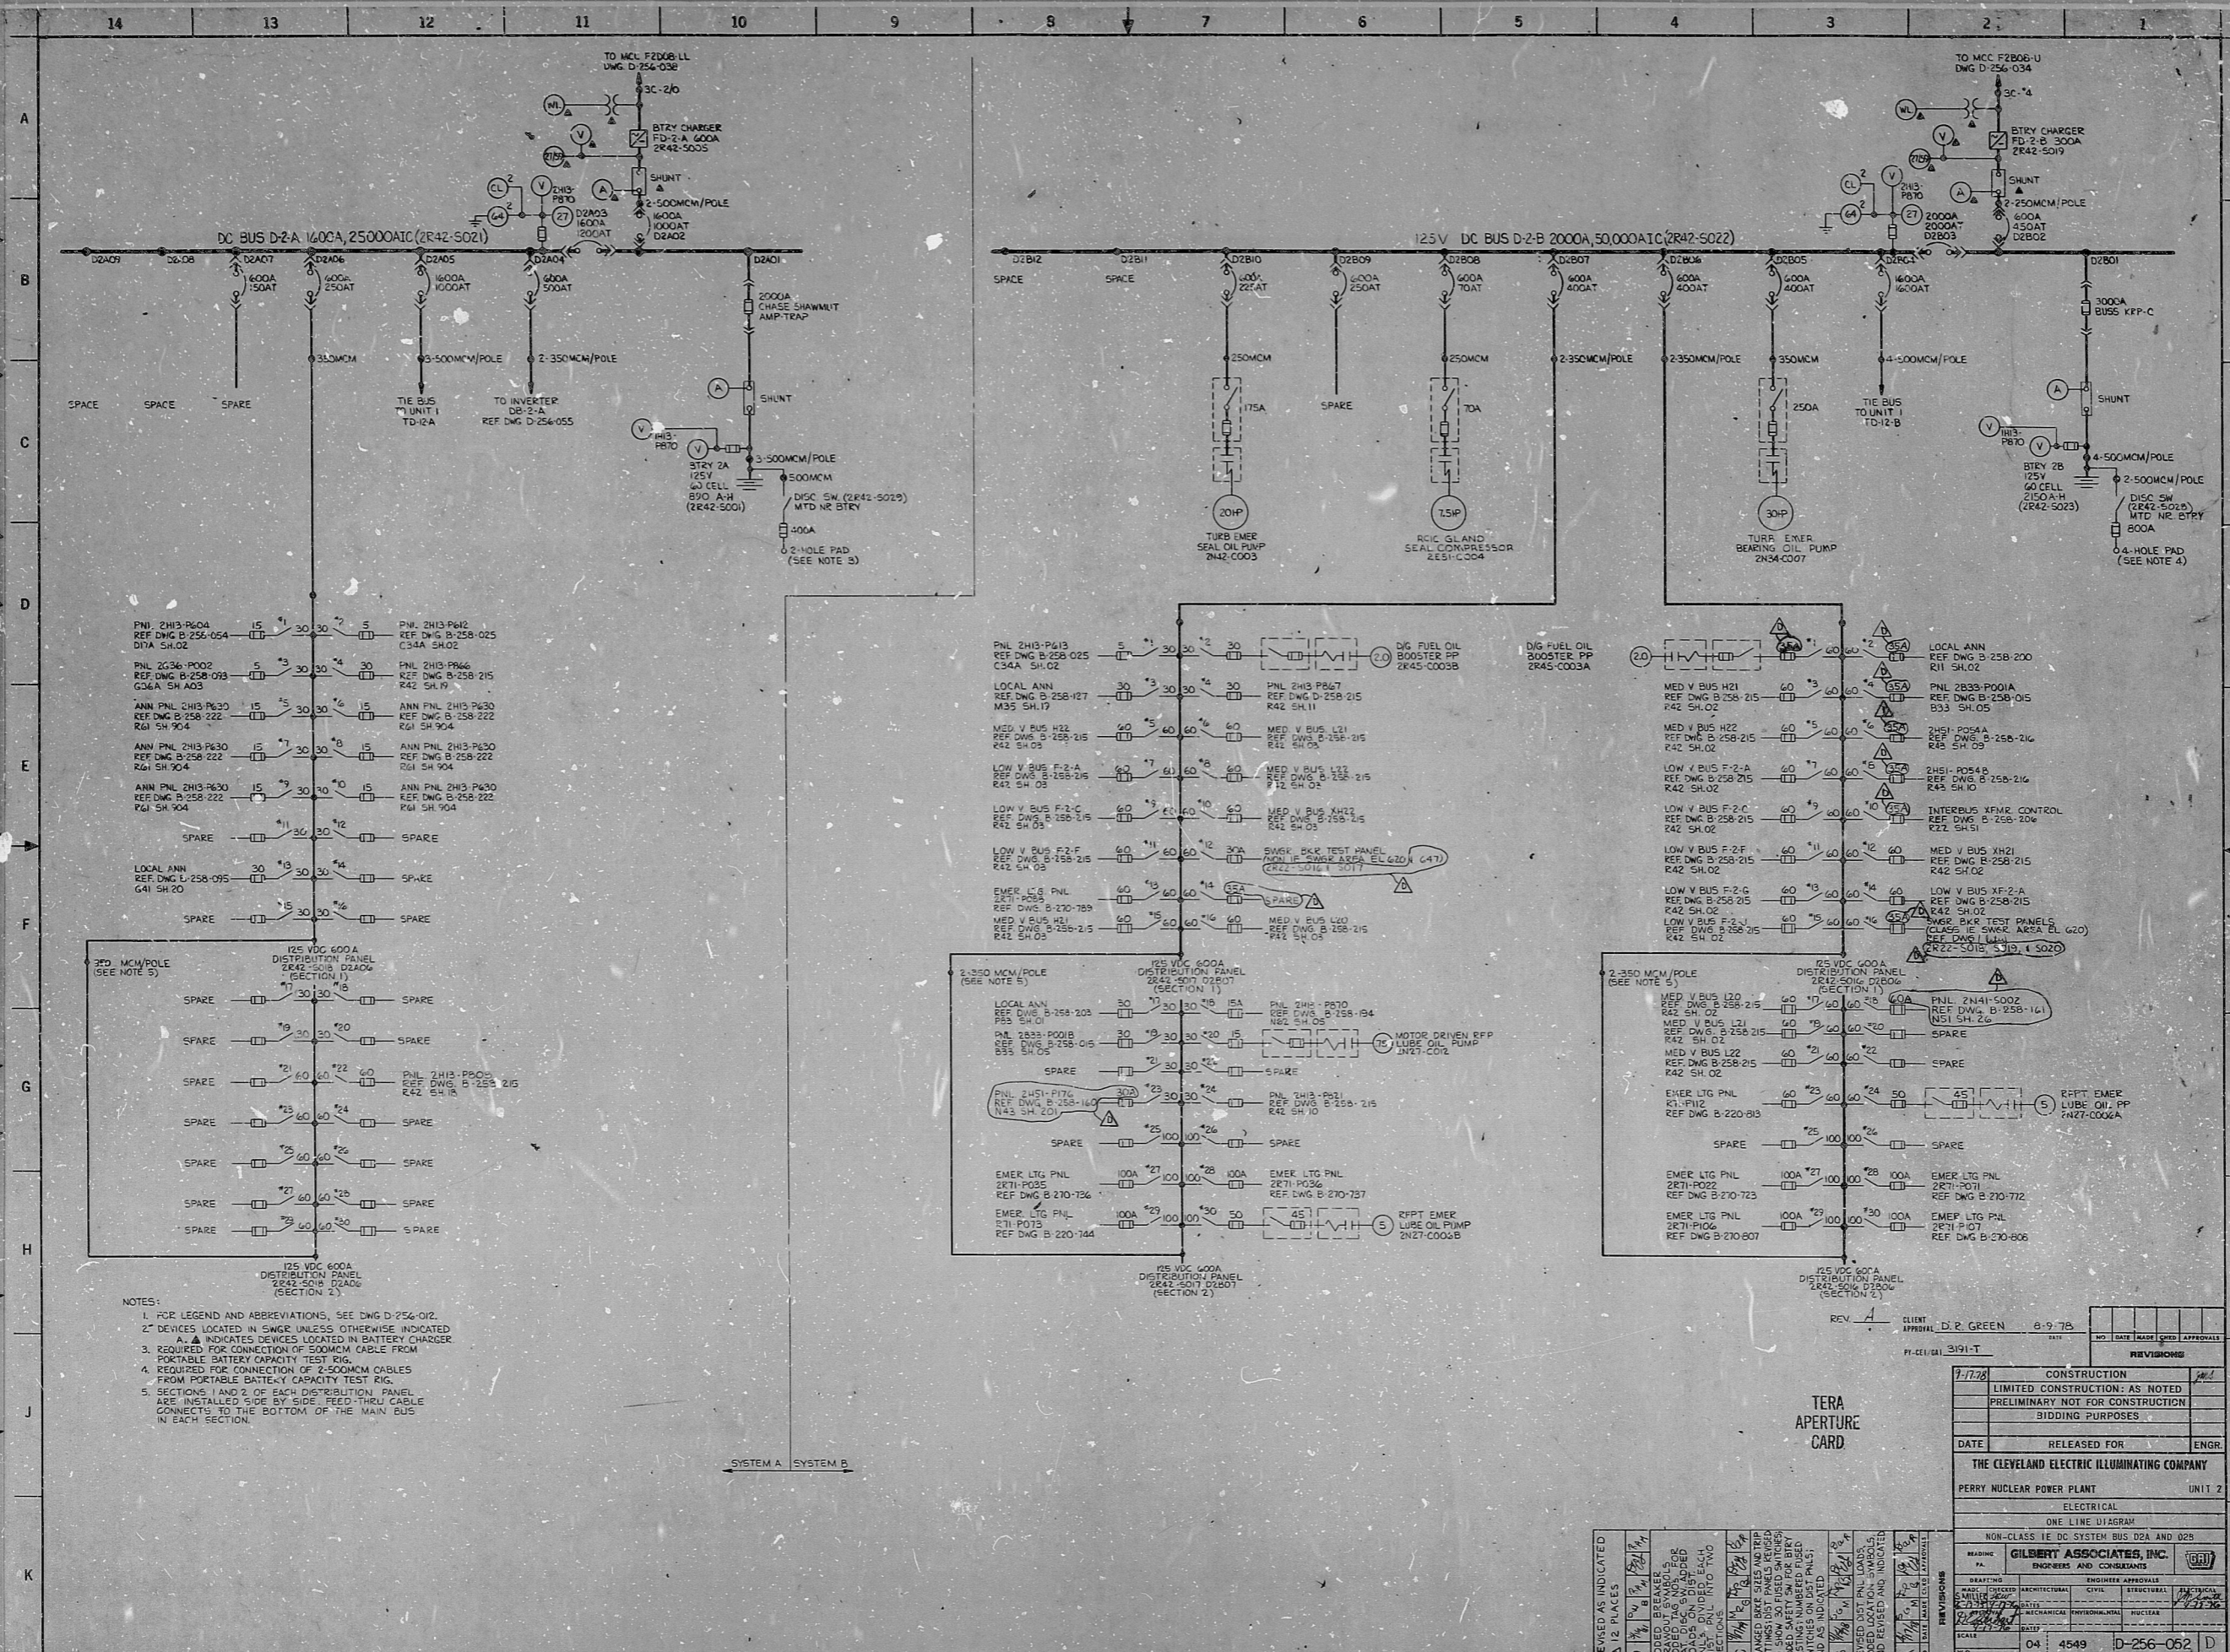

- NOTES:
- FOR LEGEND AND ABBREVIATIONS, SEE DWG D-256-012.
  - DEVICES LOCATED IN SWGR UNLESS OTHERWISE INDICATED.
  - A INDICATES DEVICES LOCATED IN BATTERY CHARGER.
  - REQUIRED FOR CONNECTION OF 5000MVA CABLES FROM PORTABLE BATTERY CAPACITY TEST RIG.
  - REQUIRED FOR CONNECTION OF 2-500MVA CABLES FROM PORTABLE BATTERY CAPACITY TEST RIG.
  - SECTIONS 1 AND 2 OF EACH DISTRIBUTION PANEL ARE INSTALLED SIDE BY SIDE. FEED THRU CABLE CONNECTS TO THE BOTTOM OF THE MAIN BUS IN EACH SECTION.

REV A CLIENT: D.P. GREEN 8-9-75  
 APPROVAL: [Signature] DATE: 8/9/75

NO.	DATE	BY	APPROVAL
1-1778			

CONSTRUCTION  
 LIMITED CONSTRUCTION: AS NOTED  
 PRELIMINARY NOT FOR CONSTRUCTION  
 BIDDING PURPOSES

DATE RELEASED FOR ENGR:  
 THE CLEVELAND ELECTRIC ILLUMINATING COMPANY  
 PERRY NUCLEAR POWER PLANT UNIT 2  
 ELECTRICAL  
 ONE LINE DIAGRAM  
 NON-CLASS I E DC SYSTEM BUS D2A AND D2B

REVISIONS	ENGINEER APPROVALS
1	
2	
34"

34"

RIDS

8112040228

