


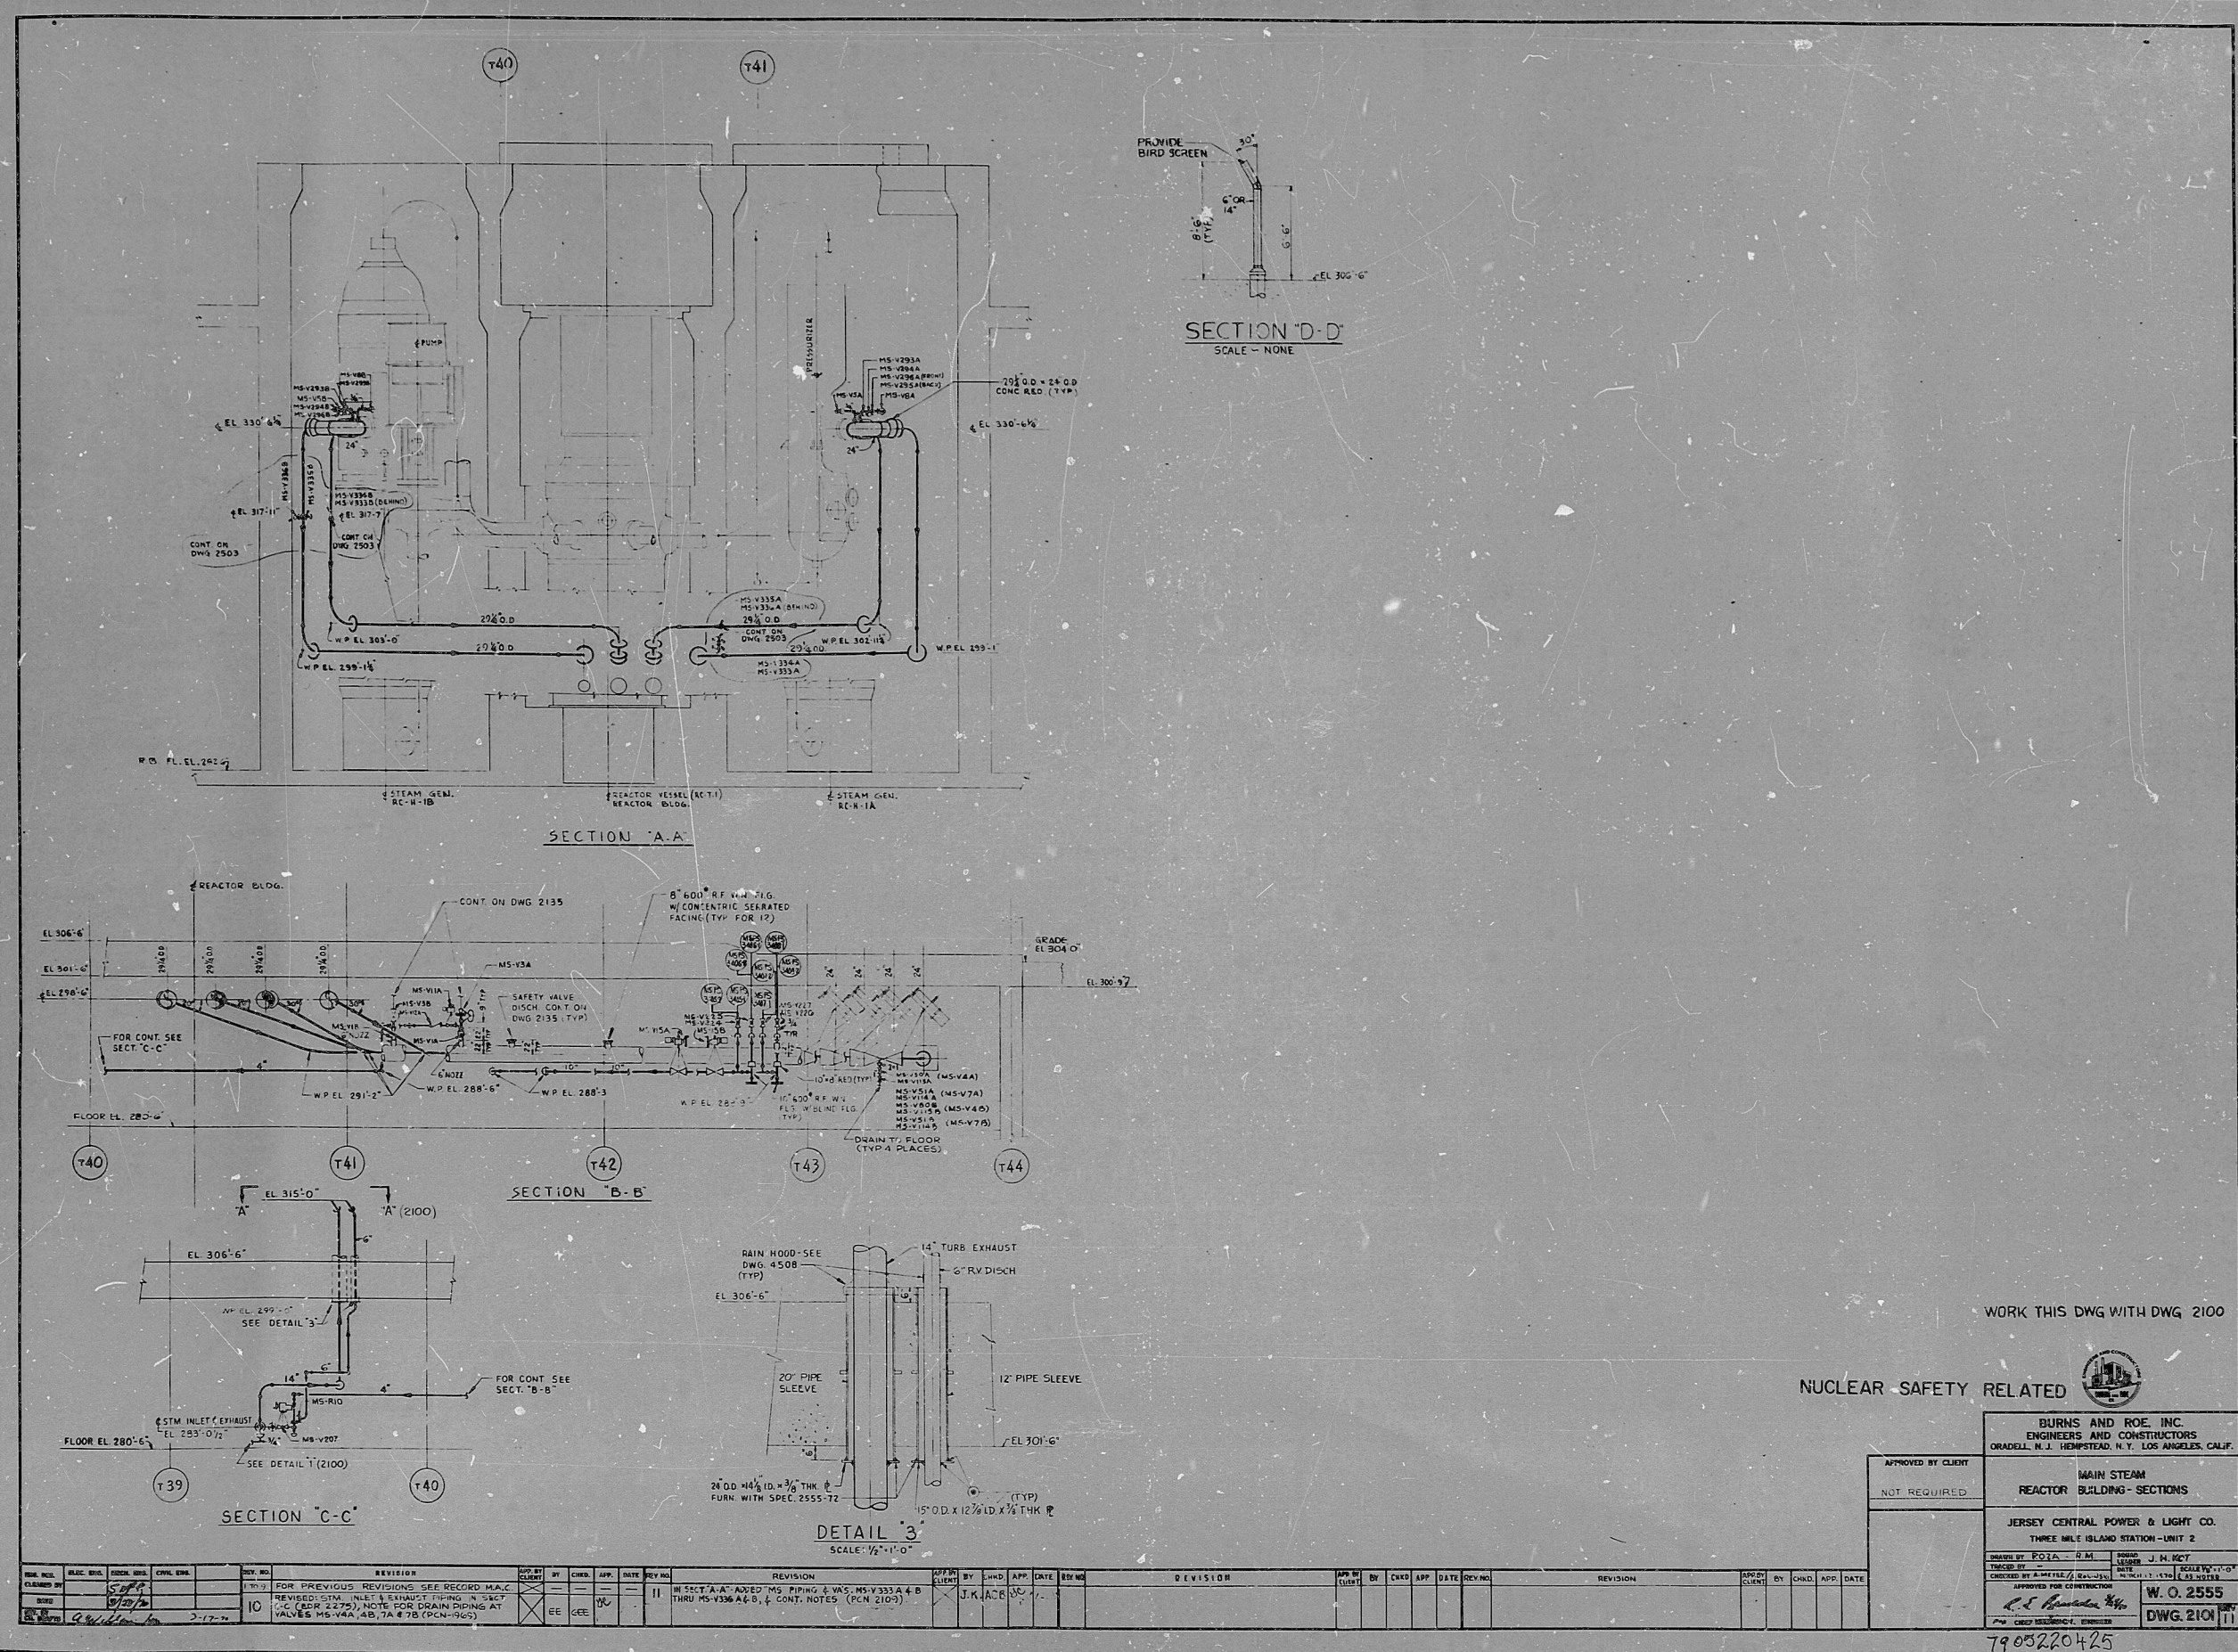

WORK THIS DWG WITH DWG 2100

NUCLEAR SAFETY RELATED



BURNS AND ROE, INC.
ENGINEERS AND CONSTRUCTORS
ORADELL, N. J. HEMPSTEAD, N. Y. LOS ANGELES, CALIF.

MAIN STEAM
REACTOR BUILDING - SECTIONS

JERSEY CENTRAL POWER & LIGHT CO.
THREE MILE ISLAND STATION-UNIT 2

DRAWN BY POZA - G.M. REPROD. LEADER J. H. KAY
TRACED BY
CHECKED BY A. MYTEL / BAL. J. S. 11/10/54
APPROVED FOR CONSTRUCTION
W. O. 2555
DWG. 2101

7905220425

PDR

7905220425

