



E-OR3221

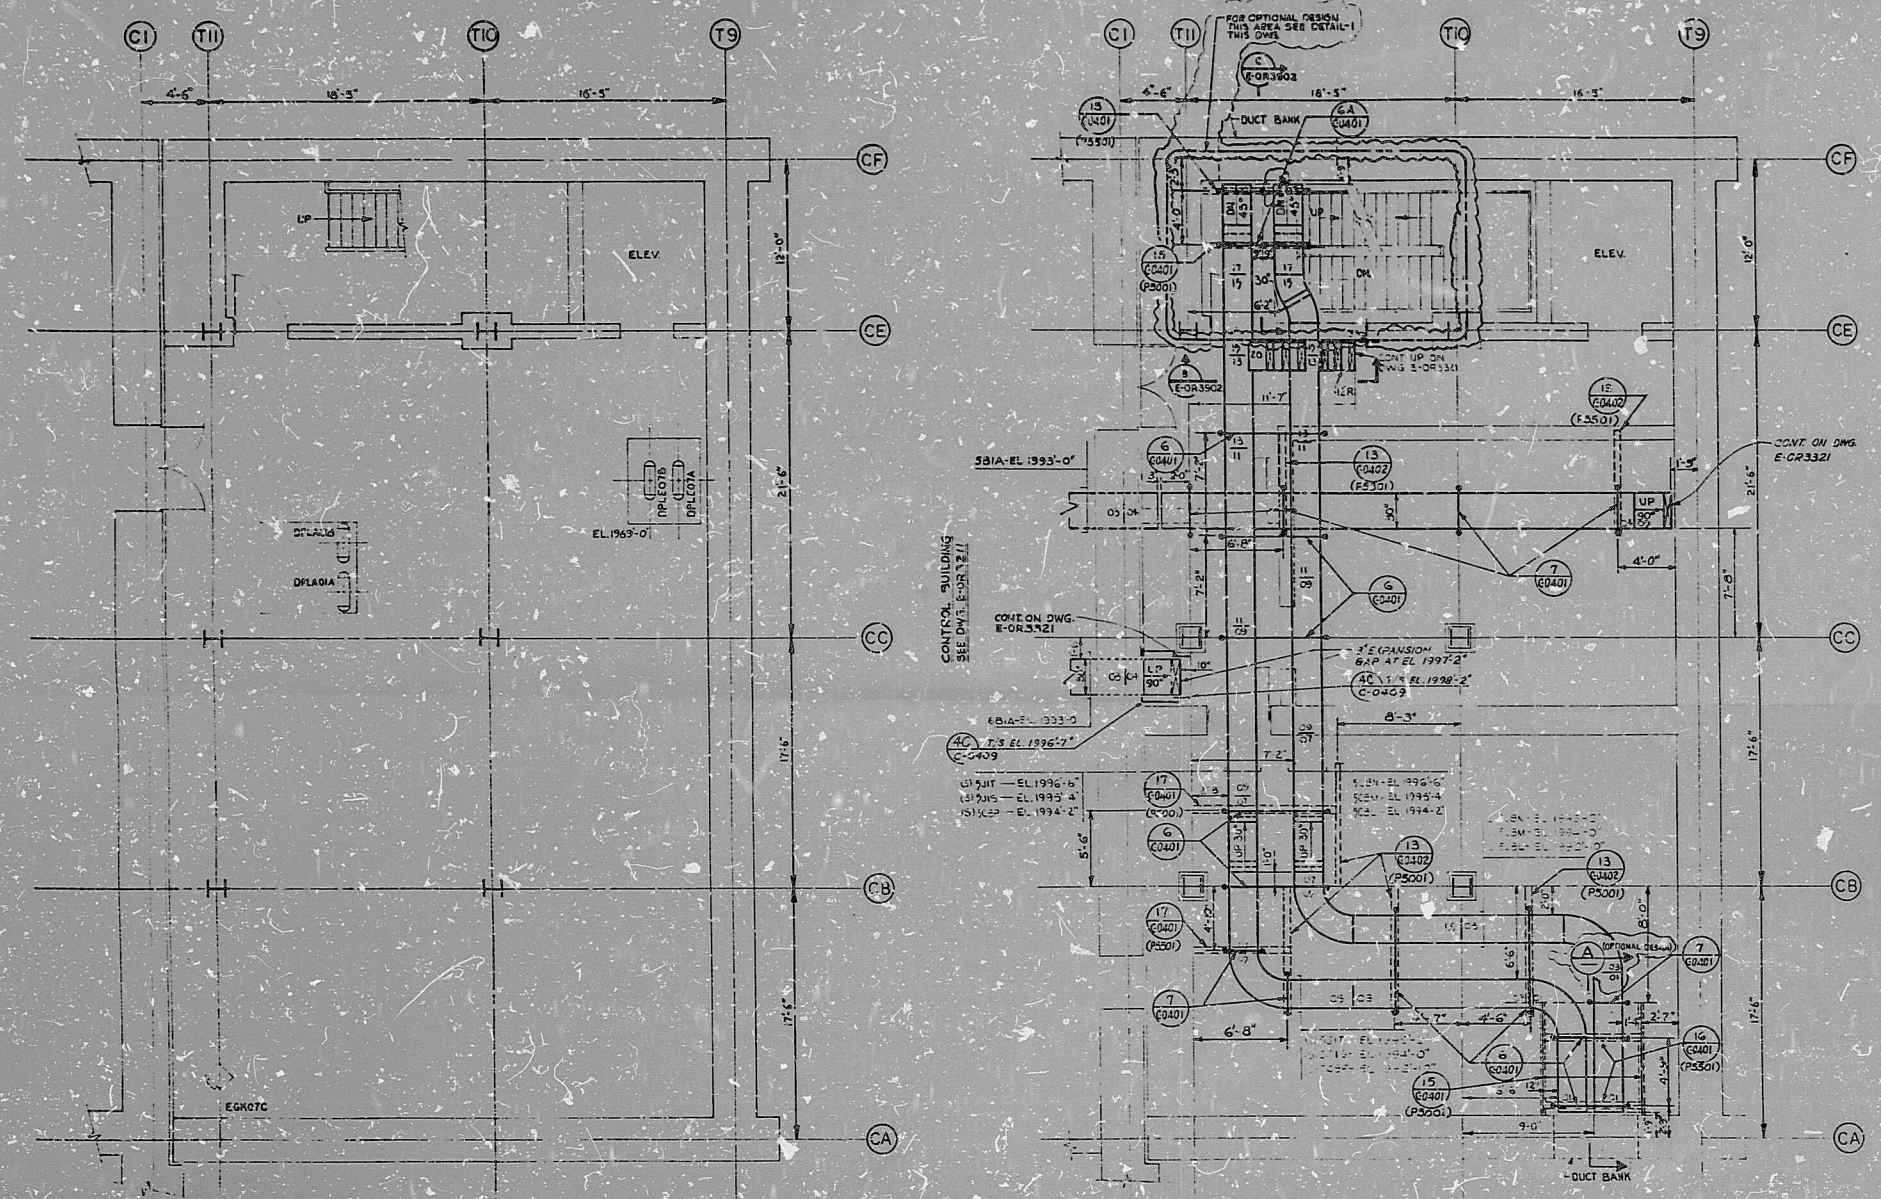



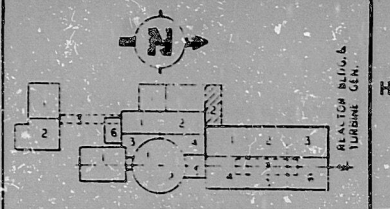

REACTOR BLDG.
 KEY PLAN
 REFERENCE DRAWINGS
 E-OR3221 RACEWAY NOTES, SYMBOLS AND DETAILS
 E-OR3221 RACEWAY PLAN COMM. CORRIDOR AREA-2 EL. 2000'-0"
 C-0401 CIVIL STRUCTURAL CABLE TRAY SUPPORTS SHIT. NO. 1
 C-0402 CIVIL STRUCTURAL CABLE TRAY SUPPORTS SHIT. NO. 2


NOTES
 1. ALL CABLE TRAYS ARE 24" WIDE AND ALL TRAY FITTINGS SHALL HAVE A 24" RADIUS UNLESS OTHERWISE NOTED.
 2. ALL CABLE TRAYS ARE 3" HIGH.
 3. FOR TRAY SUPPORT MATERIALS SEE ELECTRICAL SPECIFICATION NO. 10.10466-E-037.

TI
 APERTURE
 CARD

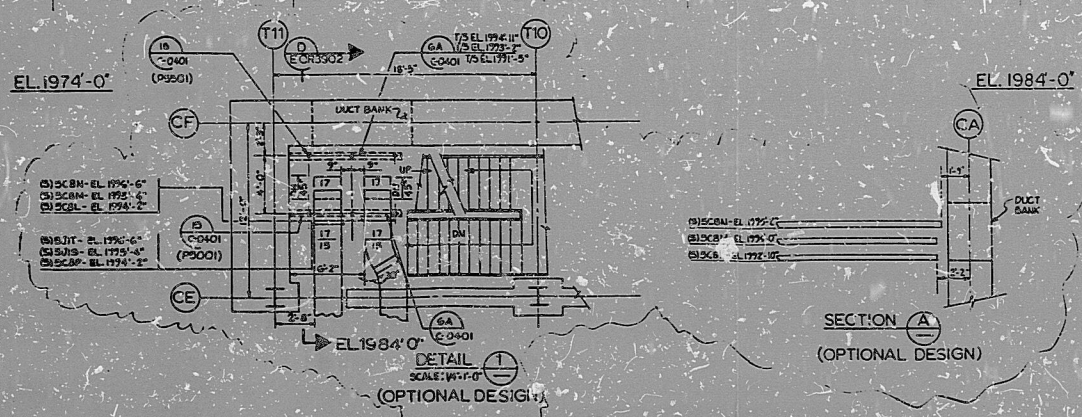

COORDINATION FOR DESIGN OFF

DESIGN	7	8
BLDG.	N/R	N/E
MECH.	N/R	N/E
ELECT.	N/R	N/E
PLUMB.	N/R	N/E
HAZAR.	N/R	N/E
INDUS.	N/R	N/E
OTHER	N/R	N/E

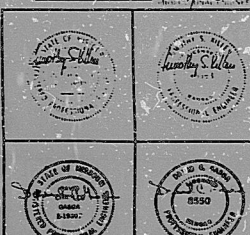

NO.	DESCRIPTION	DATE	BY	CHECKED
1	ISSUED FOR CONSTRUCTION	7/31/75	JEM/AMG	G. J.

BECHTEL
 BATHINGEN, MARYLAND
 SNUPPS
 RACEWAY PLAN
 COMMUNICATION CORRIDOR
 AREA-2 EL. 1974'-0" & EL. 1984'-0"
 10466 E-OR3221
 SITE AE RELATED

8410050/35

PDR RIDS

