

INFORMATION
THIS DOCUMENT IS
SUBJECT TO REVISION
WITHOUT NOTIFICATION
TO THE USER-IF THIS
COPY


TERA
APERTURE
CARD

- NOTES:
1. TYPE L ONE TEE WITH A PLUS EVERY 40 FT. AFTER HEADER ISOLATION VALVE UNLESS NOT PRACTICAL. MINIMUM OF ONE TEE WITH VALVE IN EACH ROOM LESS THAN 400 SQ. FT. AND TWO TEES WITH VALVES IN EACH ROOM 400 SQ. FT. OR LARGER.
 2. INSTRUMENT AIR DROPS WILL BE NORMALLY GREEN WHEN PIPED FOR USE TO AN INSTRUMENT.
 3. PIPING VALVES AND COMPONENTS IDENTIFIED AS SAFETY CLASS 1, 2, OR 3 ARE SEISMICALLY DESIGNED. CLASS 7, 8, OR 9 ITEMS ARE NON-SEISMICALLY DESIGNED.
 4. HYDRO VENTS AND DRAINS TO BE LOCATED ON FAB ISO'S ONLY.

NO.	DATE	DESCRIPTION	BY	CHKD.	APP'D.
1	11/20/78	CIRCLED AREAS INDICATE LATEST REVISION			
2	11/20/78	FIRST ISSUE			

Brown & Root, Inc. <small>Engineers, Constructors HOUSTON, TEXAS</small>		PKG. NO. 052 SUFF. 102 CONTRACT NO. CR-0241 SCALE NTS DRAWING NO. 8211 1-F-5050-B
SOUTH TEXAS PROJECT PIPING DIAGRAM MECHANICAL AUX. BUILDING INSTRUMENT AIR SHEET 2 OF 3		<input type="checkbox"/> INFORMATION <input type="checkbox"/> PRELIMINARY <input type="checkbox"/> REVIEW <input checked="" type="checkbox"/> USE <input type="checkbox"/> CONSTRUCTION

BROWN & ROOT, INC.
 MICROFILM SERVICES
 THURSDAY, NOV. 01 1978

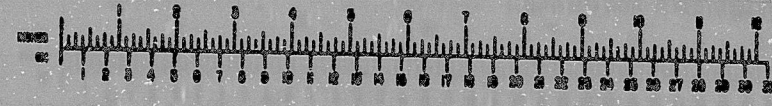

RIDS

812040656

