


INFORMATION
THIS DOCUMENT IS
SUBJECT TO REVISION
WITHOUT NOTIFICATION
TO THE USER OF THIS
COPY

- NOTES:
1. TEMPORARY CONNECTION TO BLIND FLANGE MADE ONLY DURING RHDS OPERATIONS.
 2. PIPING, VALVES, AND COMPONENTS IDENTIFIED AS SAFETY CLASS 1, 2 OR 3 ARE SEISMICALLY DESIGNED, CLASS 7, 8 OR 9 ITEMS ARE NON-SEISMICALLY DESIGNED.
 3. HYDRO VENTS AND DRAINS TO BE LOCATED ON FAB ISDS ONLY.
 4. THE GAS STORAGE TANK SUPPORTS ARE SEISMIC CATEGORY 1. ALL OTHER COMPONENTS ARE NON-SEISMIC.
 5. INTERCONNECTING PIPING SUPPLIED BY DEGASSING PACKAGE SUPPLIER.

TERA
APERTURE
CARD

<p>C CIRCLED AREAS INDICATE LATEST REVISION</p> <p>A CIRCLED AREAS INDICATE LATEST REVISION</p>		<p>PKG NO 057 SUFF 102</p> <p>SOUTH TEXAS PROJECT</p> <p>PIPING DIAGRAM</p> <p>REACTOR HEAD DEGASSING SYSTEM</p> <p>SHEET NO 1 OF 1</p>		<p>CONTRACT NO. SCALE</p> <p>CR-0241 NTS</p> <p>DRAWING NO. 5R-34</p> <p>IF-5046-C</p>	
---	--	---	--	--	--

Brown & Root Inc.
MICROFILM SERVICES

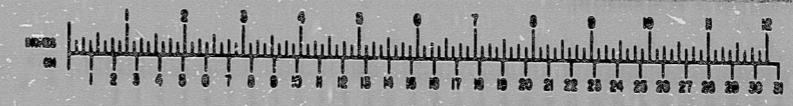

THURSDAY, DEC. 31 1978

INFORMATION PRELIMINARY REVIEW USE CONSTRUCTION

RIDS

812040660

