


50-320

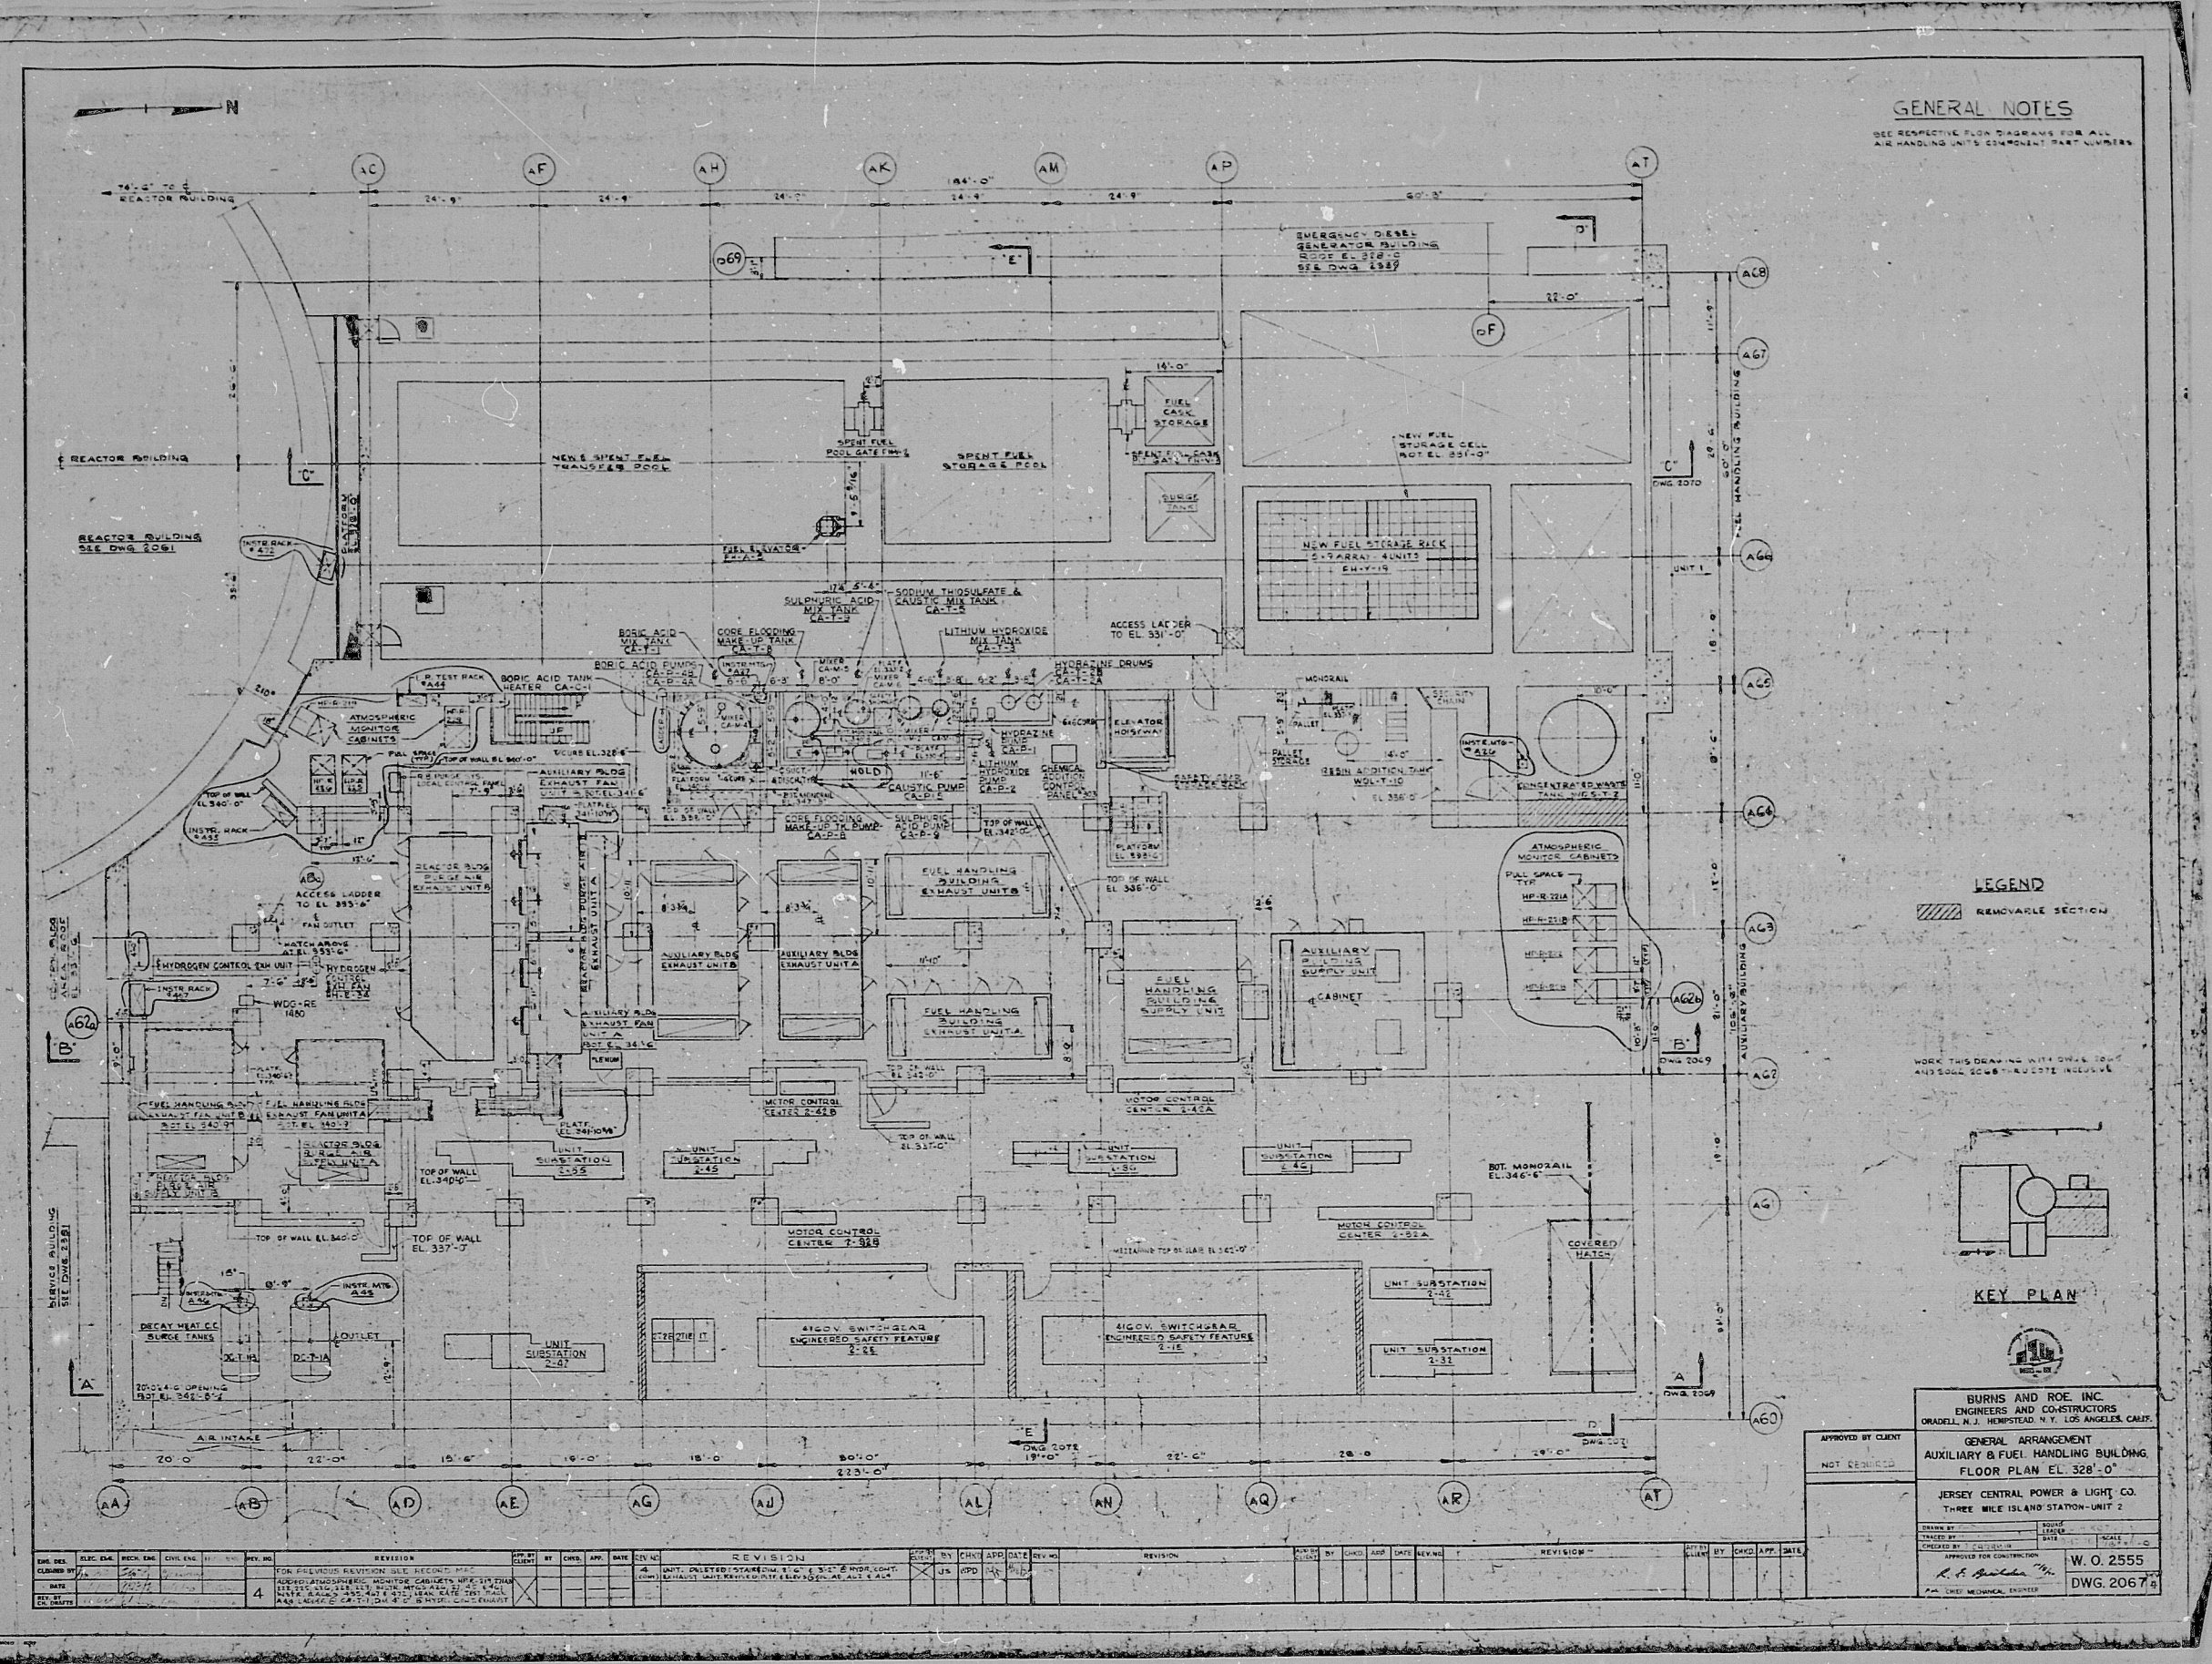

7906070154

PDR

7906070154

7906070154

