

INFORMATION
THIS DOCUMENT IS
SUBJECT TO REVISION
WITHOUT NOTIFICATION
TO THE USER OF THIS
COPY

- NOTES:
1. THE TERM 'ALTERNATOR' REFERS TO THE LEVEL SWITCH IT IS ASSOCIATED WITH.
 2. TEST CONNECTIONS ATTACHED TO BOTTOM OF PIPING TO FACILITATE DRAINING OF LINES.
 3. PIPING, VALVES, AND COMPONENTS IDENTIFIED AS SAFETY CLASS 1, 2, OR 3 ARE SEISMICALLY DESIGNED. CLASS 2, 3, OR 3 ITEMS ARE NOW SEISMICALLY DESIGNED.
 4. HYDRO VENTS AND DRAINS TO BE LOCATED ON FAB ISO'S ONLY.

TERA
APERTURE
CARD

2	10/27/79	CIRCLED AREAS INDICATE LATEST REVISION
3	10/27/79	CIRCLED AREAS INDICATE LATEST REVISION
Brown & Root, Inc.

SOUTH TEXAS PROJECT

CONTRACT NO. **CR-0241** SCALE **NONE**


PIPING DIAGRAM

EQUIPMENT & FLOOR DRAIN PUMPS

DRAWING NO. **52-06**

HF-5030-E

INFORMATION PRELIMINARY REVISION USE CONSTRUCTION

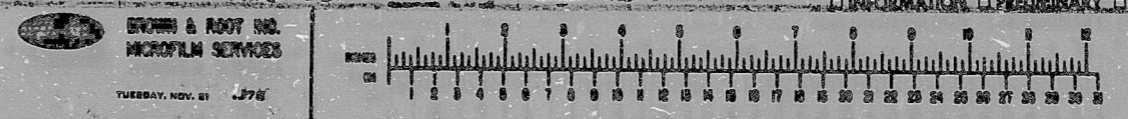

RIDS

812070042

