


681-W-9598

UNCONTROLLED DOCUMENT
FOR REFERENCE ONLY

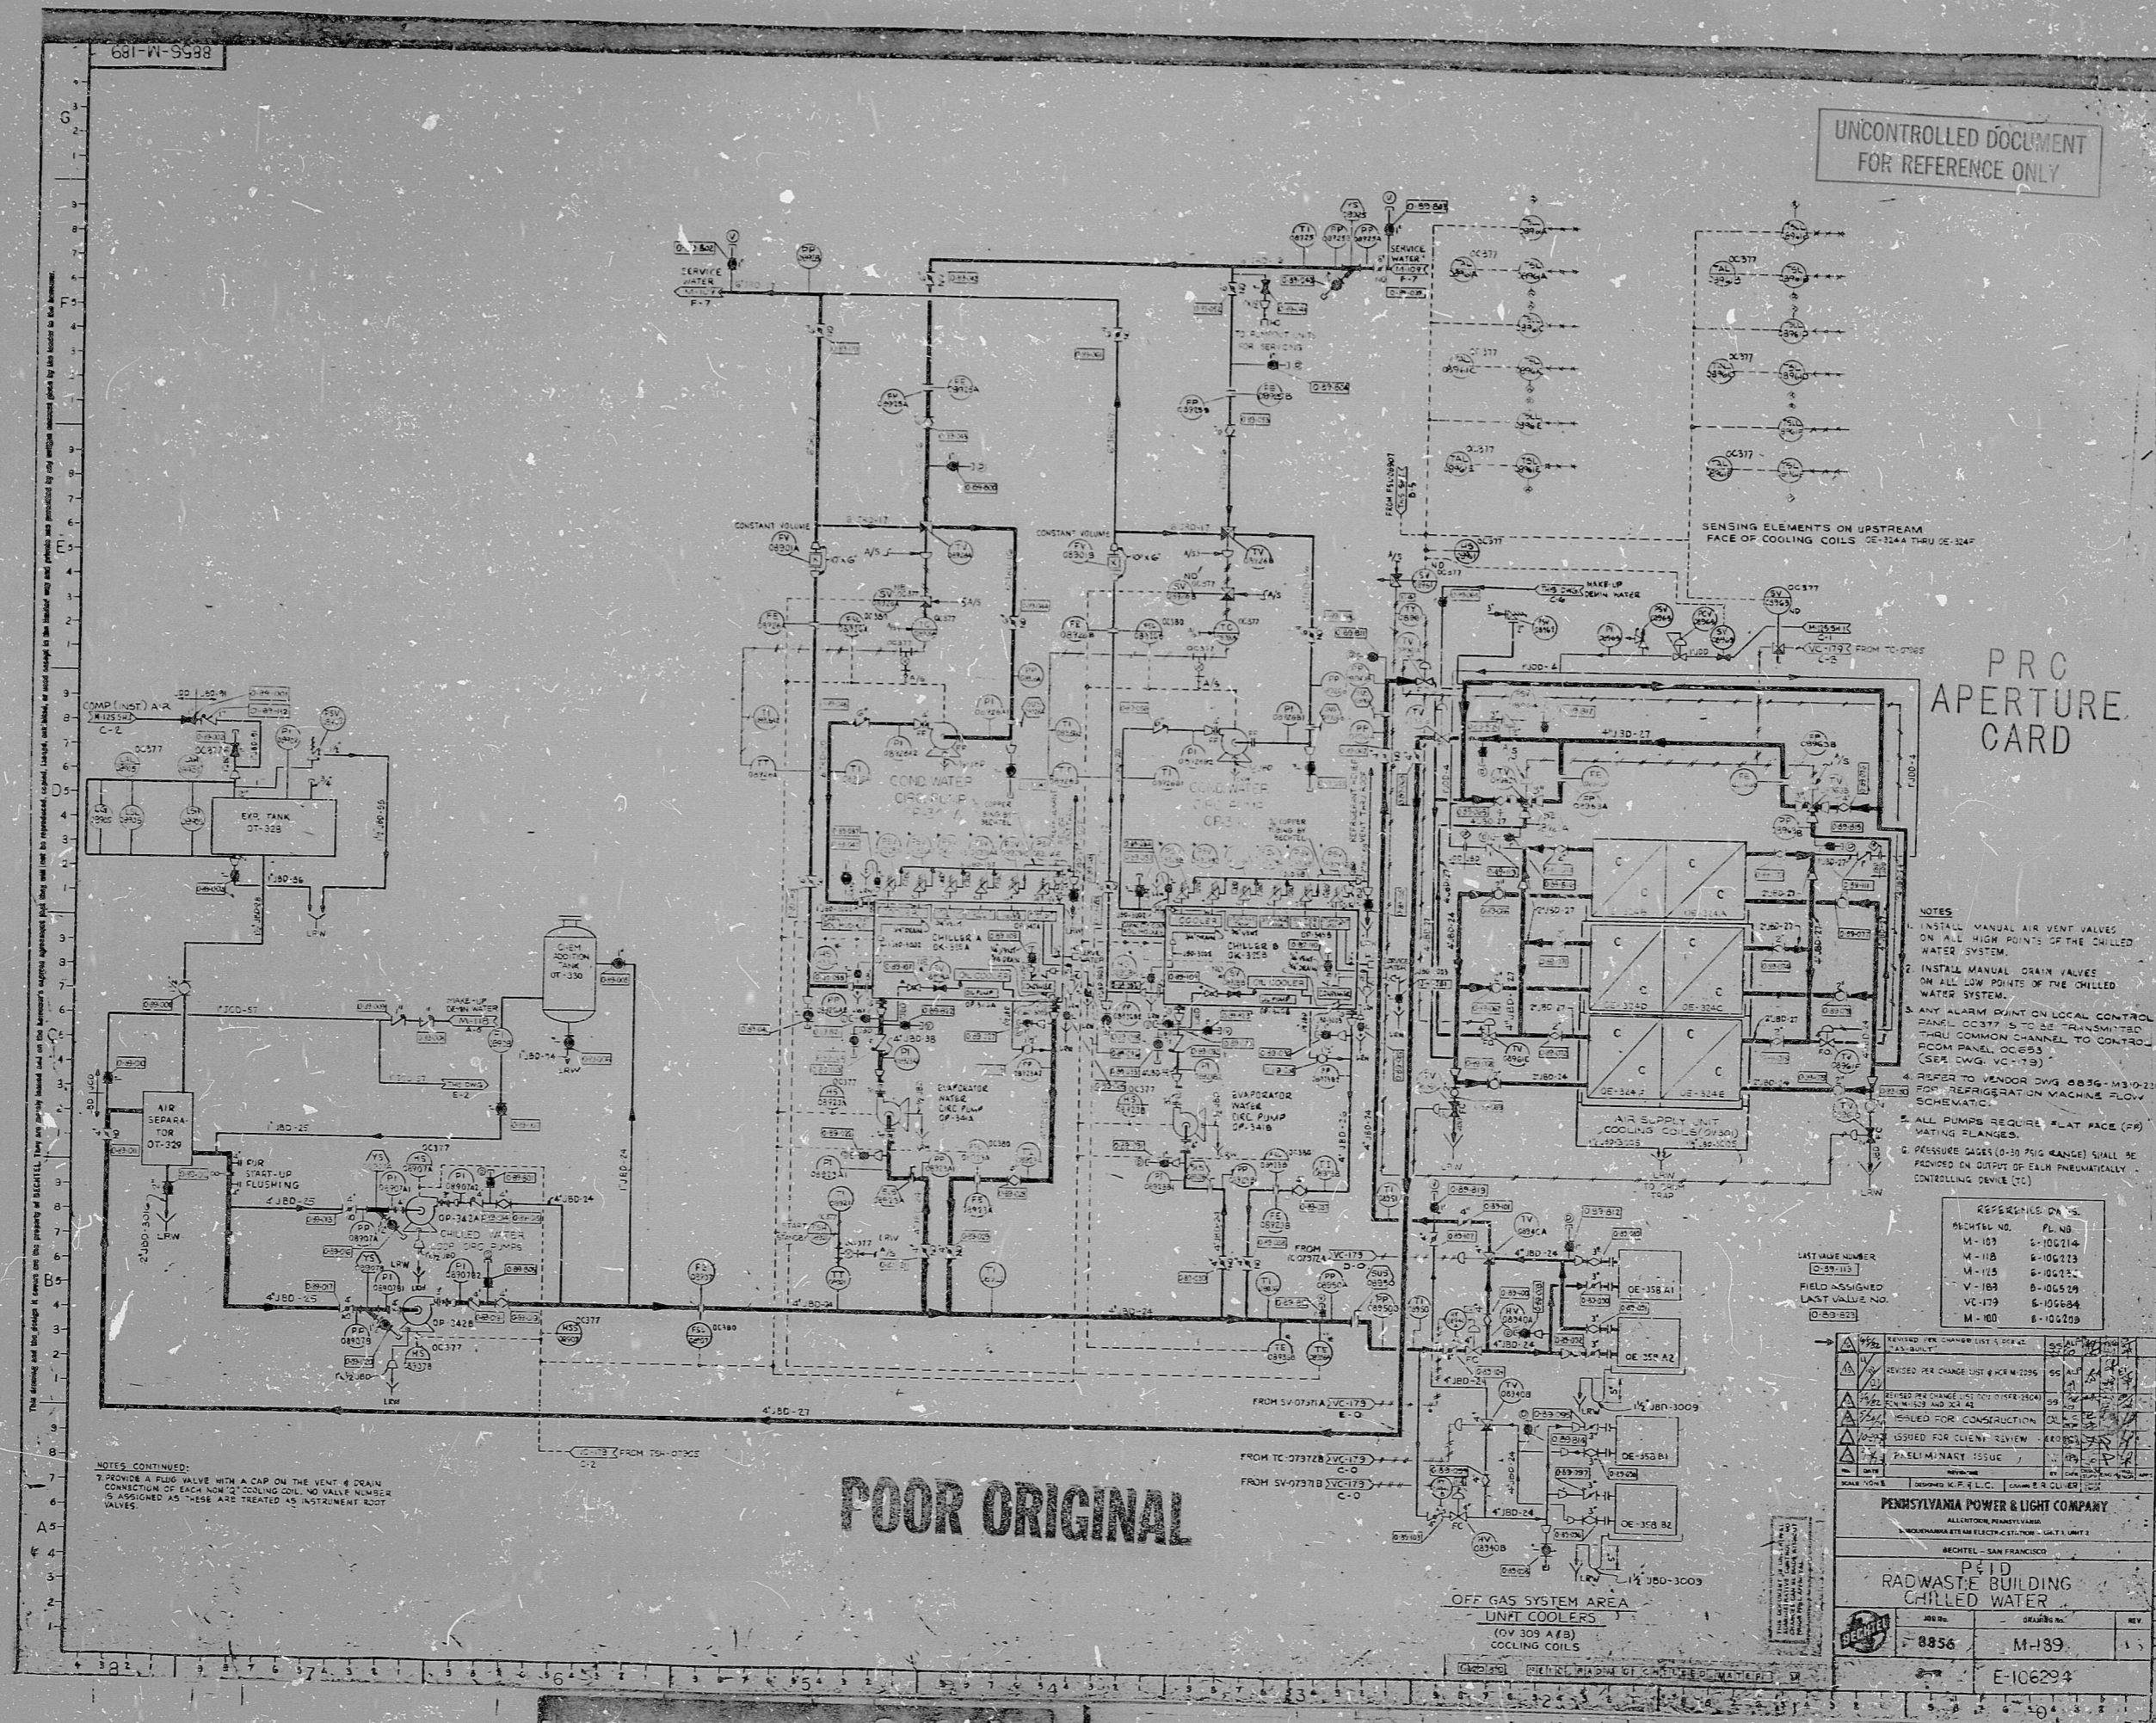

PRC
APERTURE
CARD

- NOTES
1. INSTALL MANUAL AIR VENT VALVES ON ALL HIGH POINTS OF THE CHILLED WATER SYSTEM.
 2. INSTALL MANUAL DRAIN VALVES ON ALL LOW POINTS OF THE CHILLED WATER SYSTEM.
 3. ANY ALARM POINT ON LOCAL CONTROL PANEL, OC377 IS TO BE TRANSMITTED THRU COMMON CHANNEL TO CONTROL ROOM PANEL, OC693 (SEE DWG. VC-179).
 4. REFER TO VENDOR DWG. 0856-M310-215 FOR REFRIGERATION MACHINE FLOW SCHEMATIC.
 5. ALL PUMPS REQUIRE FLAT FACE (FF) MATING FLANGES.
 6. PRESSURE GAUGES (0-30 PSIG RANGE) SHALL BE PROVIDED ON OUTPUT OF EACH PNEUMATICALLY CONTROLLING DEVICE (PC).


LAST MADE NUMBER
0-37-113
FIELD ASSIGNED
LAST VALUE NO.

| NO. | REVISION | DATE | BY | CHKD. | APP'D. |
|-----|--------------------------------|------|----|-------|--------|
POOR ORIGINAL

PENNSYLVANIA POWER & LIGHT COMPANY


RECHTEL - SAN FRANCISCO

RECHTEL - SAN FRANCISCO













RIDS

8305260091

