



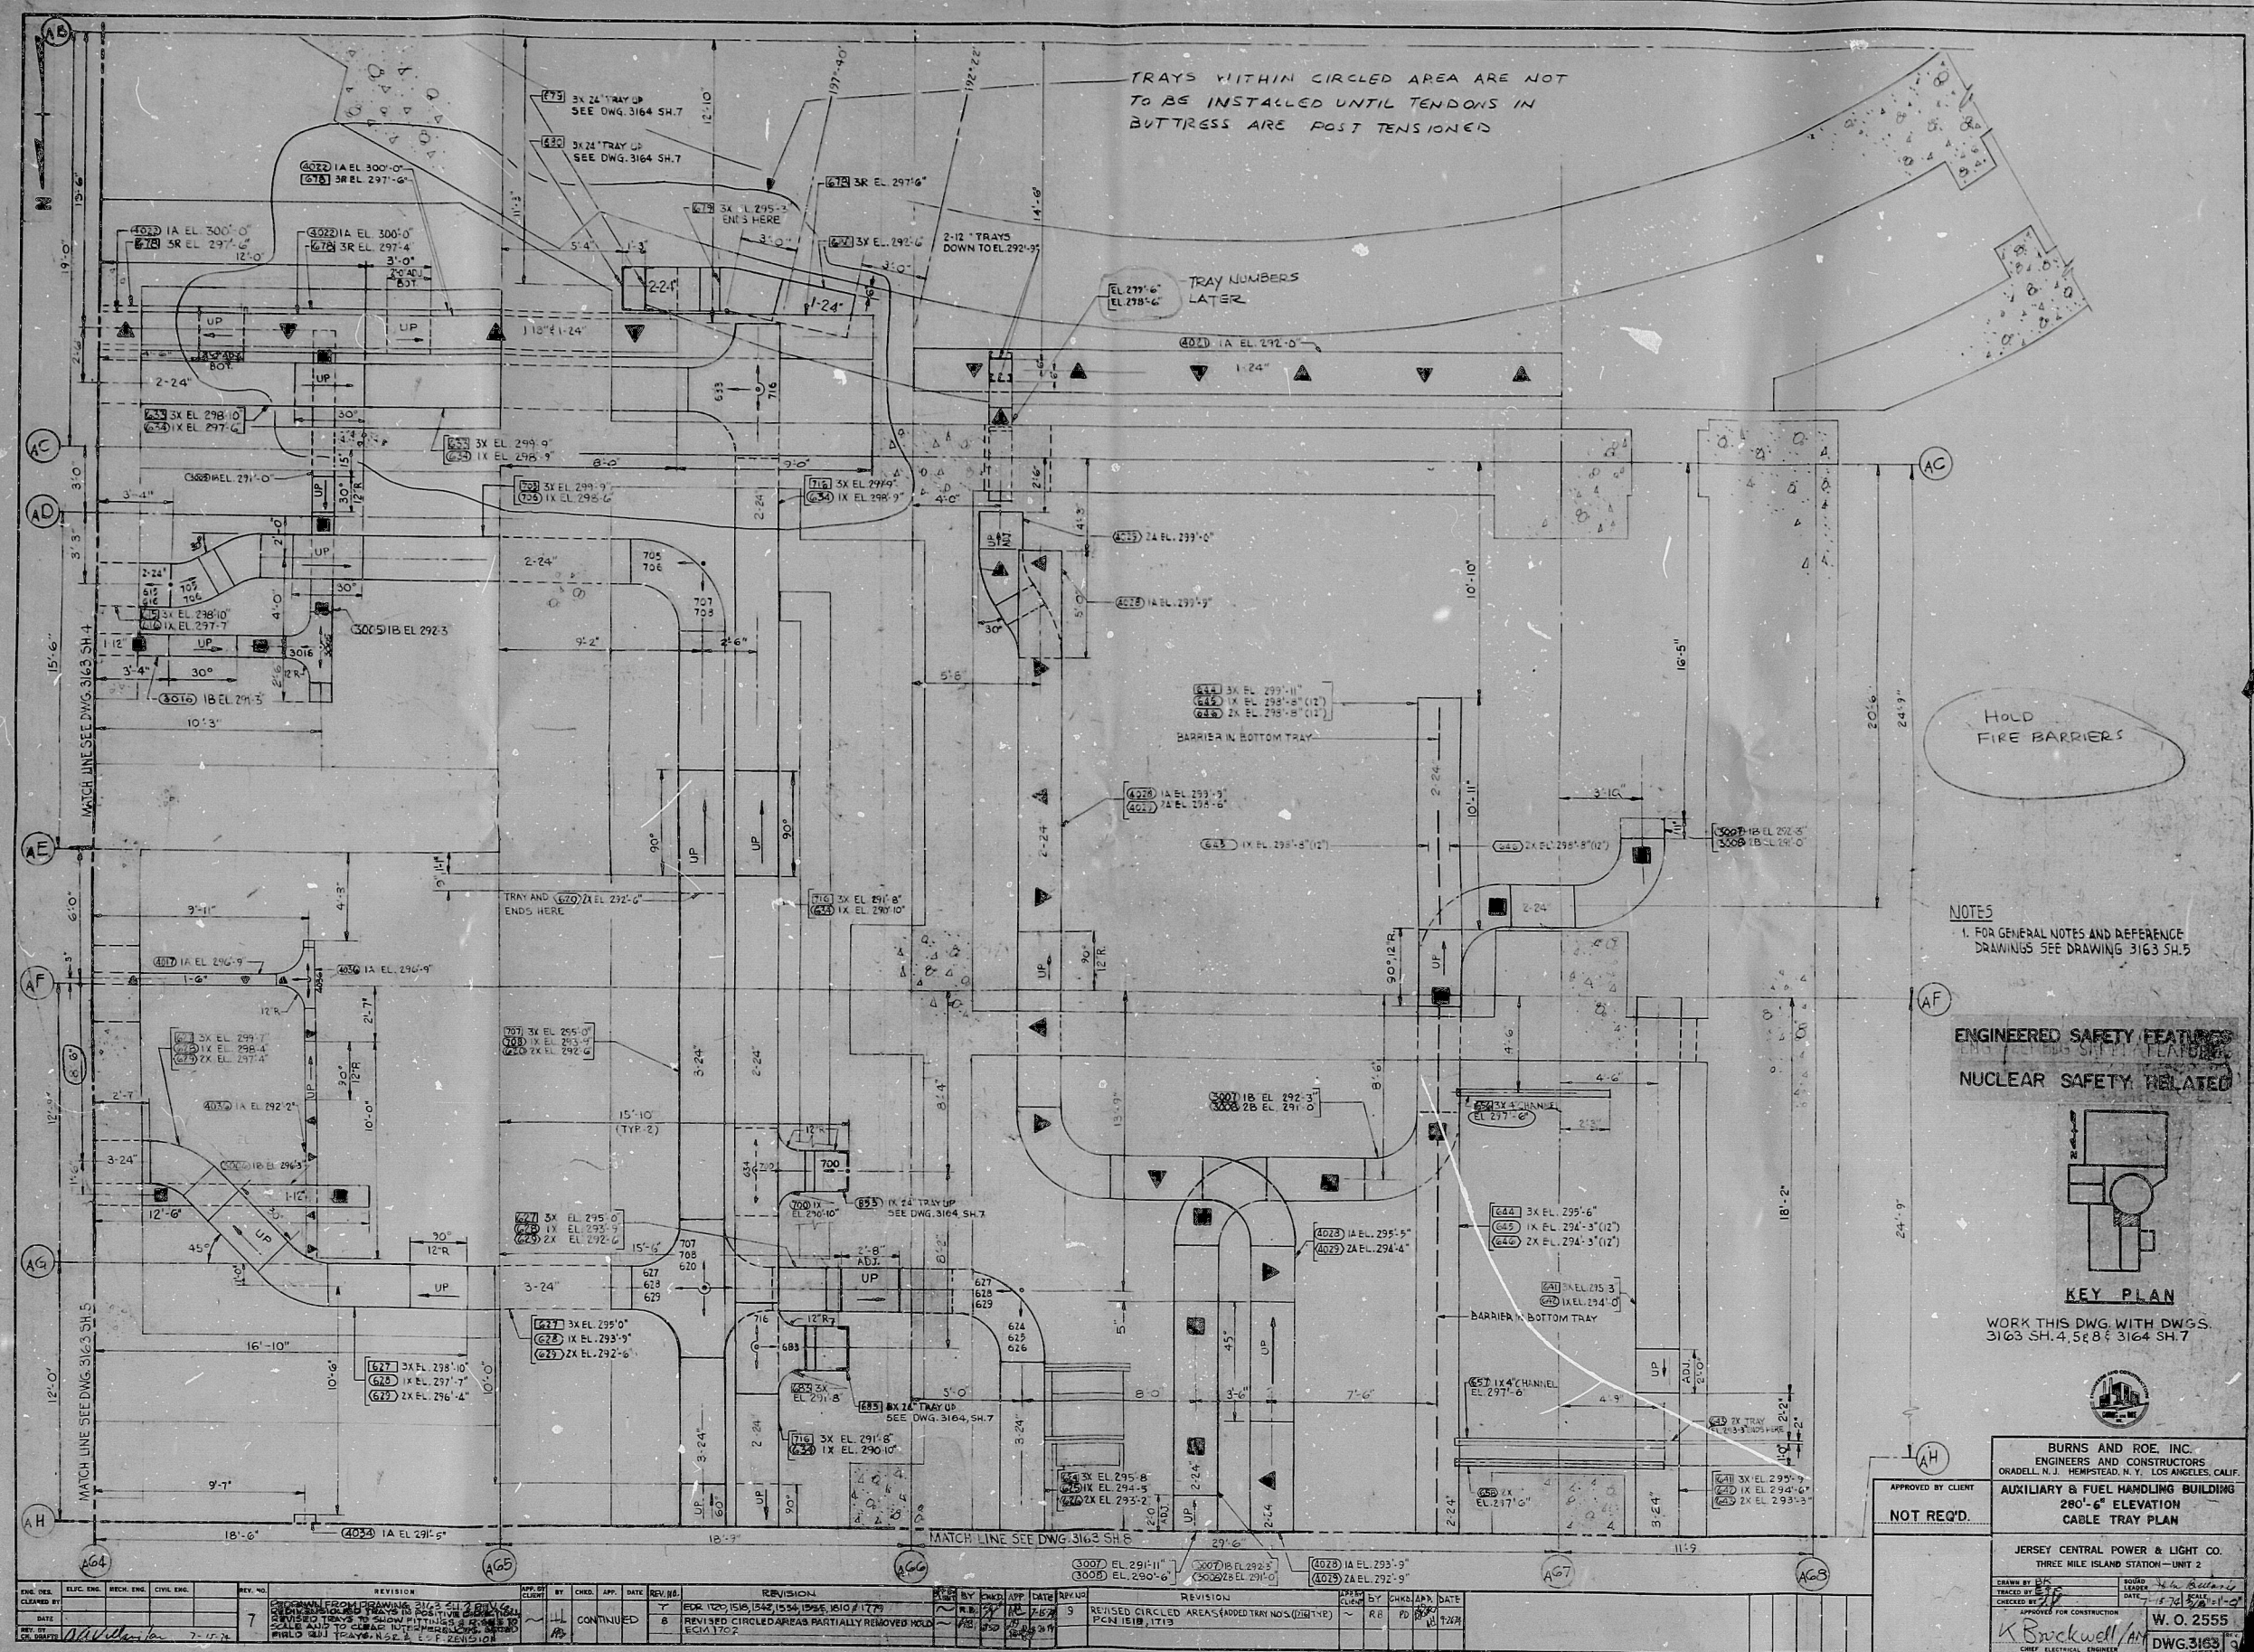

NOTES

1. FOR GENERAL NOTES AND REFERENCE DRAWINGS SEE DRAWING 3163 SH.5

ENGINEERED SAFETY FEATURES
NUCLEAR SAFETY RELATED

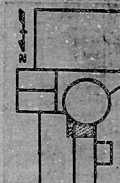

KEY PLAN

WORK THIS DWG. WITH DWGS.
3163 SH.4, 5 & 8 & 3164 SH.7

BURNS AND ROE, INC.
ENGINEERS AND CONSTRUCTORS
ORADELL, N. J. HEMPSTEAD, N. Y. LOS ANGELES, CALIF.

AUXILIARY & FUEL HANDLING BUILDING
280'-6" ELEVATION
CABLE TRAY PLAN

JERSEY CENTRAL POWER & LIGHT CO.	
THREE MILE ISLAND STATION—UNIT 2	
DRAWN BY: <i>JF</i>	SOUND LEADER: <i>John Bellan</i>
TRACED BY: <i>JF</i>	DATE: <i>1-15-76</i>
CHECKED BY: <i>JF</i>	SCALE: <i>3/8" = 1'-0"</i>
APPROVES FOR CONSTRUCTION	
<i>K Bruckwell / AN</i>	W. O. 2555
CHIEF ELECTRICAL ENGINEER	DWG. 3163

7906080050

POK

7906080058

7906080058

