


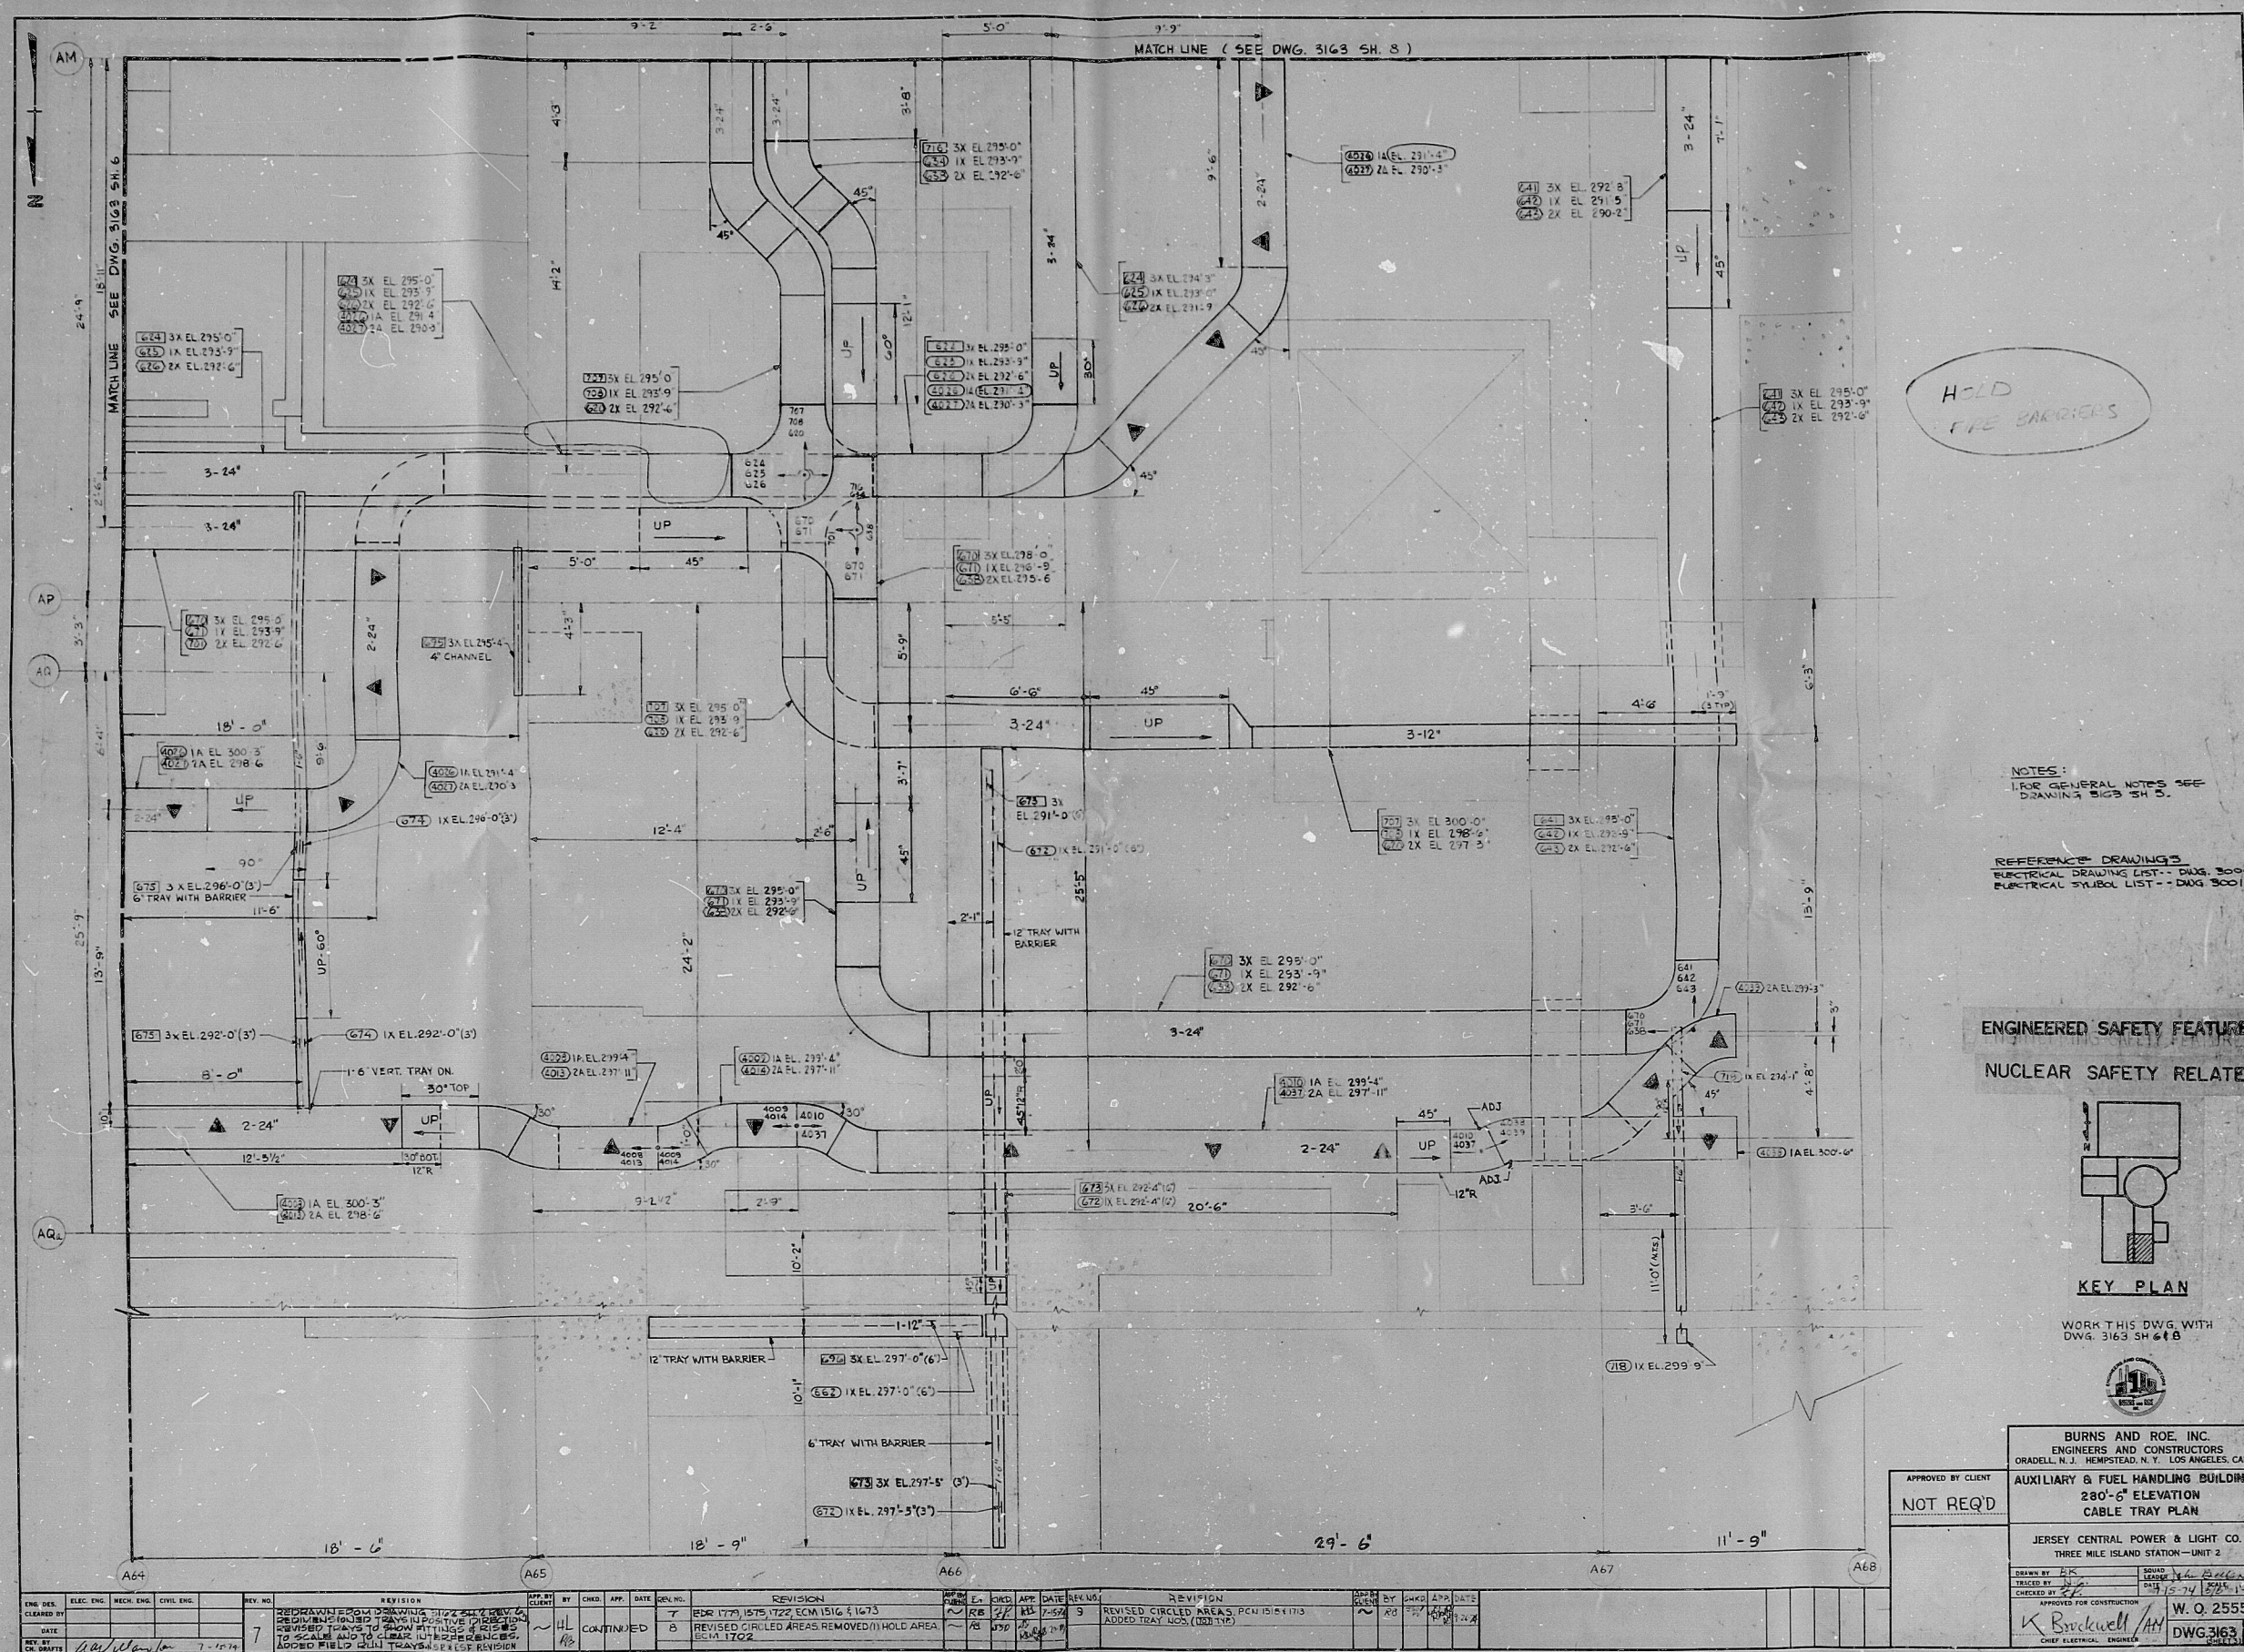


HOLD
FIRE BARRIERS

NOTES:
1. FOR GENERAL NOTES SEE
DRAWING SIGB SH 5.

REFERENCE DRAWINGS
ELECTRICAL DRAWING LIST -- DWG. 3000
ELECTRICAL SYMBOL LIST -- DWG. 3001

ENGINEERED SAFETY FEATURES
NUCLEAR SAFETY RELATED

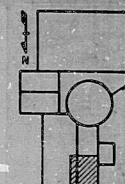

KEY PLAN

WORK THIS DWG. WITH



BURNS AND ROE, INC.
ENGINEERS AND CONSTRUCTORS
ORADELL, N. J. HEMPSTEAD, N. Y. LOS ANGELES, CALIF.

AUXILIARY & FUEL HANDLING BUILDING
280'-6" ELEVATION
CABLE TRAY PLAN

JERSEY CENTRAL POWER & LIGHT CO.
THREE MILE ISLAND STATION—UNIT 2

DRAWN BY <i>BR</i>	SQUAD LEADER <i>John H. H. H.</i>
TRACED BY <i>N. J.</i>	DATE <i>11-5-74</i>
CHECKED BY <i>SP</i>	SCALE <i>5/8" = 1'-0"</i>
APPROVED FOR CONSTRUCTION	
W. O. 2555	

K Brockwell / AM	DWG.3163	REV S
------------------	----------	----------

7246-1-1

1906080074

1892

4


[illegible]



RDR

7906080074

7906080074

 