


This drawing and the data on it are the property of the Utilities which are participating in the SNUPPS Project. It is loaned to the borrower's express agreement that it will not be reproduced, copied, loaned, exhibited, or used except in the limited way and private use permitted by written consent given by the SNUPPS Utilites to the borrower.

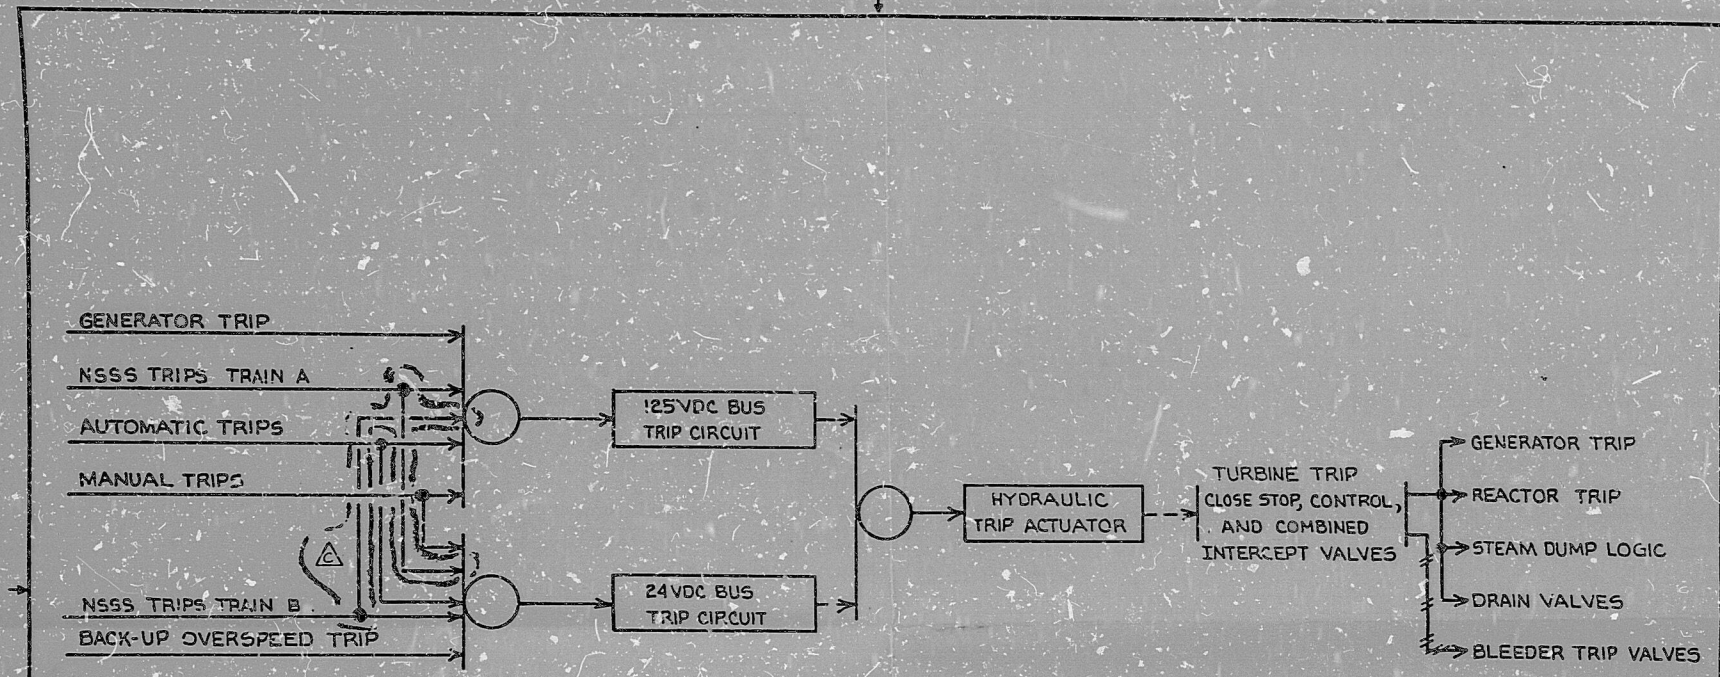

NOTES:

1. FOR LEGEND, REFERENCES, NOTES AND INDICATOR ASSIGNMENTS SEE J-02AC06
2. FOR DETAILS OF THE ABOVE LOGIC SEE J-02AC08.

TI APERTURE CARD

NO.	DATE	REVISIONS	BY	CHK	DESIGNED	DRAWN	INSP
1							
COORDINATION SIGN-OFF							
DOCUMENT IDENTIFICATION J-02AC07							

NO.	DATE	REVISIONS	BY	CHK	DESIGNED	DRAWN	INSP
1							
BECHTEL GAITHERSBURG, MARYLAND							
SNUPPS							
MAIN TURBINE TRIP BLOCK DIAGRAM							
UTILITY DRAWING NO.				REV			
JOB NO.				BECHTEL DRAWING NO.			
10436				J-02AC07			
DRAWING APPLICABLE TO UNITS				REVIEW LEVEL			
1 2 3 4 5 6 7 8				1 2 3 4 5 6 7 8			

I certify that the image contained on this frame was made in the normal and regular course of business, on the date stated below and that it is an accurate reproduction of the document(s) submitted to Micrographics.
 DATE 7-15-87 OPERATOR Bill Young SUPERVISOR R.L. Comp...

16X

8410050 24/6

PDR RIDS

