


1. 2/14/78 (CIRCLED AREAS INDICATE LATEST REVISION) 2. 2/14/78 (CIRCLED AREAS INDICATE LATEST REVISION) 3. 2/14/78 (CIRCLED AREAS INDICATE LATEST REVISION) 4. 2/14/78 (CIRCLED AREAS INDICATE LATEST REVISION) 5. 
---	--	--	--

BROWN & ROOT INC. MICROFILM SERVICES HOUSTON, TEXAS		SOUTH TEXAS PROJECT PIPING DIAGRAM RHR/SAFETY INJECTION SYSTEM SHEET NO. 3 OF 4		INCL. NO. 001 SUFF. ICD CONTRACT NO. CR-0241 SCALE: N.T.S. DRAWING NO. C.N.I. 1316 I-F-5015-F
--	--	---	--	---

INFORMATION PRELIMINARY REVIEW USE CONSTRUCTION

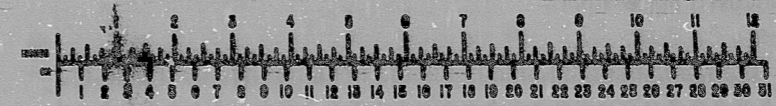

BROWN & ROOT INC.
 MICROFILM SERVICES
 FRIDAY, MAY 19 1978

R:PS

8112070091

