


POOR ORIGINAL

INFORMATION
THIS DOCUMENT IS
SUBJECT TO REVISION
WITHOUT NOTIFICATION
TO THE USER OF THIS
COPY

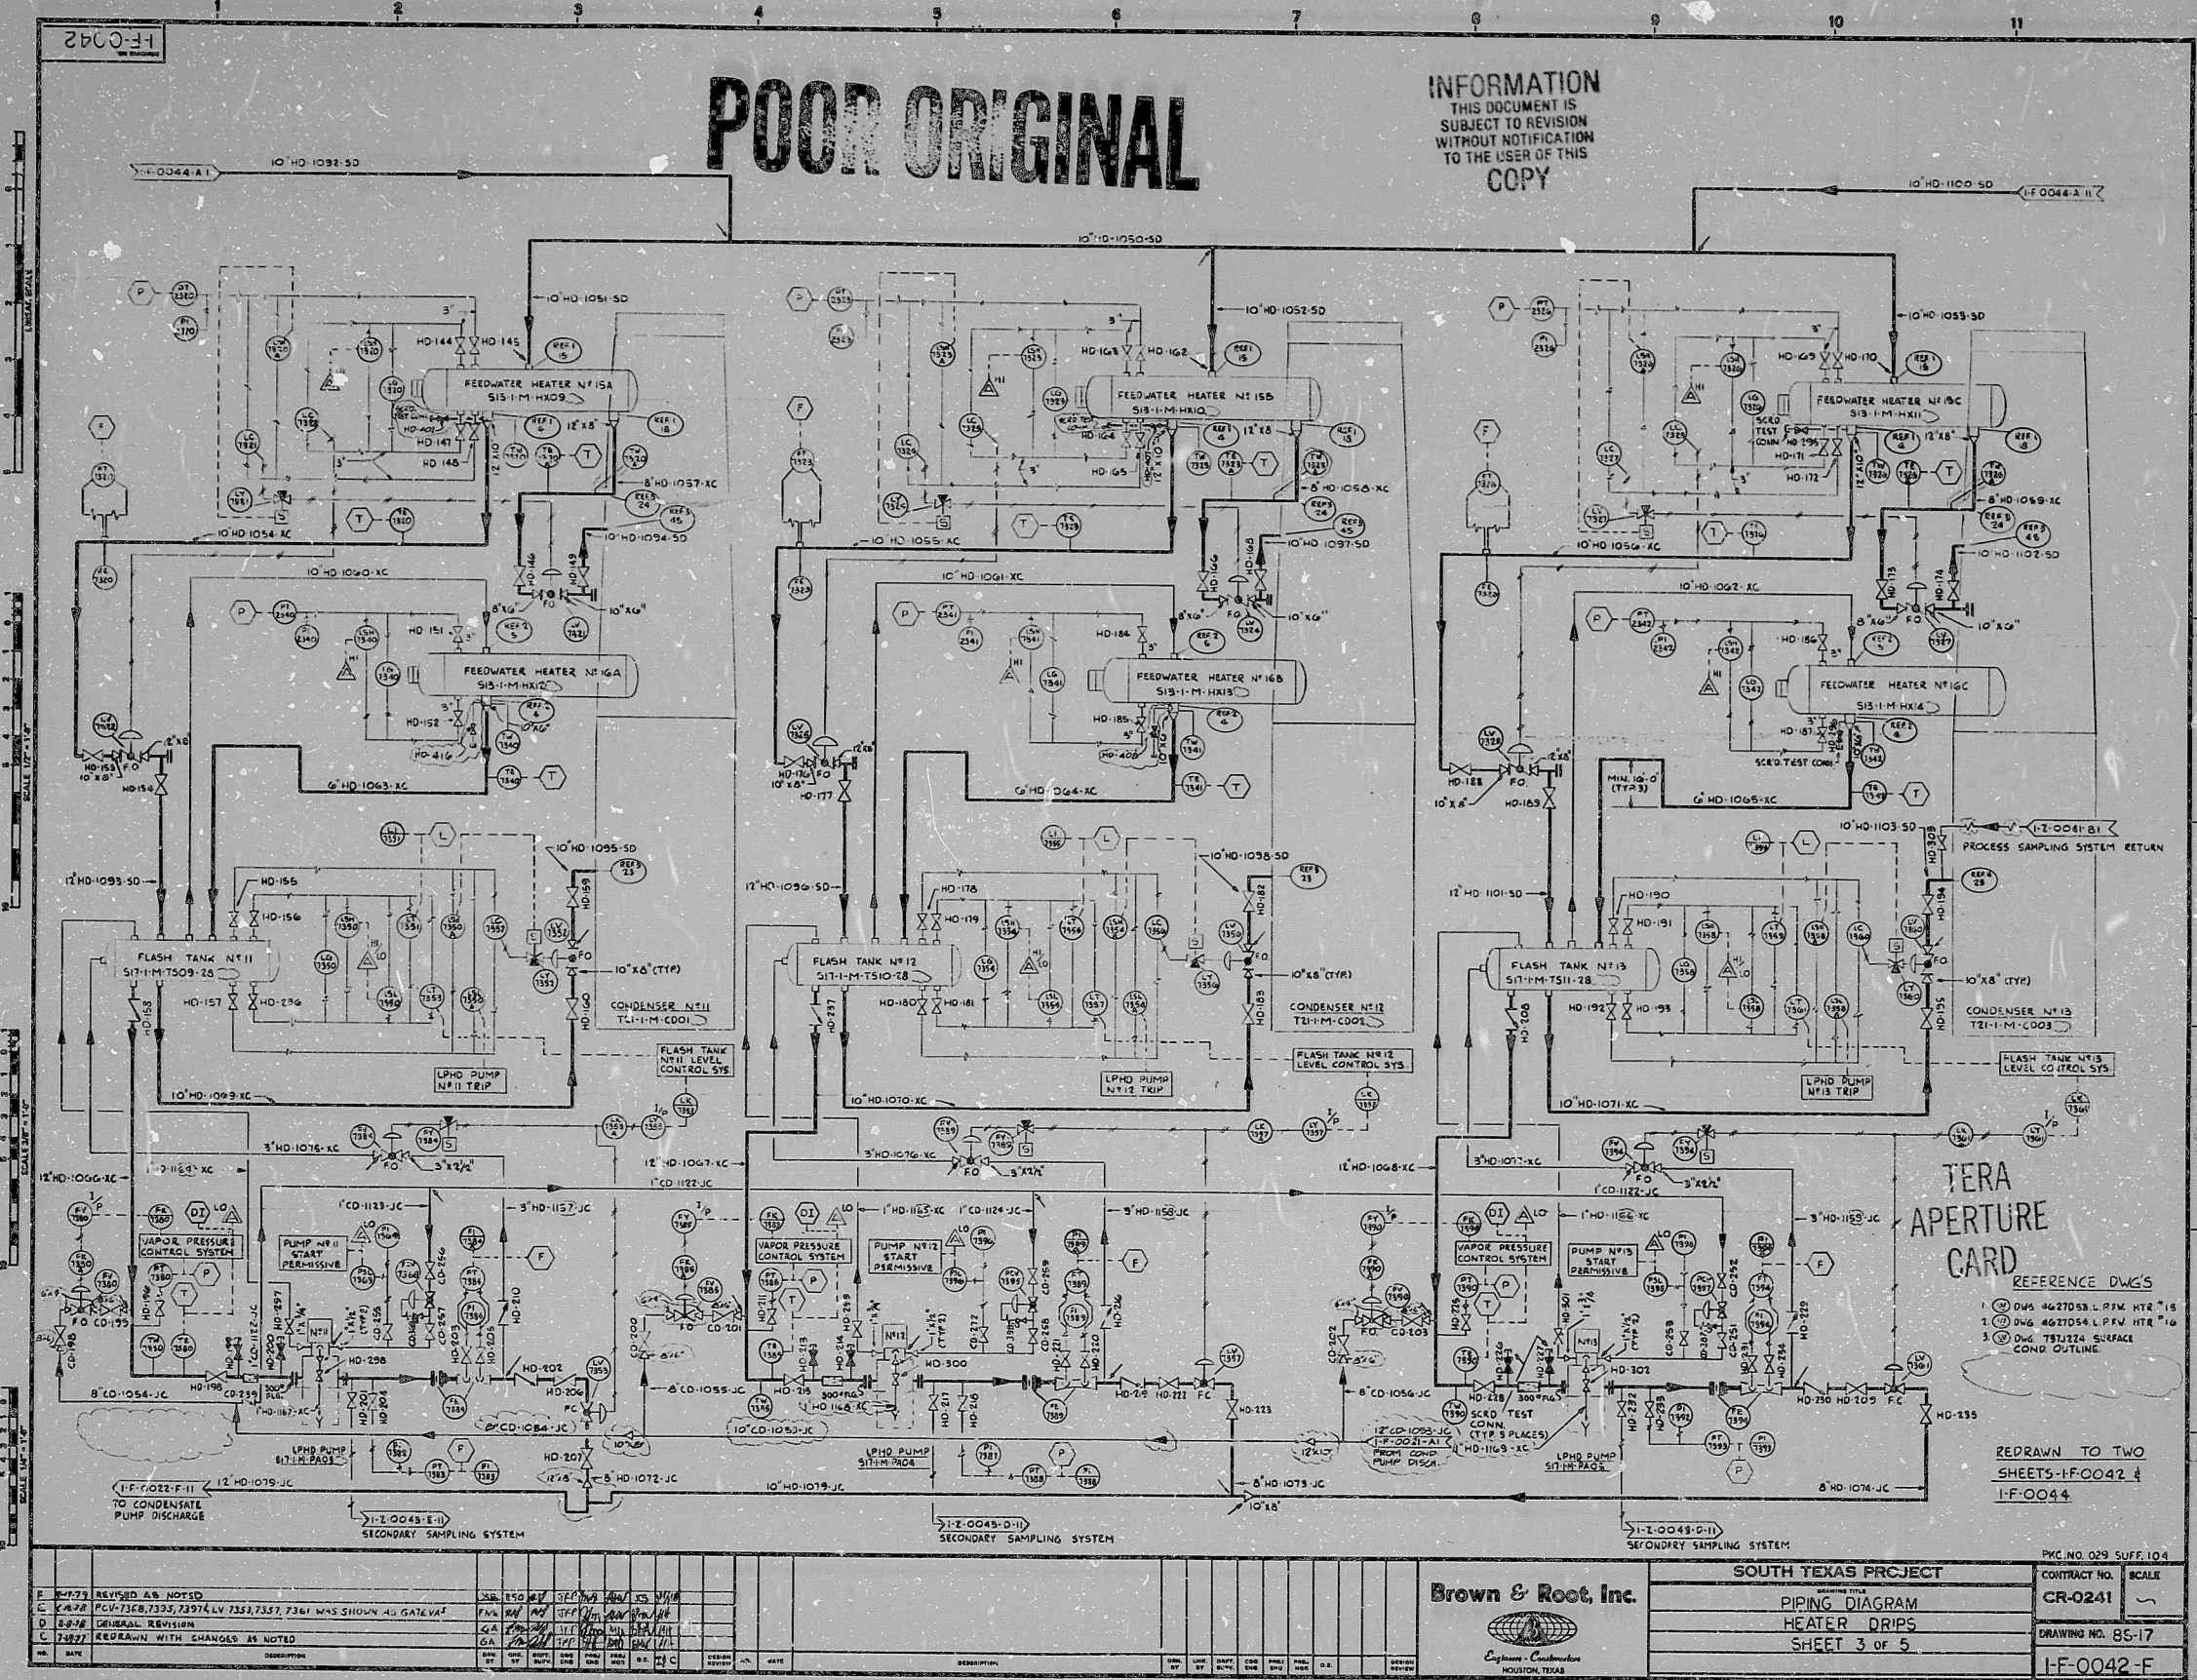

TERA APERTURE CARD
REFERENCE DWGS
1. DWG 4627053 L.P.M. HTR "15"
2. DWG 4627054 L.P.M. HTR "16"
3. DWG 781224 SURFACE COND OUTLINE
REDRAWN TO TWO SHEETS-IF-0042 & IF-0044



Brown & Root, Inc.
Corporate Headquarters
HOUSTON, TEXAS

SOUTH TEXAS PROJECT		PVC NO. 029 SUFF 104
PIPING DIAGRAM		CONTRACT NO. SCALE
HEATER DRIPS		CR-0241
SHEET 3 OF 5		DRAWING NO. BS-17
		IF-0042-F




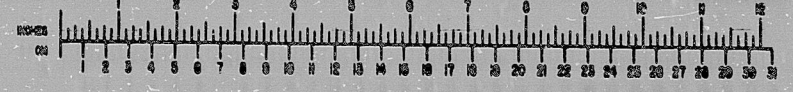

8.5"

11"

17"

8.5"

11"

17"

RIPS

8112070209

