

NOTE:  
ALL INSTRUMENTS SHOWN ON THIS DIAGRAM  
ARE PREFIXED BY THE UNIT NUMBER OR  
UNLESS OTHERWISE NOTED.


TERA  
APERTURE  
CARD

INFORMATION  
THIS DOCUMENT IS  
SUBJECT TO REVISION  
WITHOUT NOTIFICATION  
TO THE USER OF THIS  
COPY

C 7/27/77 GENERAL REVISION B 7/27/77 AS BUILT FOR INFORMATION A 0 7/27/77 PROPOSED REVISION		PKG. NO. 018 SUFF. 050 CONTRACT NO. CR-0241 SCALE NONE DRAWING NO. 93-21 95-19 0-F-0009-C	
Brown & Root, Inc. Houston, Texas		SOUTH TEXAS PROJECT PIPING DIAGRAM DEMINERALIZED WATER STORAGE	

BROWN & ROOT INC.  
MICROFILM SERVICES

WEDNESDAY, JULY 27 1977

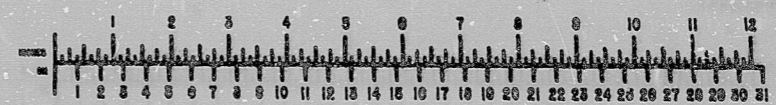

PRELIMINARY  REVIEW  USE  CONSTRUCTION

KID'S

8112070267

