

17


11

8.5

17

11

8.5

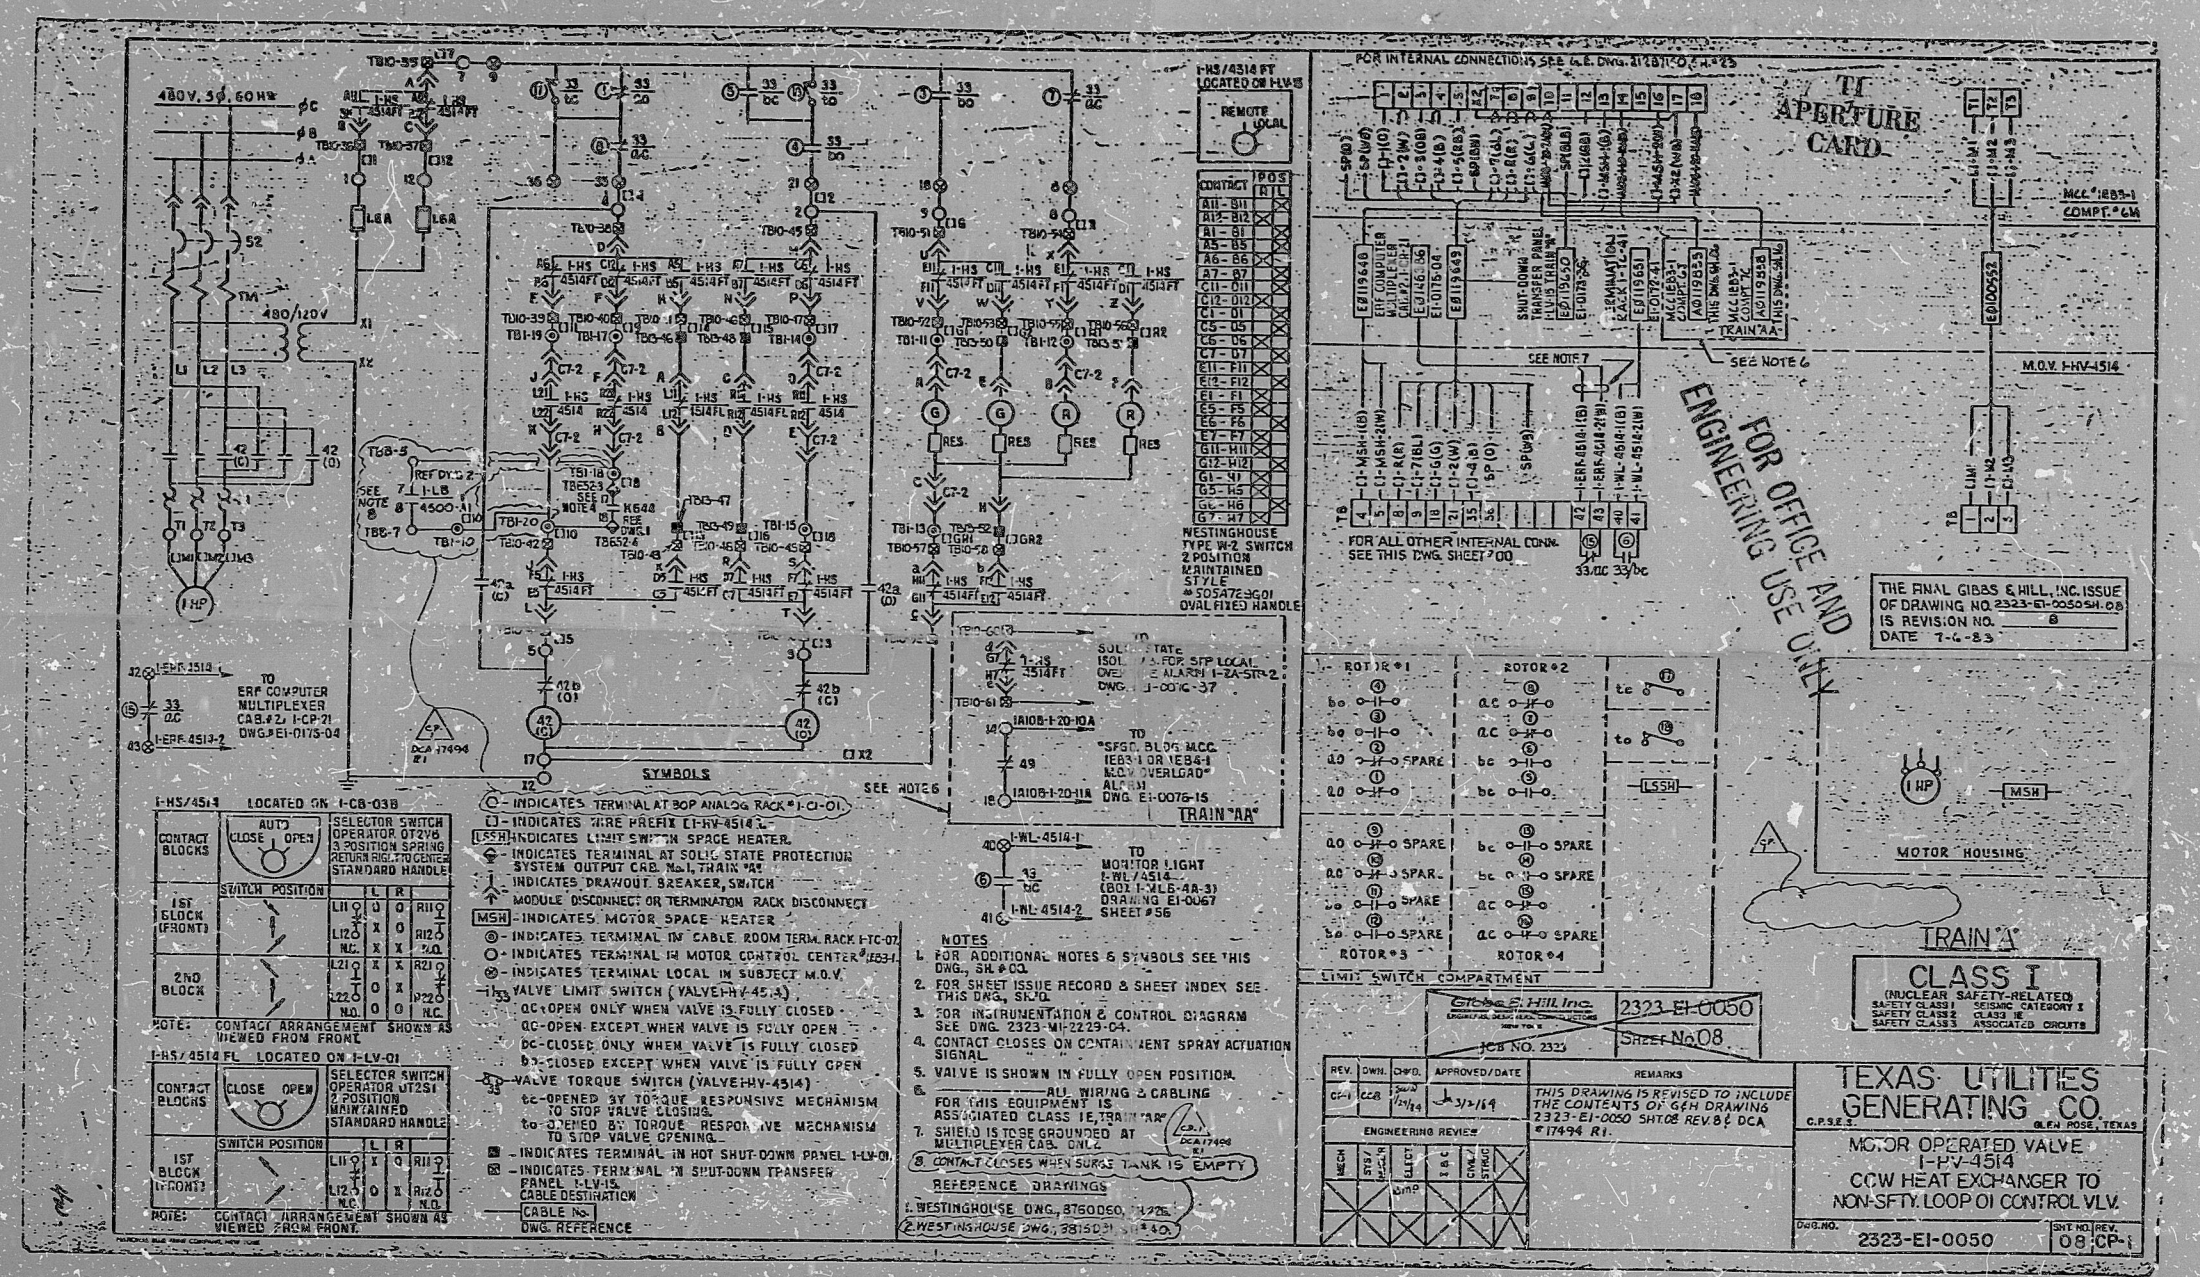

8410050426

8.5

11

17



PDR RIDS

8410050426

