


This drawing and the design it covers is the property of the utilities which are participating in the SNPPS Project. It is loaned to the borrower's express agreement that it will not be reproduced, copied, loaned, exhibited, or used except in the limited way and periods as permitted by the SNPPS Utilities to the borrower.

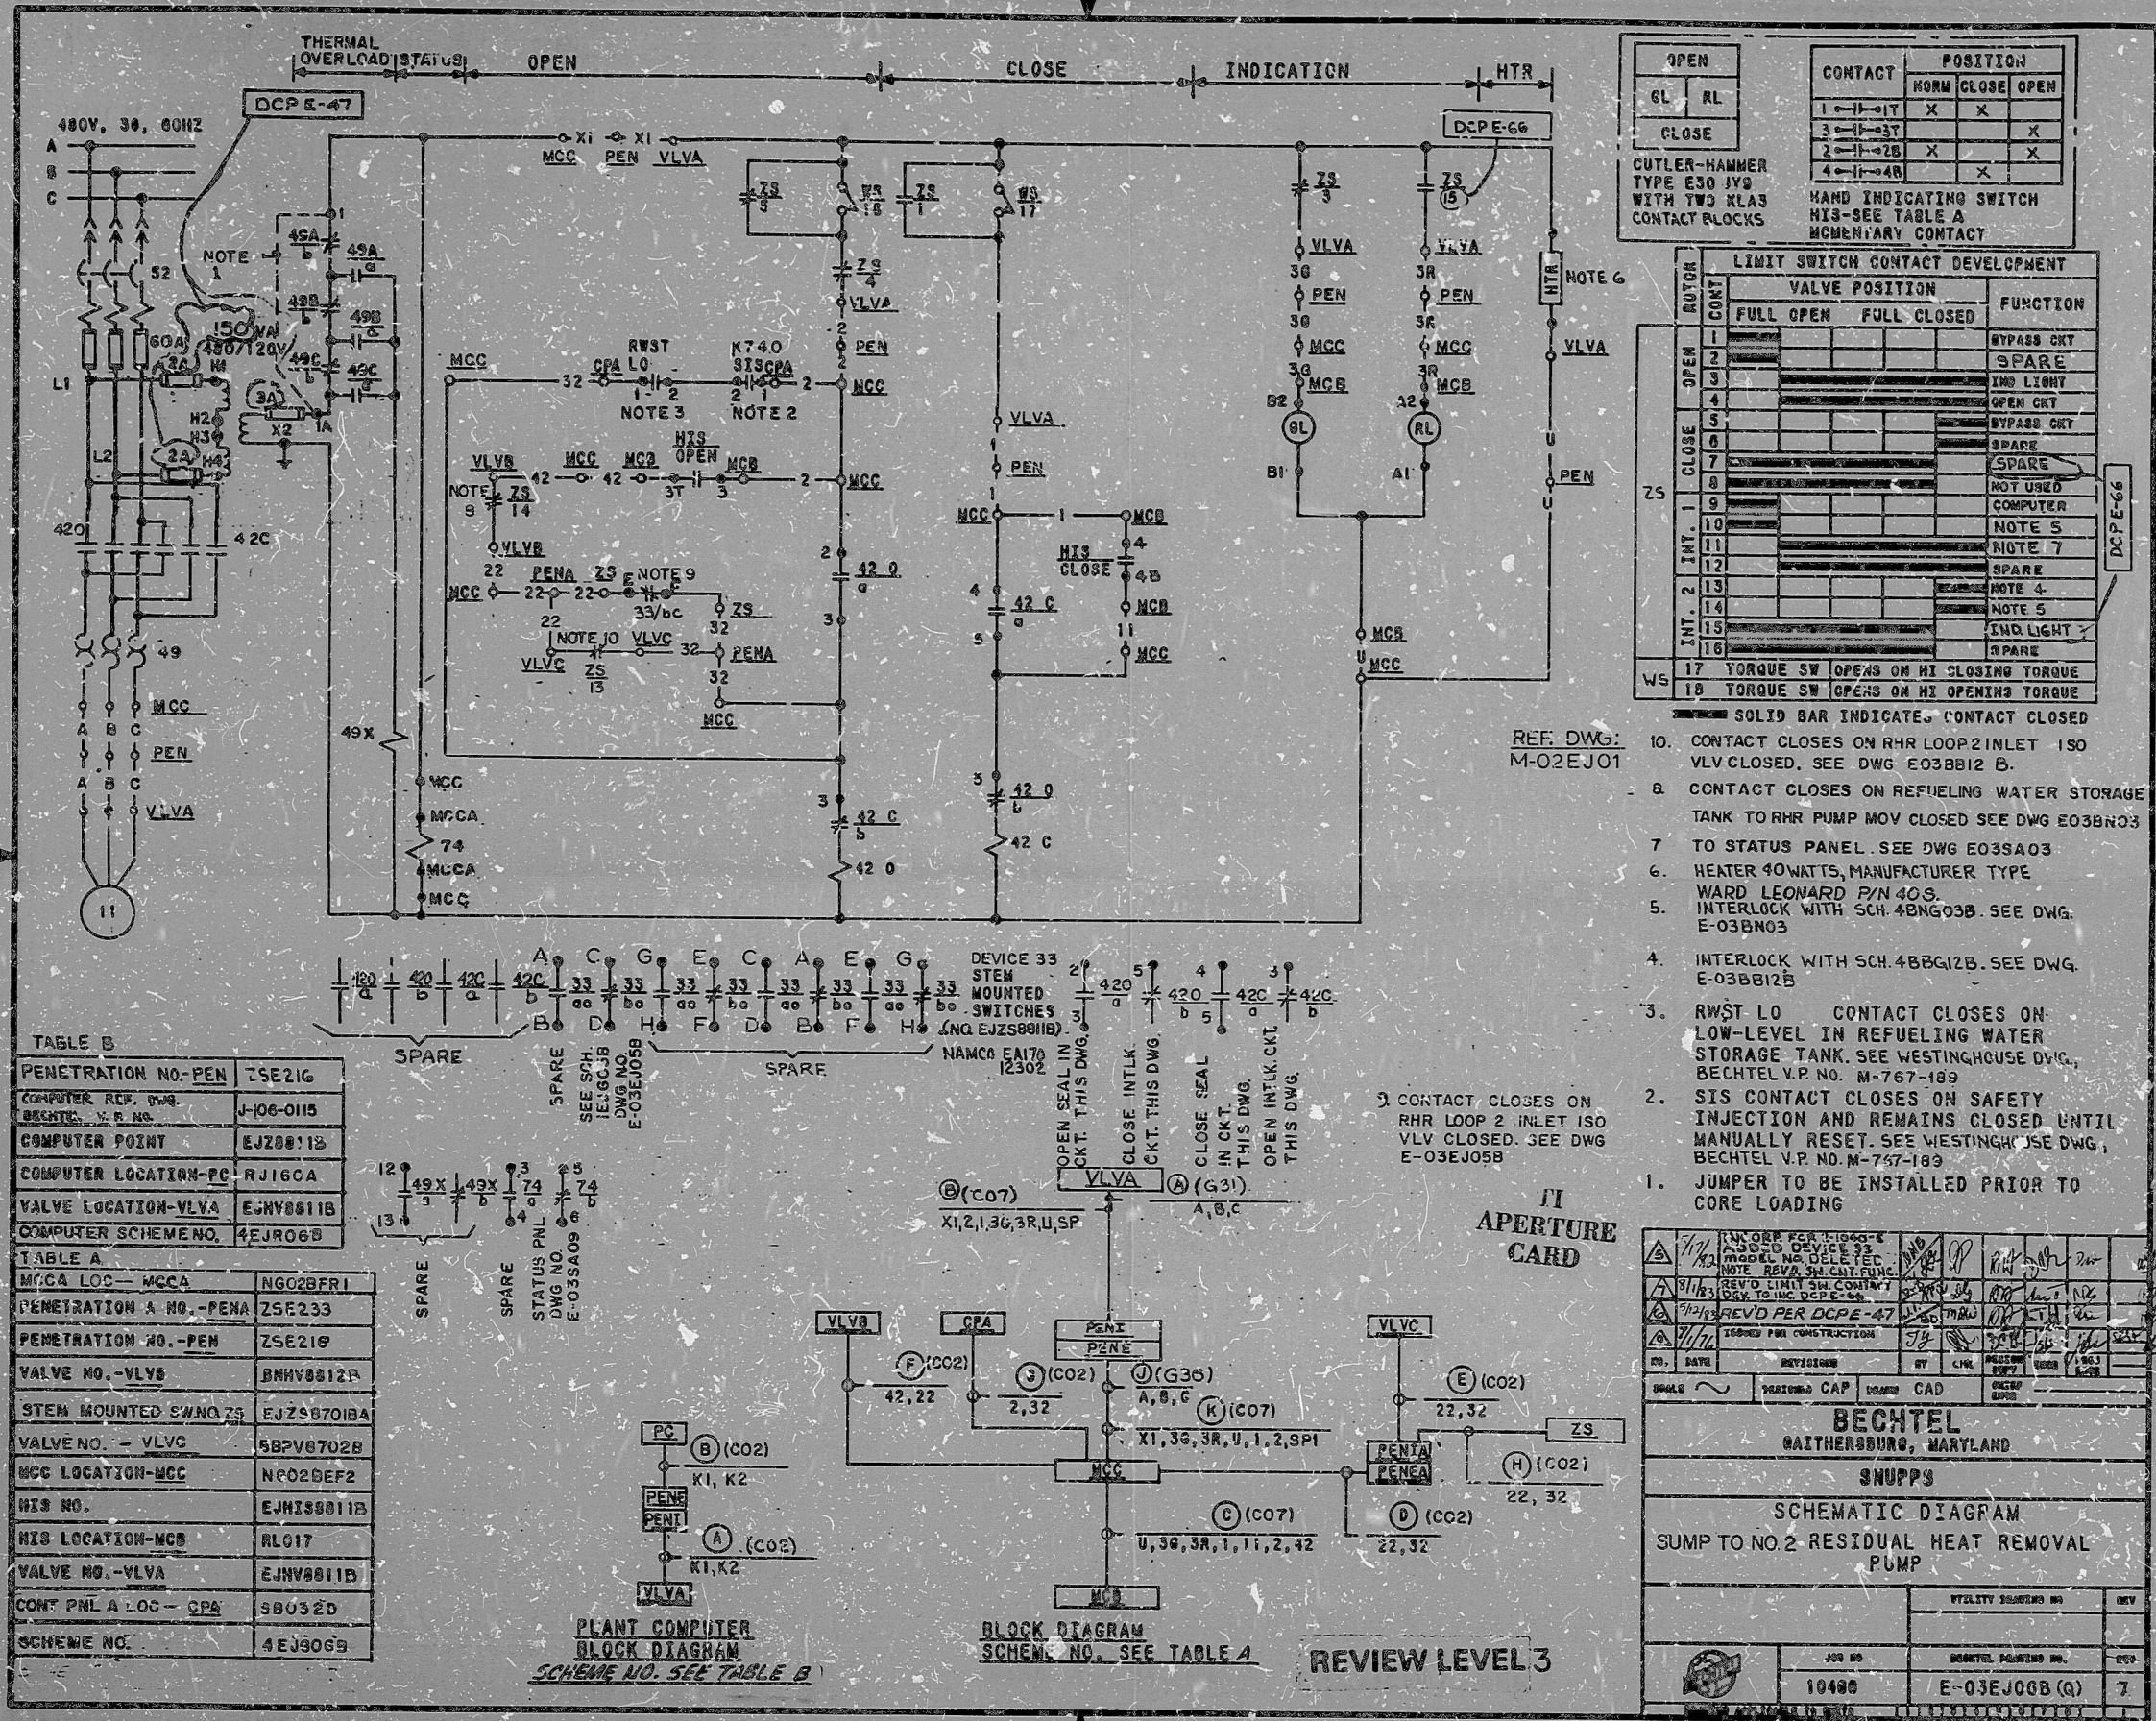

I certify that the image contained on this frame was made in the normal and regular course of business, on the date stated below and that it is an accurate reproduction of the document(s) submitted to Micrographics.
 DATE: 3-9-83 OPERATOR: [Signature] SUPERVISOR: [Signature]

16X

8410050428

PDR RWS

