


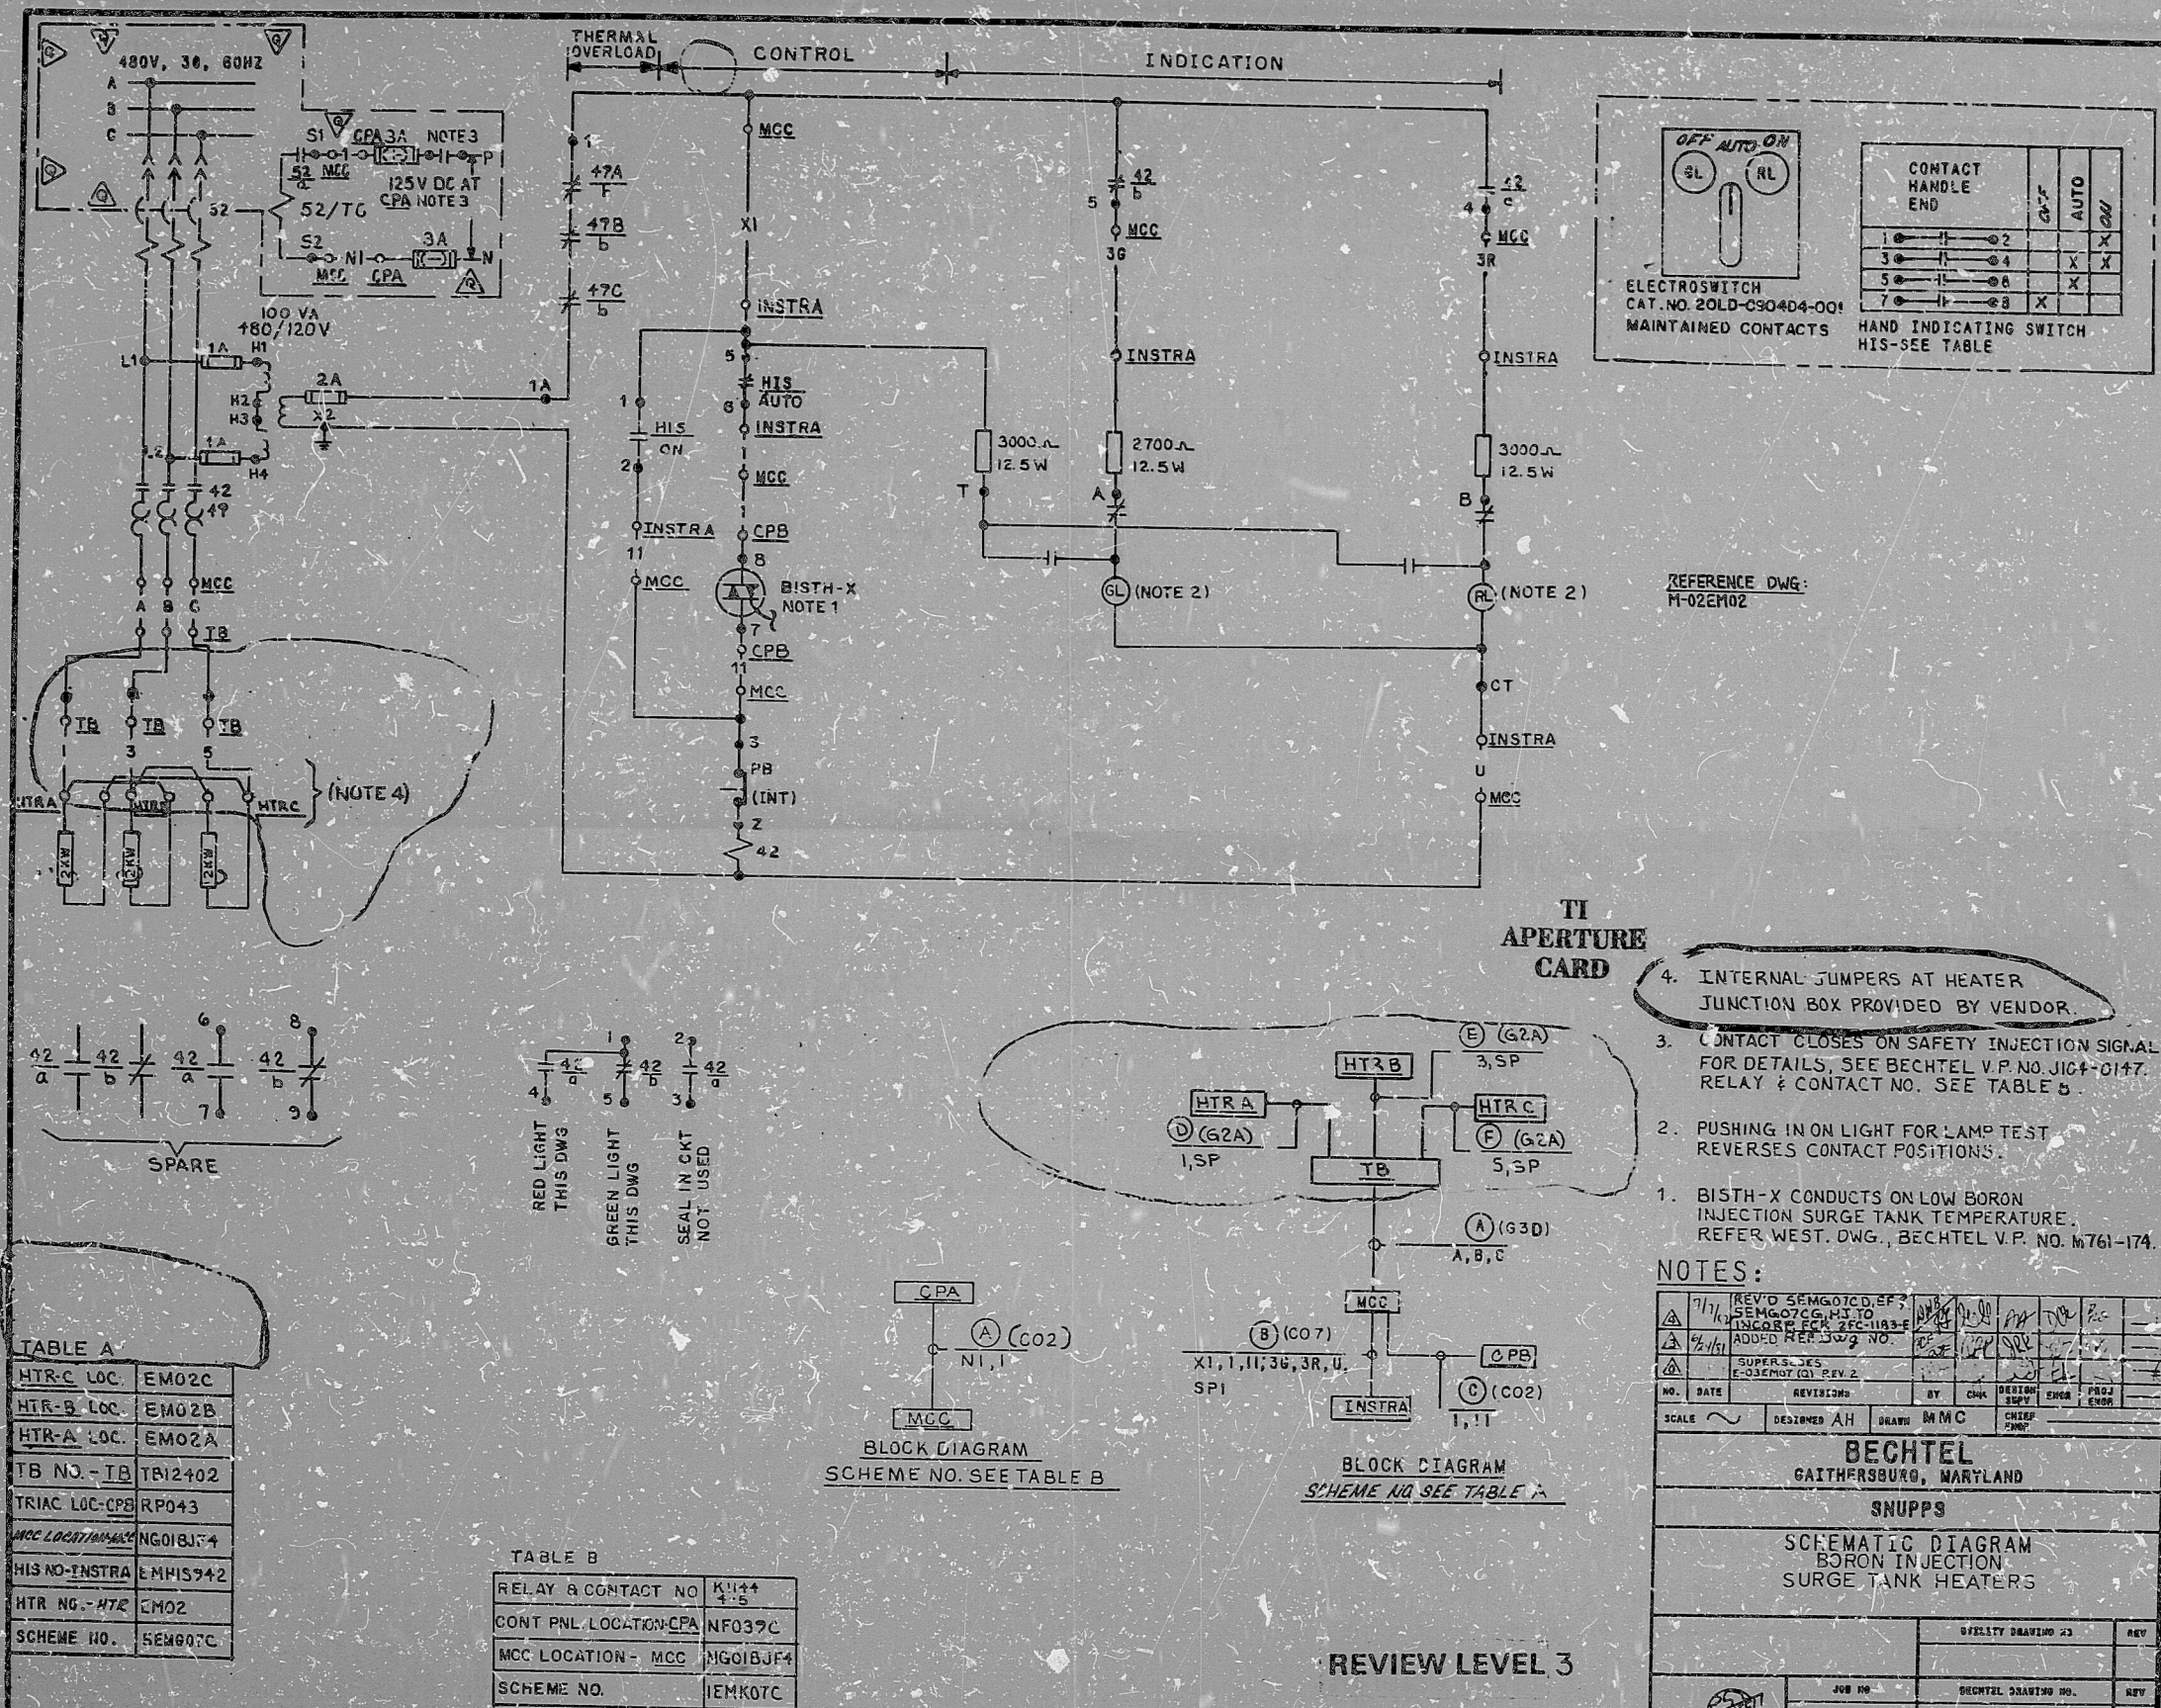

8410050489

PDR RIDS

