


62060-M

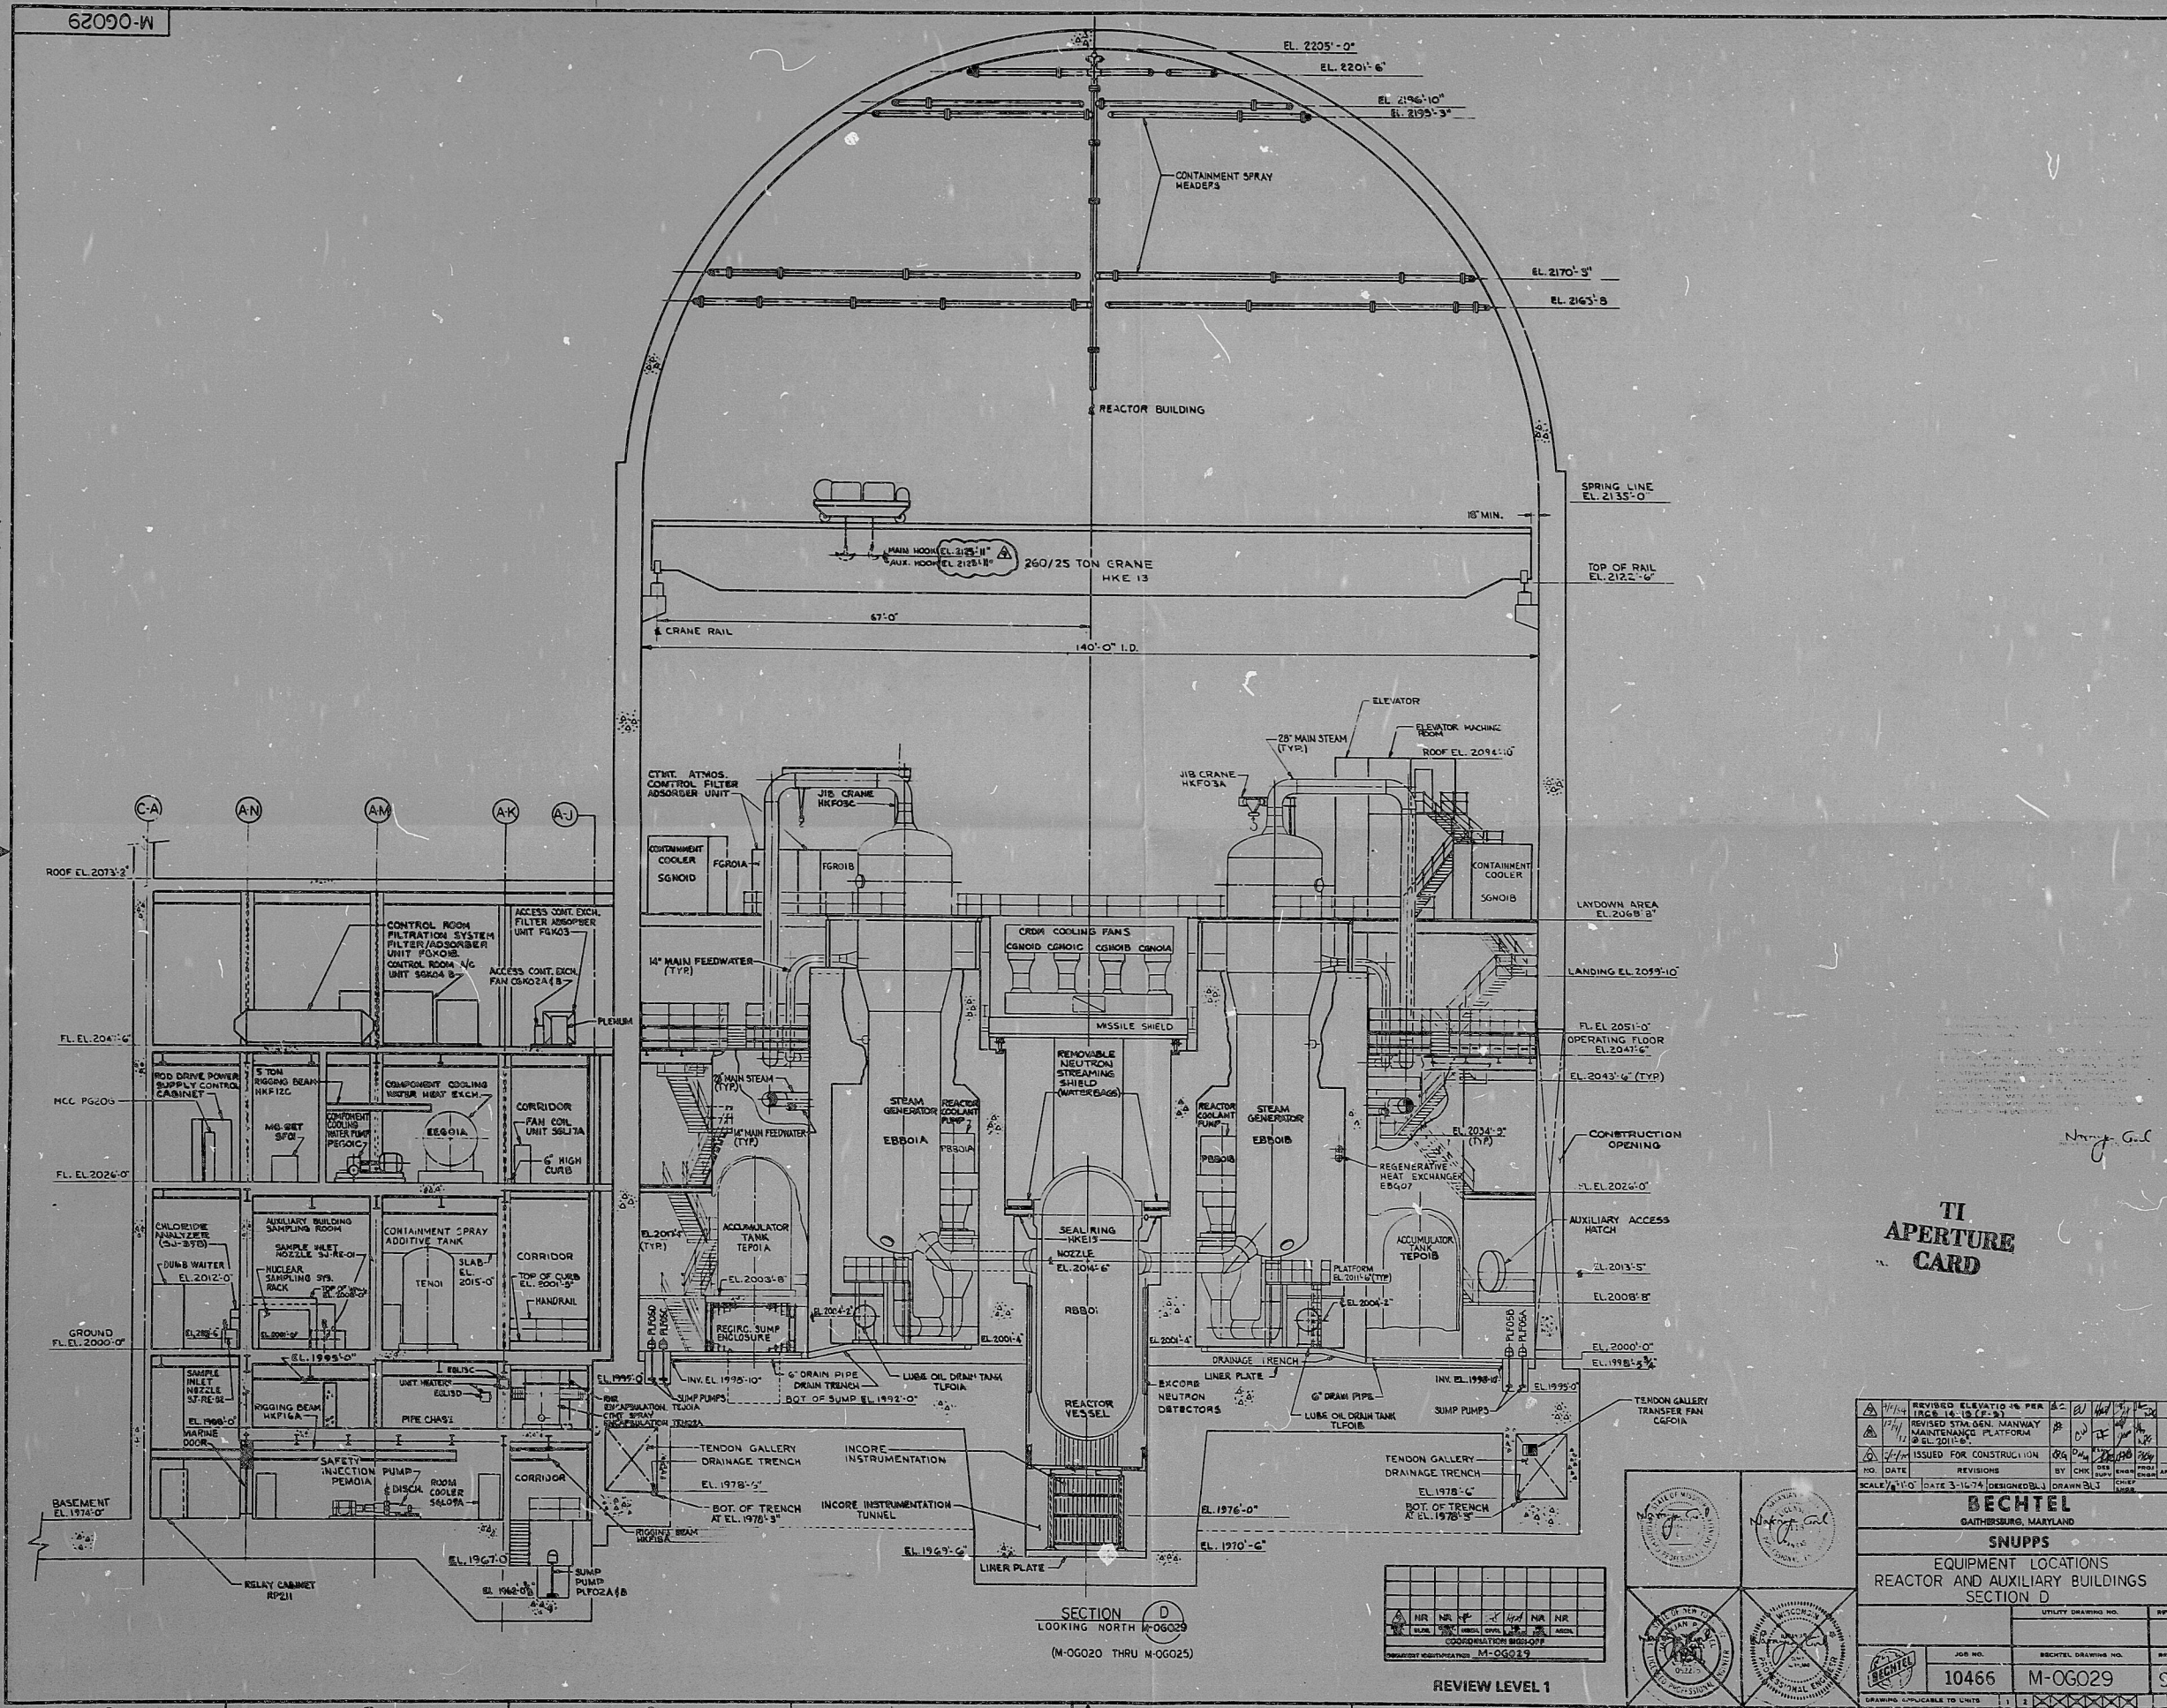

TI
APERTURE
CARD

REVISIONS			
NO.	DATE	BY	CHK.
1	3-10-74	DESIGNED	BL
2		DRAWN	BL

SCALE: 1/4" = 1'-0" DATE: 3-10-74 (DESIGNED BY) DRAWN BY

BECHTEL
BATHERSBURG, MARYLAND

SNUPPS
EQUIPMENT LOCATIONS
REACTOR AND AUXILIARY BUILDINGS
SECTION D

JOB NO.	10466	BECHTEL DRAWING NO.	M-06029
DRAWING TITLE	EQUIPMENT LOCATIONS REACTOR AND AUXILIARY BUILDINGS SECTION D	UTILITY DRAWING NO.	

REVIEW LEVEL 1

SECTION D
LOOKING NORTH M-06029
(M-06020 THRU M-06025)

This drawing and its contents are the property of the licensee which are participating in the SNUPPS Project. It is licensed on this borrower's express agreement that it may not be reproduced, copied, loaned, exhibited, or used except as specifically permitted in the license agreement between the licensee and the licensor.

0100500178

PDR RIDS

