



SCALING RULES  
 0' 10" 20" 

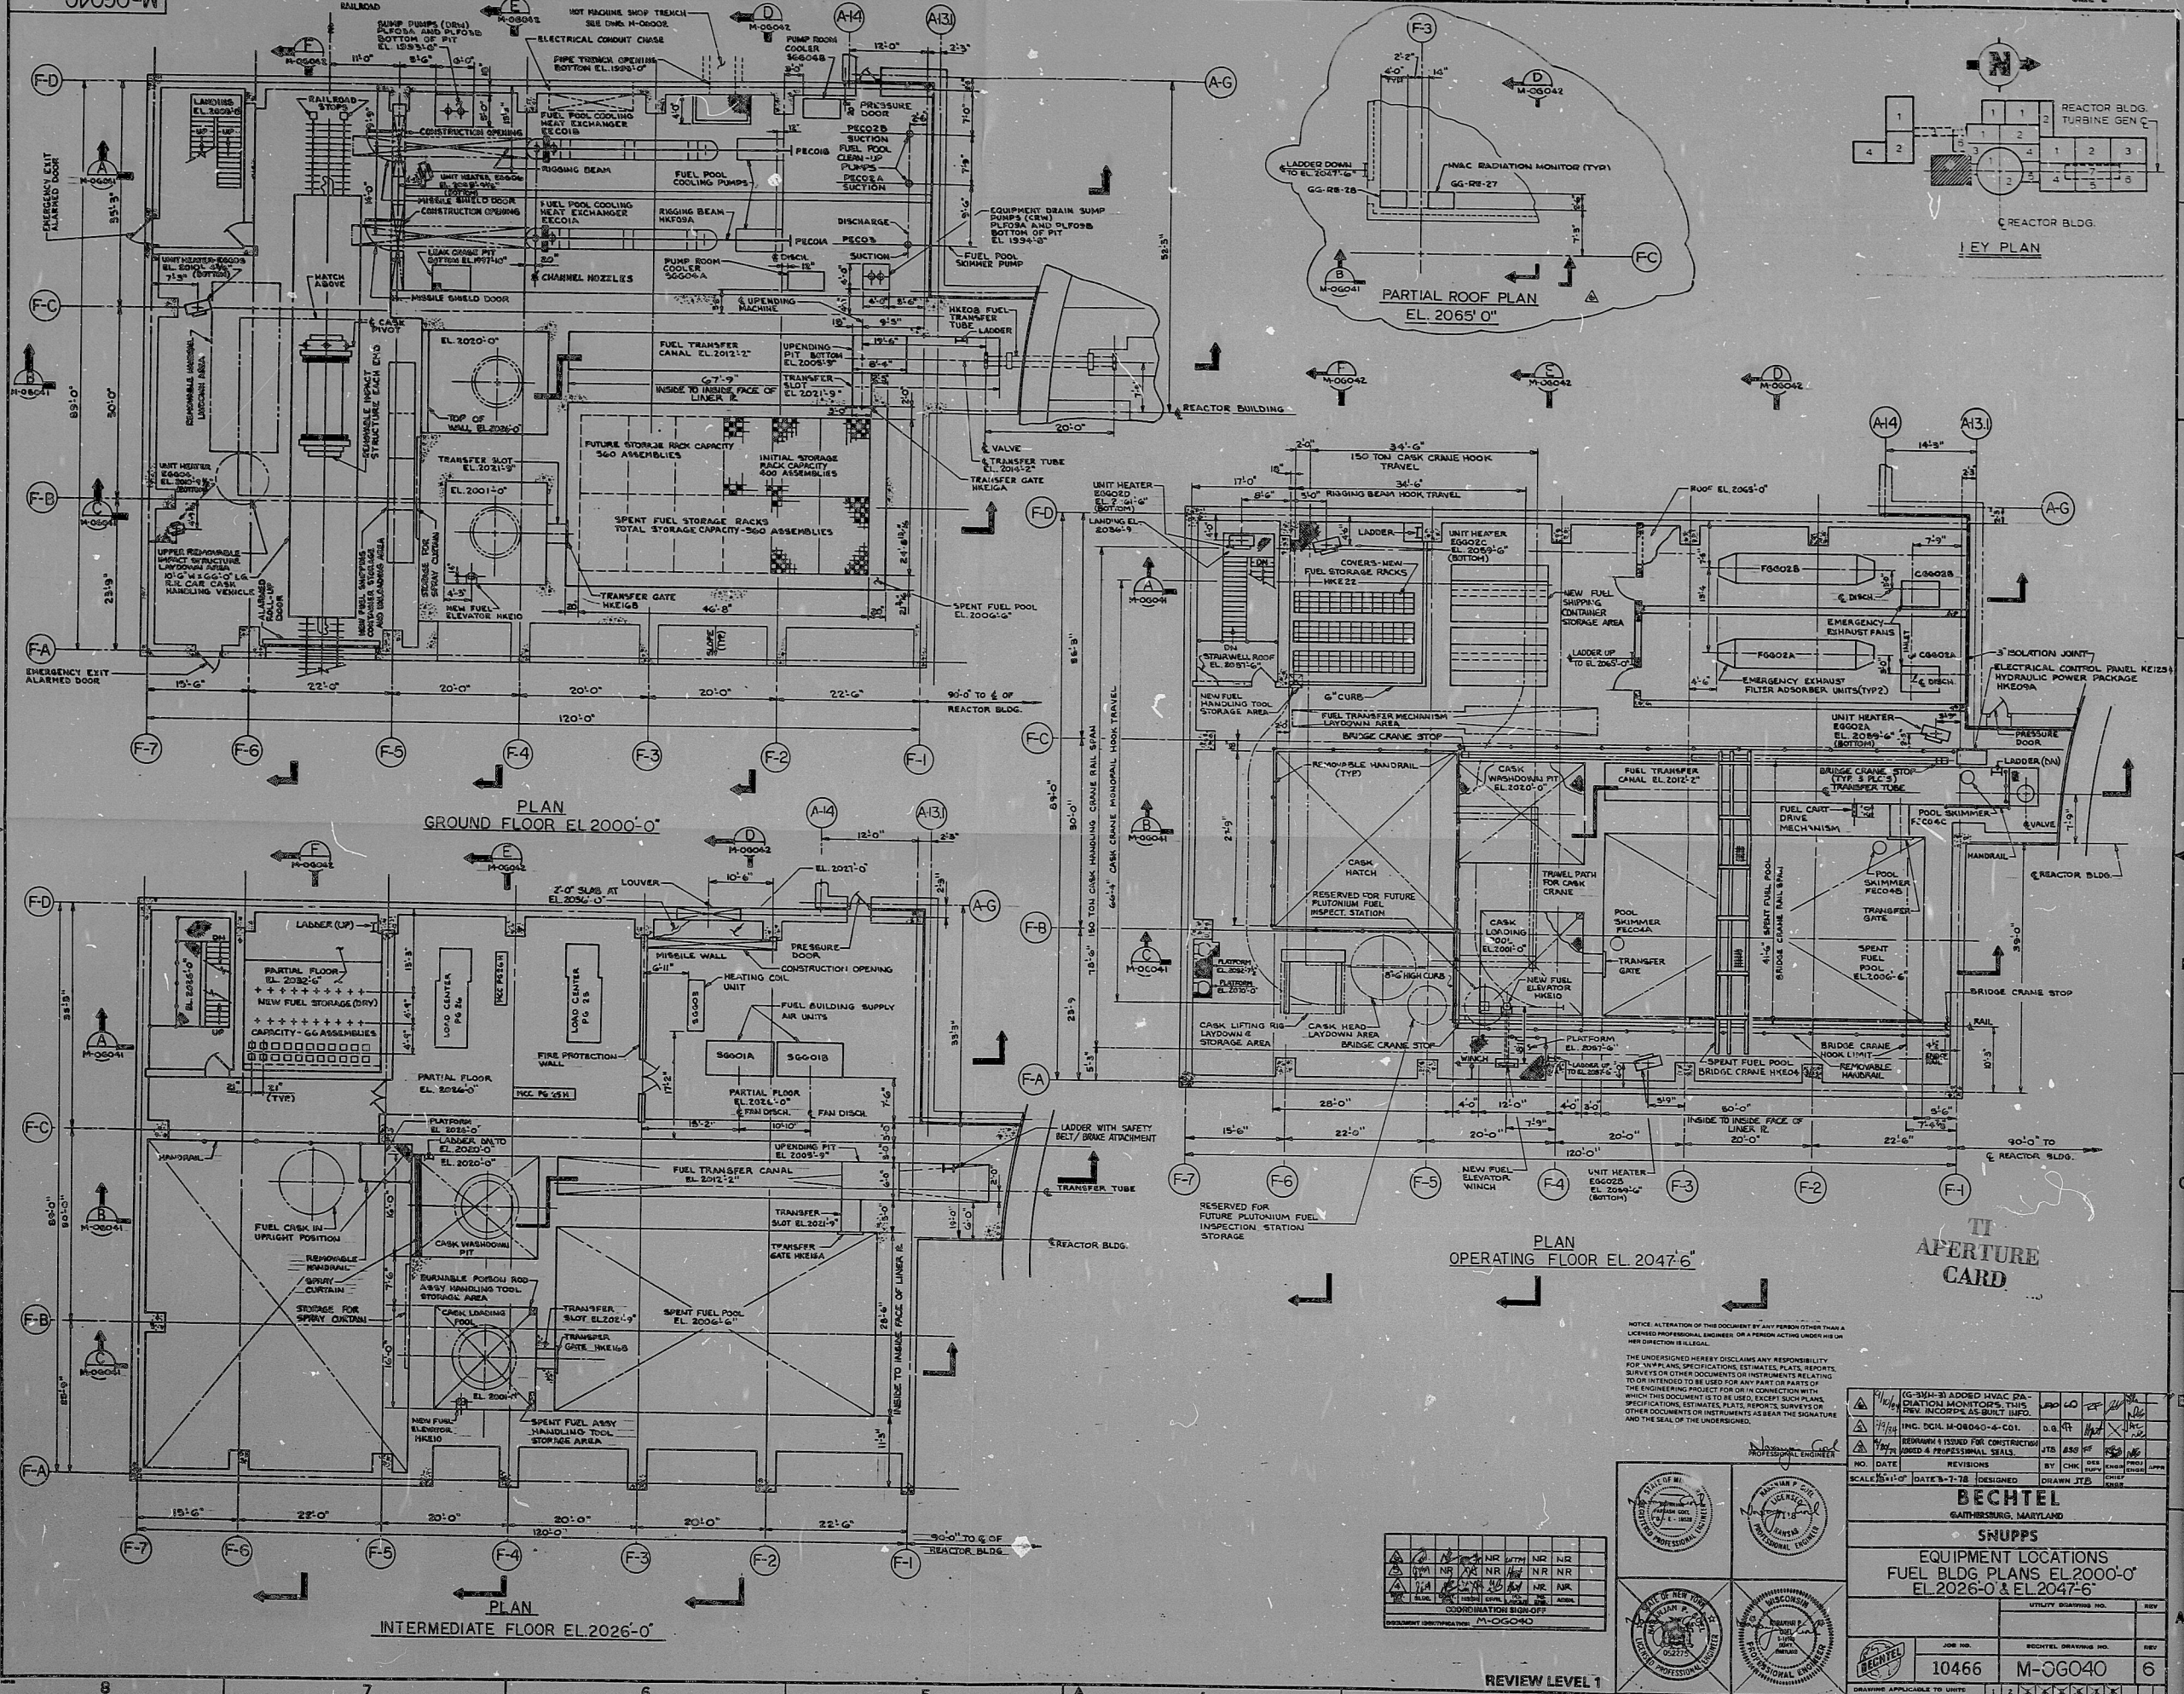

This drawing and the design it covers is the property of the Utility which is participating in the SHUPPS Project. It is based on the borrower's express agreement that it will not be reproduced, copied, loaned, exhibited, or used except in the limited way and within the consent given by the SHUPPS Utilities to the borrower.

NOTICE: ALTERATION OF THIS DOCUMENT BY ANY PERSON OTHER THAN A LICENSED PROFESSIONAL ENGINEER OR A PERSON ACTING UNDER HIS OR HER SUPERVISION IS ILLEGAL.	
THE UNDERSIGNED HEREBY DISCLAIMS ANY RESPONSIBILITY FOR ANY PLANS, SPECIFICATIONS, ESTIMATES, PLATS, REPORTS, DRAWINGS OR OTHER DOCUMENTS OR INSTRUMENTS RELATING TO THIS PROJECT TO BE USED FOR ANY PART OR PARTS OF THE ENGINEERING PROJECT FOR OR IN CONNECTION WITH WHICH THIS DOCUMENT IS USED, EXCEPT SUCH PLANS, SPECIFICATIONS, ESTIMATES, PLATS, REPORTS, DRAWINGS OR OTHER DOCUMENTS OR INSTRUMENTS AS BEAR THE SIGNATURE AND THE SEAL OF THE UNDERSIGNED.	
<b>BECHTEL</b> GAITHERSBURG, MARYLAND <b>SNUPPS</b> EQUIPMENT LOCATIONS FUEL BLDG PLANS EL 2000'-0' & EL 2047'-6'	


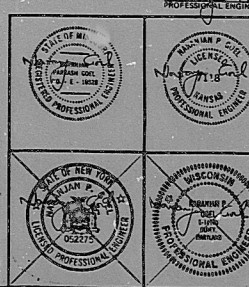

REVIEW LEVEL 1

8 7 6 5 4 3 2 1

8.5" 11" 17"

8410090014

PDR RIDS

