


M-06054

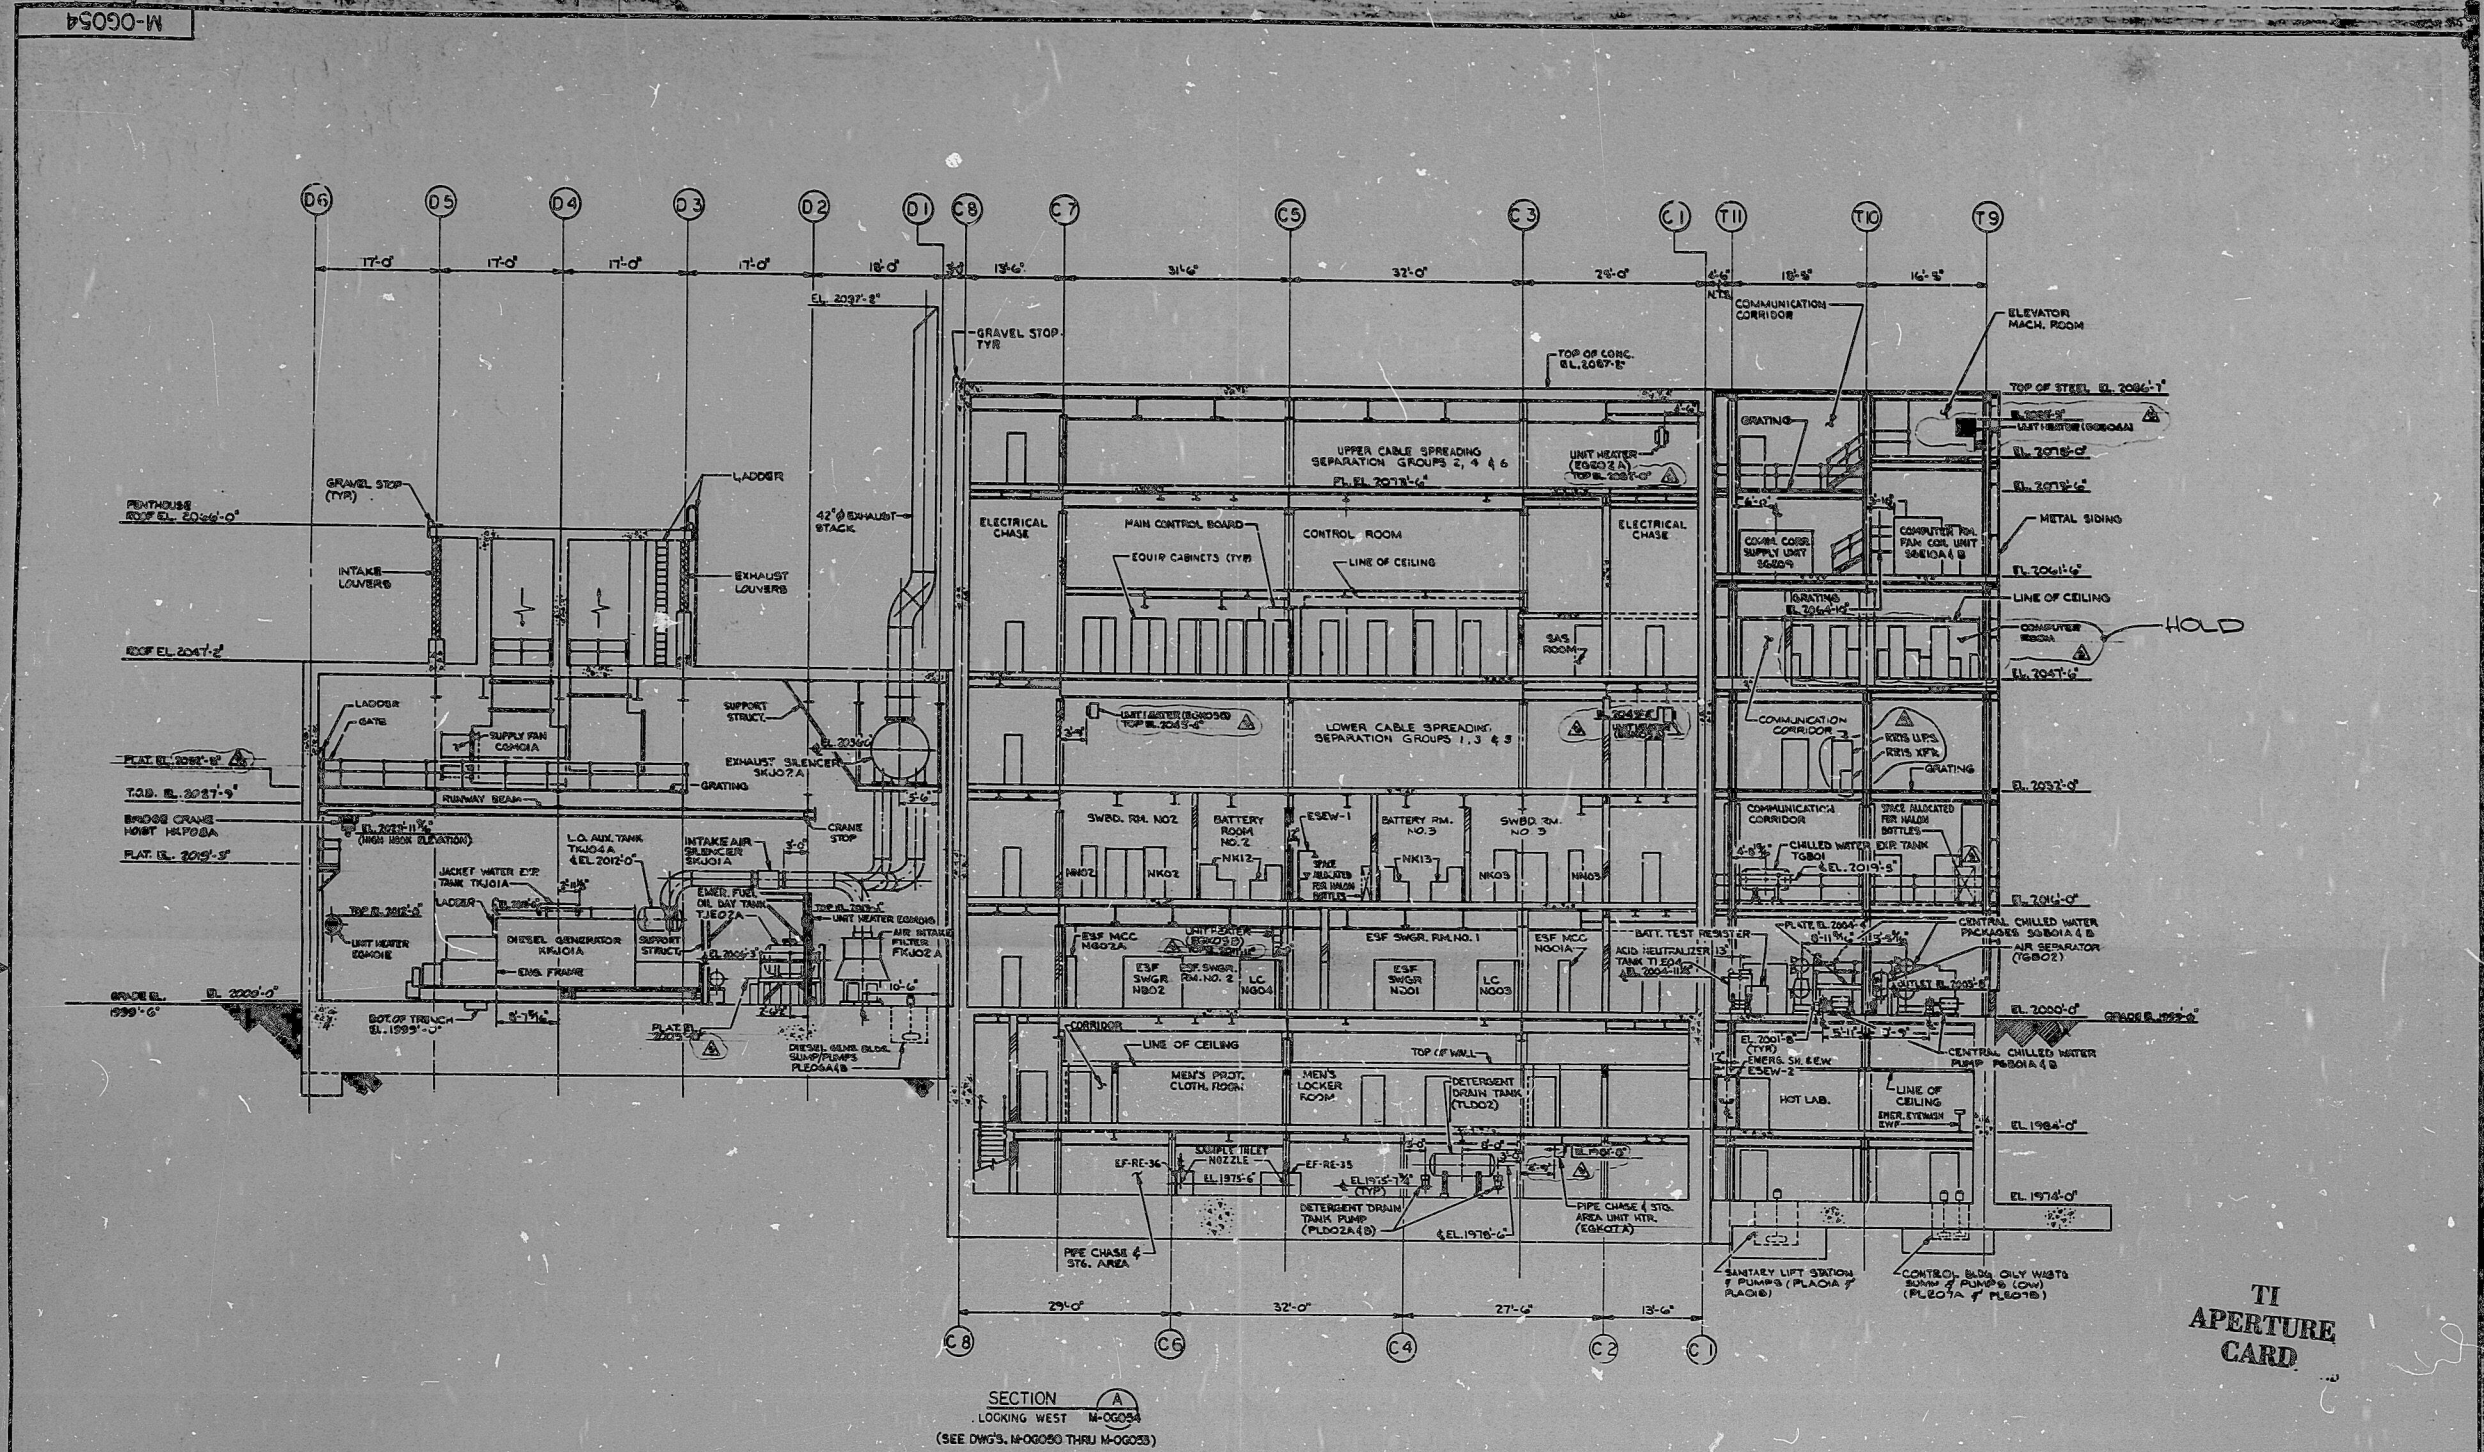

SECTION A
LOOKING WEST
(SEE DWG'S. M-06050 THRU M-06053)

TI
APERTURE
CARD

NOTICE: ALTERATION OF THIS DOCUMENT BY ANY PERSON OTHER THAN A LICENSED PROFESSIONAL ENGINEER OR A PERSON ACTING UNDER HIS OR HER DIRECTION IS ILLEGAL.

THE UNDERSIGNED HEREBY DISCLAIMS ANY RESPONSIBILITY FOR ANY PLANS, SPECIFICATIONS, ESTIMATES, PLATS, REPORTS, SURVEYS OR OTHER DOCUMENTS OR INSTRUMENTS PREPARED BY HIM OR HIS FIRM OR FOR ANY PART OF ANY OF THE ABOVE DOCUMENTS OR INSTRUMENTS PREPARED BY HIM OR HIS FIRM WHICH THIS DOCUMENT IS TO BE USED, EXCEPT SUCH PLANS, SPECIFICATIONS, ESTIMATES, PLATS, REPORTS, SURVEYS AND OTHER DOCUMENTS OR INSTRUMENTS AS BEAR THE SIGNATURE AND THE SEAL OF THE UNDERSIGNED.

DATE	REVISIONS	BY	CHKD

SCALE: AS SHOWN DATE: 2-28-74 DRAWN BY: DEAN C. B. CHECKED BY: DEAN C. B.

BECHTEL
CORPORATION, BERKELEY, CALIFORNIA

SNUPPS
EQUIPMENT LOCATIONS
CONTROL & DIESEL ENGS. BLDGS. AND COMM.
CORRIDOR SECTION A

PROJECT: M-06054

DATE: 2-28-74

8410090033

PDR AIDS

