

11

11

8.5

8.5

11

17

11


11

8.5

8.5

11

17

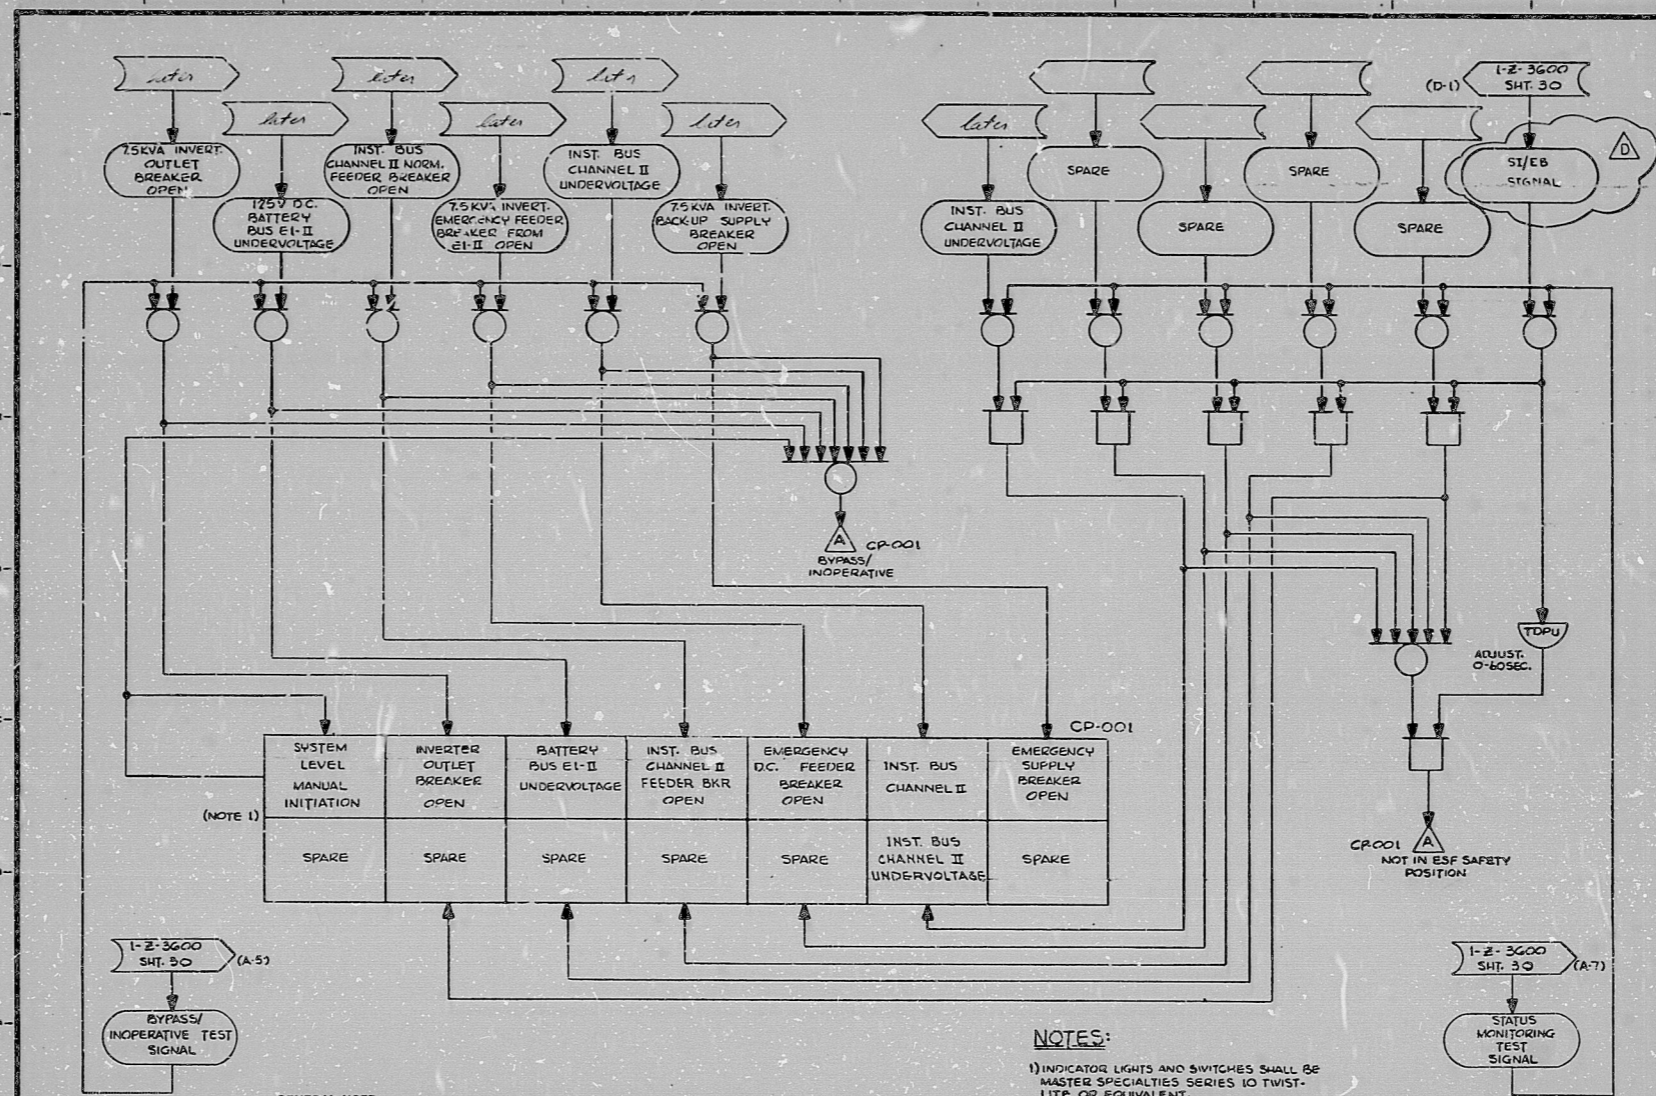

GENERAL NOTE:
THIS DRAWING REPRESENTS FUNCTIONAL REQUIREMENTS ONLY. REFER TO ELECTRICAL REFERENCE DRAWING FOR HARDWARE IMPLEMENTATION.

NOTES:
1) INDICATOR LIGHTS AND SWITCHES SHALL BE MASTER SPECIALTIES SERIES 10 TWIST-LITE OR EQUIVALENT.



































































































































































































































































































































































































































RIDS

8112090241

