




PLAN VIEW AT ELEVATION 601'-0"
SCALE: 1/4" = 1'-0"
PROB. 42C

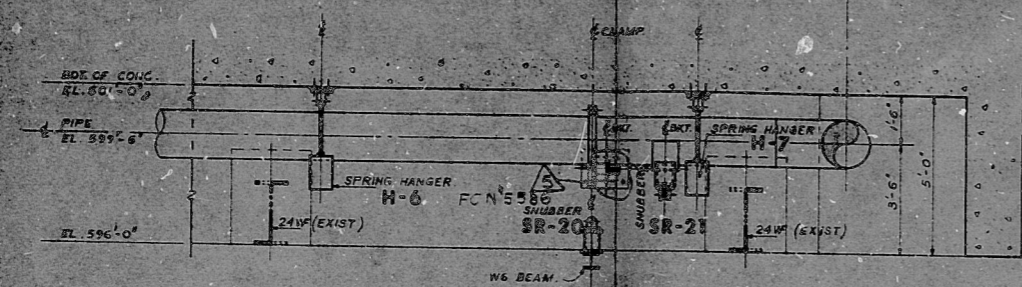


SECTION B
SCALE: 1/4" = 1'-0"

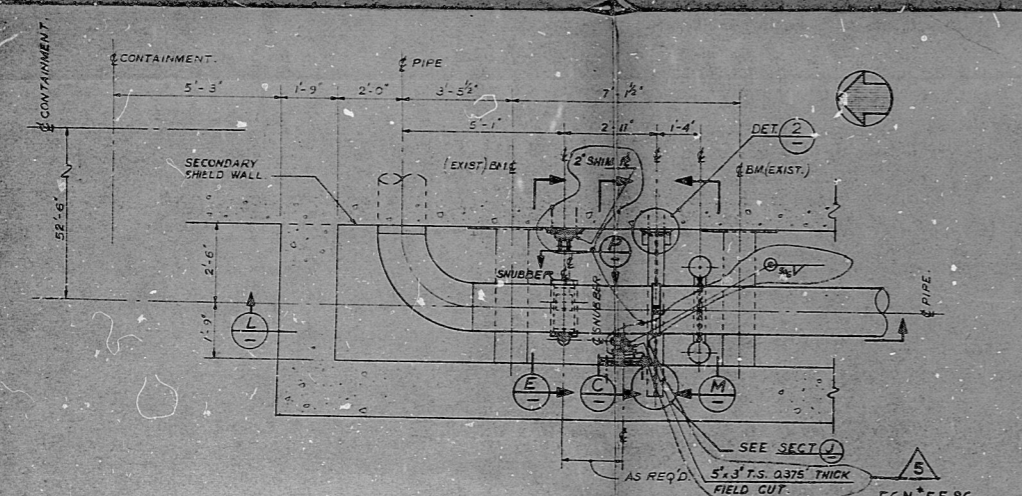


PLAN VIEW AT ELEVATION 601'-0"
SCALE: 1/4" = 1'-0"
PROB. 42A

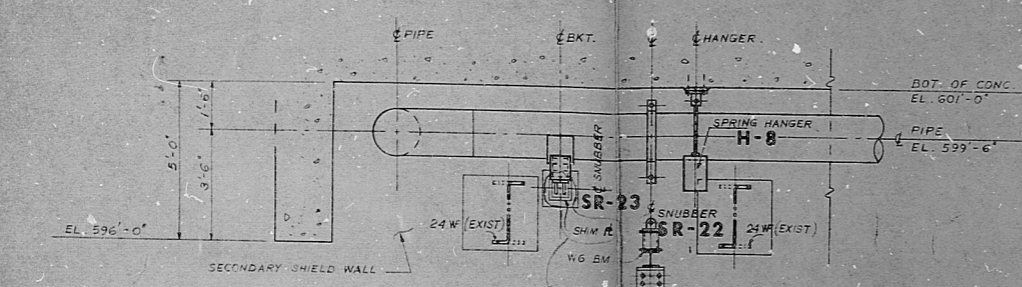


SECTION L
SCALE: 1/4" = 1'-0"

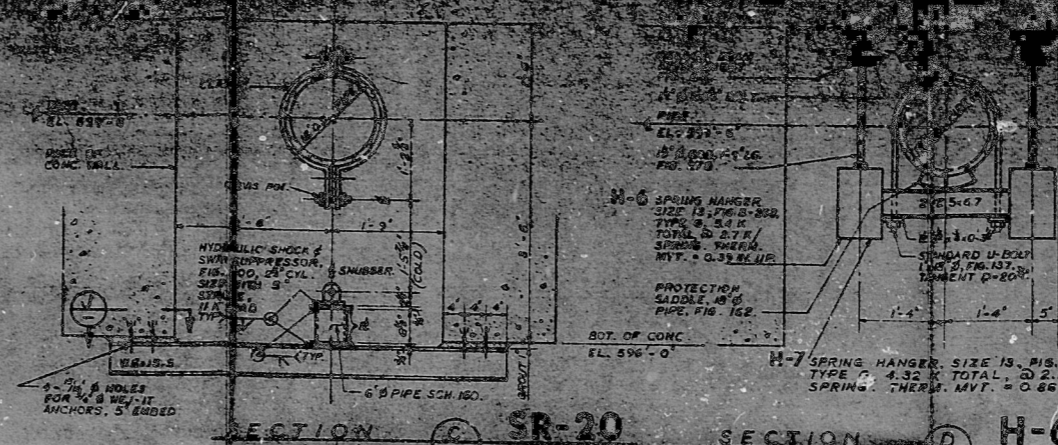


SECTION C
SCALE: 1/4" = 1'-0"

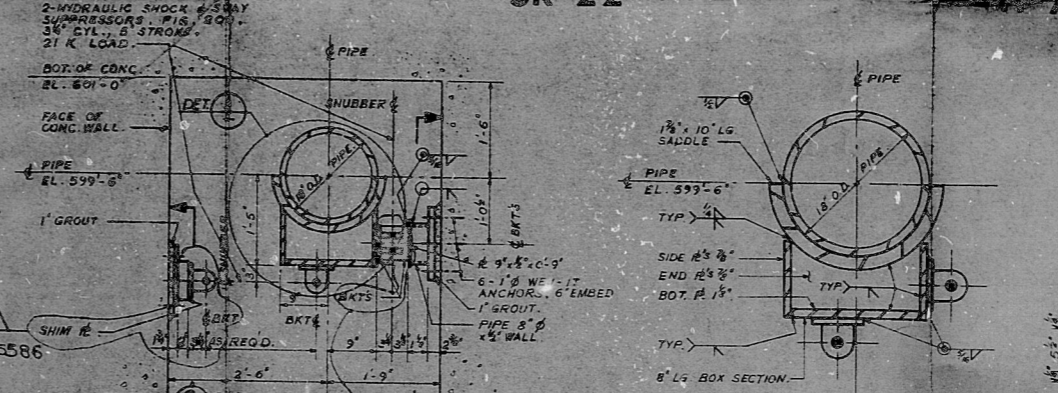


SECTION E
SCALE: 1/4" = 1'-0"

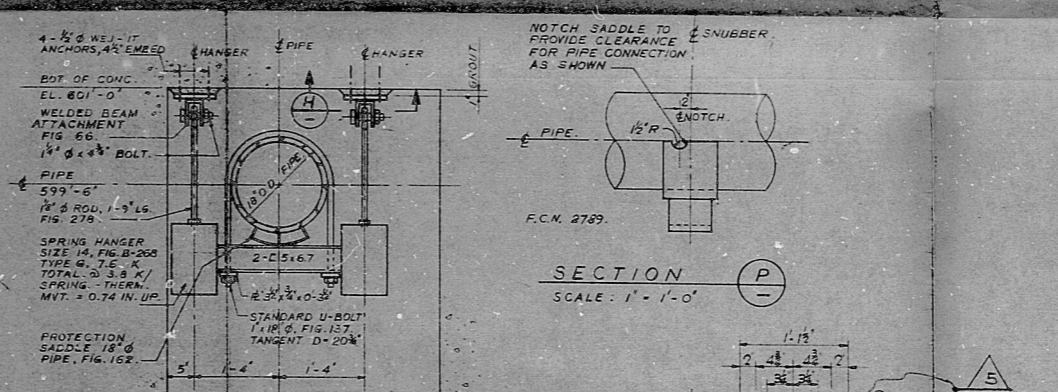


SECTION M
SCALE: 1/4" = 1'-0"

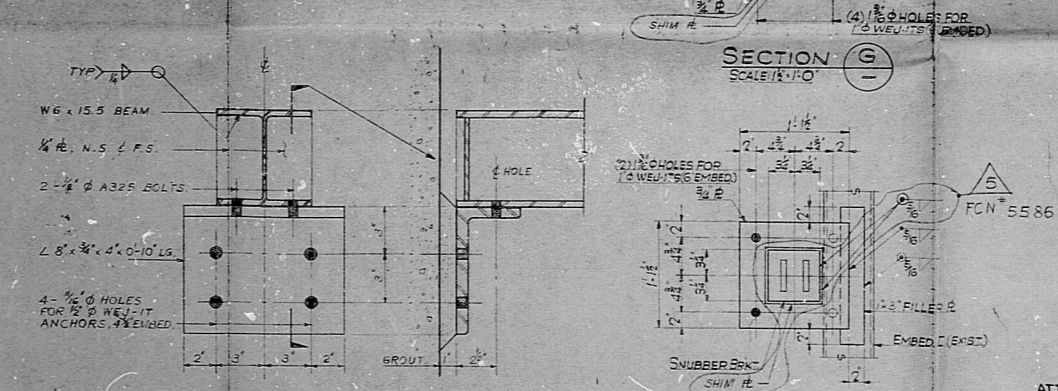


SECTION R
SCALE: 1/4" = 1'-0"

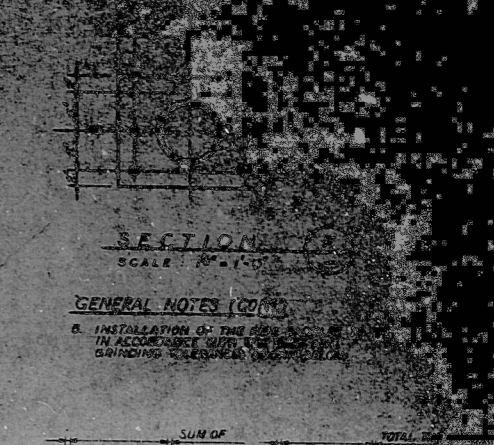


SECTION D
SCALE: 1/4" = 1'-0"

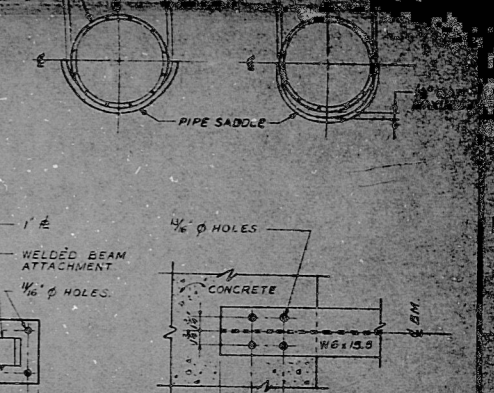



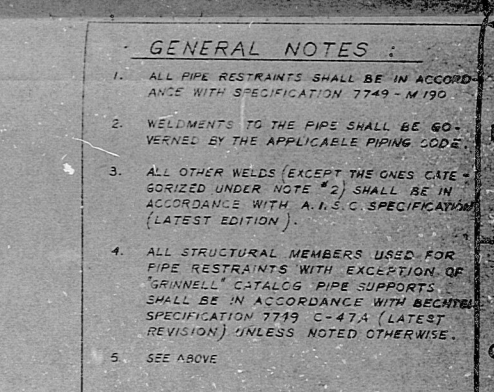


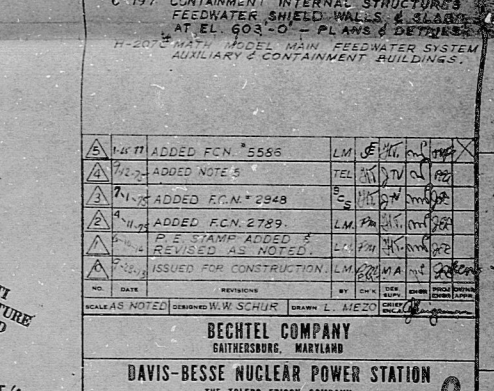


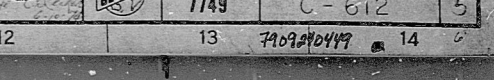


GENERAL NOTES (CONT.)
B. INSTALLATION OF THE PIPE RESTRAINTS SHALL BE IN ACCORDANCE WITH THE FOLLOWING NOTES:

- GENERAL NOTES:
1. ALL PIPE RESTRAINTS SHALL BE IN ACCORDANCE WITH SPECIFICATION 7749-M190.
 2. WELDMENTS TO THE PIPE SHALL BE GOVERNED BY THE APPLICABLE PIPING CODE.
 3. ALL OTHER WELDS (EXCEPT THE ONES CATEGORIZED UNDER NOTE #2) SHALL BE IN ACCORDANCE WITH A.I.S.C. SPECIFICATION (LATEST EDITION).
 5. SEE ABOVE.

REFERENCE DRAWINGS:
C-128 CONTAINMENT INTERNAL STRUCTURES FLOOR PLAN EL. 603'-0" STRUCTURAL STEEL
C-197 CONTAINMENT INTERNAL STRUCTURES FEEDWATER SHIELD WALLS & SLABS AT EL. 603'-0" - PLANS & DETAILS
H-207 MAIN FEEDWATER SYSTEM AUXILIARY & CONTAINMENT BUILDINGS.


BECHTEL COMPANY

DAVIS-BESSE NUCLEAR POWER STATION
THE TOLEDO EDISON COMPANY
THE CLEVELAND ELECTRIC ILLUMINATING COMPANY

CONTAINMENT BUILDING
MAIN FEEDWATER SEISMIC-RESTRAINTS
DETAILS, SHEET 5

JOB NO. 7749
DRAWING NO. C-612
REV. 5

74090499

PDR BFT

7909240449

